


PLANS

NOT

TO

SCALE

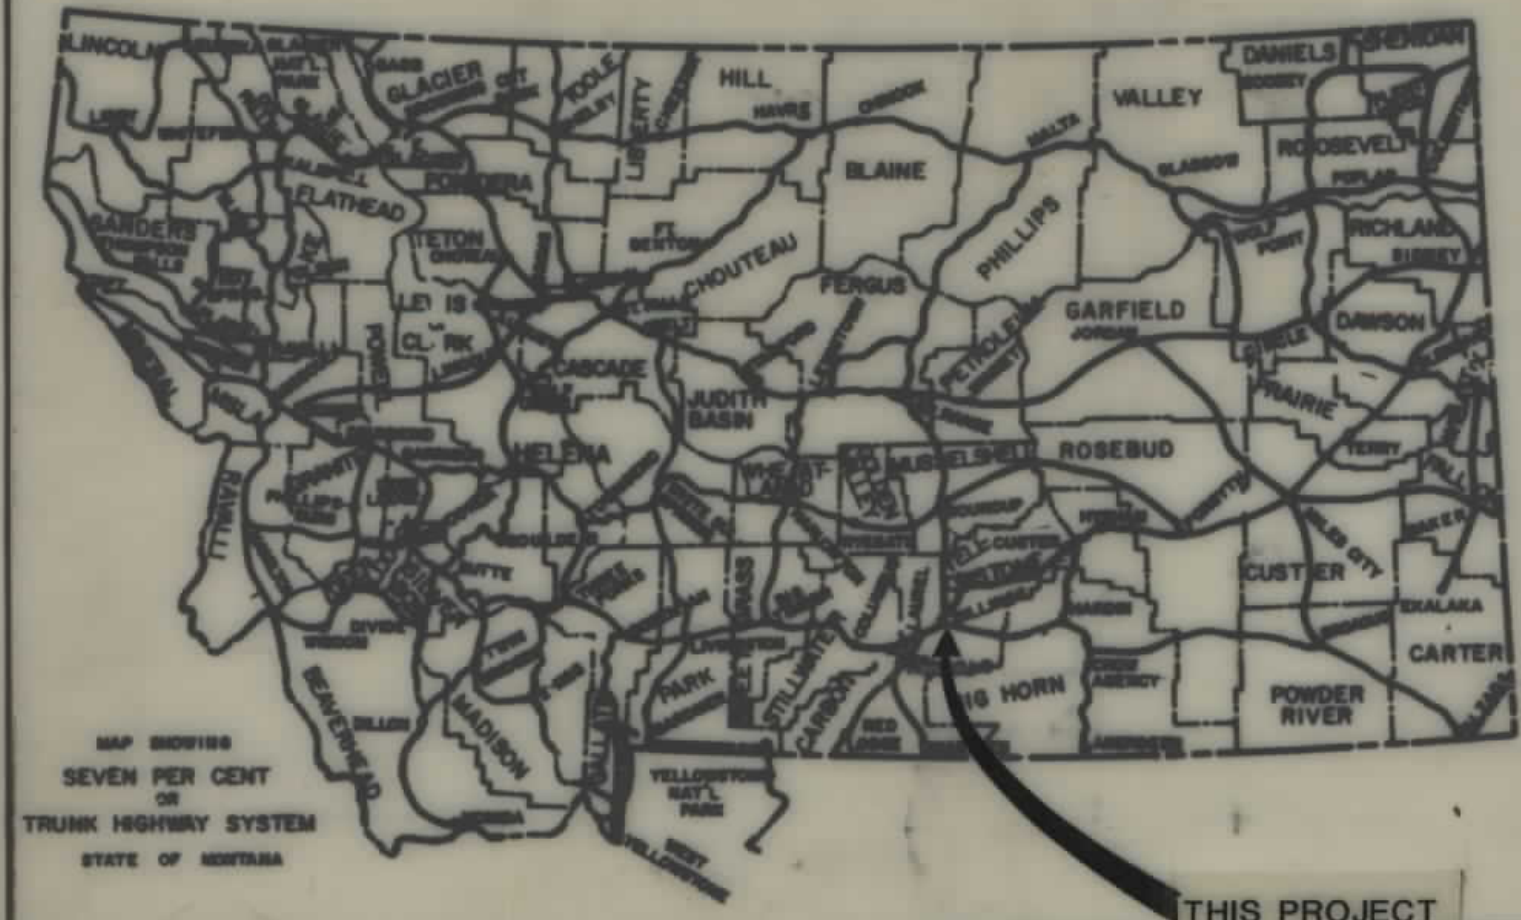

MAP SHOWING
SEVEN PER CENT
OF
TRUNK HIGHWAY SYSTEM
STATE OF MONTANA

THIS PROJECT


CONVENTIONAL SIGNS

- PROPOSED RIGHT OF WAY LINE
- EXISTING RIGHT OF WAY LINE
- RAILROAD RIGHT OF WAY LINE
- CENTERLINE (C) OR PROJECTED LINE
- STK'D CENTERLINE
- OWNERSHIP BOUNDARY
- PRESENT TRAVELED WAY (P.T.W.)
- R/W LINE FENCED
- CONSTRUCTION LIMITS
- FENCE LINE
- CONTROL OF ACCESS WITH FENCE
- LIMITED ACCESS
- EXISTING LIMITED ACCESS
- GATE IN FENCE
- CATTLE GUARD = 24'
- STATE & NATIONAL BORDER LINES
- CITY OR TOWN LIMITS LINE
- COUNTY LINE
- RESERVATION LINE
- TOWNSHIP & SECTION LINE
- 1/4 & 1/2 SECTION LINE
- SECTION CORNER
- 1/4 SECTION COR.
- 1/16 SECTION COR.
- CENTER OF SECTION
- TELEPHONE OR TELEGRAPH POLES IN PLACE
- POWER POLES IN PLACE
- TEL. OR TEL. OR POWER POLES TO BE MOVED
- NEW PIPES
- OLD PIPES IN PLACE
- OUTLET DITCH
- INLET DITCH
- DITCHES
- CHANNEL CHANGES
- BRIDGES
- RAILROADS
- PARCEL NUMBER
- NEW APPROACH
- EXISTING APPROACH
- LIMITED ACCESS

T. 1 S. R. 26 E.

STATE OF MONTANA
DEPARTMENT OF HIGHWAYS
RIGHT OF WAY PLAN OF
FEDERAL AID PROJECT NO.

M - 1024 (2)
STATE AVENUE - BILLINGS
YELLOWSTONE COUNTY
LENGTH 1.71 MILES

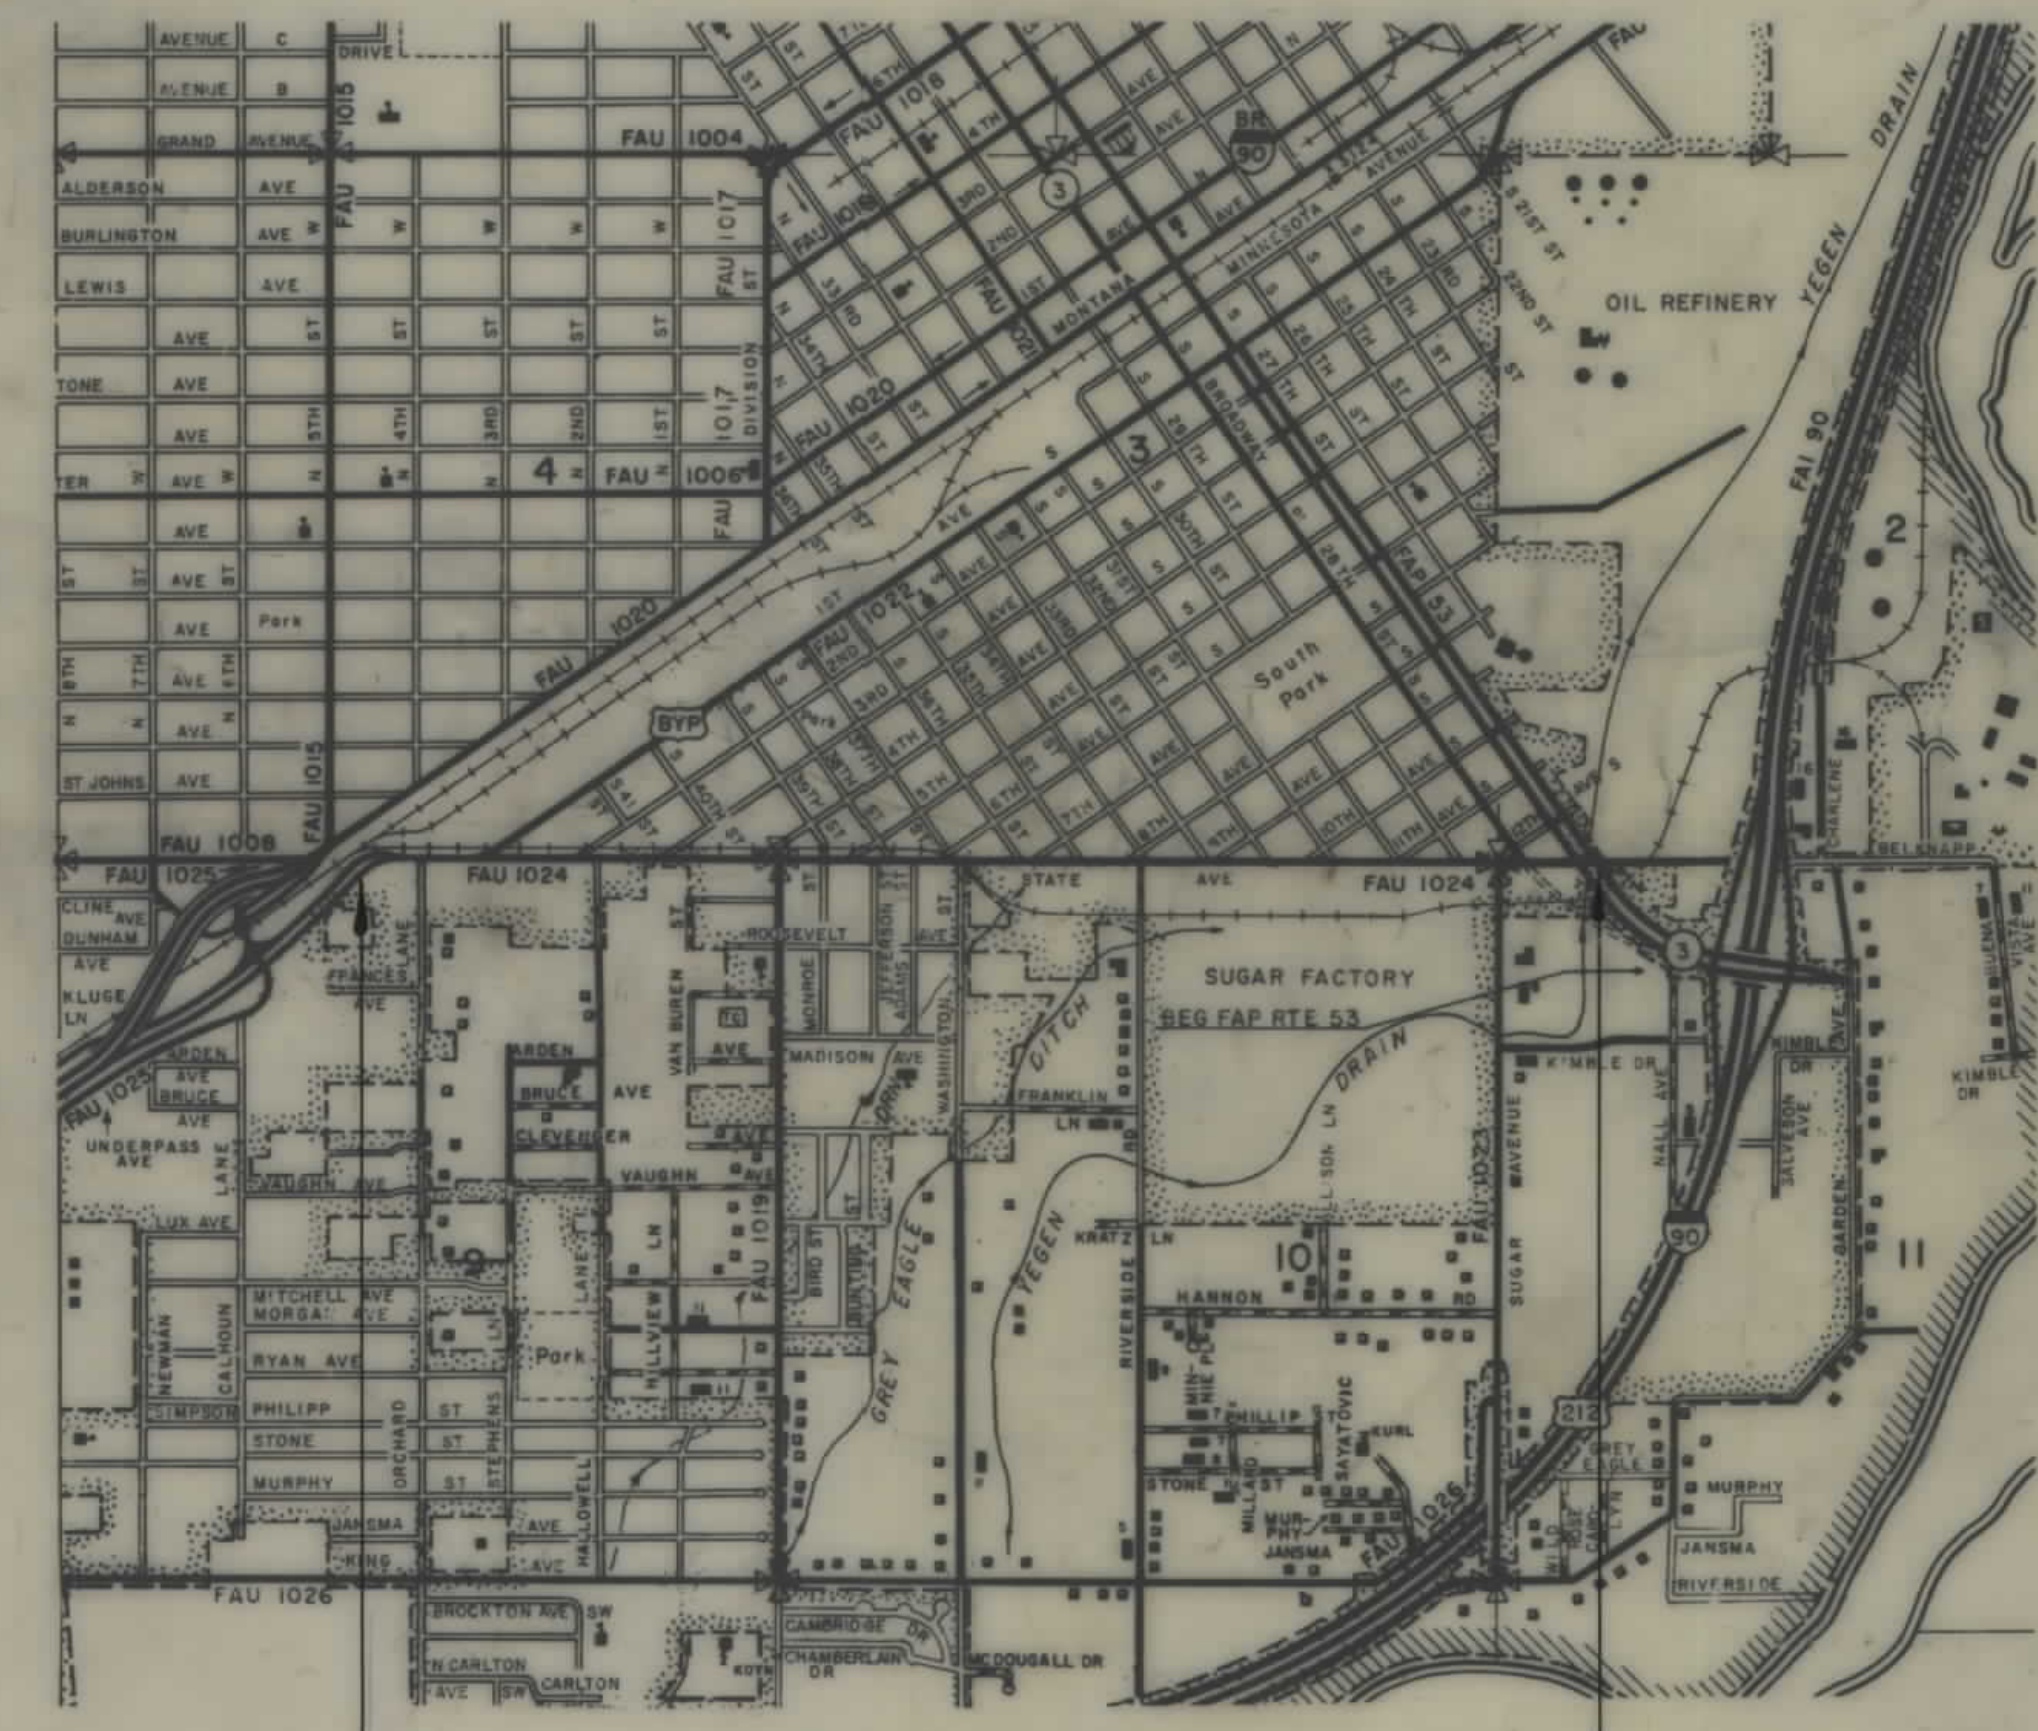

STA. 4+66 BEG. M 1024 (2)

STA. 94+89 END M 1024 (2)

Revised: 11-27-89, 12-28-89
11-15-93

THIS CONTRACT

STATE	PROJECT NO.	SHEET NO.	TOTAL SHEETS
MONT.	M1024 (2)	1	22

STATE AVE. - BILLINGS

INDEX

PARCEL NO.	OWNERSHIPS	SHEET NO.
1	DELETED	3
2	DELETED	3,4
3	STATE AVENUE PARTNERS	4,5
4	BURLINGTON NORTHERN RAILROAD	5-11
5	S. C. RYAN, INC.	5
6	E. HOWARD SANDAKER & RAYMOND F. SEDERHOLM	5
7	GARRETT FREIGHTLINES INC.	5
8	ESTHER K. SACKMAN & GLORIA A. TOD	5
63	GARRETT FREIGHTLINES INC.	5
7 & 63	GARRETT FREIGHTLINES INC.	5
9	DANIAL W. DIMICH, JR.	6
10	DELETED	6
11	ED CONITZ SHOPPING CENTER	6,7
12	WINFREY, EDITH N.	7,8
13	FAIST, ANDREW & LEOCARDIA	7
14	ROBERT J. BRUCE & ARTHUR A. MICHELISIC	7,8
15	ETHEL G. LAPP	8
65	HELEN D. ADAMS	8
16	RICHARD W. & KATHY J. JOHNSON	8
17	EDITH N. WINDREY	8
18	ESTHER A. LOGAN	8
19	MARGARET BRITTAIN	8
20	ANN HUDSON	8
21	J & K VENTURES	8,9
22	ADMIN. OF VET. AFFAIRS	9
23	HARRY & RUTH KUYATT	9
24	ADAM SCHAFF	9,10
25	TERRANCE & BETTY J. BEYERS	10
26	RONALD V. FODE	10,11
27	PETER JR. & ZELLA H. YEGEN	11,12
28	JOSE M. & ROSELLA J. RODRIGUEZ	11
29	LESTER L. & RICHARD GUGLER	11
30	CURTISS T. BROWN	11
31	PEDERSON CONSTRUCTION CO.	11
32	KRATZ DRAINAGE DISTRICT	12
33	THE WESTERN SUGAR COMPANY	11-14
34	ANITA S. & MARIA A. FLOREZ	12
35	MARY & MARIA A. FLORES	12
36	DANIEL W. DIMICH, JR.	12
37	MARGARET E. SCHMITTOW	13
38	EDWARD E. & MONTANA L. DAVIS	13
39	JOSE & EDELLIO ARREDONDO	13,14
40	SALVADOR & VALERIA MARTINEZ	14
41	ADOLF HOVLAND	14
42	LYLE COONARE AND VELMA ARLENE MASSEY	14,15
43	THE WESTERN SUGAR COMPANY	14-19
44	FRIEDA L. GILLIS	15
45	VERLIN G. HALE	15,16
46	SOLAR WORLD, INC.	16
47	GLEN L. & JOAN D. HARBAUGH	16
48	EDWIN H. & JEAN HEISER	16
49	TATE & LYLE, INC.	17
50	THE WESTERN SUGAR COMPANY	17,18
51	DONALD E. HAUGAN	18
52	DONALD E. HAUGAN	18,19
53	GARY & JOYCE M. STOPPEL	19
54	GARY & JOYCE M. STOPPEL	19
55	YELLOWSTONE COUNTY	19
56	THE WESTERN SUGAR COMPANY	19,20
57	DELETED	20
58	C.C. SPENCER	22
59	HELEN A. MELNIC	13
60	SALVADOR & VALERIA MARTINEZ	14
61	GREY EAGLE DITCH CO.	14-17

INDEX

PARCEL NO.	OWNERSHIPS	SHEET NO.
62	DELETED	8
64	MICHAEL & LUCILE KAISER	10
66	DENNIS L. & CYNTHIA HUMPHREY	10
67	RONALD V. FODE	18
68	FRED M. & DOROTHY M. STEWART JR.	4
69	BURLINGTON NORTHERN RAILROAD	4

STATE OF MONTANA
DEPARTMENT OF HIGHWAYS

APPROVED: August 19, 1987

GARY J. WICKS
DIRECTOR OF HIGHWAYS
BY: Stephen C. Kolagi
CHIEF
PRECONSTRUCTION BUREAU

U.S. DEPARTMENT OF TRANSPORTATION
FEDERAL HIGHWAY ADMINISTRATION

APPROVED: F.H.W.A. 1-4-89

DIVISION ADMINISTRATOR DATE

STEPHEN C. KOLOGI
1241 E
PROFESSIONAL ENGINEER

A circular professional engineer seal for the State of Montana. The outer ring contains the text "MONTANA" at the top and "PROFESSIONAL ENGINEER" at the bottom, separated by two stars. The inner circle contains the name "RICHARD L. JACOBSON" and the number "5657". A handwritten signature "R. Jacobson" is written across the seal.

Executive Plaza • Airport Industrial Park
P.O. Box 31318, Billings, Montana 59107 (406-245-6354)

Checked: RZL

DRAWN: D8G

Date: _____

2M025 123

OWNERSHIP LOCATION MAP

APPROVED F.H.W.A. 1-4-89

Sheet No.

2

of 22



OWNERSHIP										
PARCEL	NAME	ADDRESS	TOTAL AREA	GROSS R/W AREA	P.T.W. AREA	AREA TO BE ACQUIRED	REMAINDER		CONST. FERM. AREA	EASEMENT AREA
							LEFT	RIGHT		
1	* DELETED									
2	* DELETED									
62	DELETED									

* R.O.W. ACQUIRED THROUGH AMENDED PLAT OF LOTS 7 & 8, STRECKER SUB

STATE	PROJECT NUMBER	SHEET NO.
MONT.	M1024 (2)	3





H K M ASSOCIATES
ENGINEERS - ARCHITECTS - PLANNERS
Executive Plaza - Airport Industrial Park
P.O. Box 31316, Billings, Montana 59107 (406) 245-6354

Drawn: DT-DCR-DGG
Checked: WASHA
Approved: JACOBSON

STATE AVENUE RECONSTRUCTION
RIGHT OF WAY PLANS
APPROVED F.H.W.A. 1-4-89
YELLOWSTONE CO.

Sheet No. 3
Project No. 2M025.123

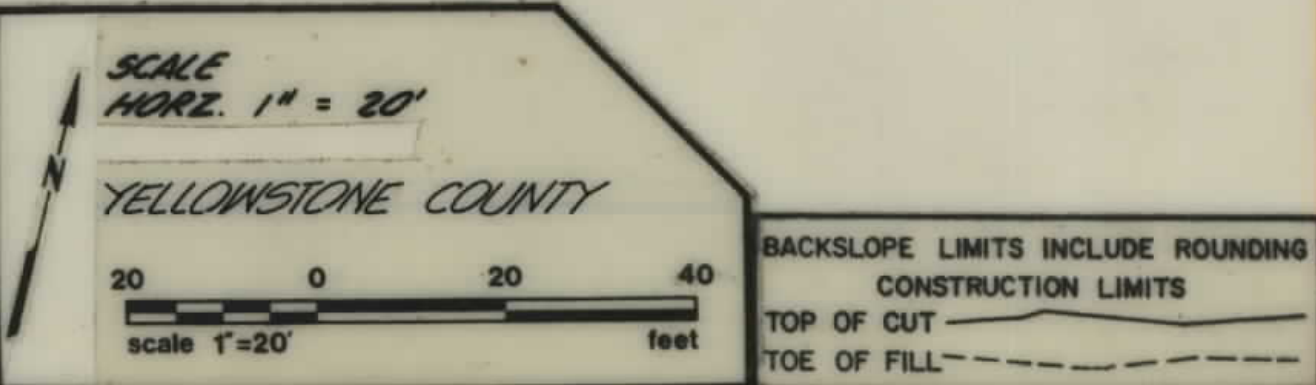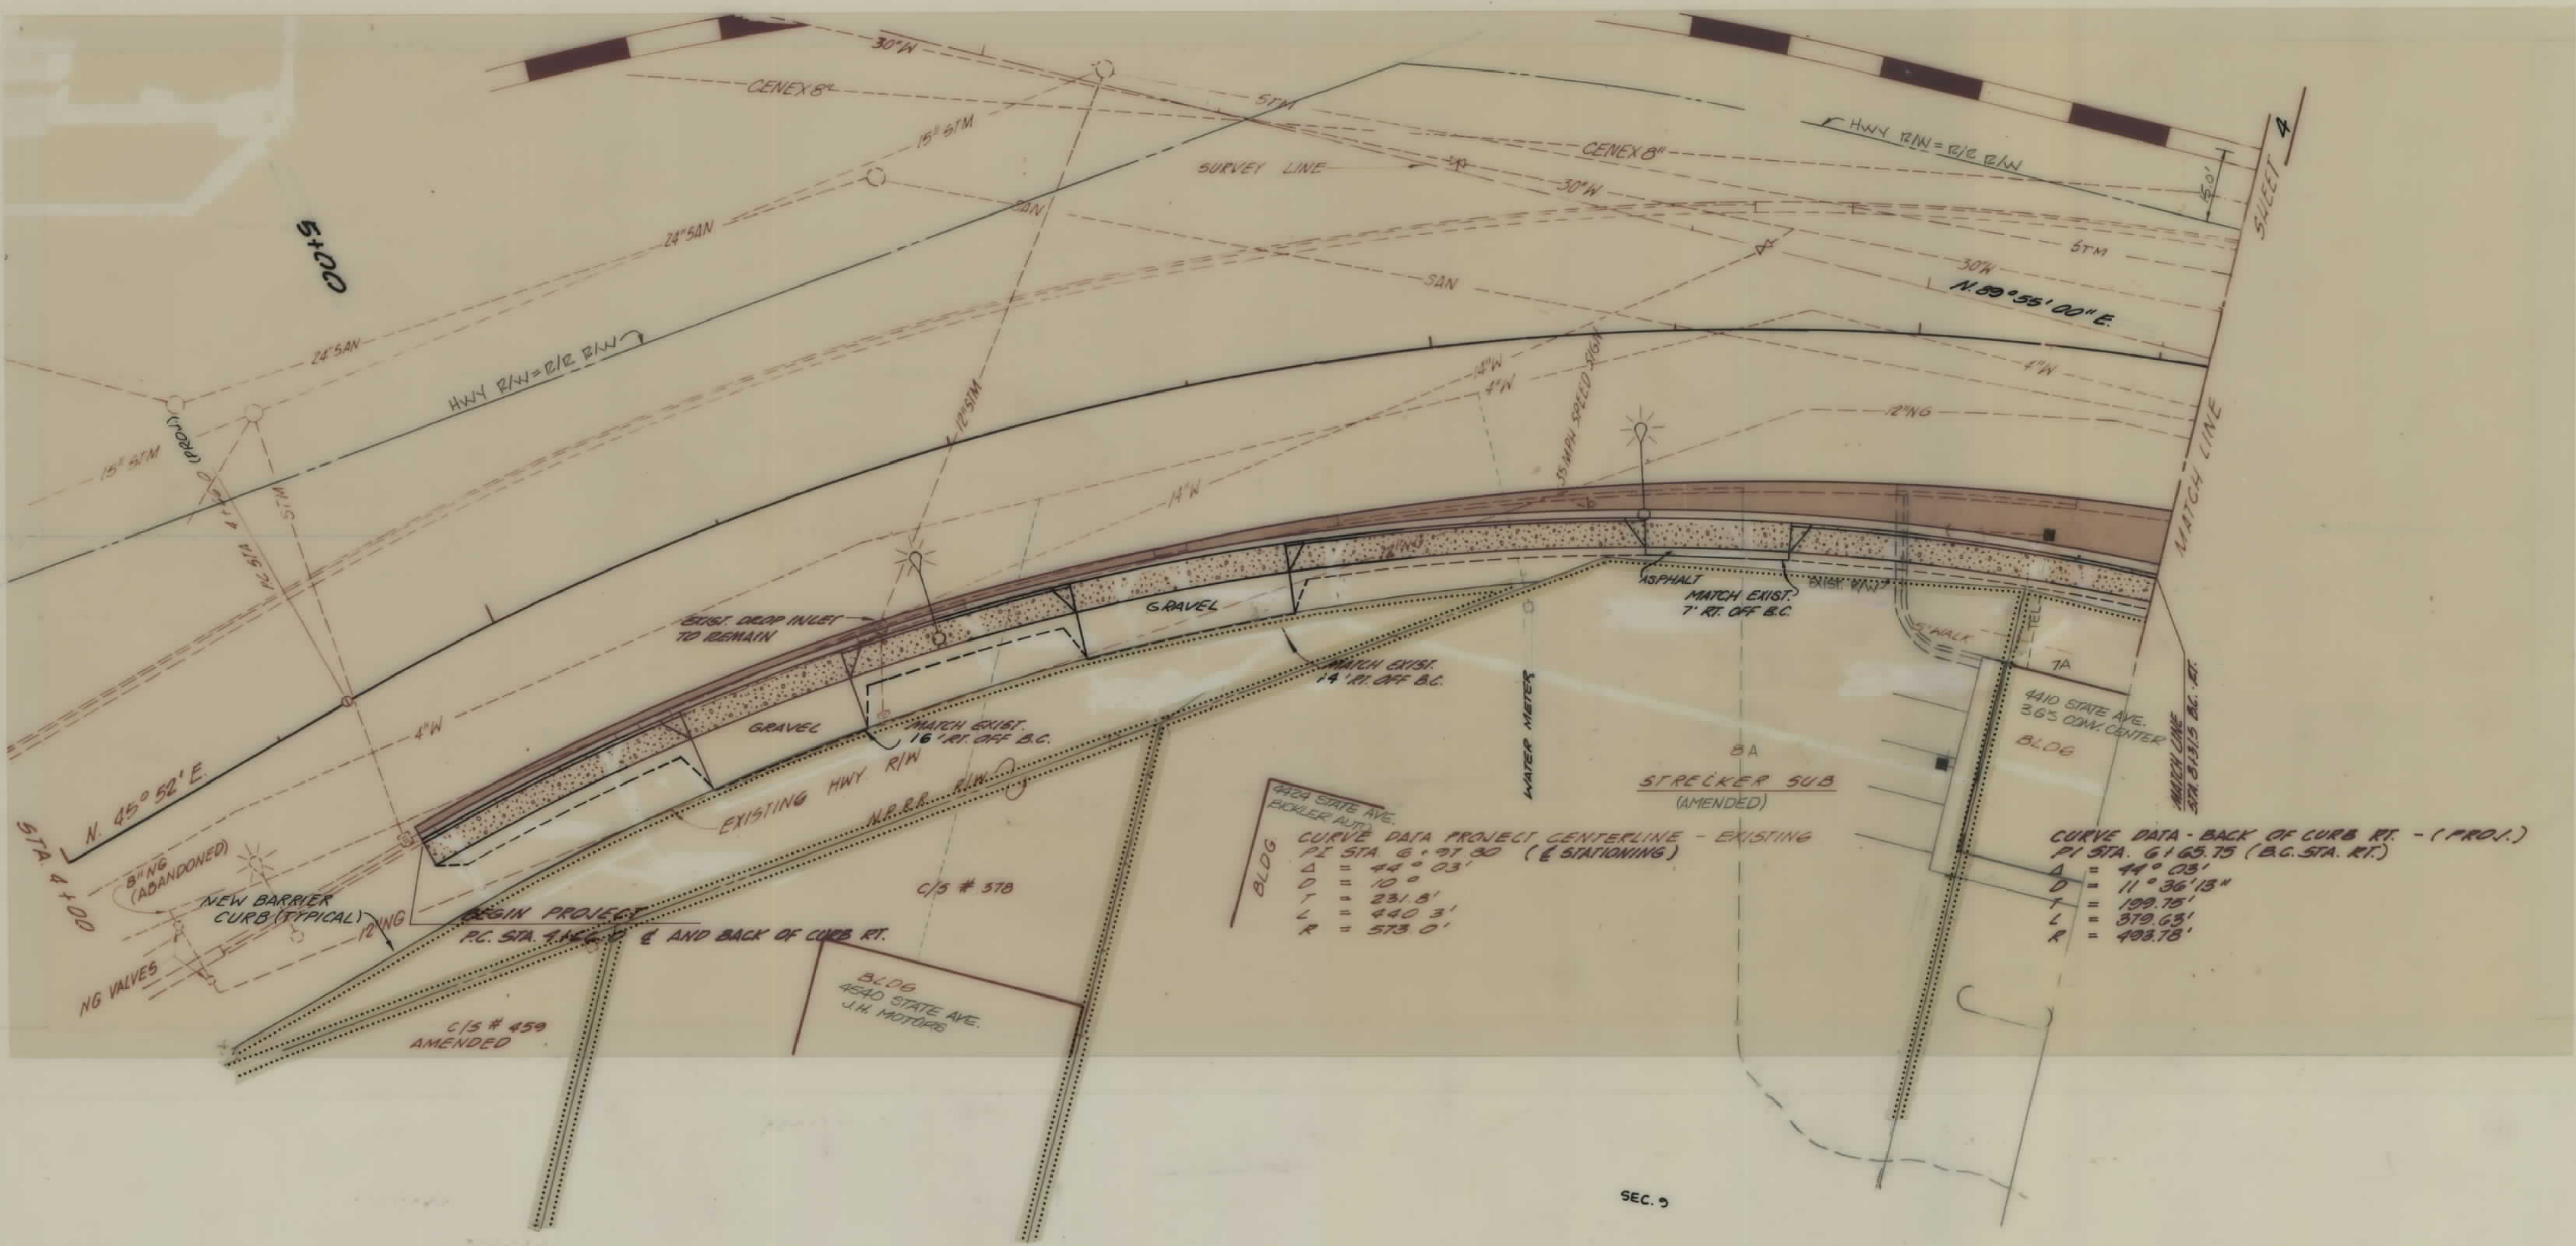

F.H.W.A. APPROVAL 1-4-89

OWNERSHIP										
PARCEL	NAME	ADDRESS	TOTAL	GROSS R/W	P.T.W.	AREA TO BE	REMAINDER		CONST.	EASEMENT
			AREA	AREA	AREA	ACQUIRED	LEFT	RIGHT	PERM. AREA	AREA
2	* DELETED									
3	STATE AVE., PARTNERS	SEE SHEET NO. 5								
62	DELETED									
69	BURLINGTON NORTHERN RAILROAD	ST. PAUL, MINNESOTA								** 200 SF

* R.O.W. ACQUIRED THROUGH AMENDED PLAT OF LOTS 7 & 8, STRECKER SUB
** EASEMENT FOR NEW TRAFFIC SIGNAL SUPPORTS AS CONSTRUCTED IN THE FIELD

STATE	PROJECT NUMBER	SHEET NO.
MONT.	M1024 (2)	4





H K M ASSOCIATES
ENGINEERS - ARCHITECTS - PLANNERS
Executive Plaza - Airport Industrial Park
P.O. Box 31316, Billings, Montana 59107 (406) 245-8354

No.	REVISIONS	Date
1	11-27-89	1-9-90, 8-21-93, 9-05-93

STATE AVENUE RECONSTRUCTION
RIGHT OF WAY PLANS
APPROVED F.H.W.A. 1-4-89
YELLOWSTONE CO

Sheet No. 4
Project No. 2M025.123
F.H.W.A. 1-4-89

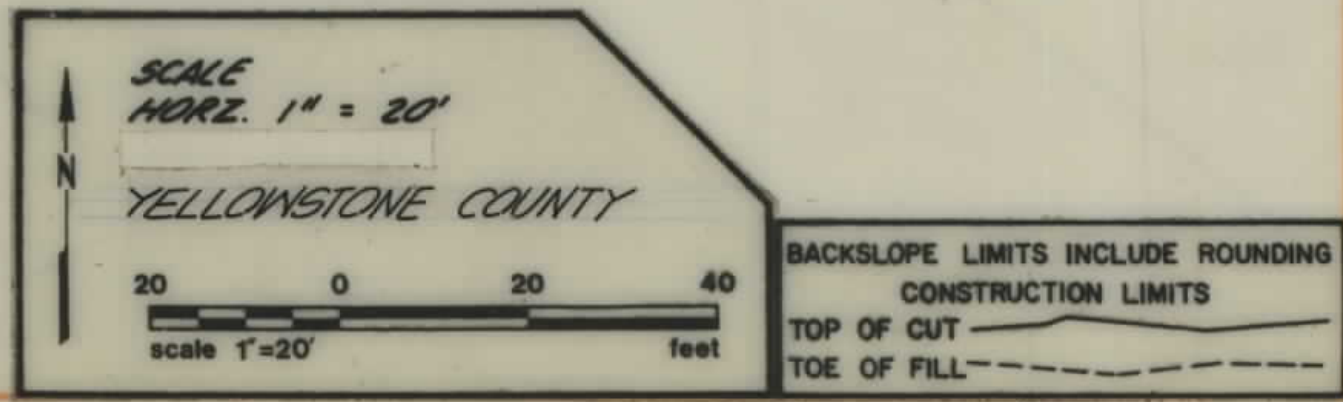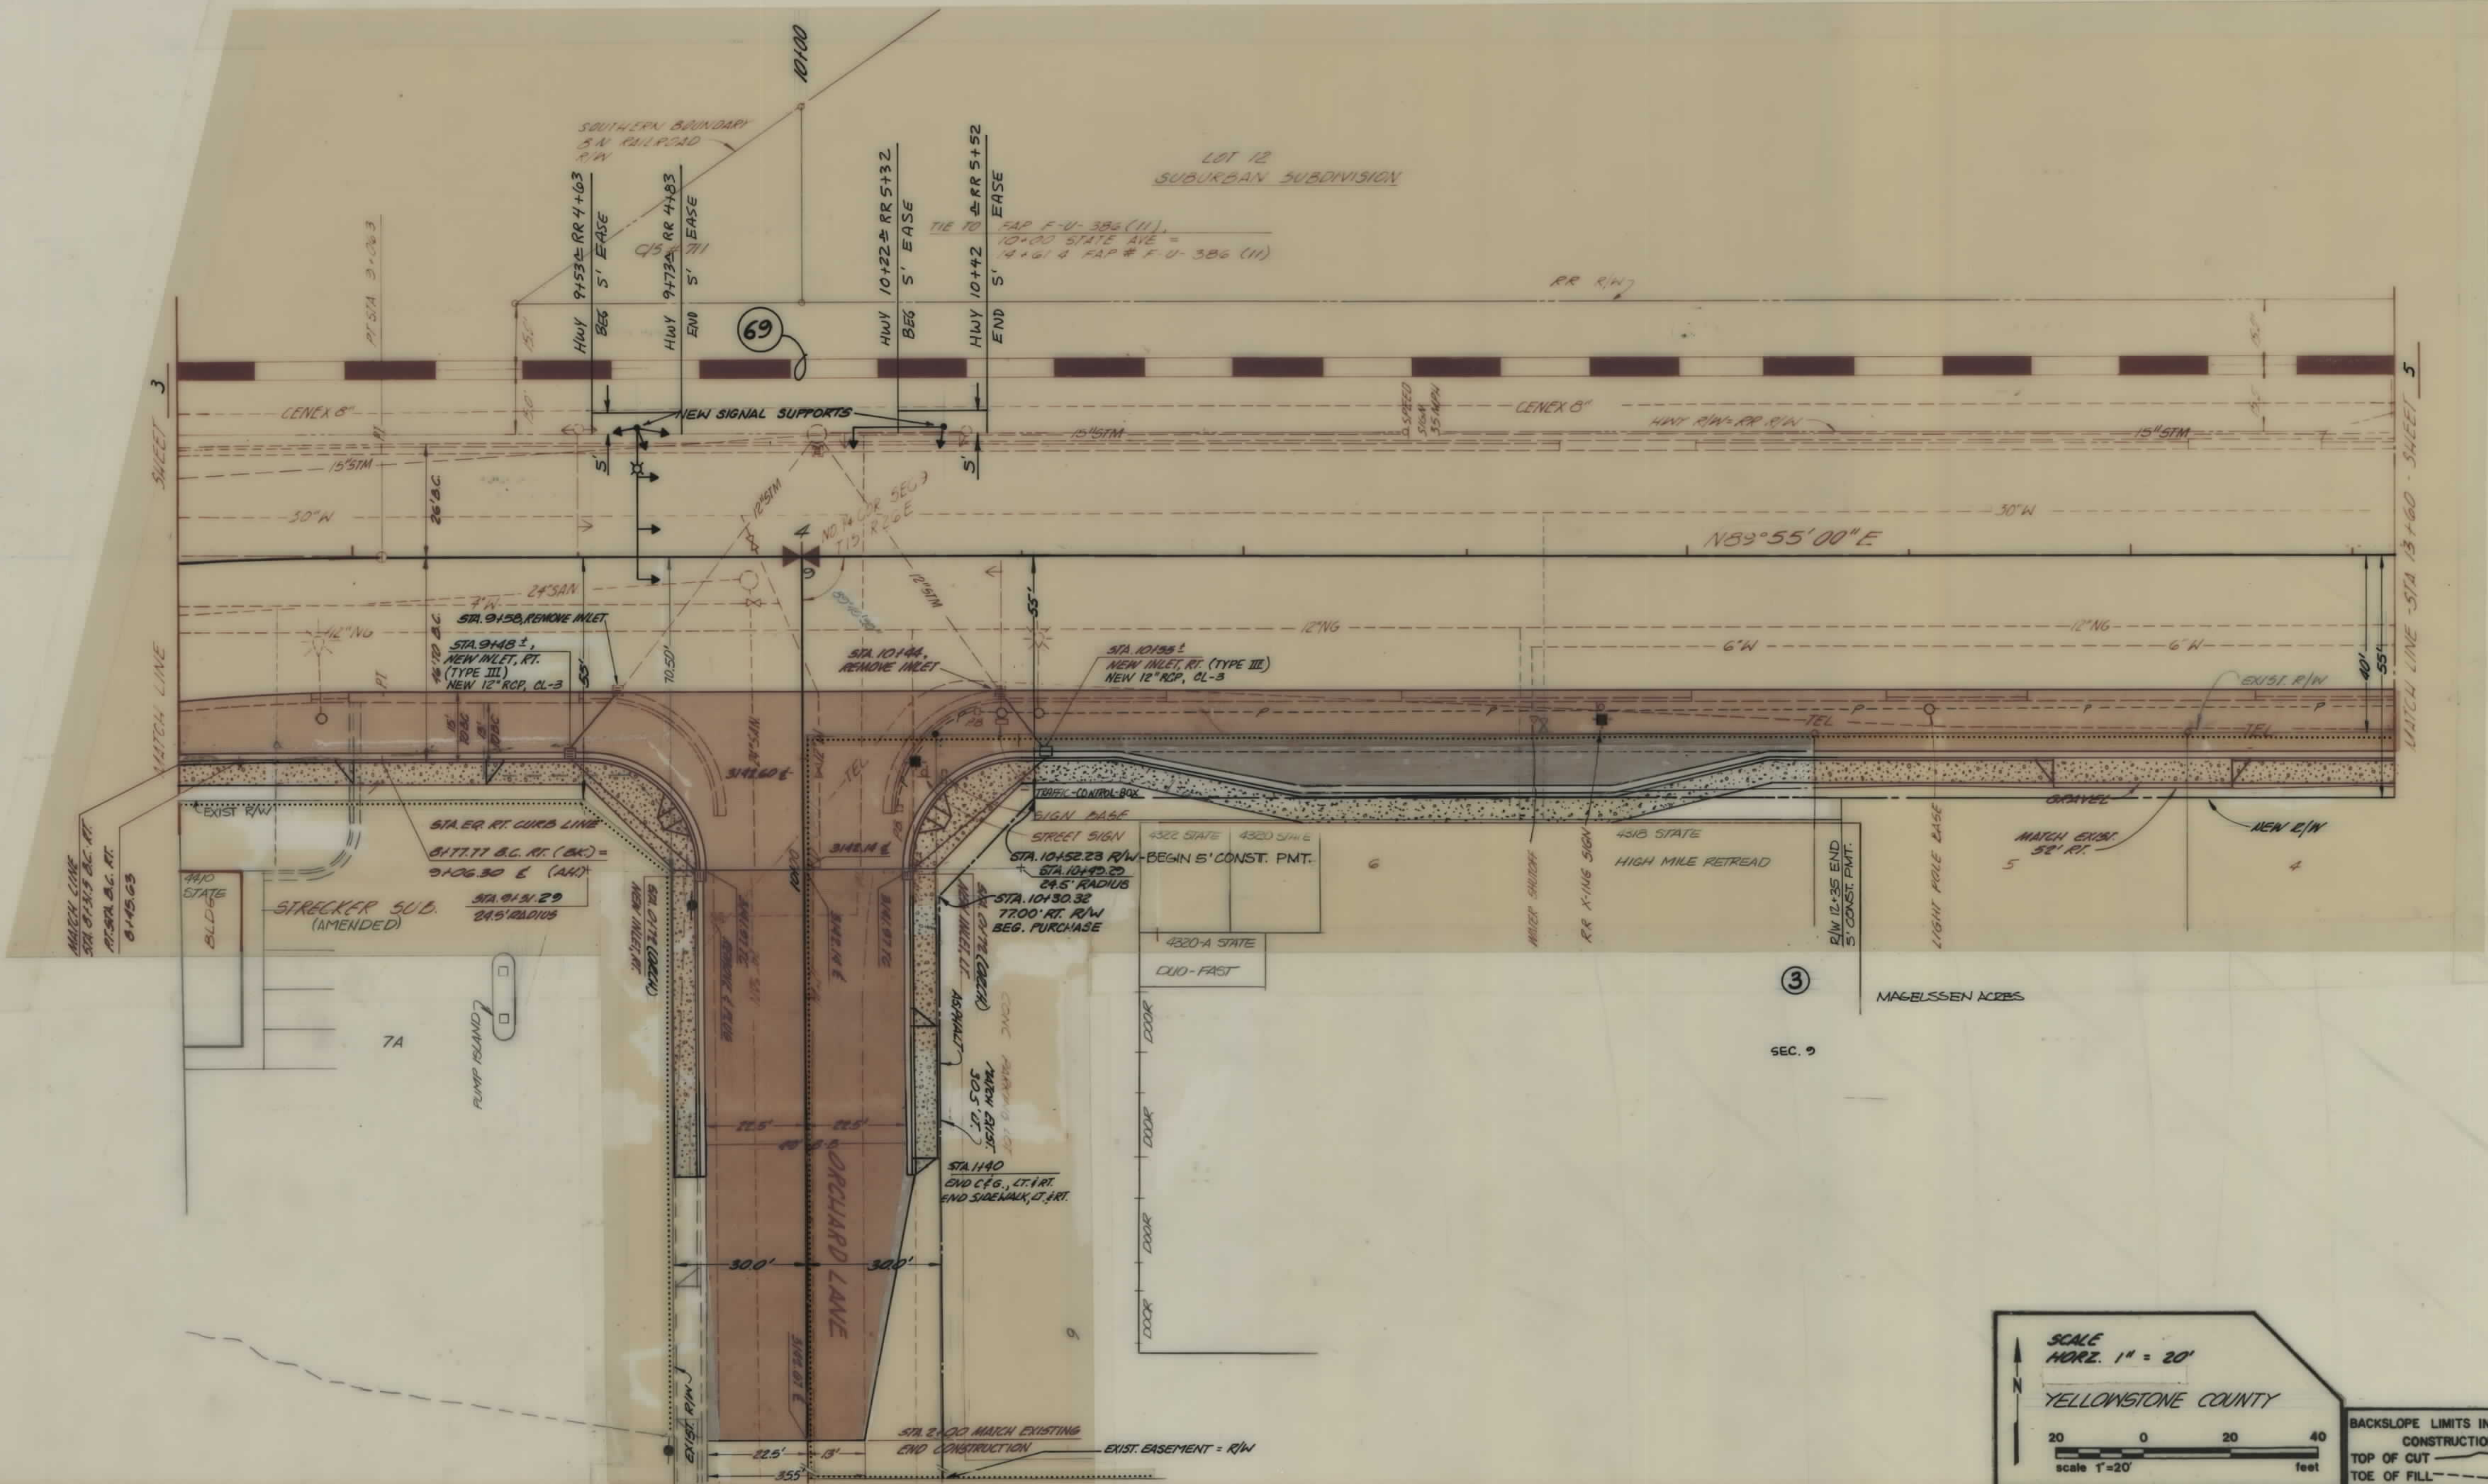

OWNERSHIP										
PARCEL	NAME	ADDRESS	TOTAL AREA	GROSS R/W AREA	P.T.W. AREA	AREA TO BE ACQUIRED	REMAINDER		CONST. PERM. AREA	EASEMENT AREA
3	STATE AVE., PARTNERS	5546 BILLY CASPER BILLINGS, MONTANA 59106	76,064	11,499	5,770	5,729		64,565	914	
4	BURLINGTON NORTHERN RAILROAD	SEE SHEET NO. 11								
5	S.C. RYAN, JR. INC., A MONTANA CORP.	4148 1ST AVENUE SOUTH BILLINGS, MONTANA 59101	54,772	3,435	0	3,435	51,337			
6	E. HOWARD SANDAKER & RAYMOND F. SEDERHOLM	2400 1ST AVENUE SOUTH BILLINGS, MONTANA 59101	16,109	1,259	0	1,259		14,850		
7	GARRETT FREIGHTLINES, INC.	P.O. BOX 5070, DENVER, CO 80217	77,649	2,699	0	2,699		74,950	575	3719 S.F.*
8	ESTHER K. SACKMAN & GLORIA R. TOD	P.O. BOX 214, BILLINGS, MT 59103	18,000	3,336	0	3,336		14,664	750	
63	GARRETT FREIGHTLINES, INC.	P.O. BOX 5070, DENVER, CO 80217	137,997	1,886	0	1,886		136,111		
7463	GARRETT FREIGHTLINES, INC.	P.O. BOX 5070, DENVER, CO 80217	215,646	4,585	0	4,585		211,061	575	150
62	DELETED									

* EASEMENT TO BE ACQUIRED IN THE NAME OF PARCEL 6.



STATE	PROJECT NUMBER	SHEET NO.
MONT.	M1024 (2)	5



H K M ASSOCIATES
ENGINEERS - ARCHITECTS - PLANNERS
Executive Plaza - Airport Industrial Park
P.O. Box 31316, Billings, Montana 59107 (406) 245-8354
Approved: JACOBSON

REVISION	DATE
11-27-89, 8-27-93, 10-1-93, 10-29-93	

STATE AVENUE RECONSTRUCTION
RIGHT OF WAY PLANS
APPROVED F.H.W.A. 1-4-89
YELLOWSTONE CO.
Project No. 2M025.123
Date: DEC. 1981
Drawn: D1-DCR-D86
Checked: WASH

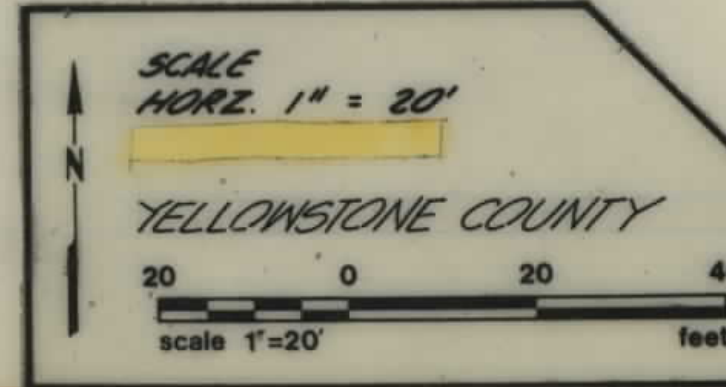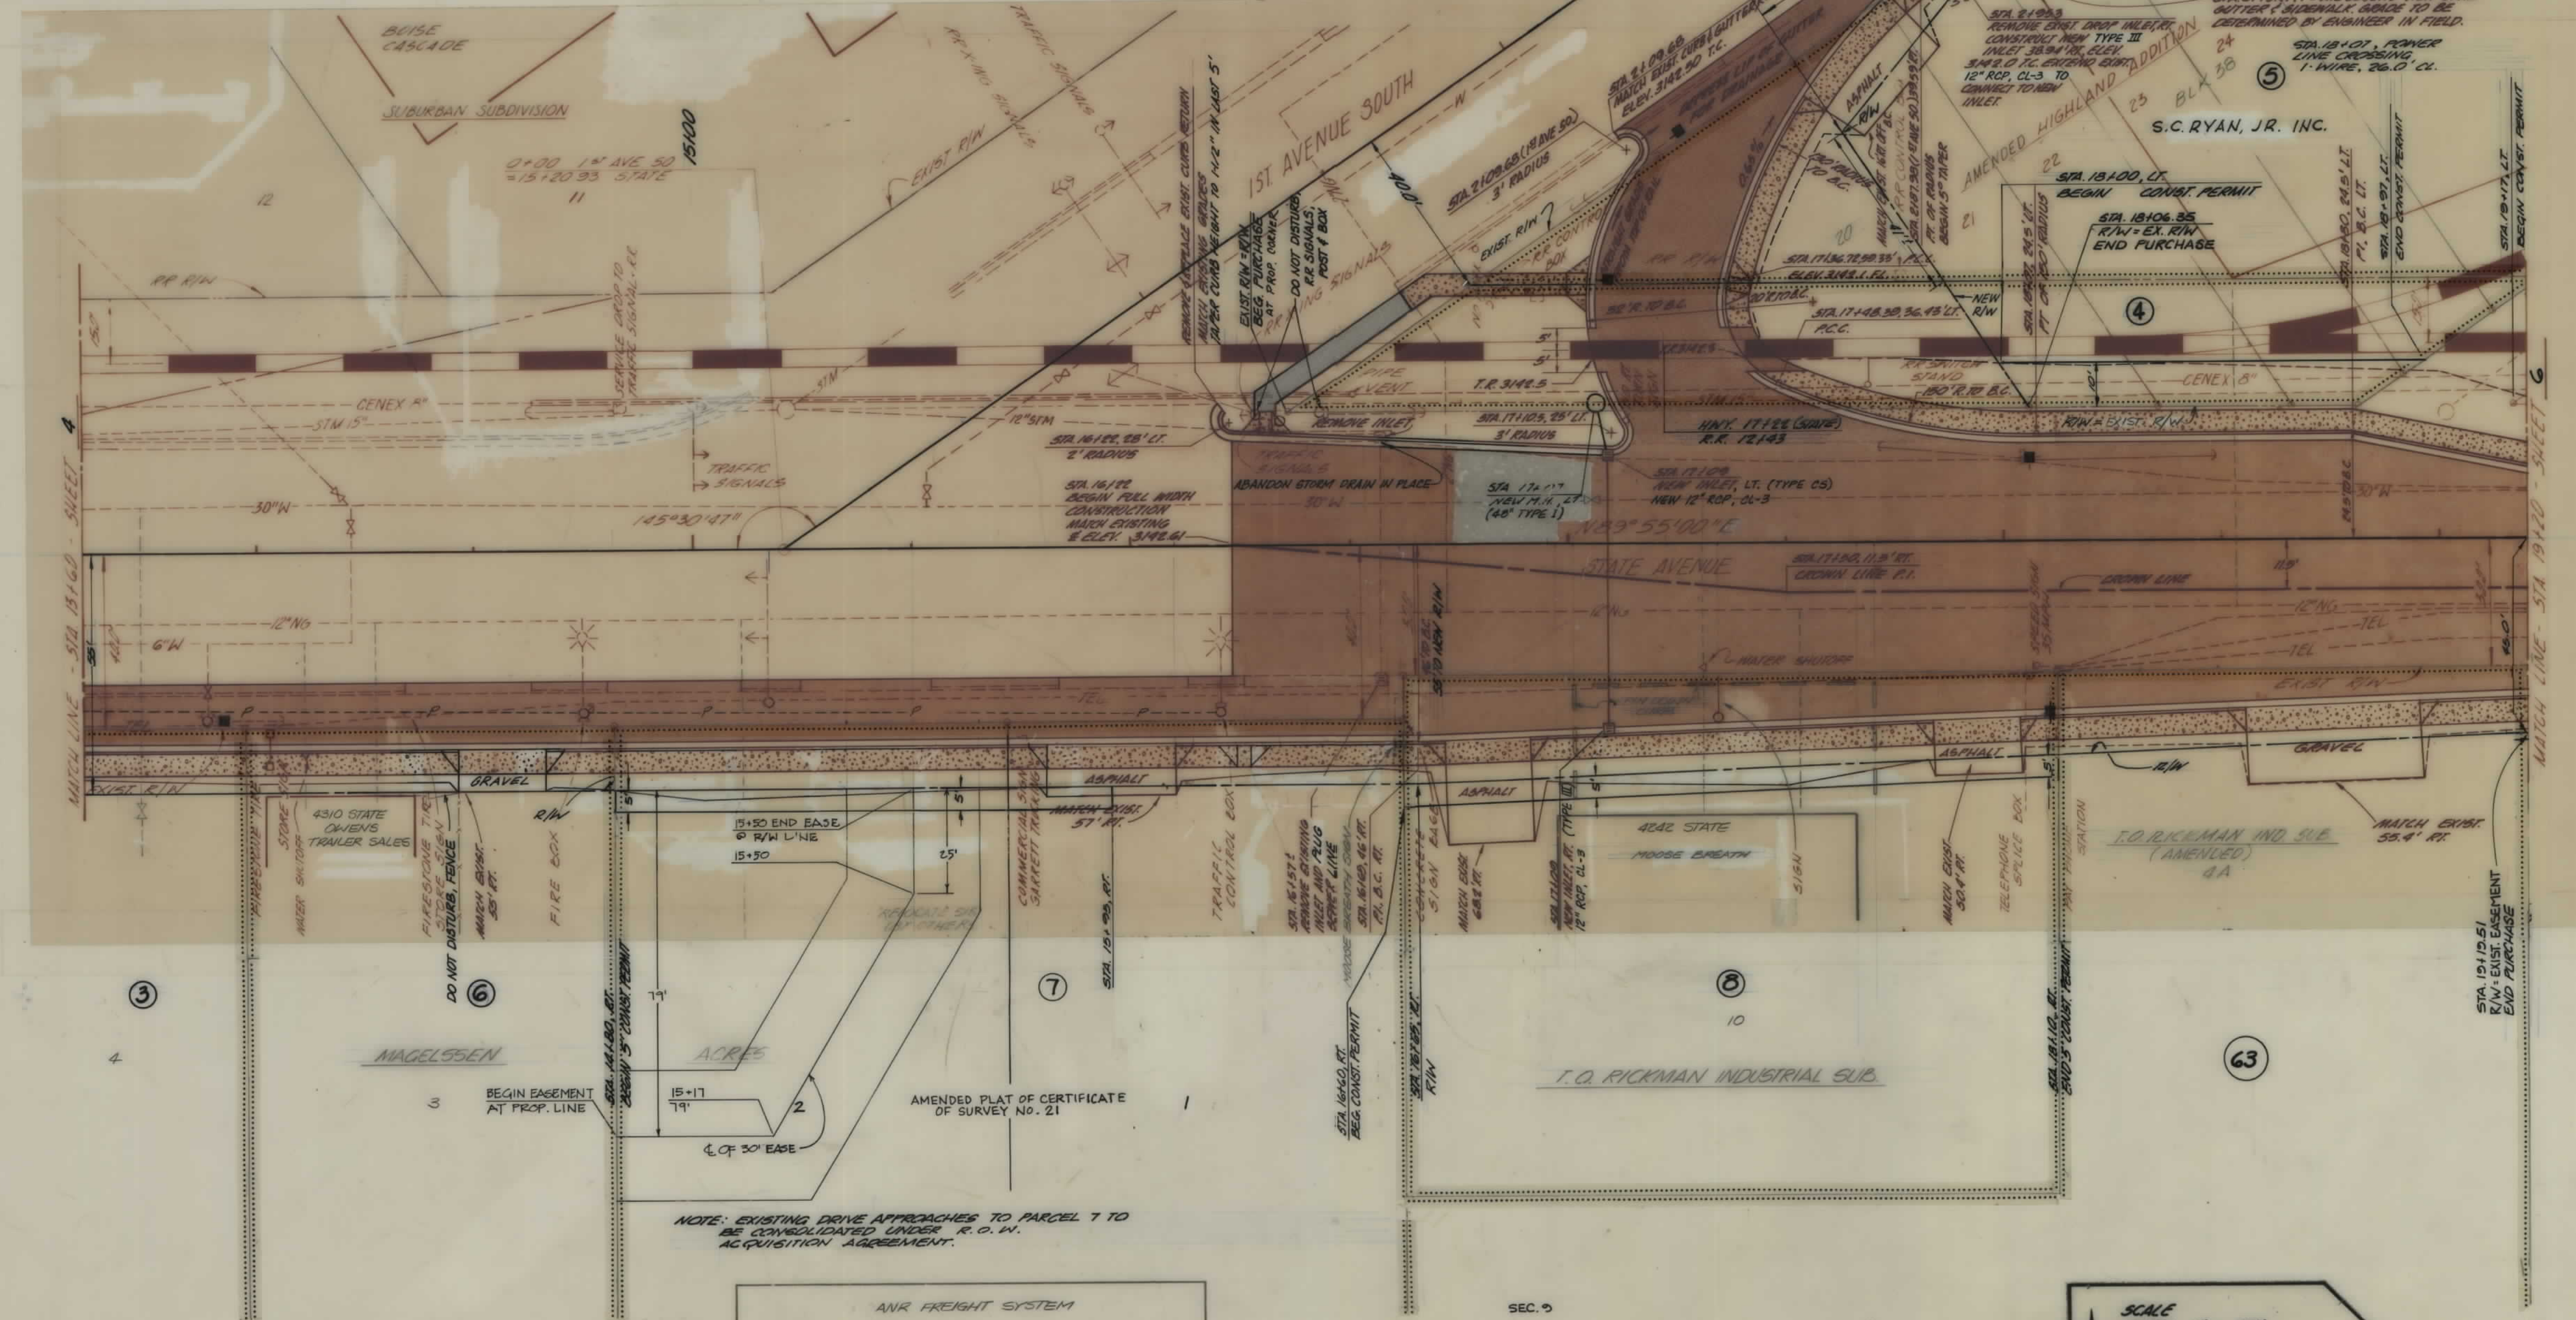

BACKSLOPE LIMITS INCLUDE ROUNDING
CONSTRUCTION LIMITS
TOP OF CUT
TOE OF FILL

OWNERSHIP										
PARCEL	NAME	ADDRESS	TOTAL AREA	GROSS R/W AREA	P.T.W. AREA	AREA TO BE ACQUIRED	REMAINDER		CONST. PERM. AREA	EASEMENT AREA
4	BURLINGTON NORTHERN RAILROAD	SEE SHEET NO. 11								
9	DANIAL W. DIMICH, JR.	1105 PARKHILL DRIVE BILLINGS MONTANA 59101							213	
10	DELETED									
11	ED CONLITZ SHOPPING CENTER, INC.	SEE SHEET NO. 7								
62	DELETED									



STATE	PROJECT NUMBER	SHEET NO.
MONT.	M1024 (2)	6




H&M ASSOCIATES
ENGINEERS - ARCHITECTS - PLANNERS
Executive Plaza - Airport Industrial Park
P.O. Box 31318, Billings, Montana 59107 (406 245 8354)
Checked: WLSA
Approved: JACOBSON

No.	REVISIONS	Date
1		11-27-89, 12-28-89

STATE AVENUE RECONSTRUCTION
RIGHT OF WAY PLANS
APPROVED F.H.W.A. 1-4-89
YELLOWSTONE CO.
Project No. 2M025.123
Sheet No. 6

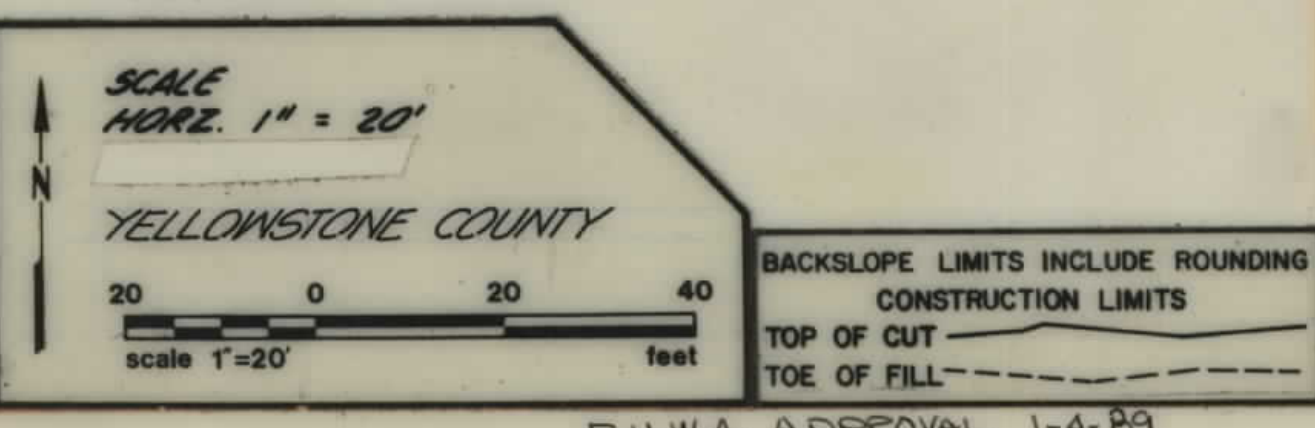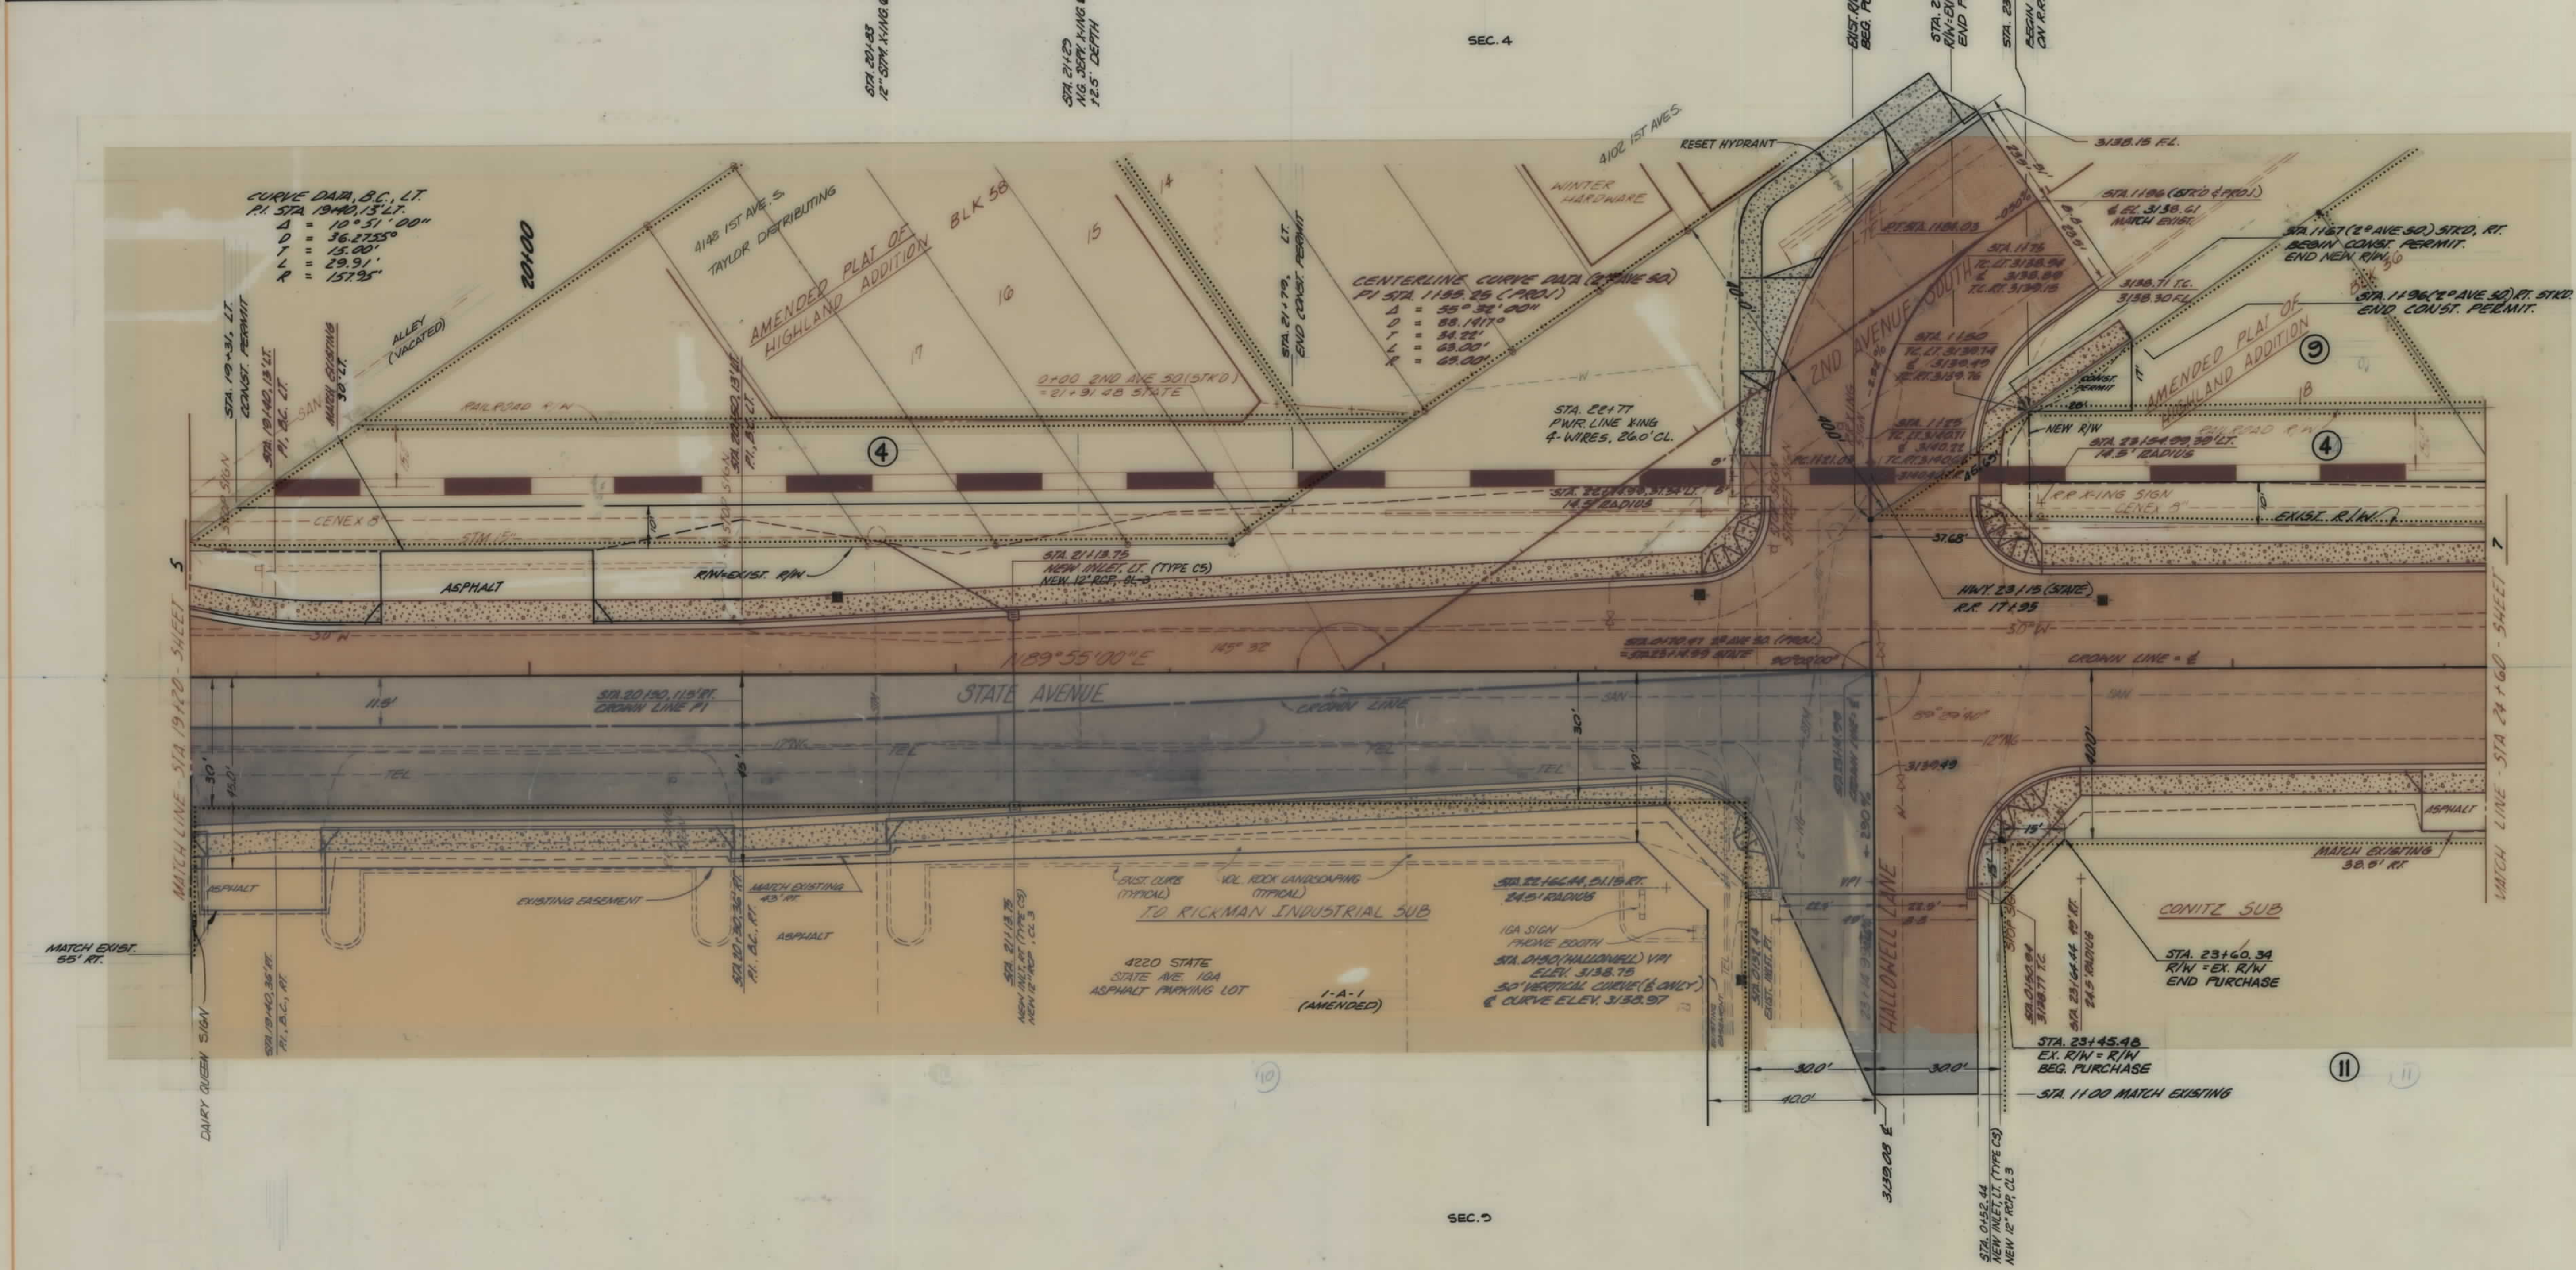

OWNERSHIP										
PARCEL	NAME	ADDRESS	TOTAL	GROSS R/W	P.T.W.	AREA TO BE	REMAINDER		CONST. PERM. AREA	EASEMENT AREA
			AREA	AREA	AREA	ACQUIRED	LEFT	RIGHT		
4	BURLINGTON NORTHERN RAILROAD	SEE SHEET NO. 11								
11	ED CONLITZ SHOPPING CENTER, INC.	2643 COUNTRY LANE BILLINGS, MONTANA 59102	73,056	113	0	113		72,943		
12	WINFREY, EDITH N.	SEE SHEET NO. 8								
13	FAIST, ANDREW & LEOCARDIA ROBERT J. BRUCE & ARTHUR A. MICHELISIC	4104 STATE AVENUE BILLINGS, MONTANA 59101	41,738	3,795	3,036	759		37,943	1,500	
62	DELETED	SEE SHEET NO. 8								

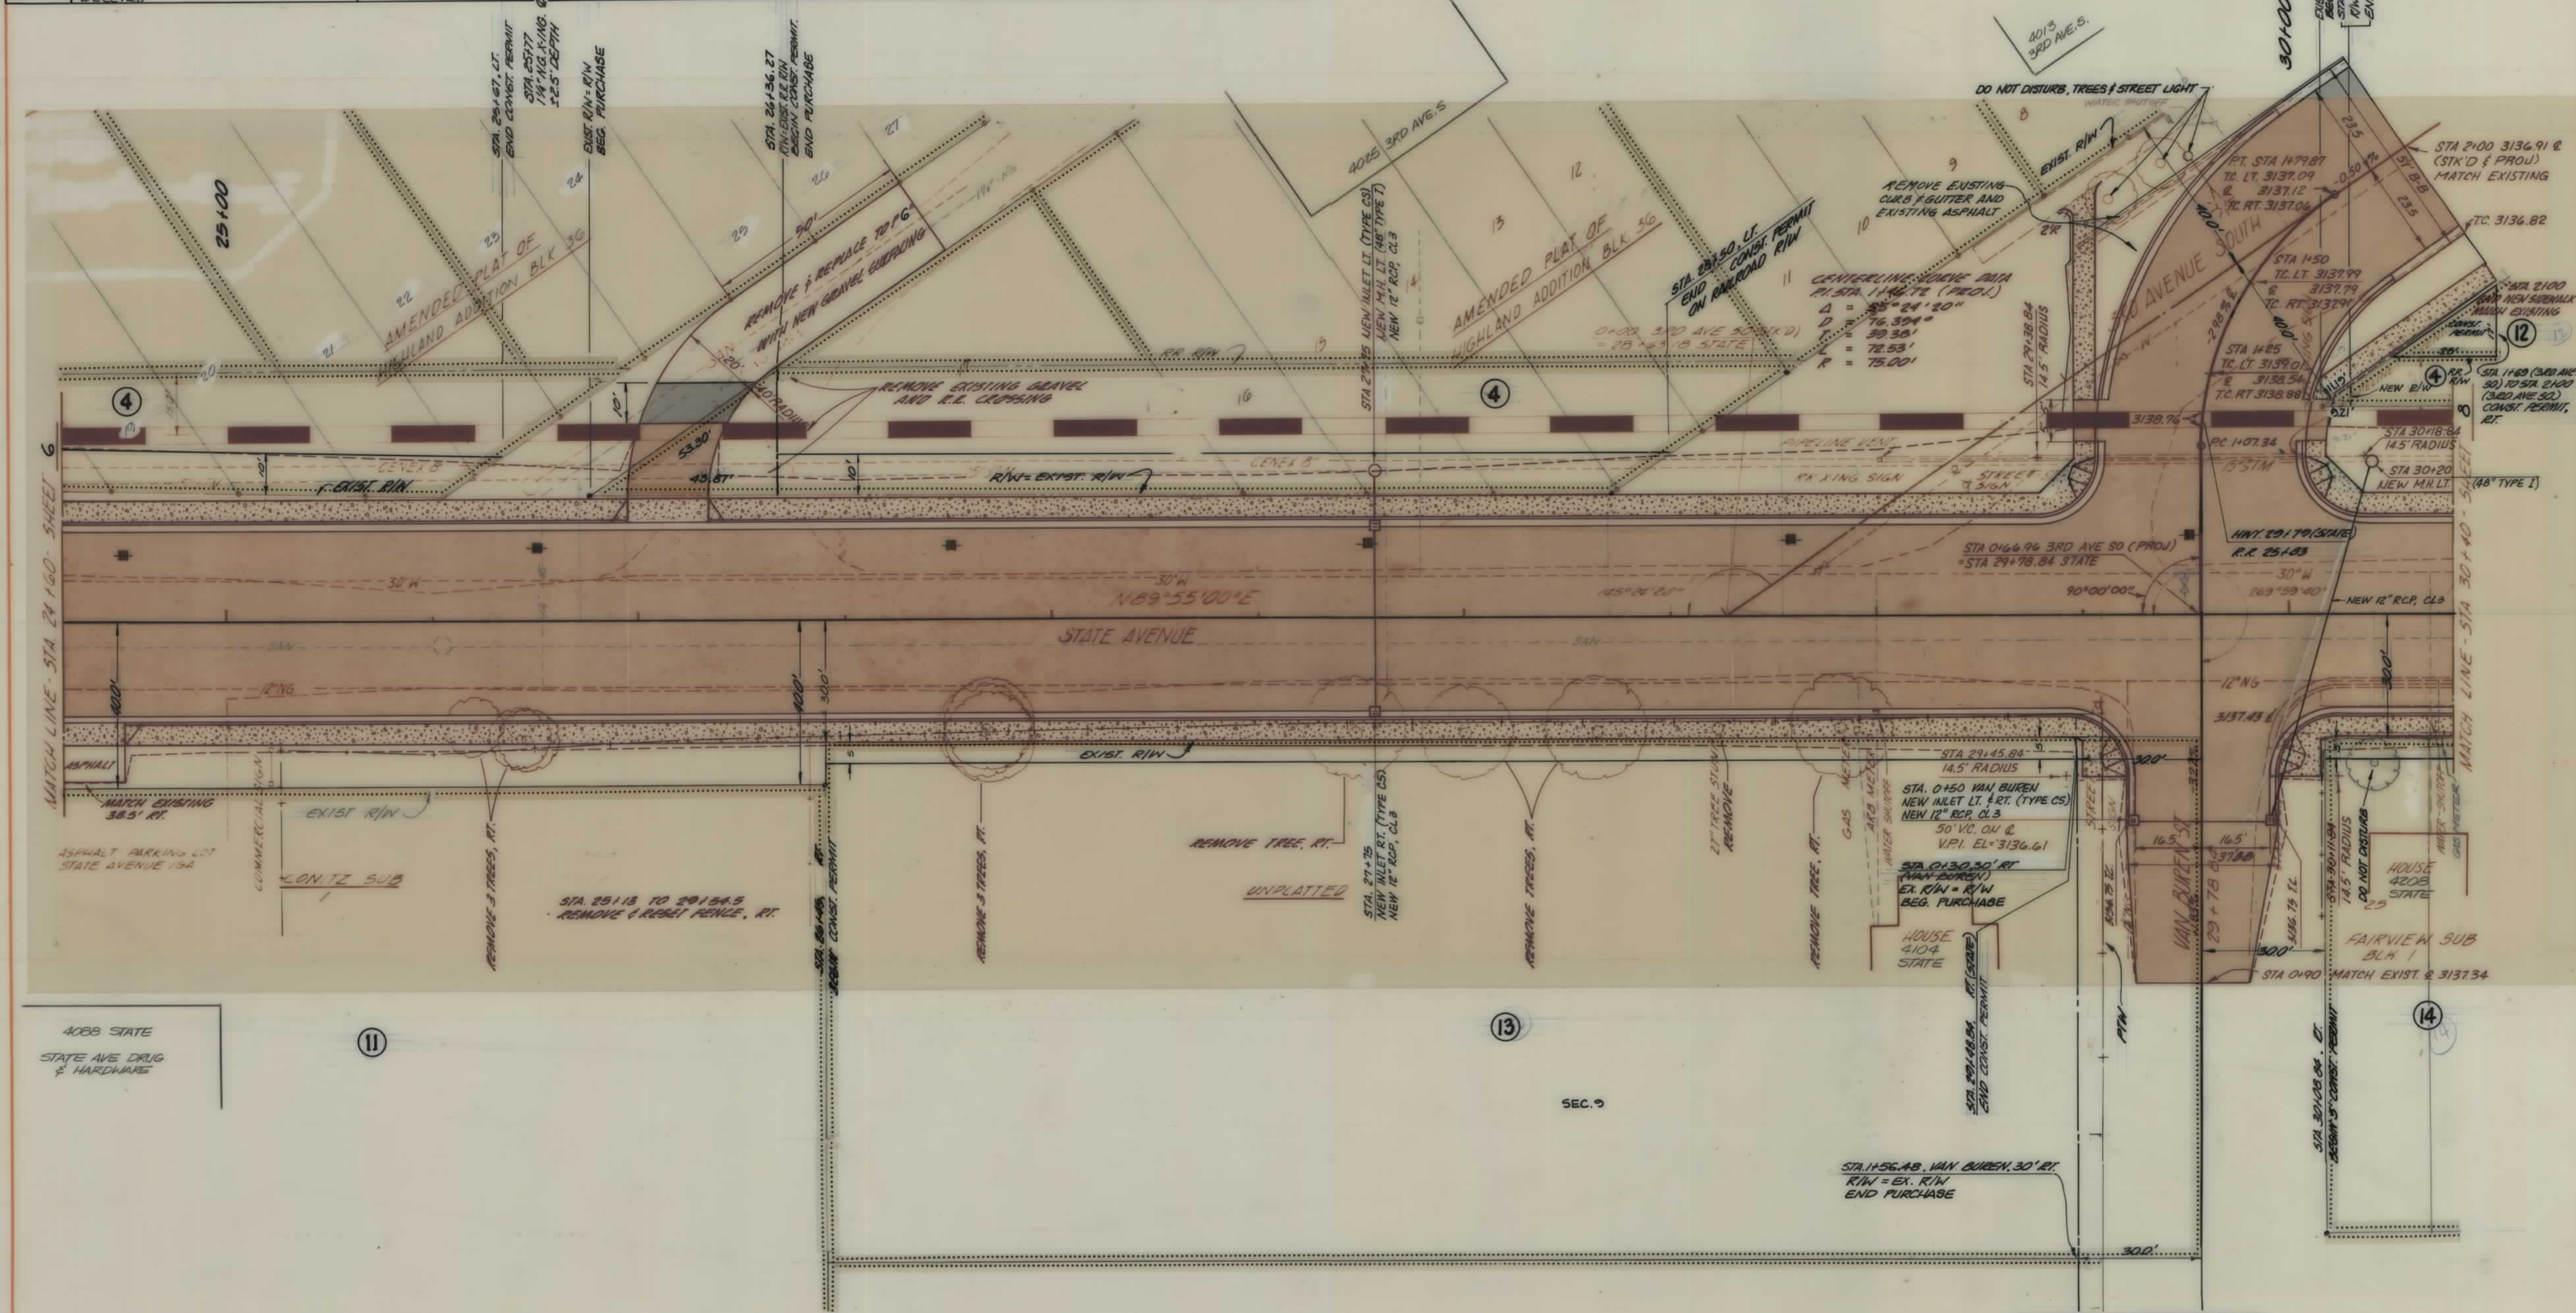

4088 STATE
STATE AVE DRUG
& HARDWARE

SCALE
HORIZ. 1" = 20'

YELLOWSTONE COUNTY

scale 1"=20'

feet

BACKSLOPE LIMITS INCLUDE ROUNDING
CONSTRUCTION LIMITS
TOP OF CUT
TOE OF FILL

F.H.W.A. APPROVAL 1-4-89

STATE	PROJECT NUMBER	SHEET NO.
MONT.	M1024 (2)	7

REVISIONS

No.	Date
1	11-27-89

STATE AVENUE RECONSTRUCTION

RIGHT OF WAY PLANS

APPROVED F.H.W.A. 1-4-89

YELLOWSTONE CO.

PROJECT No. 210225.23

Sheet No. 7

01 22

DATE DEC. 1981

Drawn: DT-DCR-DAG

Checked: WASH

Approved: JACOBSON

Montana

RICHARD L. JACOBSON

5657 E

PROFESSIONAL ENGINEER


H&M ASSOCIATES

ENGINEERS - ARCHITECTS - PLANNERS

Executive Plaza - Airport Industrial Park

P.O. Box 31318, Billings, Montana 59107 (406 245 6354)

OWNERSHIP										
PARCEL	NAME	ADDRESS	TOTAL AREA	GROSS R/W AREA	P.T.W. AREA	AREA TO BE ACQUIRED	REMAINDER		CONST. PERM. AREA	EASEMENT AREA
							LEFT	RIGHT		
4	BURLINGTON NORTHERN RAILROAD	SEE SHEET NO. 11								
21	J. & K. VENTURES	P.O. BOX 20799 BILLINGS, MONTANA 59104	18,740	200	0	200		18,550	1,051	
22	ADMIN. OF VET. AFFAIRS	VETERANS ADMINISTRATION WASHINGTON, D.C. 20420	6,250	200	0	200		6,050	575	
23	HARRY & RUTH KUYATT	2 MONROE STREET BILLINGS, MONTANA 59102							625	
24	ADAM SCHAFF	SEE SHEET NO. 10								
62	DELETED									

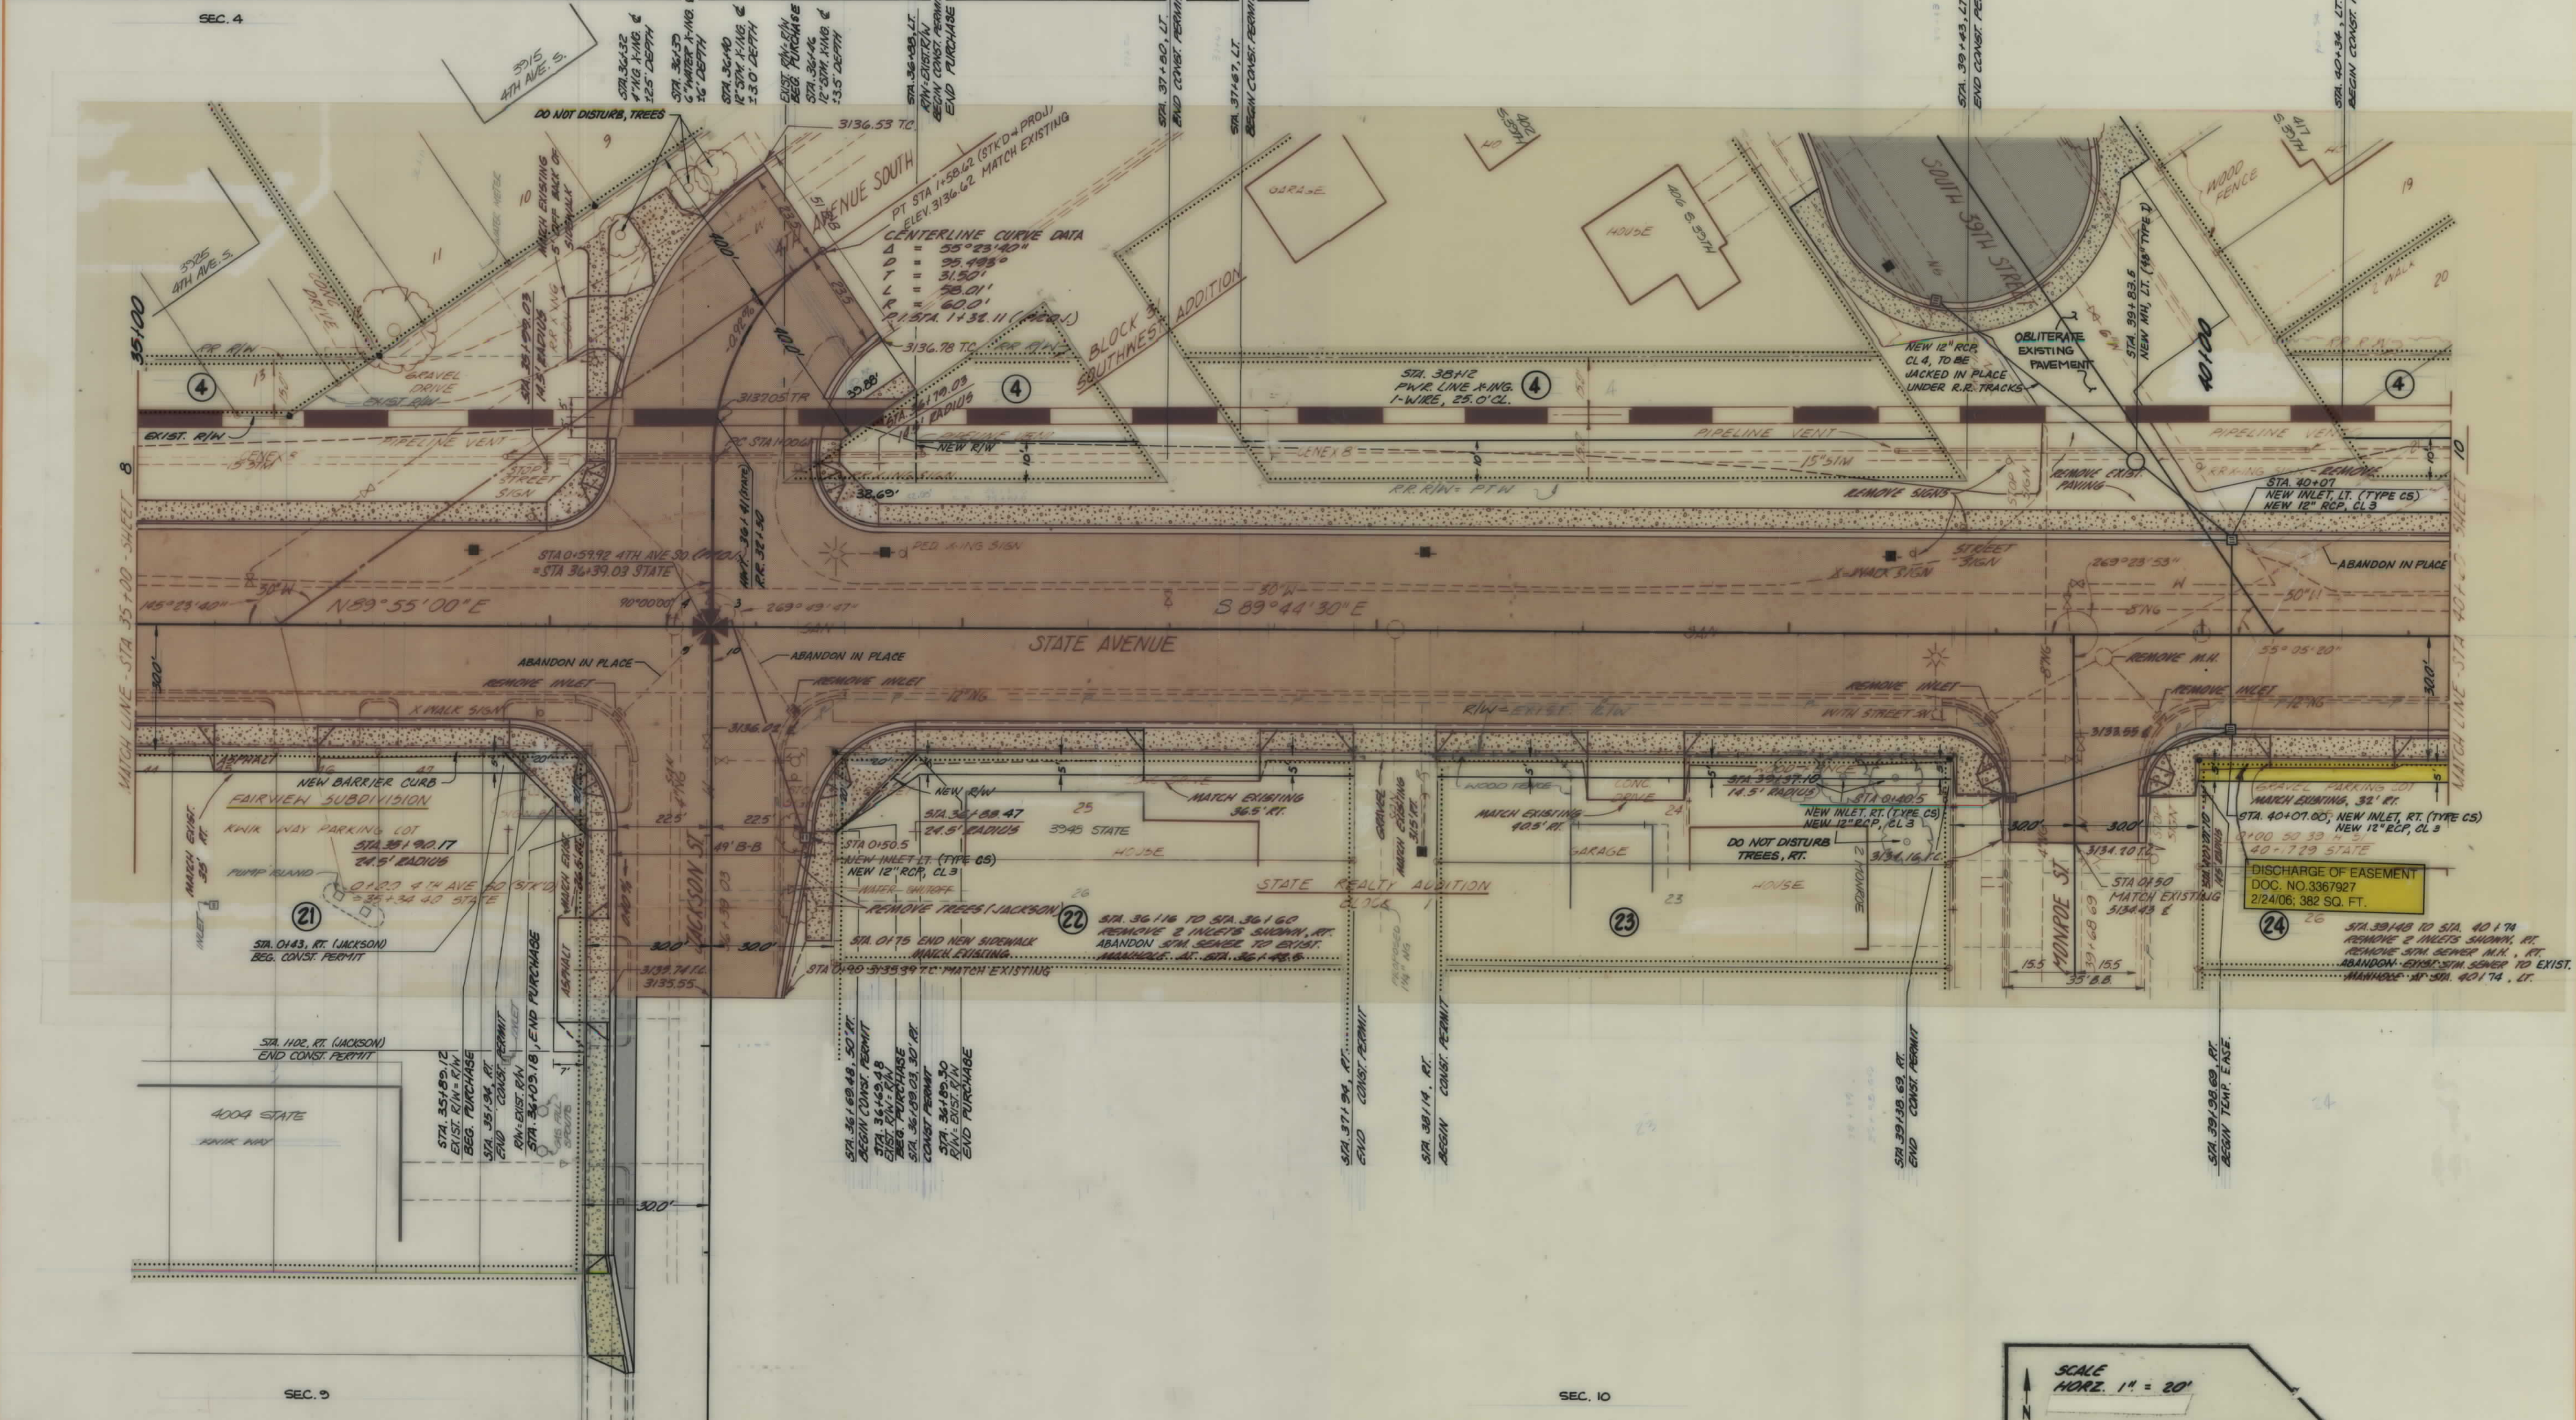

T. 1 S. N. R. 26 E.

SEC. 3

SEC. 10

STA 35+42
4" W. KING &
12" S. DEPTH

STA 35+63
6" W. KING &
12" S. DEPTH

STA 35+87
12" S. KING &
12" S. DEPTH

STATE	PROJECT NUMBER	SHEET NO.
MONT.	M1024 (2)	9



H K M ASSOCIATES
ENGINEERS - ARCHITECTS - PLANNERS
Executive Plaza - Airport Industrial Park
P.O. Box 31318, Billings, Montana 59107 (406) 245-6354

DATE: DEC. 1991

REVISIONS

No.	Date	Description
1	11-27-89	12-28-89, 8-15-90

Project No. 2M025/123

Sheet No. 9

22

STATE AVENUE RECONSTRUCTION

RIGHT OF WAY PLANS


APPROVED F.H.W.A. 1-4-89

YELLOWSTONE CO.

Drawn: DT-DCR-DB-6


Checked: M354

Approved: JACOBSON

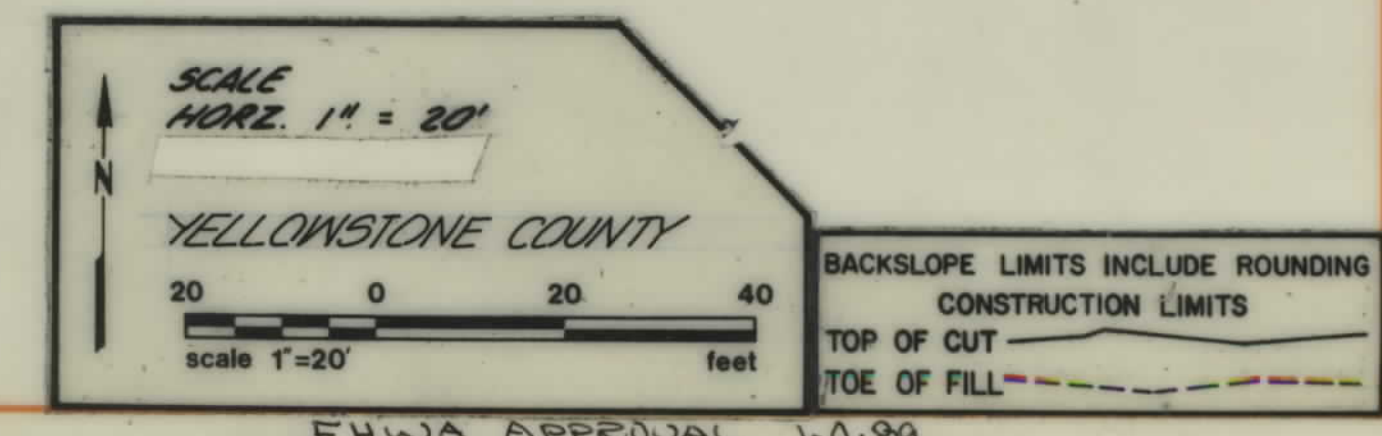

FHWA APPROVAL 1-4-89

PARCEL	NAME	ADDRESS	OWNERSHIP		TOTAL AREA	GROSS R/W AREA	P.T.W. AREA	AREA TO BE ACQUIRED	REMAINDER		CONST. FERM. AREA	EASEMENT AREA
									LEFT	RIGHT		
4	BURLINGTON NORTHERN RAILROAD	SEE SHEET NO. 11										
24	ADAM SCHAFF	3 MONROE STREET BILLINGS, MONTANA 59102										382 sq. ft.
25	TERRANCE & BETTY J. BEYERS	2 JEFFERSON STREET BILLINGS, MONTANA 59102										625 sq. ft.
26	RONALD V. FODE	SEE SHEET NO. 11										
62	DELETED											
66	DENNIS L. & CYNTHIA HUMPHRY	3 JEFFERSON STREET BILLINGS, MONTANA 59102										625
67	RONALD V. FODE											

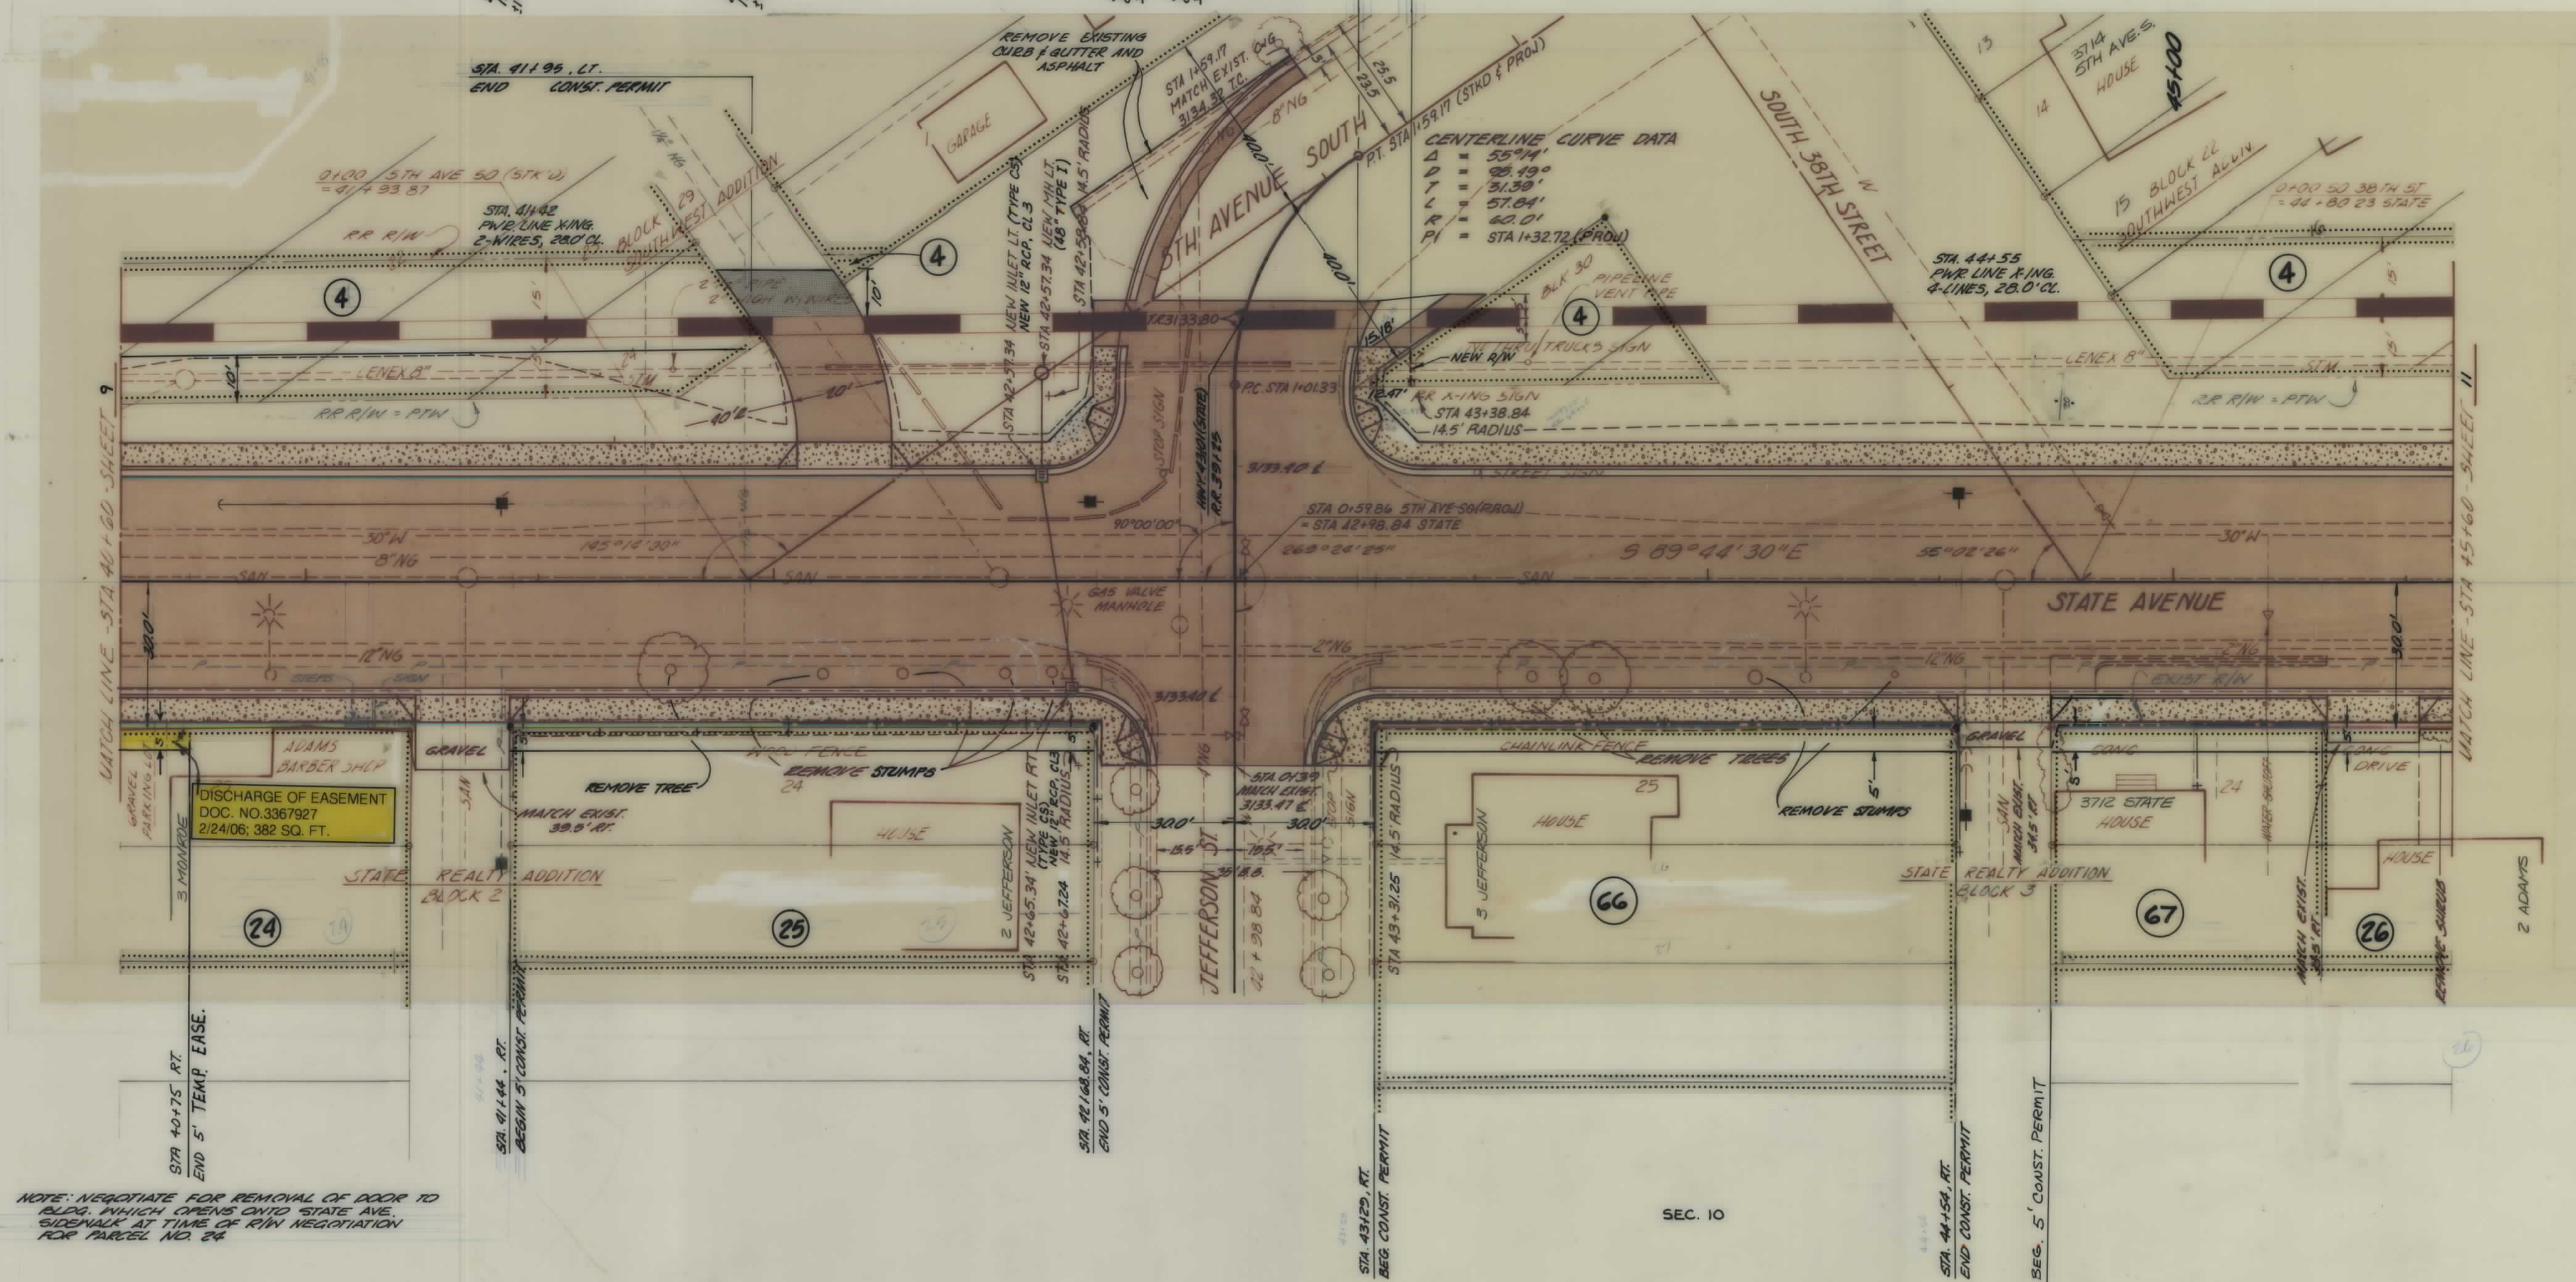


STATE	PROJECT NUMBER	SHEET NO.
MONT.	M1024 (2)	10



H K M ASSOCIATES
ENGINEERS - ARCHITECTS - PLANNERS
 Executive Plaza - Airport Industrial Park
 P.O. Box 31318, Billings, Montana 59107 (406 245 6354)

No.	REVISIONS	Date
1	11-27-89, 12-28-89, 8-13-90	

STATE AVENUE RECONSTRUCTION
RIGHT OF WAY PLANS
 APPROVED F.H.W.A. 1-4-89
 YELLOWSTONE CO.
 Project No. 2M025.123
 Sheet No. 10
 Date: DEC. 1991
 Drawn: DT-DCR-D&G
 Checked: WASH
 Approved: JACOBSON

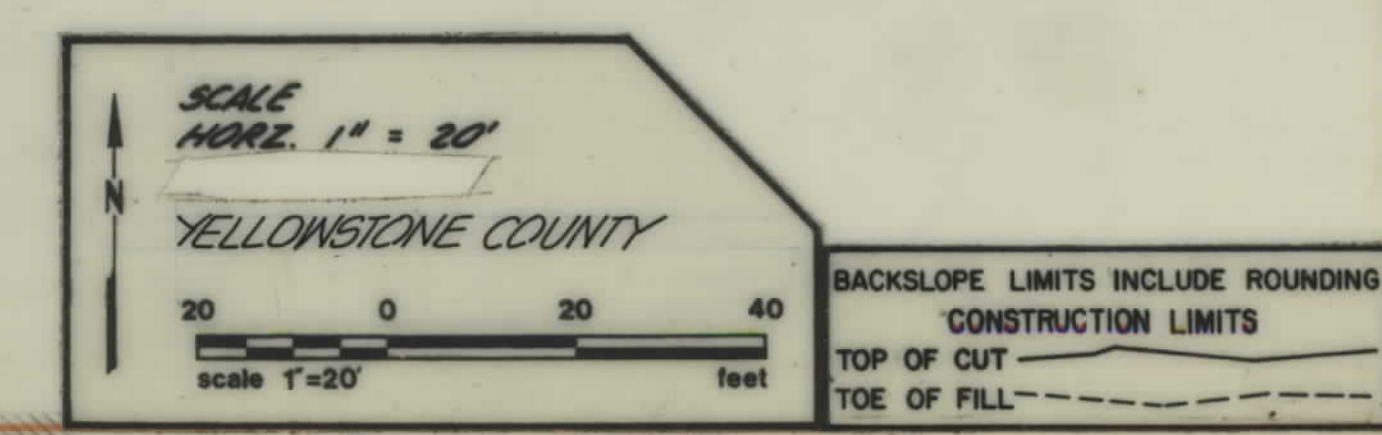

PARCEL	NAME	ADDRESS	OWNERSHIP					REMAINDER		CONST. PERM. AREA	EASEMENT AREA
			TOTAL AREA	GROSS R/W AREA	P.T.W. AREA	AREA TO BE ACQUIRED		LEFT	RIGHT		
4	BURLINGTON NORTHERN RAILROAD	SEE SHEET NO. 11									
21	J. & K. VENTURES	P.O. BOX 20799 BILLINGS, MONTANA 59104	18,740	200	0	200			18,550	1,051	
22	ADMIN. OF VET. AFFAIRS	VETERANS ADMINISTRATION WASHINGTON, D.C. 20420	6,250	200	0	200			6,050	575	
23	HARRY & RUTH KUYATT	2 MONROE STREET BILLINGS, MONTANA 59102								625	
24	ADAM SCHAFF	SEE SHEET NO. 10									
62	DELETED										



STATE	PROJECT NUMBER	SHEET NO.
MONT.	M1024 (2)	9



H K M ASSOCIATES
ENGINEERS - ARCHITECTS - PLANNERS
Executive Plaza - Airport Industrial Park
P.O. Box 31316, Billings, Montana 59107 (406 245 8354)
Approved: JACOBSON

No.	REVISIONS	Date
1	11-27-83	12-28-83, 8-15-90

STATE AVENUE RECONSTRUCTION
RIGHT OF WAY PLANS
APPROVED F.H.W.A. 1-4-89
YELLOWSTONE CO.
Project No. 2M023.03
Sheet No. 9
Date: DEC. 1981
Drawn: DT-DGP-D.B.B. Checked: MUSA

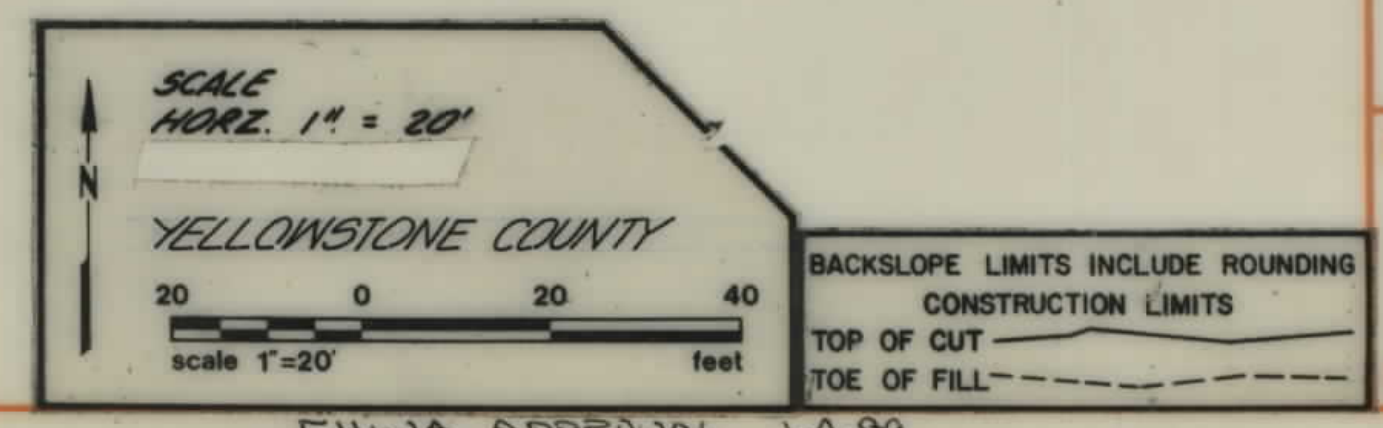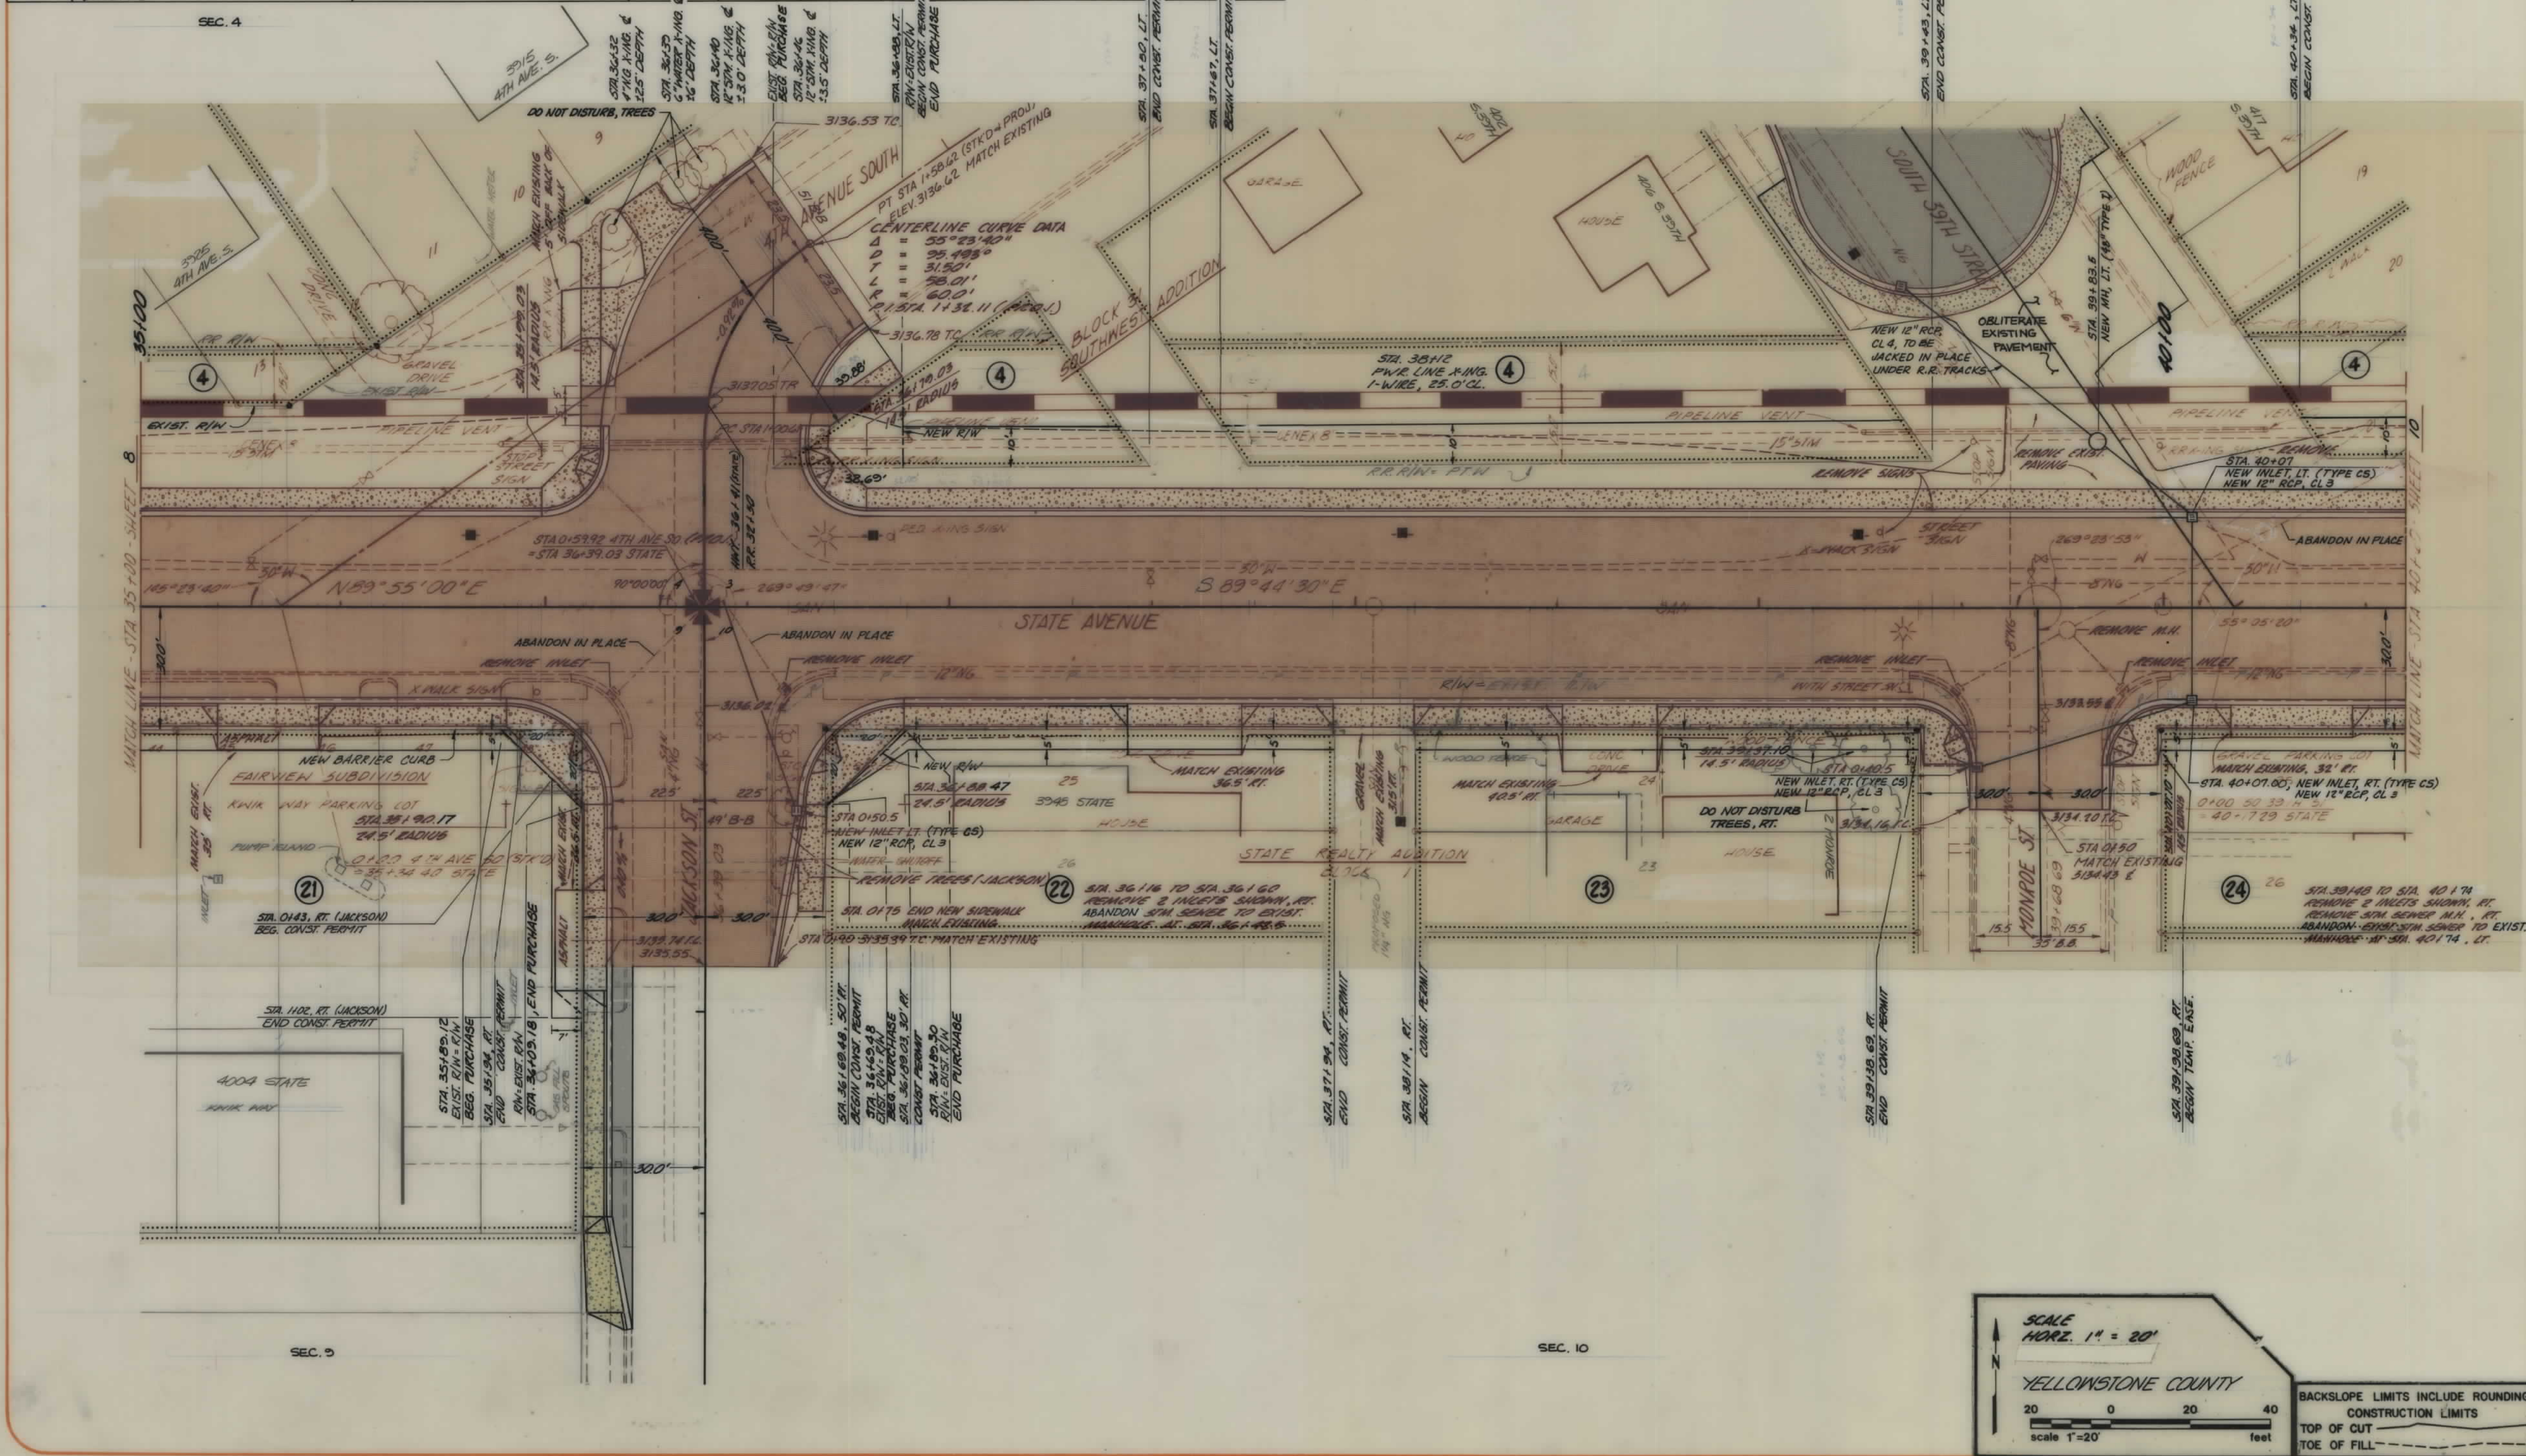

PARCEL	NAME	ADDRESS	TOTAL AREA	OWNERSHIP					REMAINDER	CONST. FERM. AREA	EASEMENT AREA
				GROSS R/W AREA	P.T.W. AREA	AREA TO BE ACQUIRED	LEFT	RIGHT			
4	BURLINGTON NORTHERN RAILROAD	ST. PAUL, MINNESOTA	74,300	6,084	0	6,084	68,216			12,510	
26	RONALD V. FODE	739 HALLOWELL LANE BILLINGS, MONTANA 59101								330	
27	PETER JR. & ZELLAH YEGEN	SEE SHEET NO. 12									
28	JOSE M. & ROSELLA J. RODRIGUEZ	5 ADAMS STREET BILLINGS, MONTANA 59101								1,246	
29	LESTER L. & RICHARD BUGLER	646 MILES AVENUE BILLINGS, MONTANA 59101	9,525*	200	0	200		9,325		2,707	
30	CURTISS T. BROWN	8 WASHINGTON STREET BILLINGS, MONTANA 59101								500	
31	PEDERSON CONSTRUCTION CO., THE WESTERN SUGAR COMPANY, A DELAWARE CORPORATION	BOX 1204 BILLINGS, MONTANA 59103	23,575	5,554	5,554	0		18,021		2,134	
62	DELETED	SEE SHEET NO. 14									

STATE	PROJECT NUMBER	SHEET NO.
MONT.	M1024 (2)	11



H K M ASSOCIATES
ENGINEERS - ARCHITECTS - PLANNERS
Executive Plaza - Airport Industrial Park
P.O. Box 31318, Billings, Montana 59107 (406) 245-6354

Approved: JACOBSON

Checked: WASH

Drawn: D.T.-D.C.R.-D.B.B.

Date: DEC 1981

STATE AVENUE RECONSTRUCTION

RIGHT OF WAY PLANS
APPROVED FHWA, 1-4-89
YELLOWSTONE CO.



Sheet No.

11

22

Map Revised 7-6-95
BACKSLOPE LIMITS INCLUDE ROUNDING
CONSTRUCTION LIMITS
TOP OF CUT
TOE OF FILL

FHWA APPROVAL 1-4-89

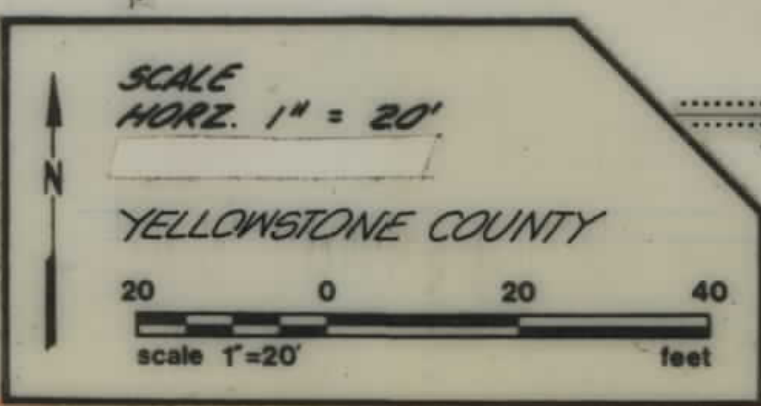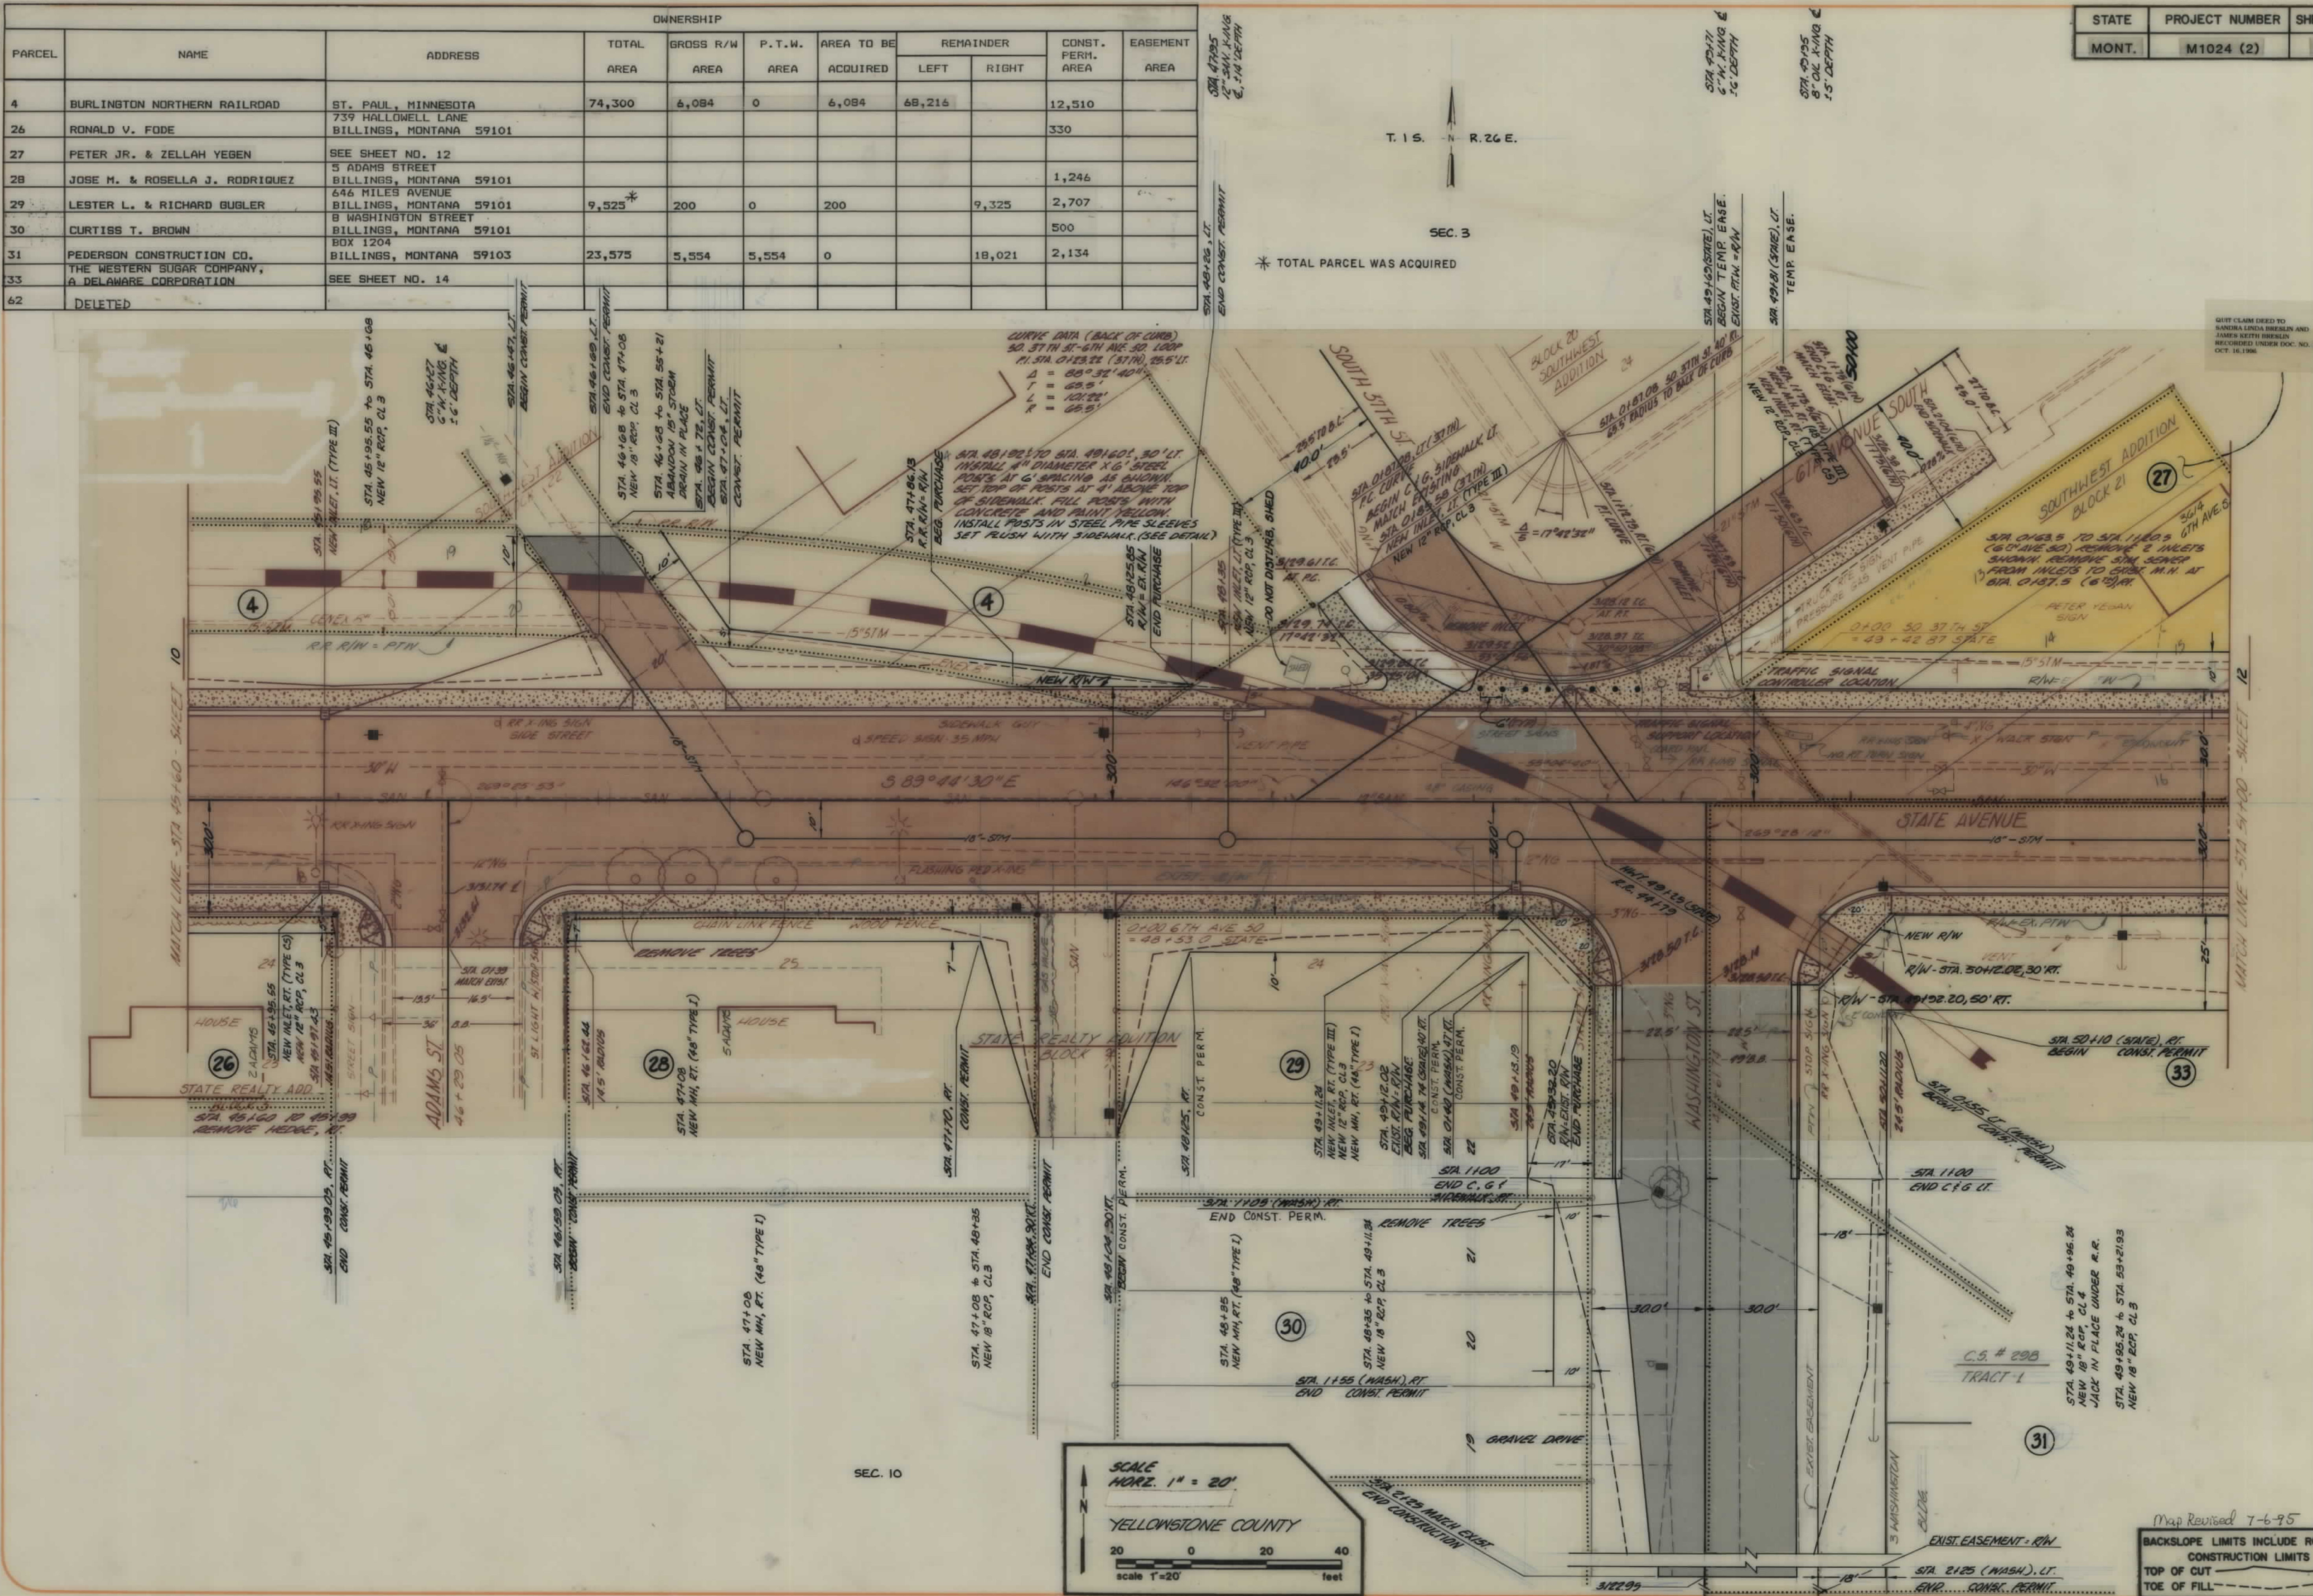

OWNERSHIP											
PARCEL	NAME	ADDRESS	TOTAL AREA	GROSS R/W AREA	P.T.W. AREA	AREA TO BE ACQUIRED	REMAINDER		CONST. PERM. AREA	EASEMENT AREA	
							LEFT	RIGHT			
27	PETER JR. & ZELLAH YEGEN	211 NORTH 30TH BILLINGS, MONTANA 59101	11,609	5,139	5,139	0	6,470		1,635	*	
32	KRATZ DRAINAGE DISTRICT								490		
33	THE WESTERN SUGAR COMPANY, A DELAWARE CORPORATION	SEE SHEET NO. 14									
34	ANITA S. & MARIA A. FLOREZ	610 SOUTH 36TH BILLINGS, MONTANA 59101	11,298	270	270	0	11,028		275		
35	MARY & MARIA A. FLOREZ	610 SOUTH 36TH BILLINGS, MONTANA 59101	9,520	4,956	4,864	92	4,564		940		
36	DANIEL W. DIMICH, JR.	621 SOUTH 36TH BILLINGS, MONTANA 59101	7,000	1,038	435	603	5,962		550		
62	DELETED										

STATE	PROJECT NUMBER	SHEET NO.
MONT.	M1024 (2)	12



H&M ASSOCIATES
ENGINEERS - ARCHITECTS - PLANNERS
Executive Plaza - Airport Industrial Park
P.O. Box 31318, Billings, Montana 59107 (406) 245-6354
Approved: JACOBSON


No.	REVISIONS	Date
1	11-27-89, 1-16-90, 6-4-93, 9-24-93	

STATE AVENUE RECONSTRUCTION
RIGHT OF WAY PLANS
APPROVED F.H.W.A. 1-4-89
YELLOWSTONE CO.


Sheet No.

12


22

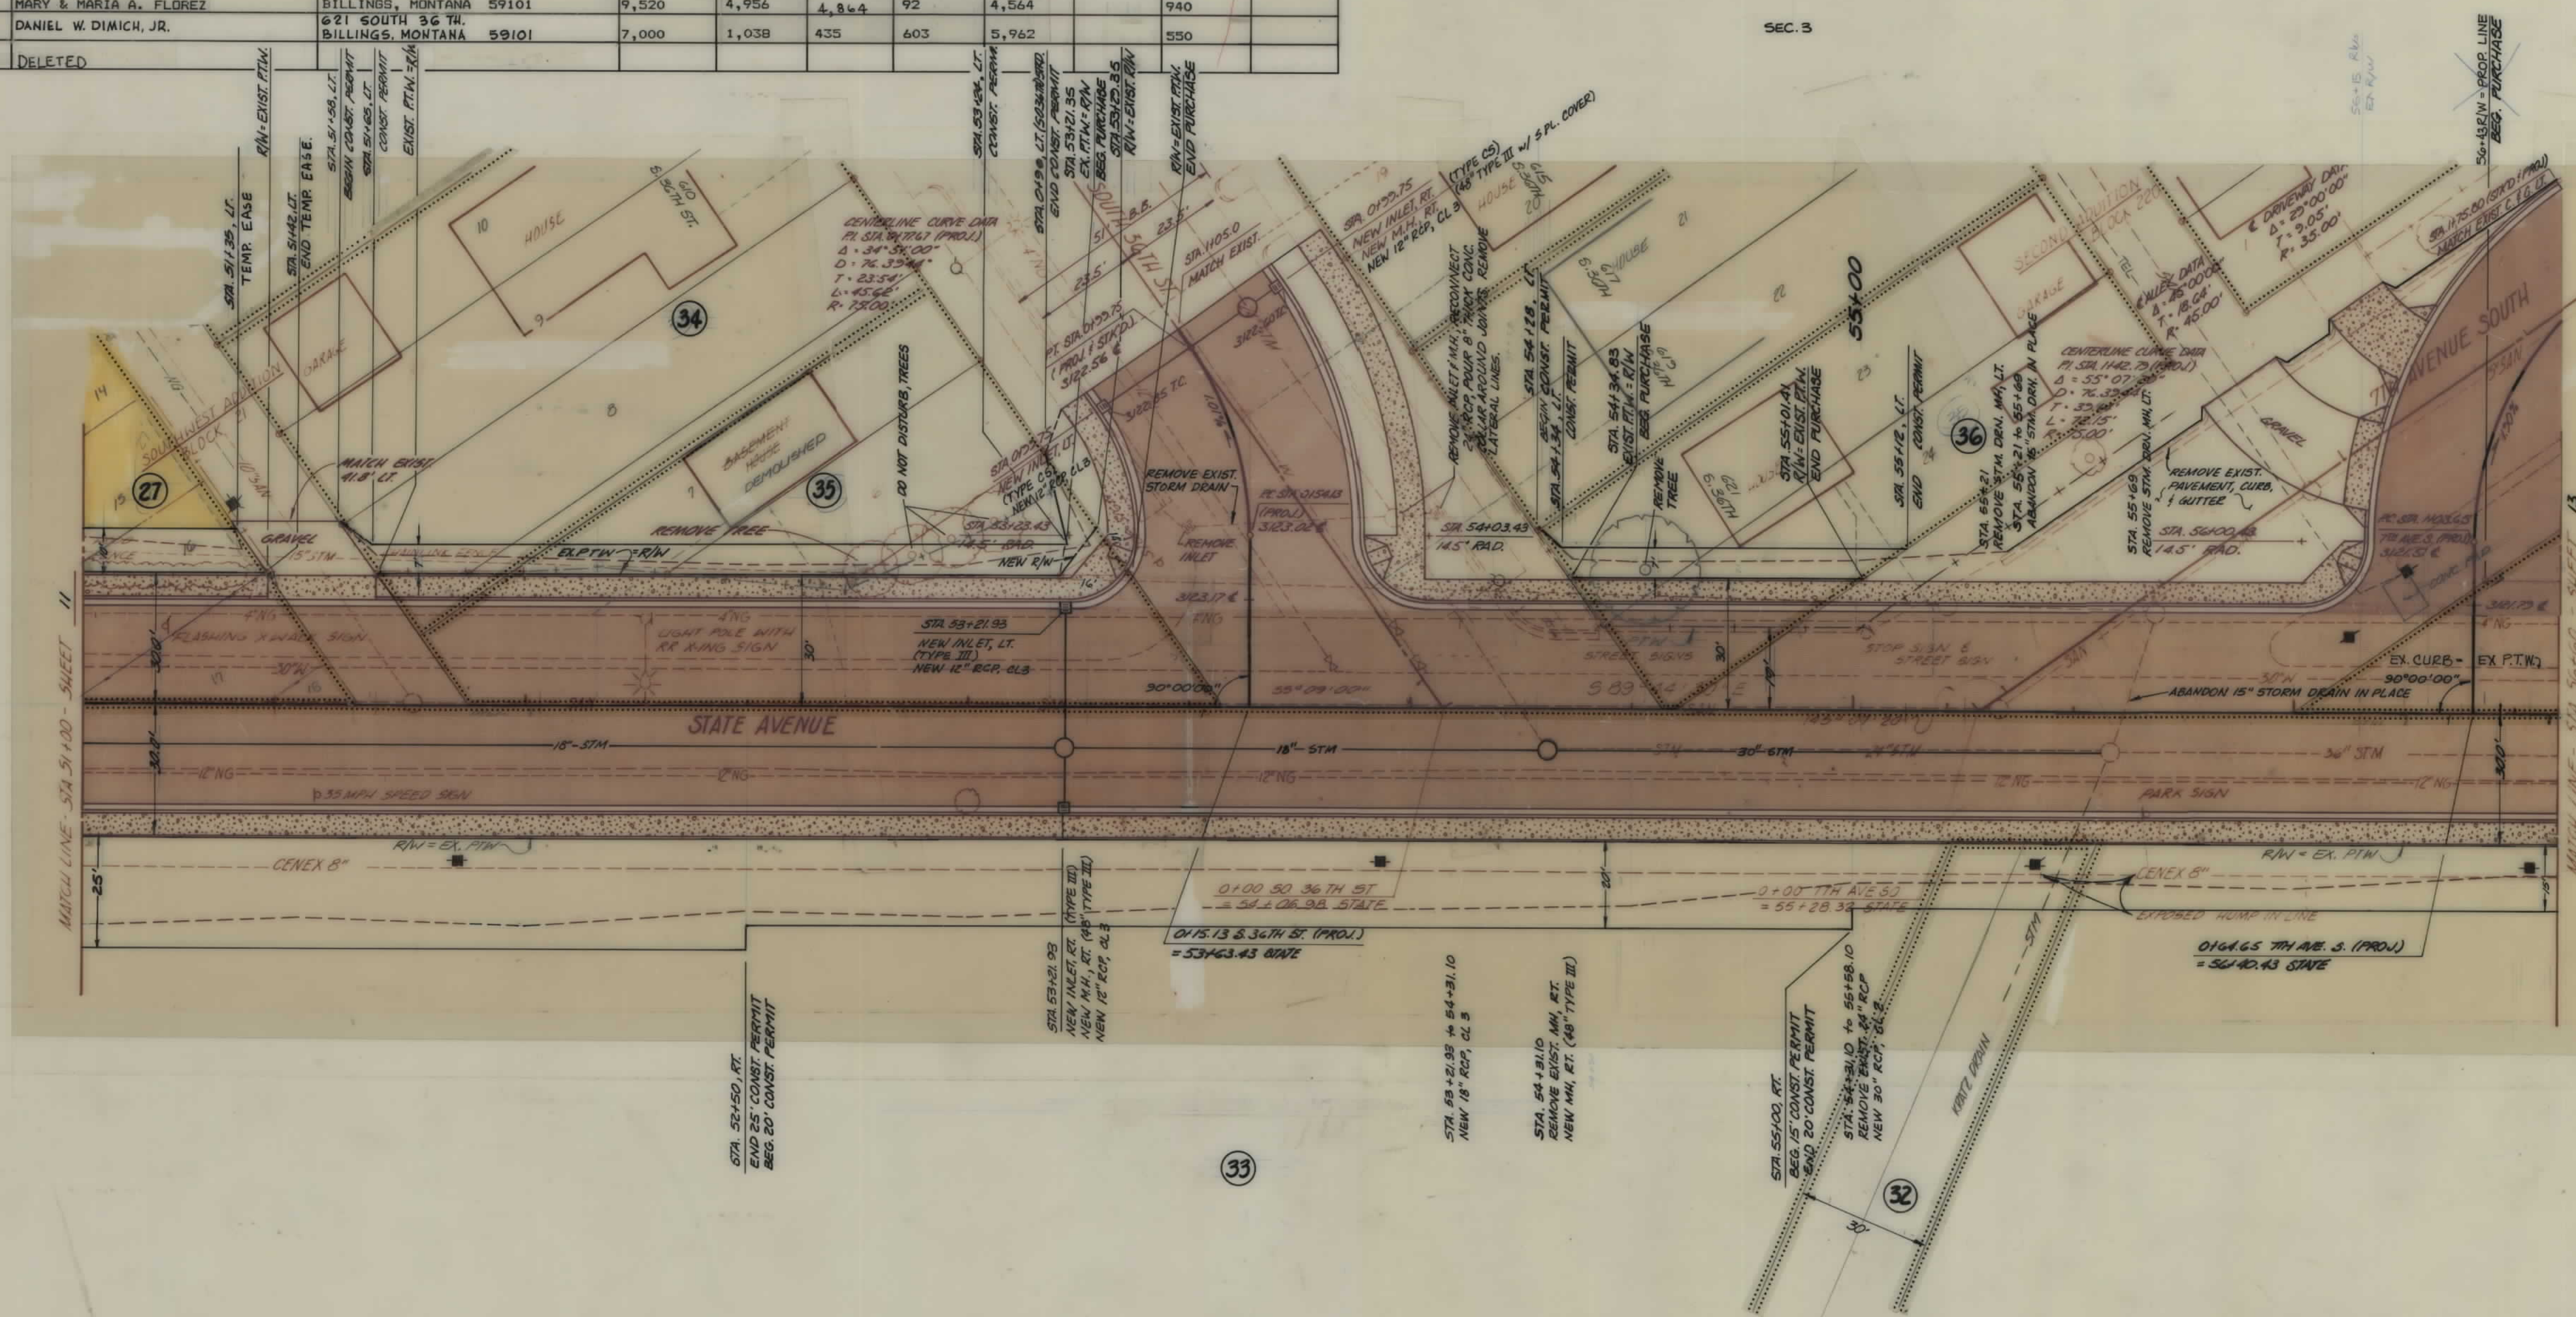

SEC. 10

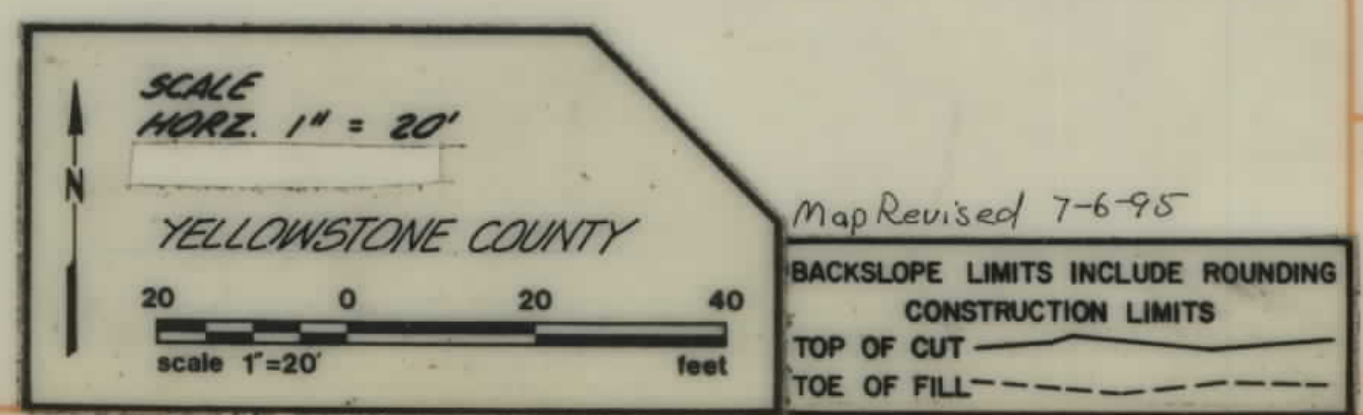

OWNERSHIP										
PARCEL	NAME	ADDRESS	TOTAL	GROSS R/W	P.T.W.	AREA TO BE	REMAINDER		CONST. PERM. AREA	Temp. Easement AREA
			AREA	AREA	AREA	ACQUIRED	LEFT	RIGHT		
33	THE WESTERN SUGAR COMPANY, A DELAWARE CORPORATION	SEE SHEET NO. 14								
37	TERRY L. MCKAY	P.O. BOX 80181 BILLINGS, MONTANA 59108	11,094	5,615	1,746	3,869	5,479			371
38	EDWARD E. & MONTANA L. DAVIS	721 SOUTH 35TH STREET BILLINGS, MONTANA 59101	7,000	5	5	0	6,995		470	
39	JOSE & EUELIO ARREDONDO	SEE SHEET NO. 14								
59	HELEN A. MELNICK	624 AVENUE D BILLINGS, MONTANA 59102	11,520	5,104	5,104	0	6,416		480	
62	DELETED									

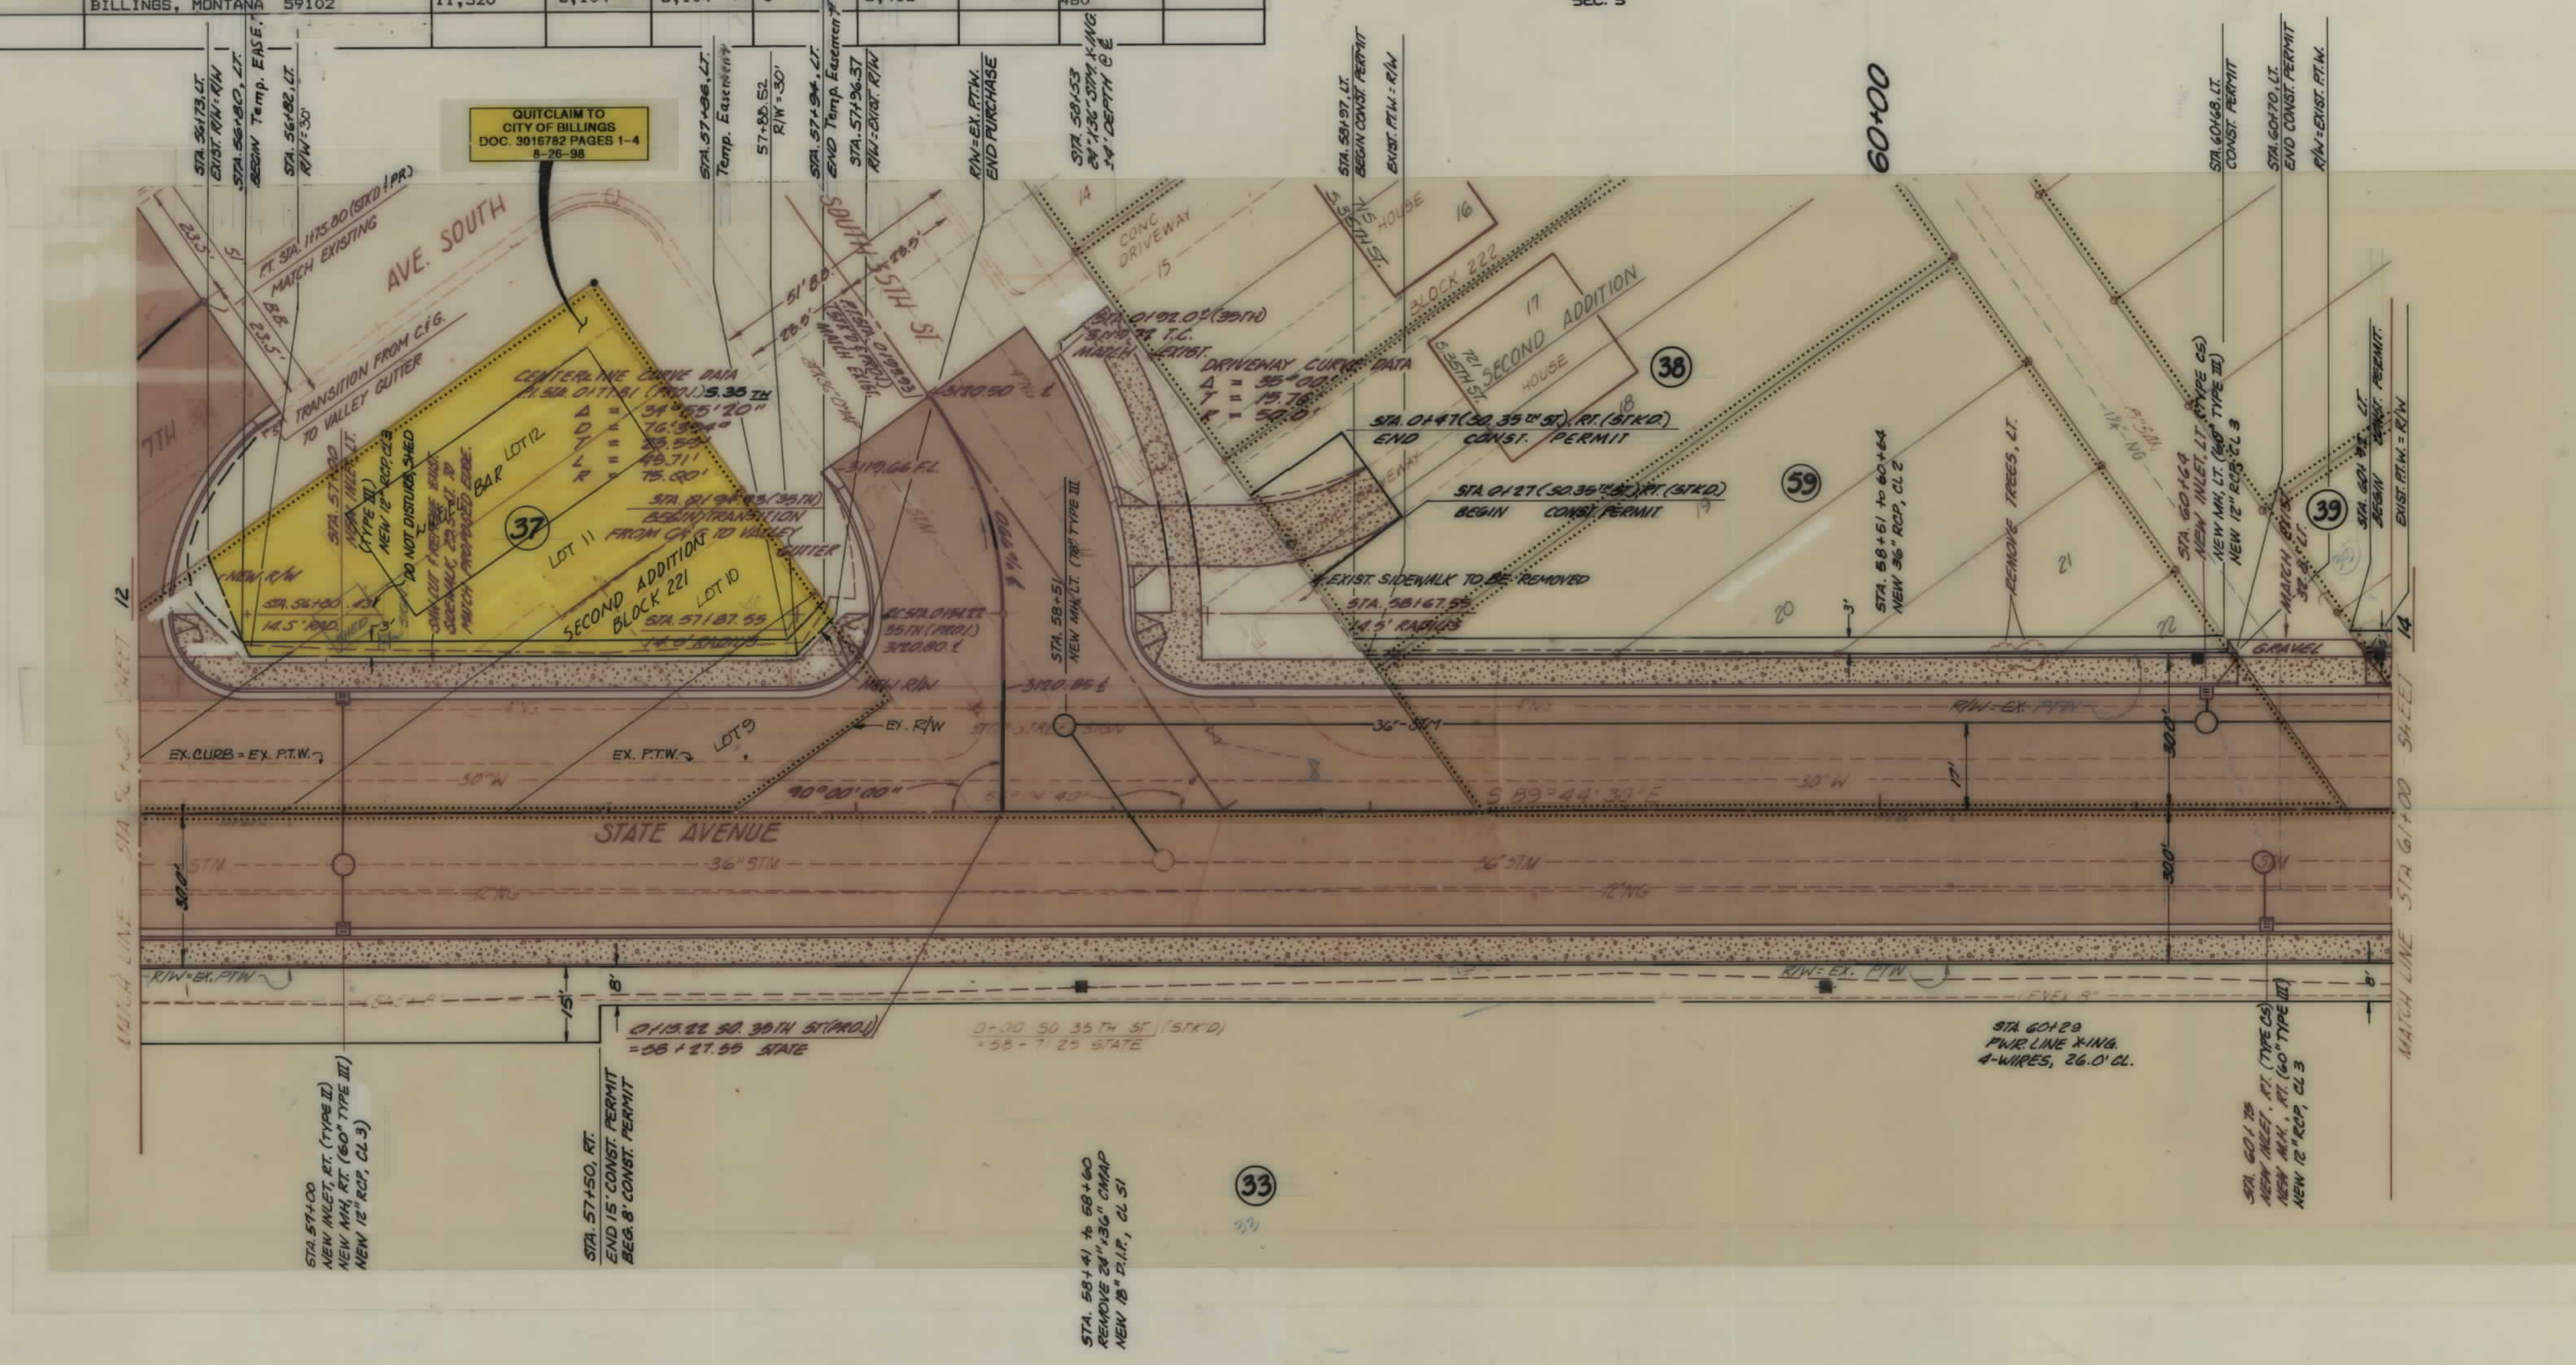

STATE	PROJECT NUMBER	SHEET NO.
MONT.	M1024 (2)	13




H&M ASSOCIATES
ENGINEERS - ARCHITECTS - PLANNERS
Executive Plaza - Airport Industrial Park
P.O. Box 31318, Billings, Montana 59107 (406) 245-6354

No.	REVISIONS	Date
1	11-27-89, 7-13-90, 8-10-93	
2	9-24-93, 10-10-93	

STATE AVENUE RECONSTRUCTION
RIGHT OF WAY PLANS
APPROVED F.H.W.A. 1-4-89
YELLOWSTONE CO.

Project No. 2M025.123
Sheet No. 13
Date DEC 1981
Drawn: DI - DLR - DGB
Checked: WSLA
Approved: JACOBSON

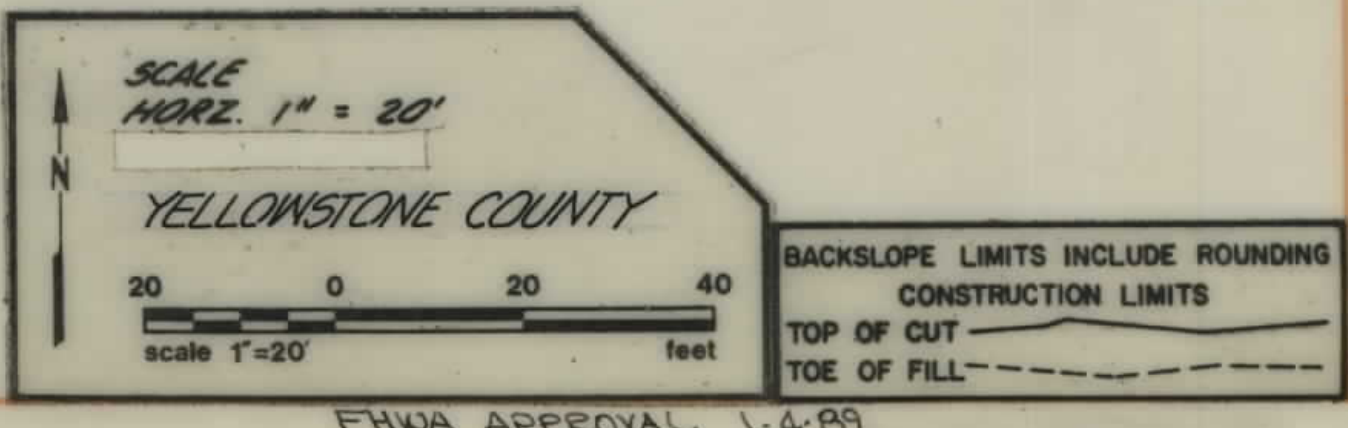

FHWA APPROVAL 1-4-89

PARCEL	NAME	ADDRESS	OWNERSHIP								CONSTR. PERM. AREA	EASEMENT AREA
			TOTAL AREA	GROSS R/W AREA	P.T.W. AREA	AREA TO BE ACQUIRED	REMAINDER		AREA	AREA		
33	THE WESTERN SUGAR COMPANY, A DELAWARE CORPORATION	555 17TH STREET DENVER, CO. 80202	523,076	57,956	57,556	400			465,120	20,428		
39	JOSE & EDELLIO ARREDONDO	724 SOUTH 34TH STREET BILLINGS, MONTANA 59101	10,207	1,179	1,179	0			9,028	405		
40	SALVADOR & VALERA MARTINEZ	680 GARNET AVENUE BILLINGS, MONTANA 59102	8,940	4,878	4,878	0			4,052	800		
41	ADOLF HOVLAND	810 SOUTH 33RD STREET BILLINGS, MONTANA 59101	6,959	39	0	39			6,920	35		
42	LYLE COONARE AND VELMA ARLENE MASSEY	SEE SHEET NO. 15										
43	THE WESTERN SUGAR COMPANY, A DELAWARE CORPORATION	SEE SHEET NO. 19										
60	SALVADOR & VALERA MARTINEZ	680 GARNET AVENUE BILLINGS, MONTANA 59102	7,000	231	231	0			6,769	230		
61	GREY EAGLE DITCH CO.	SEE SHEET NO. 16										
62	DELETED											

STATE	PROJECT NUMBER	SHEET NO.
MONT.	M1024 (2)	14



HKM ASSOCIATES
ENGINEERS - ARCHITECTS - PLANNERS

Executive Plaza - Airport Industrial Park
P.O. Box 31318, Billings, Montana 59107 (406) 245-6354

Approved: JACOBSON

Checked: WASH

Drawn: DT-DCR-DB6

Date: 1/27/89

Date: DEC 1981

Project No. 2M023.123

STATE AVENUE RECONSTRUCTION

RIGHT OF WAY PLANS


APPROVED FHWA 1-4-89

YELLOWSTONE CO.


Sheet No.

14

22

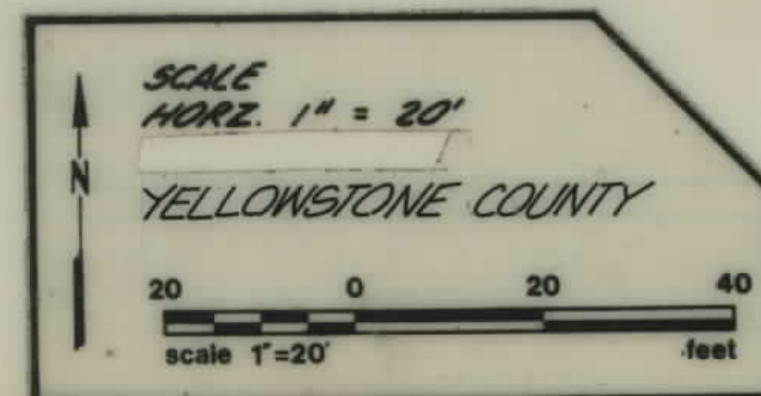

FHWA APPROVAL 1-4-89
Copyright © 1984 HKM Associates, All Rights Reserved

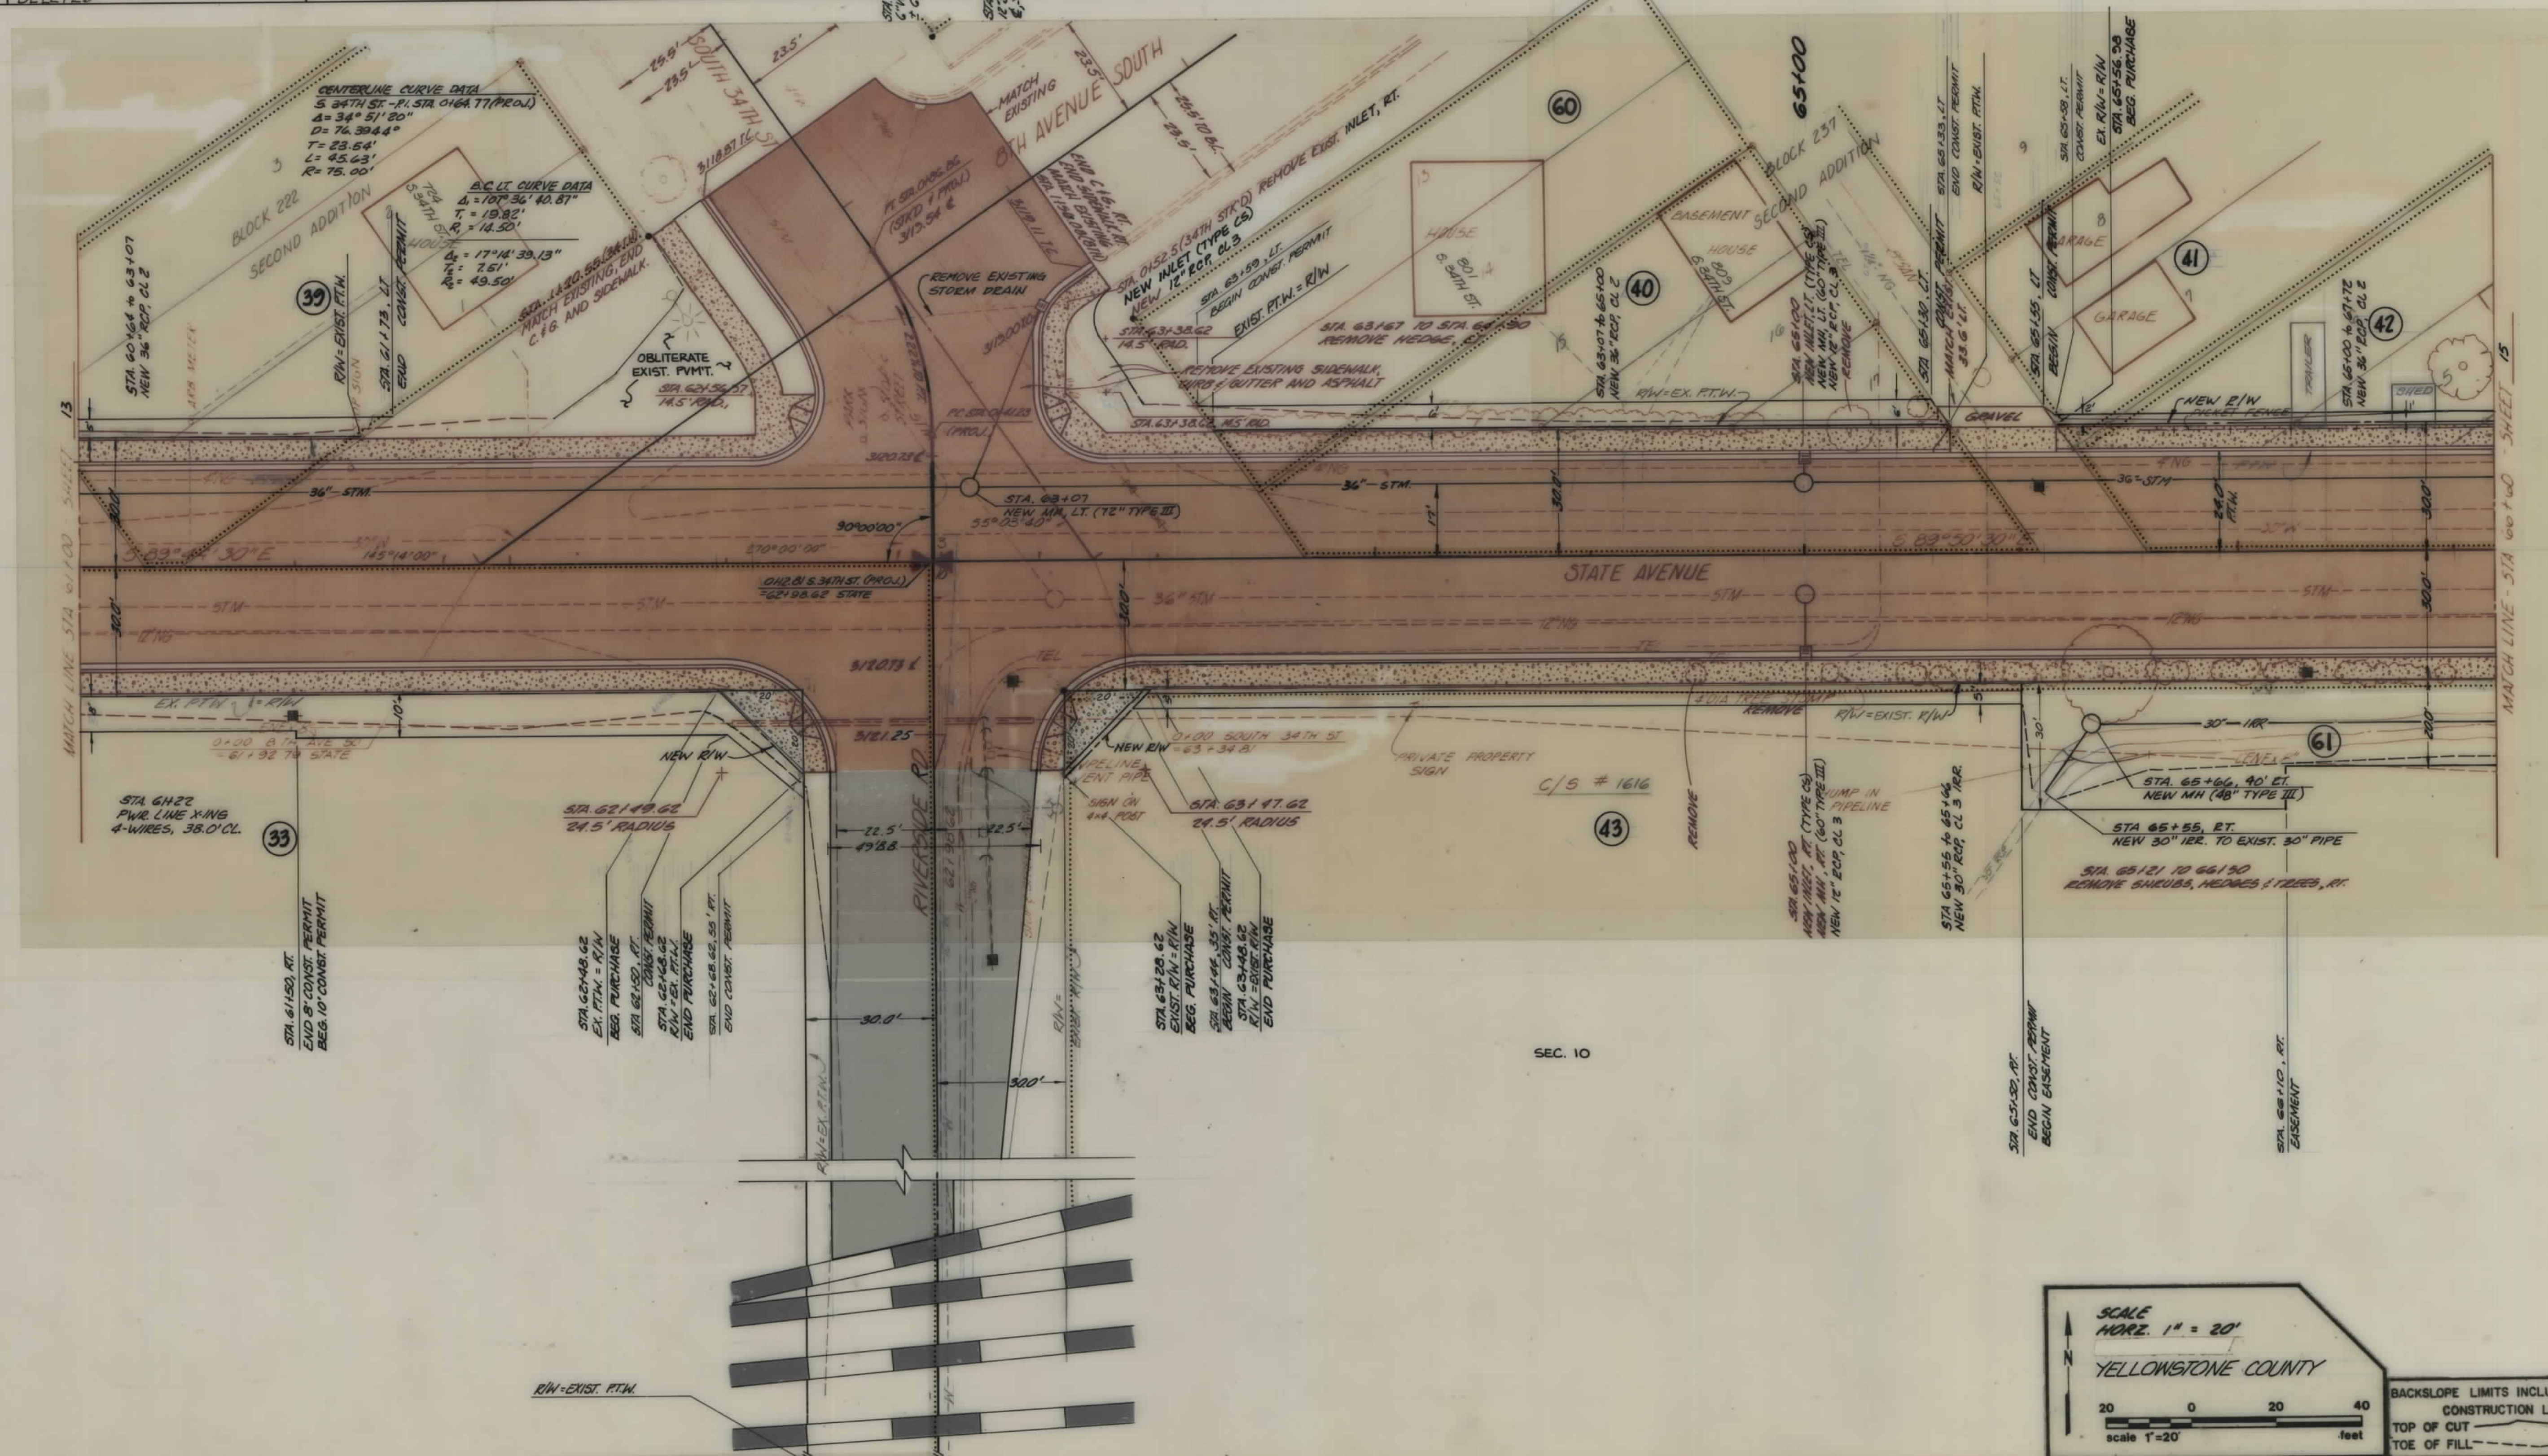

OWNERSHIP										
PARCEL	NAME	ADDRESS	TOTAL	GROSS R/W	P.T.W.	AREA TO BE	REMAINDER		CONST.	EASEMENT
			AREA	AREA	AREA	ACQUIRED	LEFT	RIGHT	PERM. AREA	AREA
42	LYLE COONEARE AND VELMA ARLENE MASSEY	P.O. BOX 30024 BILLINGS, MONTANA 59107	10,850	5,126	4,082	1,044	5,724		450	
43	THE WESTERN SUGAR COMPANY, A DELAWARE CORPORATION	SEE SHEET NO. 19								
44	FRIEDA L. GILLIS	823 SOUTH 33RD STREET BILLINGS, MONTANA 59101	7,000	29	29	0	6,971		85	
45	VERLIN G. HALE	SEE SHEET NO. 16								
62	DELETED									
61	GREY EAGLE DITCH CO.	SEE SHEET NO. 16								

STATE	PROJECT NUMBER	SHEET NO.
MONT.	M1024 (2)	15




H&M ASSOCIATES
ENGINEERS - ARCHITECTS - PLANNERS
Executive Plaza - Airport Industrial Park
P.O. Box 31318, Billings, Montana 59107 (406) 245-6354
Approved: JACOBSON
Checked: WASH
Drawn: DT-PCR-D.B.G.

No.	REVISIONS	Date
1		11/27/89

STATE AVENUE RECONSTRUCTION
RIGHT OF WAY PLANS
APPROVED F.H.W.A. 1-4-89
YELLOWSTONE CO.
Project No. 2M025/123
Sheet No. 15
22



SEC. 3

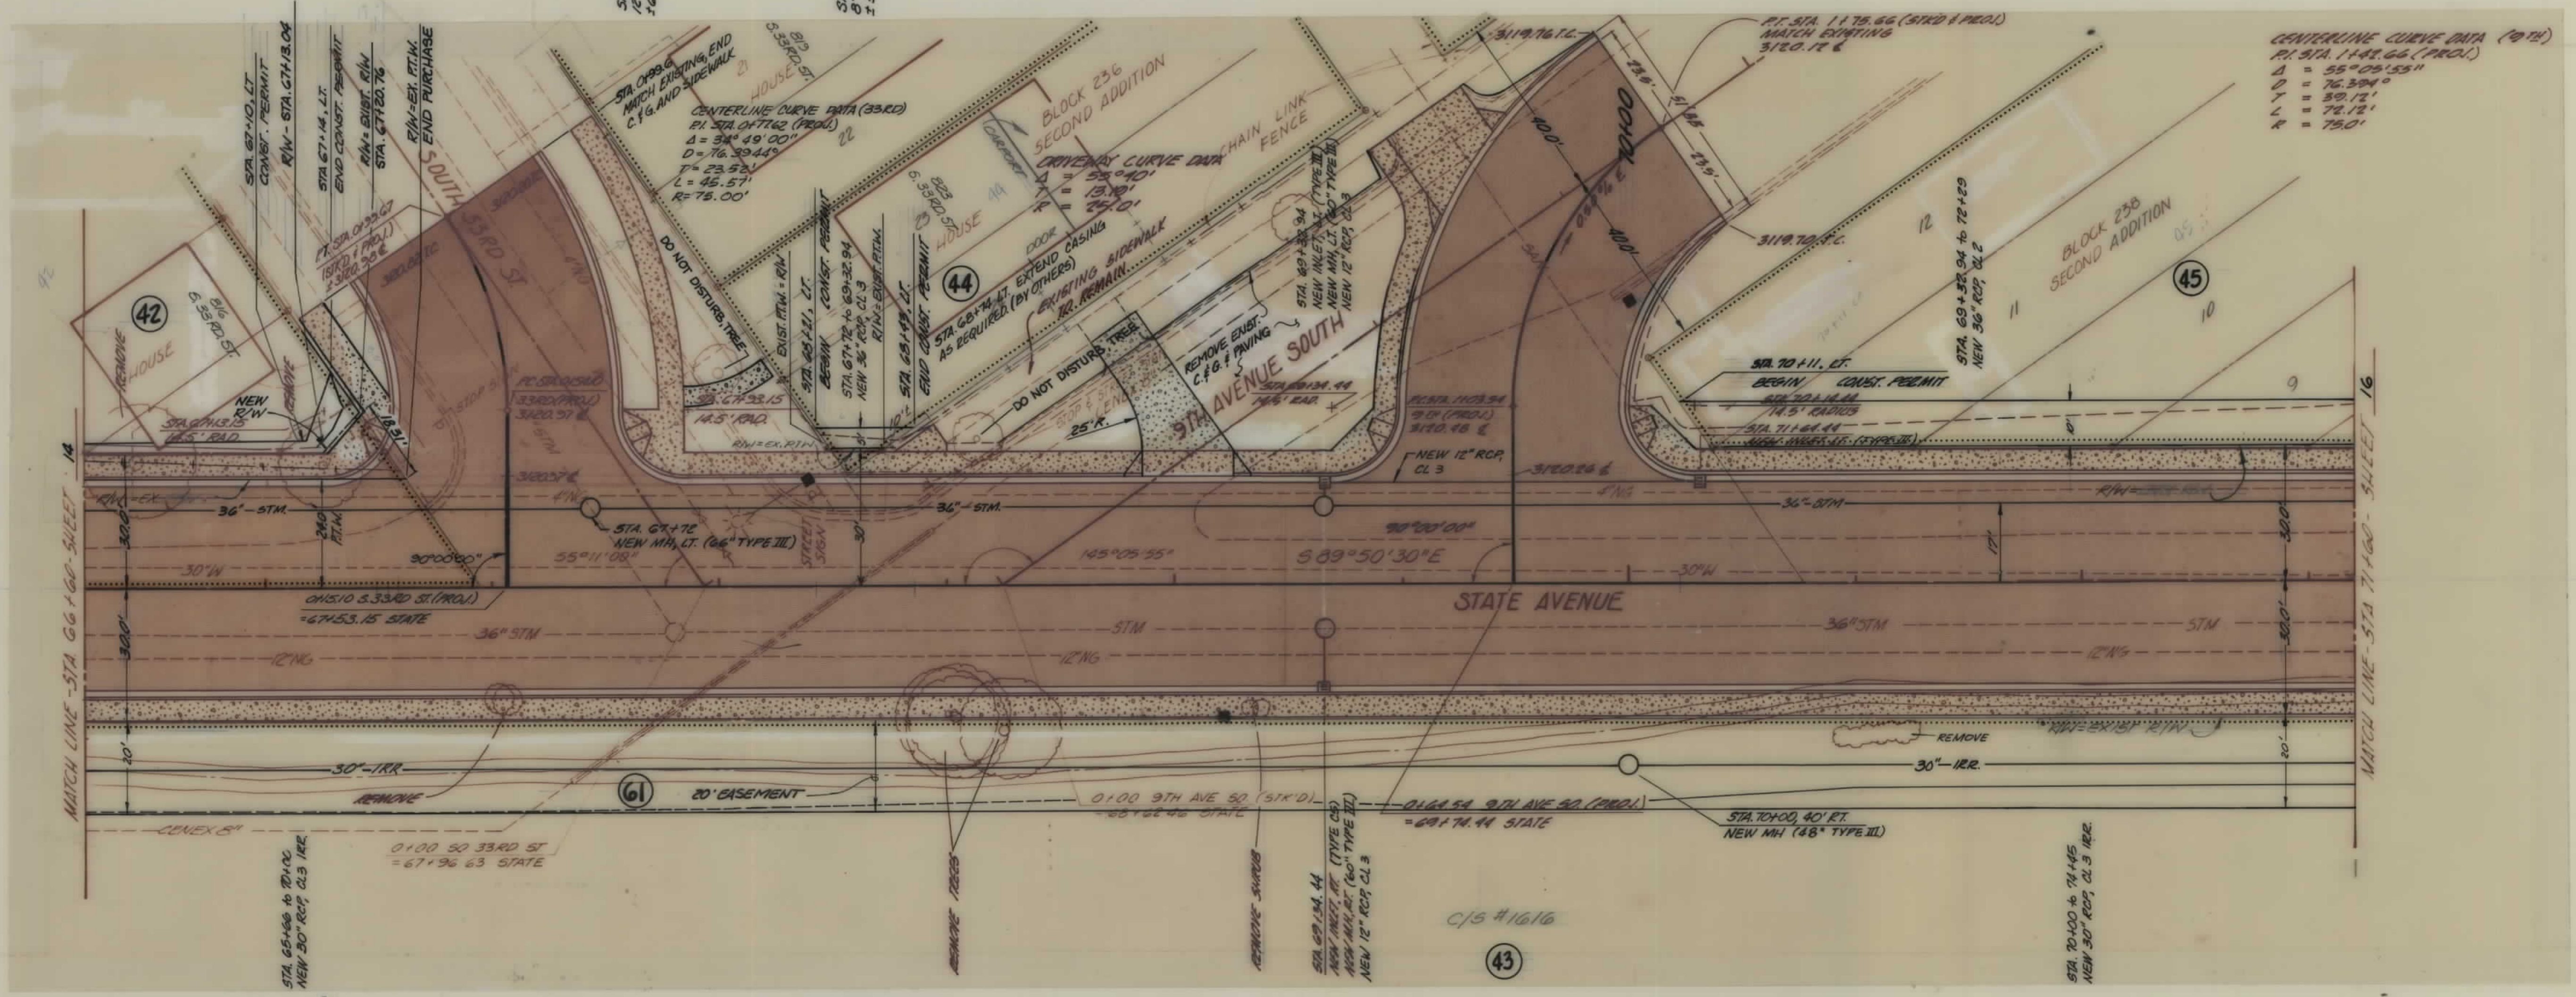

PARCEL	NAME	ADDRESS	OWNERSHIP							EASEMENT AREA
			TOTAL AREA	GROSS R/W AREA	P.T.W. AREA	AREA TO BE ACQUIRED	REMAINDER		CONST. PERM. AREA	
43	THE WESTERN SUGAR COMPANY, A DELAWARE CORPORATION	SEE SHEET NO. 19								
45	VERLIN G. HALE	2011 9TH AVENUE N. BILLINGS, MONTANA 59101	10,182	68	0	68	10,114		1,640	
46	SOLAR WORLD, INC.	P.O. BOX 14584 SPOKANE, WASHINGTON 99214	12,030	5,016	5,016	0	7,014		1,645	
47	GLEN L. & JOAN D. HARBAUGH	14 PRINCE OF WALES DRIVE BILLINGS, MONTANA 59105							65	
48	EDWIN H. & JEAN HEISER	3908 MCGIRL ROAD BILLINGS, MONTANA 59101	14,000	74	74	0	13,926		150	
61	GREY EAGLE DITCH CO.	FOR NEGOTIATION ONLY								



STATE	PROJECT NUMBER	SHEET NO.
MONT.	M1024 (2)	16



H&M ASSOCIATES
ENGINEERS - ARCHITECTS - PLANNERS
 Executive Plaza - Airport Industrial Park
 P.O. Box 31318, Billings, Montana 59107 (406) 245-6354
 Approved: JACOBSON
 Checked: AMISA
 Drawn: DT - DCF - D.B.G.

No.	REVISIONS	Date

STATE AVENUE RECONSTRUCTION
RIGHT OF WAY PLANS
 APPROVED F.H.W.A. 1-4-89
YELLOWSTONE CO
 Project No. 21025.123
 Sheet No. 16
 Date: DEC. 1981

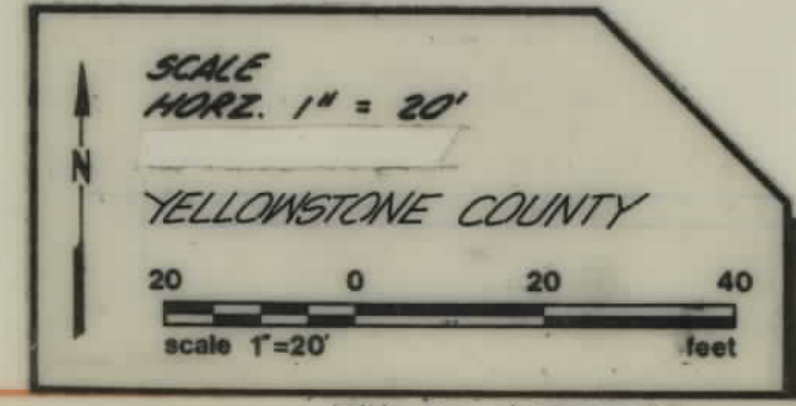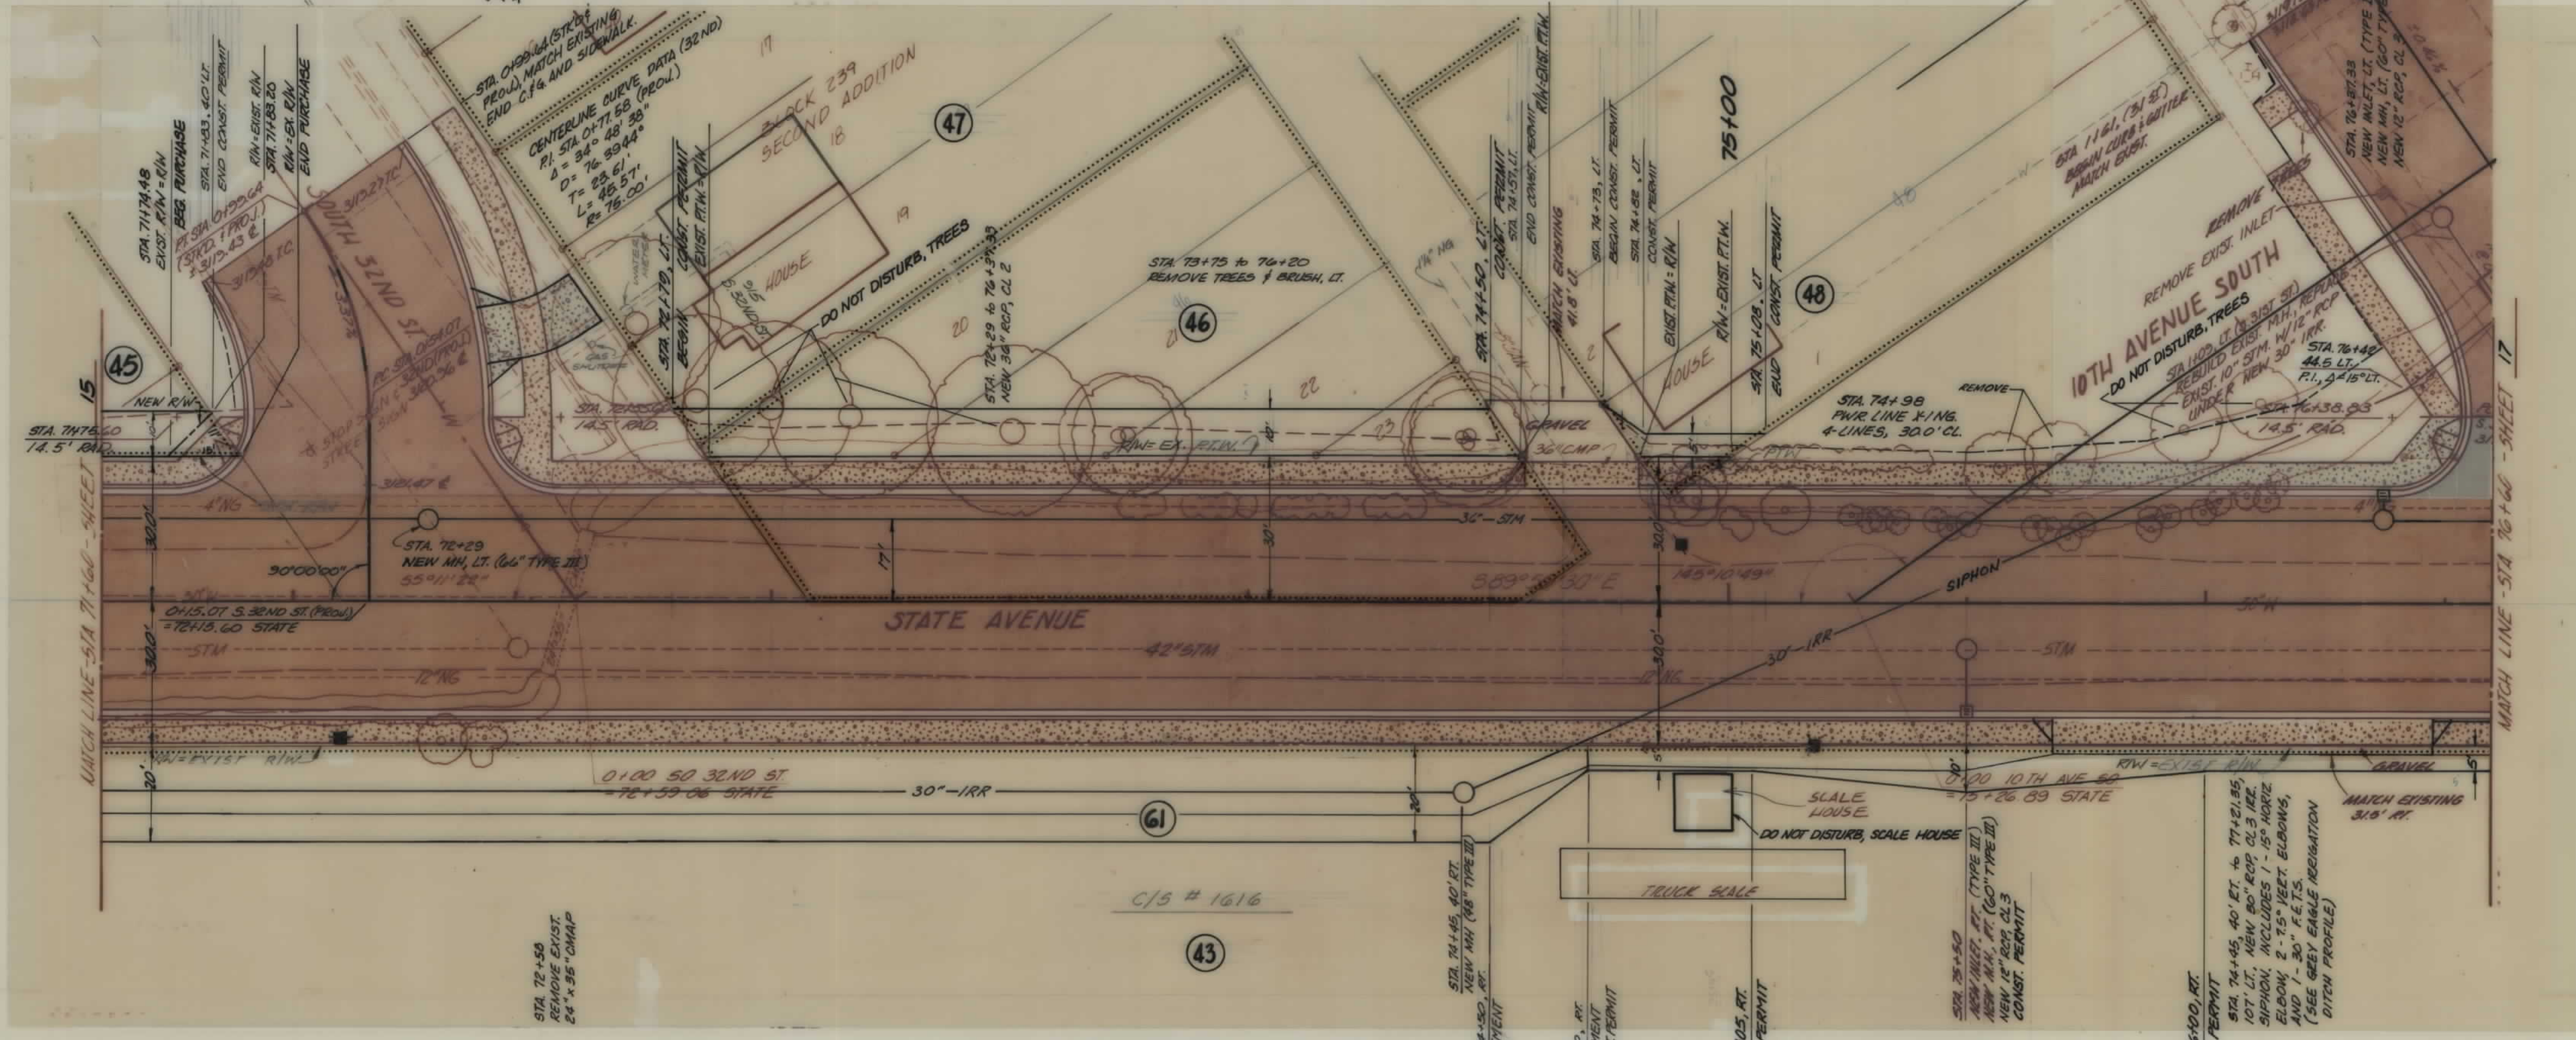


BACKSLOPE LIMITS INCLUDE ROUNDING
 CONSTRUCTION LIMITS
 TOP OF CUT
 TOE OF FILL

FHWA APPROVAL 1-4-89

OWNERSHIP										
PARCEL	NAME	ADDRESS	TOTAL AREA	GROSS R/W AREA	P.T.W. AREA	AREA TO BE ACQUIRED	REMAINDER		CONST. PERM. AREA	EASEMENT AREA
43	THE WESTERN SUGAR COMPANY, A DELAWARE CORPORATION	SEE SHEET NO. 19					LEFT	RIGHT		
49	TATE & LYLE, INC.	ONE FEDERAL STREET YONKERS, NEW YORK 10702	15,590	0	0	0	15,590		850	
50	THE WESTERN SUGAR COMPANY, A DELAWARE CORPORATION	SEE SHEET NO. 18								

STATE	PROJECT NUMBER	SHEET NO.
MONT.	M1024 (2)	17

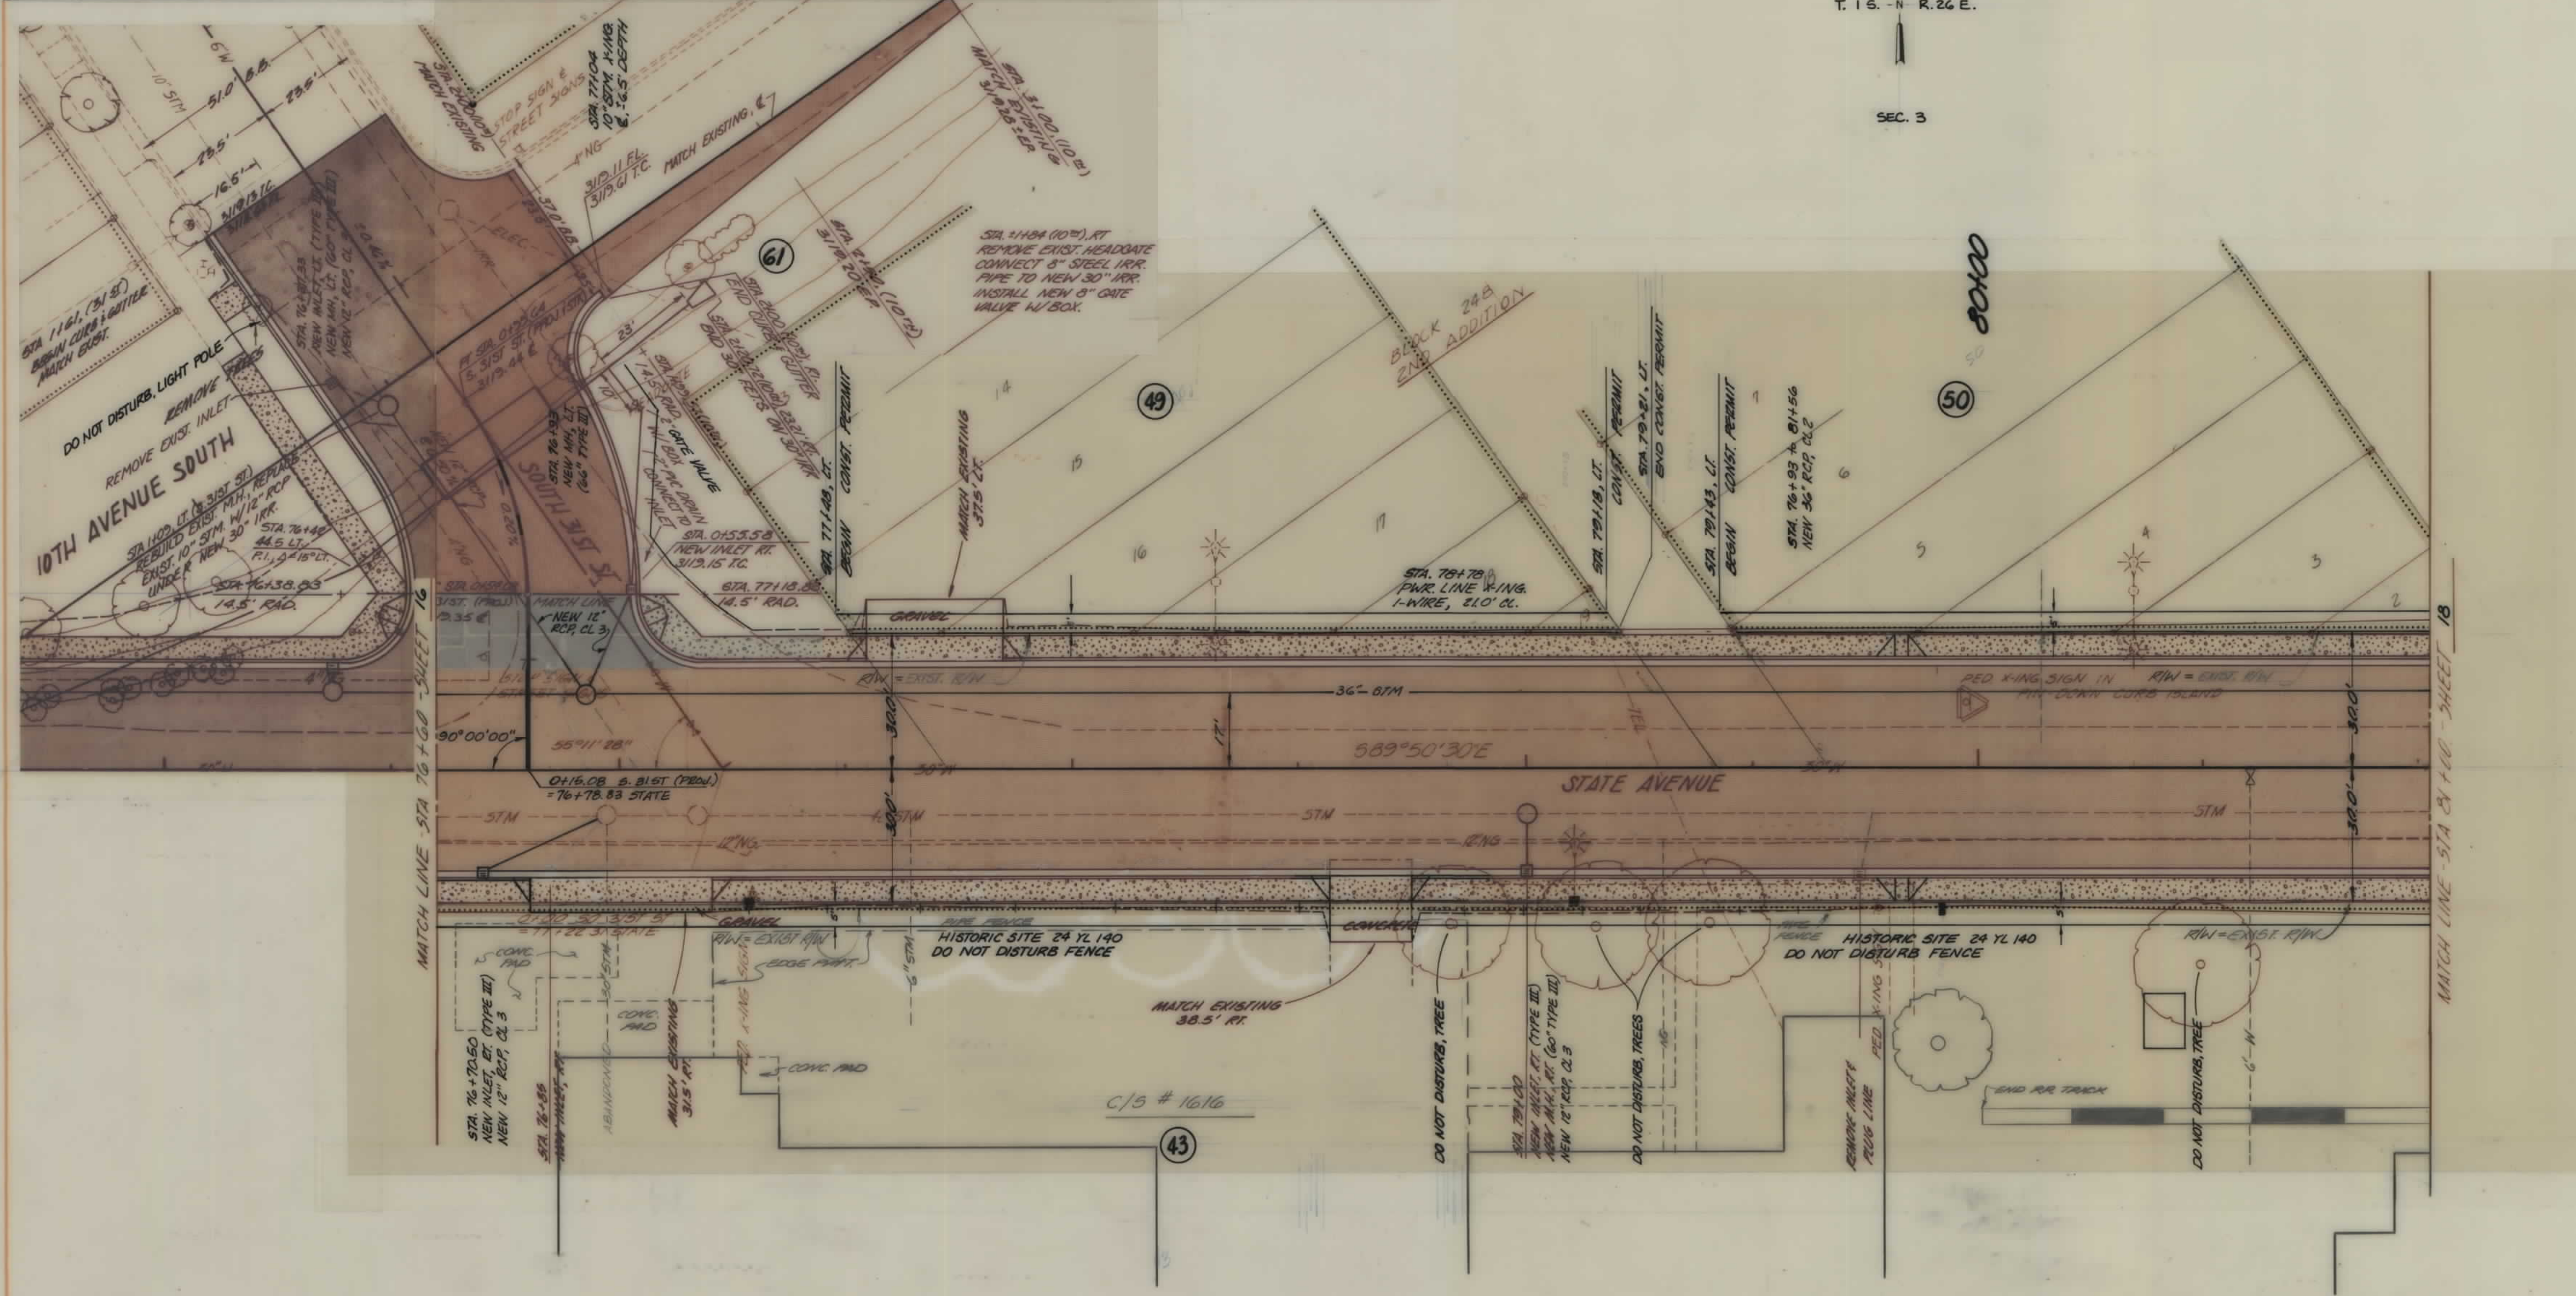


STA 79+29
P.W. LINE
± 2.5' DEPTH

T. 1 S. - N. R. 26 E.

SEC. 3

SEC. 10

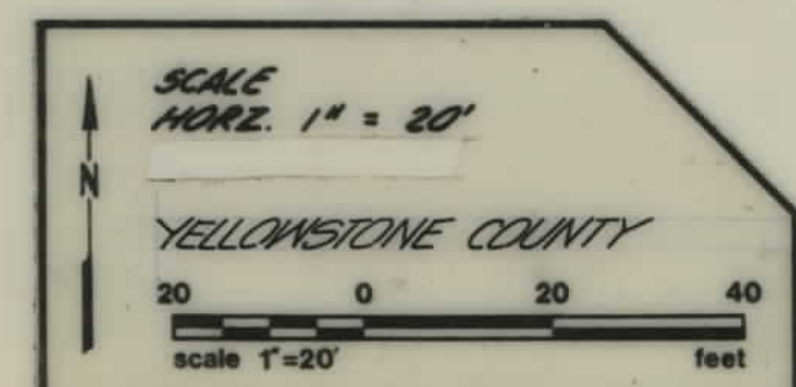

BACKSLOPE LIMITS INCLUDE ROUNDING
CONSTRUCTION LIMITS
TOP OF CUT
TOE OF FILL

H K M ASSOCIATES
ENGINEERS - ARCHITECTS - PLANNERS
Executive Plaza - Airport Industrial Park
P.O. Box 31318, Billings, Montana 59007 (406) 245-6354

No.	REVISIONS	Date

STATE AVENUE RECONSTRUCTION
RIGHT OF WAY PLANS
APPROVED F.H.W.A. 1-4-89
YELLOWSTONE CO.
Project No. 24025.123
Sheet No. 17
Drawn: D.T.-D.C.R.-D.B.G.
Checked: N.A.S.A.
Approved: J.A.COBSON
Date: DEC. 1981

OWNERSHIP										
PARCEL	NAME	ADDRESS	TOTAL AREA	GROSS R/W AREA	P.T.W. AREA	AREA TO BE ACQUIRED	REMAINDER		CONST. FERM. AREA	EASEMENT AREA
							LEFT	RIGHT		
43	THE WESTERN SUGAR COMPANY, A DELAWARE CORPORATION	SEE SHEET NO. 19								
50	THE WESTERN SUGAR COMPANY, A DELAWARE CORPORATION	555 17TH STREET DENVER, CO. 80202	31,170	92	0	92	31,078		785	
51	DONALD E. HAUGAN	1923 MILES AVENUE BILLINGS, MONTANA 59102	4,853	3,442	3,243	199	1,411		300	
52	DONALD E. HAUGAN	SEE SHEET NO. 19								
68	FRED M. & DOROTHY M. STEWART JR.	FOR NEGOTIATION ONLY								

STATE	PROJECT NUMBER	SHEET NO.
MONT.	M1024 (2)	18



H&M ASSOCIATES
ENGINEERS - ARCHITECTS - PLANNERS
Executive Plaza - Airport Industrial Park
P.O. Box 3318, Billings, Montana 59107 (406 245 6354)

Approved: JACOBSON

Drawn: DT-DCR-D&G

Date: DEC. 1981

STATE AVENUE RECONSTRUCTION

RIGHT OF WAY PLANS



APPROVED F.H.W.A. 1-A-89

YELLOWSTONE CO.

Sheet No.

18

22

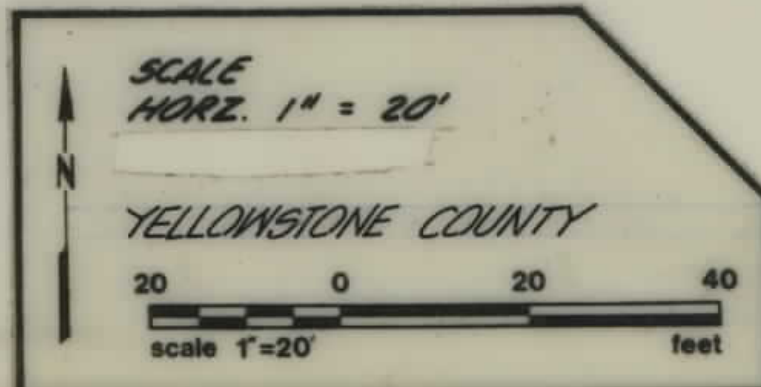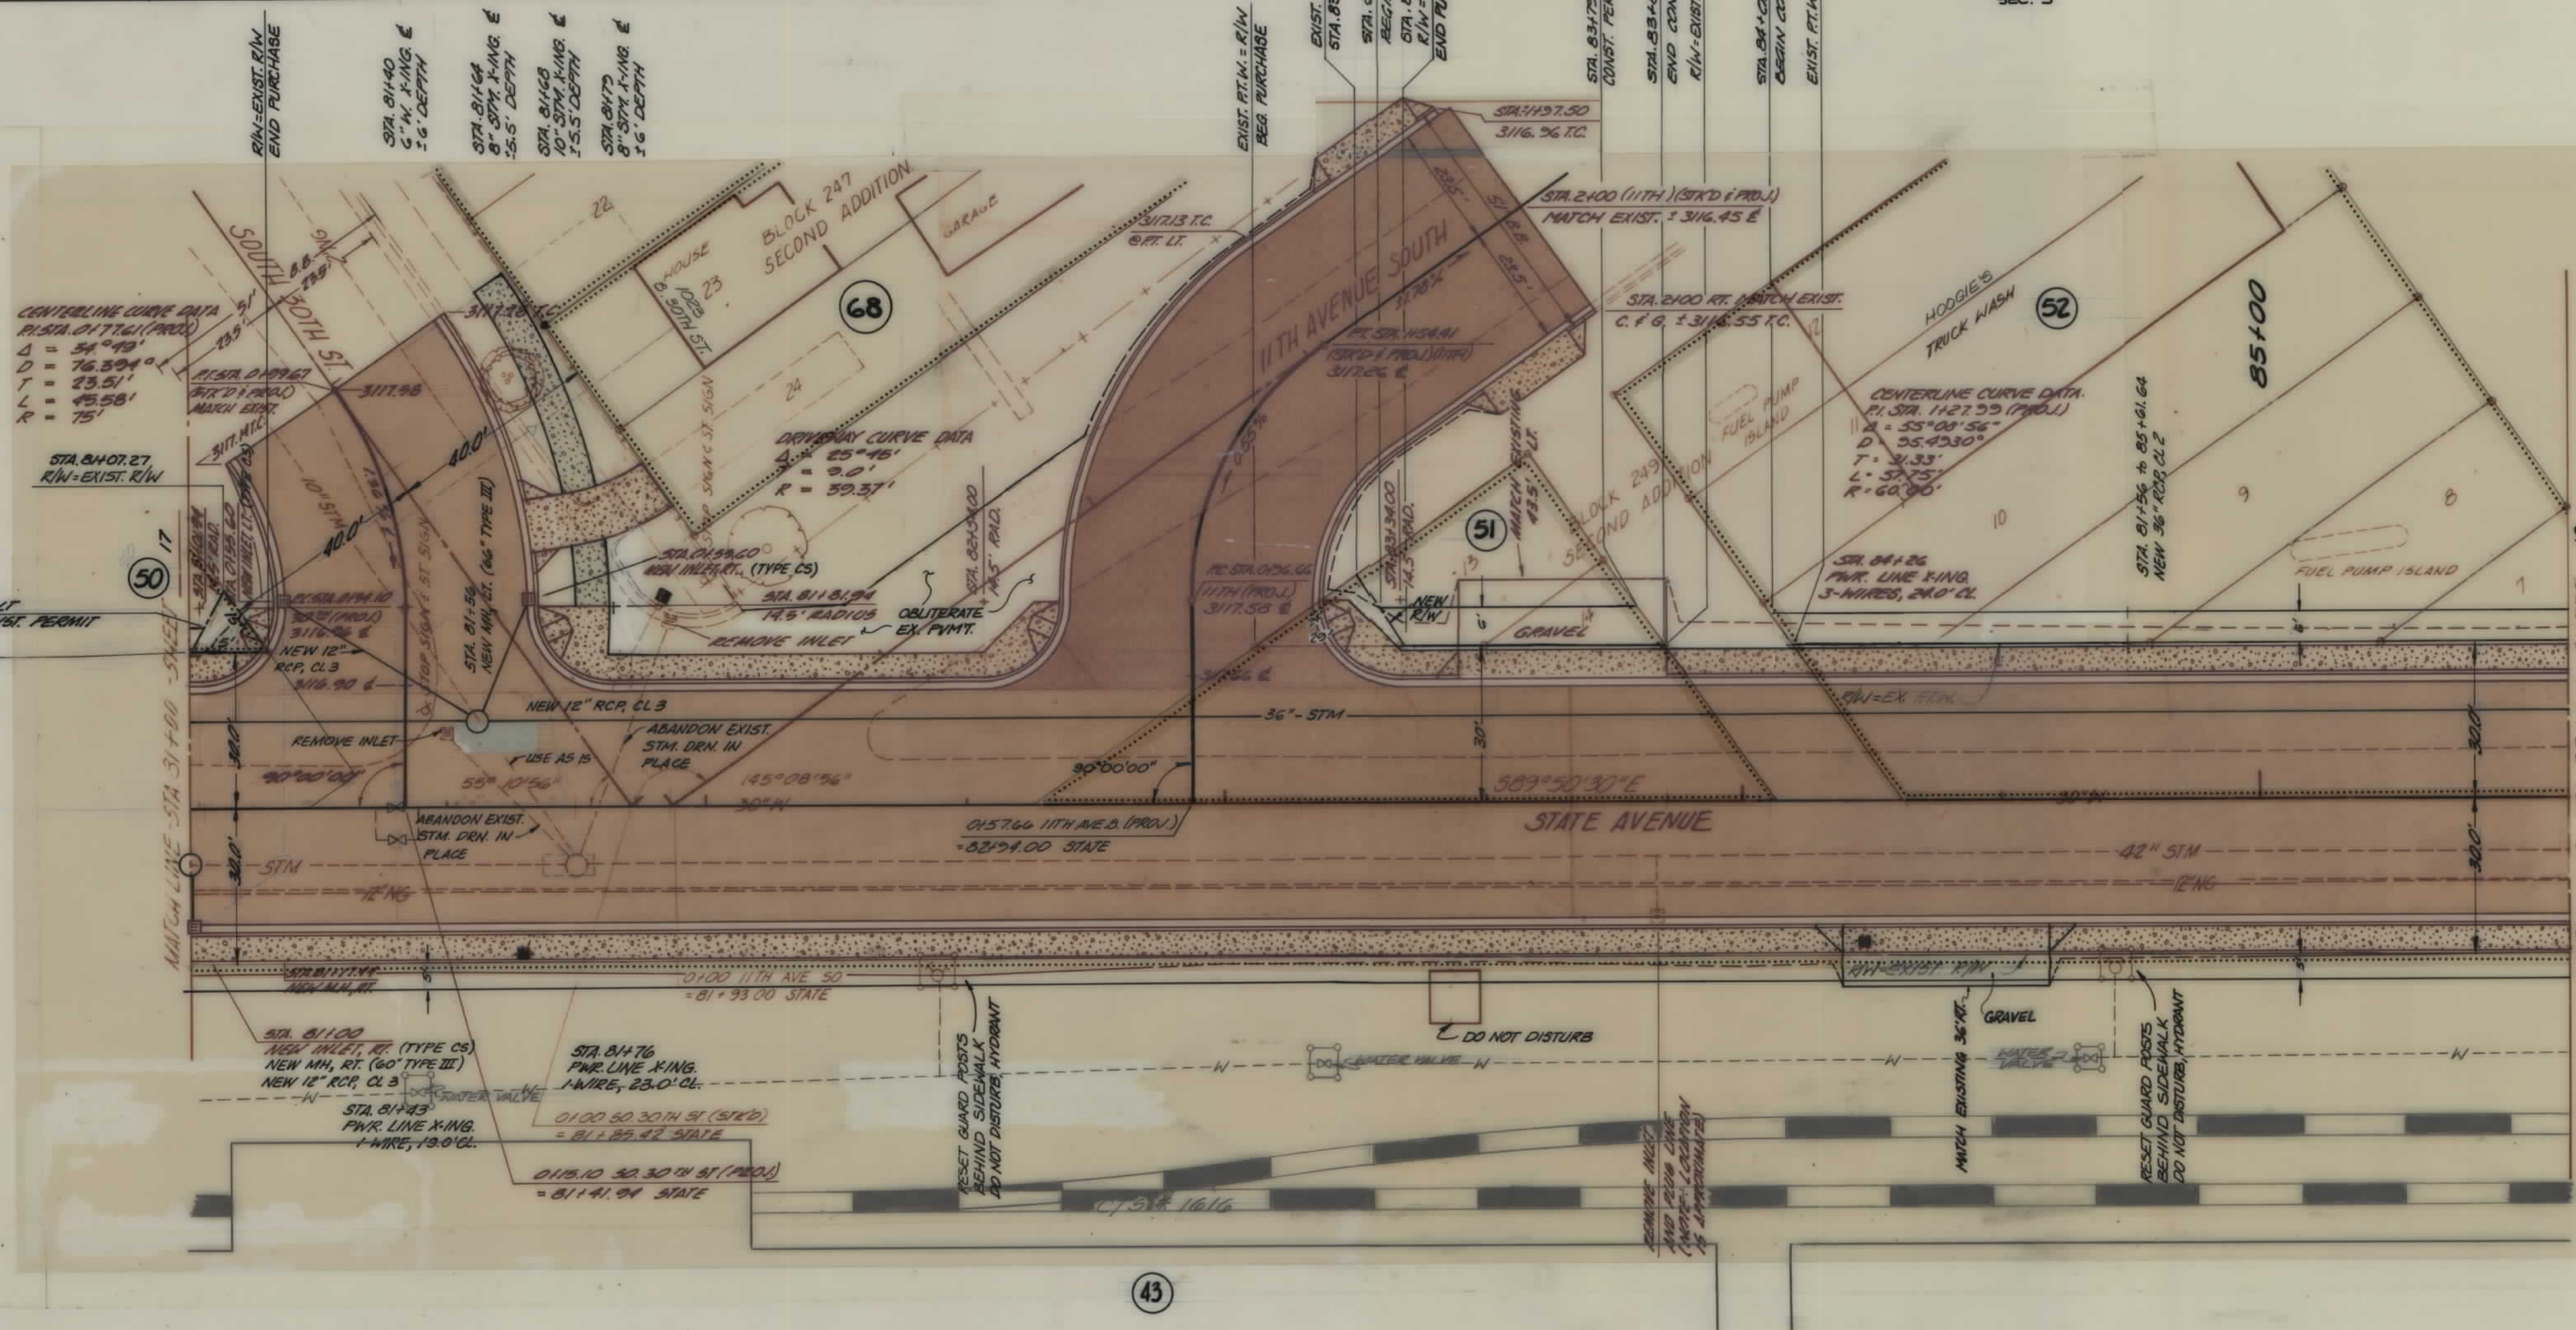


BACKSLOPE LIMITS INCLUDE ROUNDING
CONSTRUCTION LIMITS
TOP OF CUT
TOE OF FILL

FHWA APPROVAL 1-4-89

PARCEL	NAME	ADDRESS	TOTAL AREA	OWNERSHIP			AREA TO BE ACQUIRED	REMAINDER		CONSTR. PERM. AREA	EASEMENT AREA
				GROSS R/W AREA	P.T.W. AREA			LEFT	RIGHT		
43	THE WESTERN SUGAR COMPANY, A DELAWARE CORPORATION	555 17TH STREET DENVER, CO. 80202	6,738,296	813	0		813		6,737,483	8,457	18,850 *
52	DONALD E. HAUBAN	1923 MILES AVENUE BILLINGS, MONTANA 59102	20,267	5,206	5,114	92	15,061			936	
53	GARY & JOYCE M. STOPPEL	391 MONCLAIR DRIVE BILLINGS, MONTANA 59102	22,600	4,464	3,761	703	18,136			422	
54	GARY & JOYCE M. STOPPEL	391 MONCLAIR DRIVE BILLINGS, MONTANA 59102								840	
55	YELLOWSTONE COUNTY	P.O. BOX 35001 BILLINGS, MT. 59107	1,264	29	0	29	1,235			1,235	
56	THE WESTERN SUGAR COMPANY, A DELAWARE CORPORATION	SEE SHEET NO. 20									

* EASEMENT TO BE TAKEN IN THE NAME OF GREY EAGLE DITCH CO.

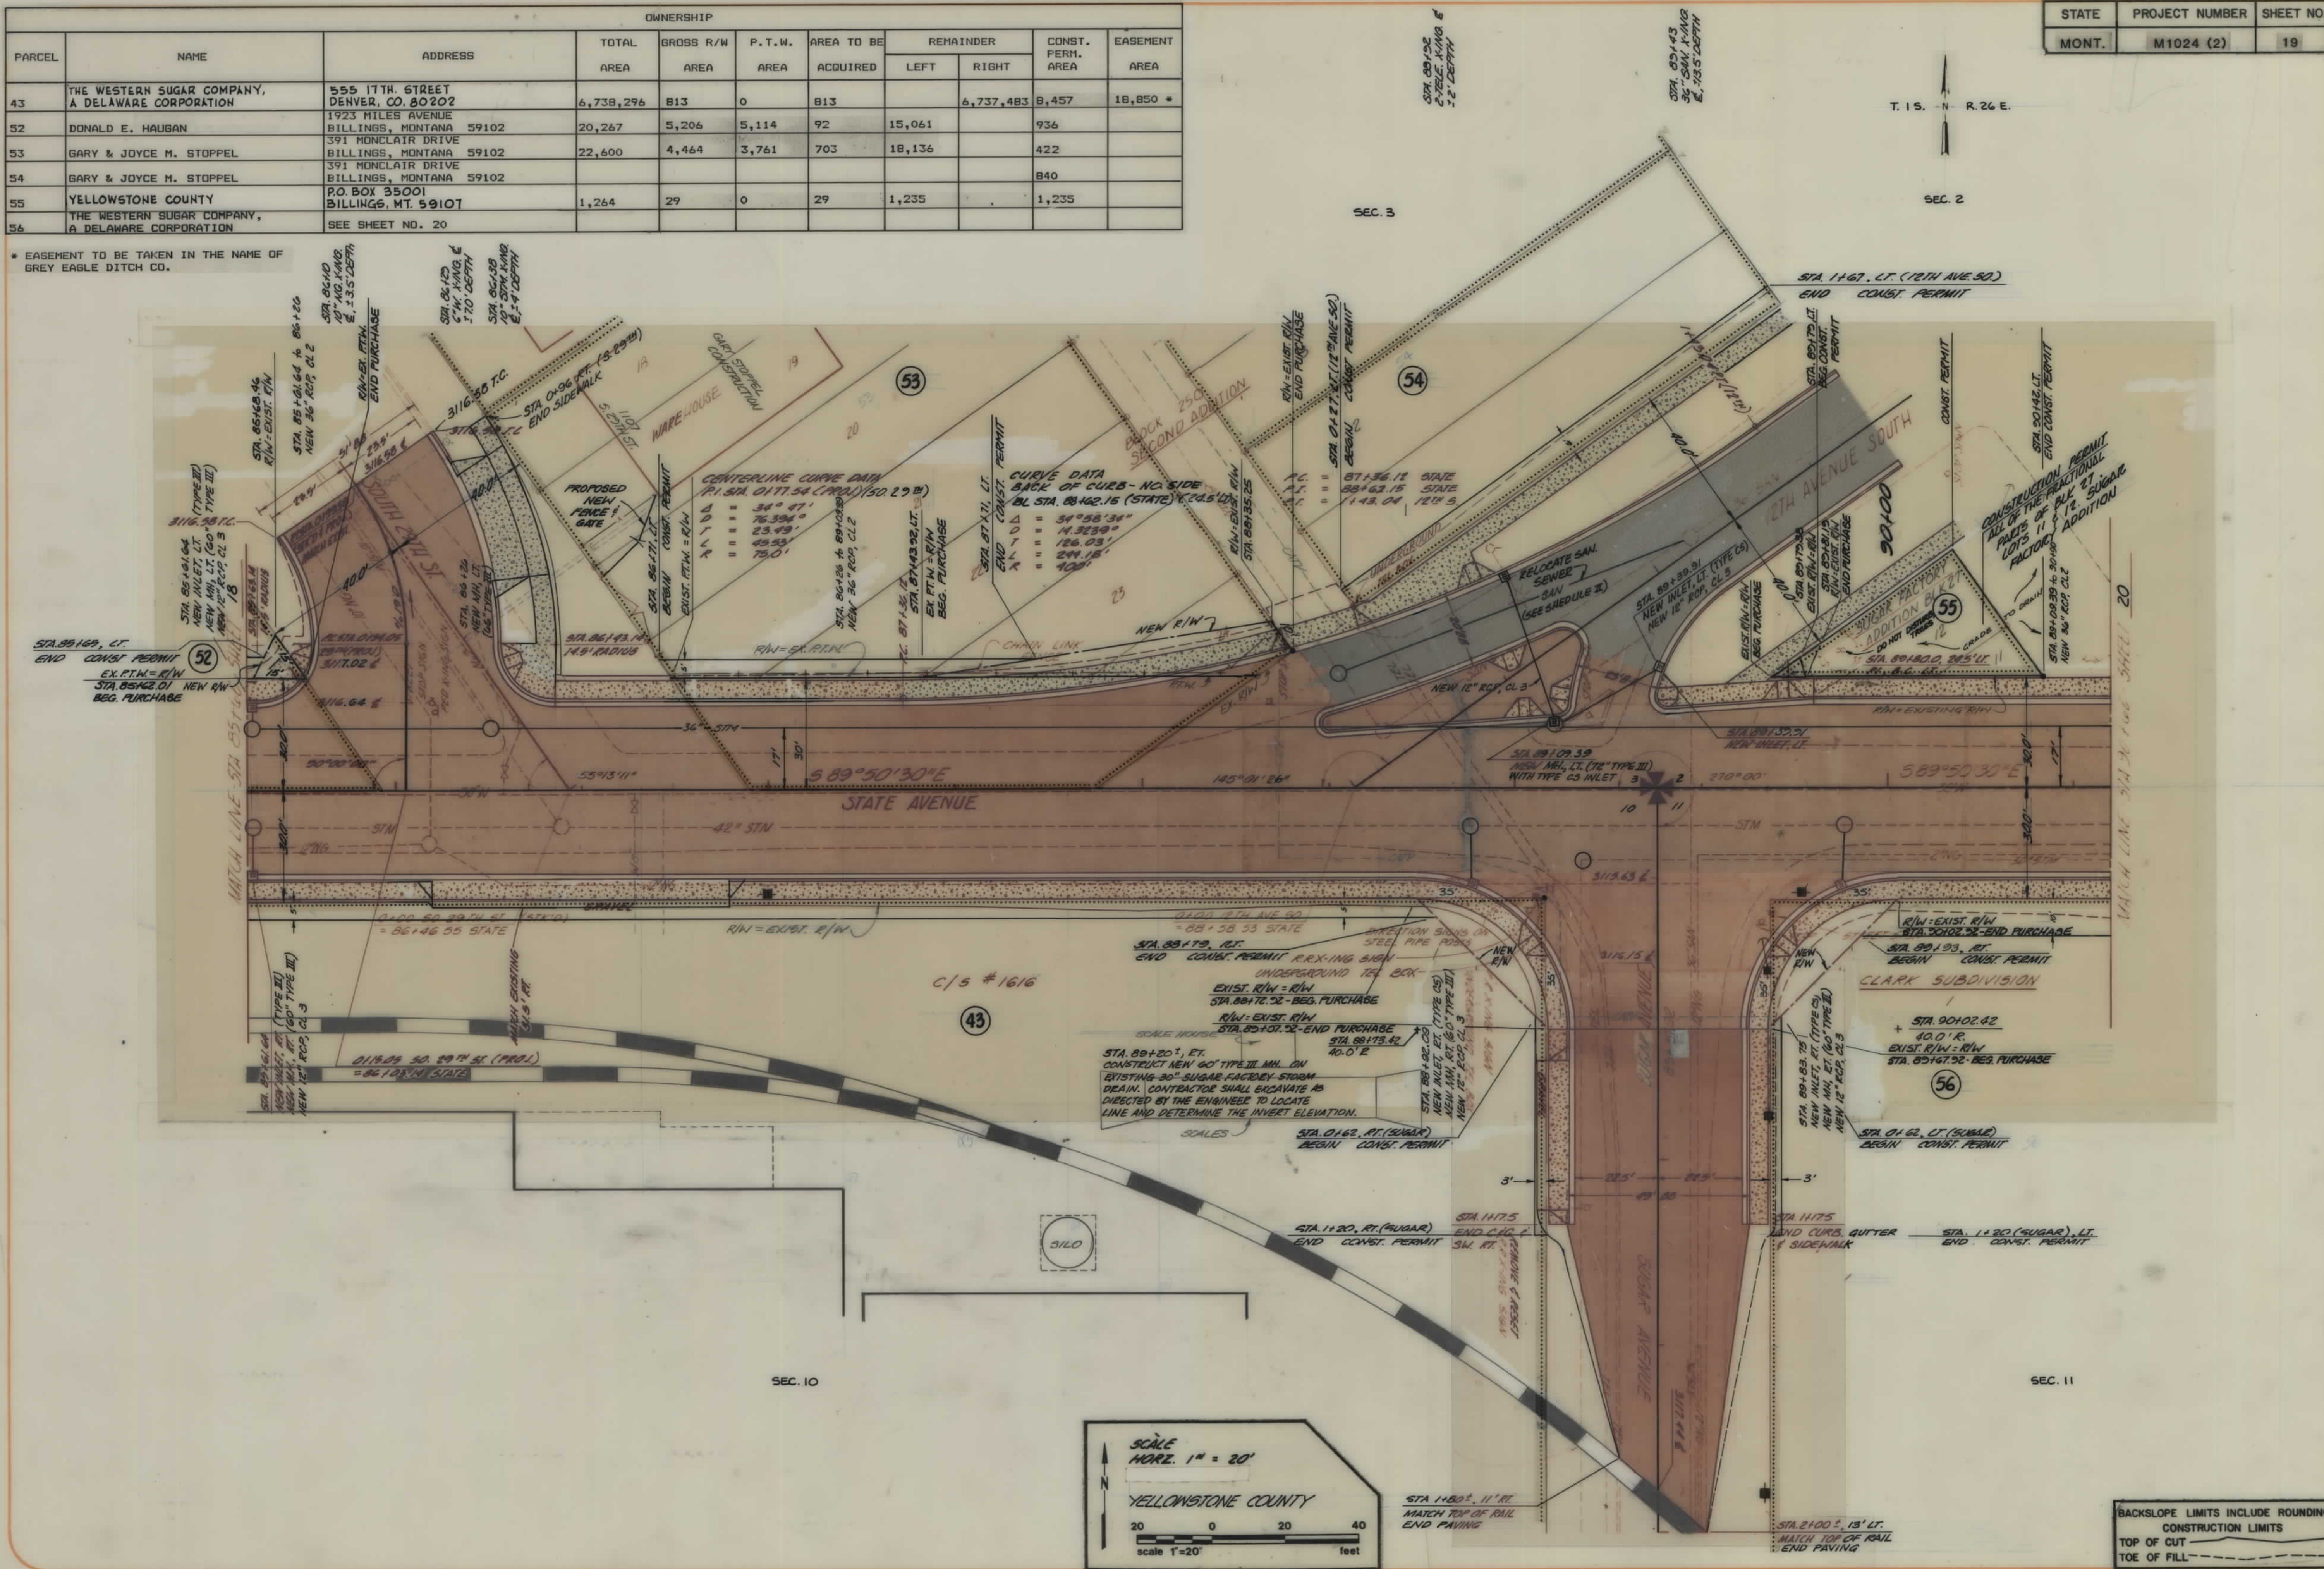

STATE

MONT.

PROJECT NUMBER

M1024 (2)

SHEET NO.

19

REVISIONS

No.	Date	Description

DATE

DEC. 1981

PROJECT NO.

2M025.123

STATE

RECONSTRUCTION

RIGHT OF WAY PLANS

APPROVED F.H.W.A. 1-4-87

YELLOWSTONE CO.

DATE

DEC. 1981

PROJECT NO.

2M025.123

DATE

DEC. 1981

PROJECT NO.

2M025.123

DATE

DEC. 1981

PROJECT NO.

2M025.123

OWNERSHIP										
PARCEL	NAME	ADDRESS	TOTAL	GROSS R/W	P.T.W.	AREA TO BE	REMAINDER		CONST. PERM. AREA	EASEMENT AREA
			AREA	AREA	AREA	ACQUIRED	LEFT	RIGHT		
58	C.C. SPENCER	C/O RED RIVER ROYALTY CORP. 100 N. 27 ST, SUITE 700, BILLINGS	42,000	2,488	0	2,488	39,512			

STATE	PROJECT NUMBER	SHEET NO.
MONT.	M1024 (2)	22



H K M ASSOCIATES
ENGINEERS - ARCHITECTS - PLANNERS
Executive Plaza - Airport Industrial Park
PO Box 9318, Billings, Montana 59107 (406) 245-8354

Approved: JACOBSON

Checked: MASH

Drawn: DT - DCR - DBC

Date: DEC 1981

Project No. 21025.123




STATE AVENUE RECONSTRUCTION

RIGHT OF WAY PLANS
APPROVED F.H.W.A. 1-4-89
YELLOWSTONE CO

Sheet No.

22

22

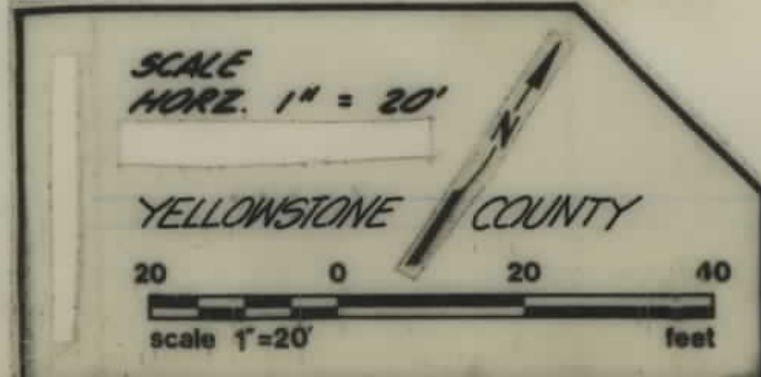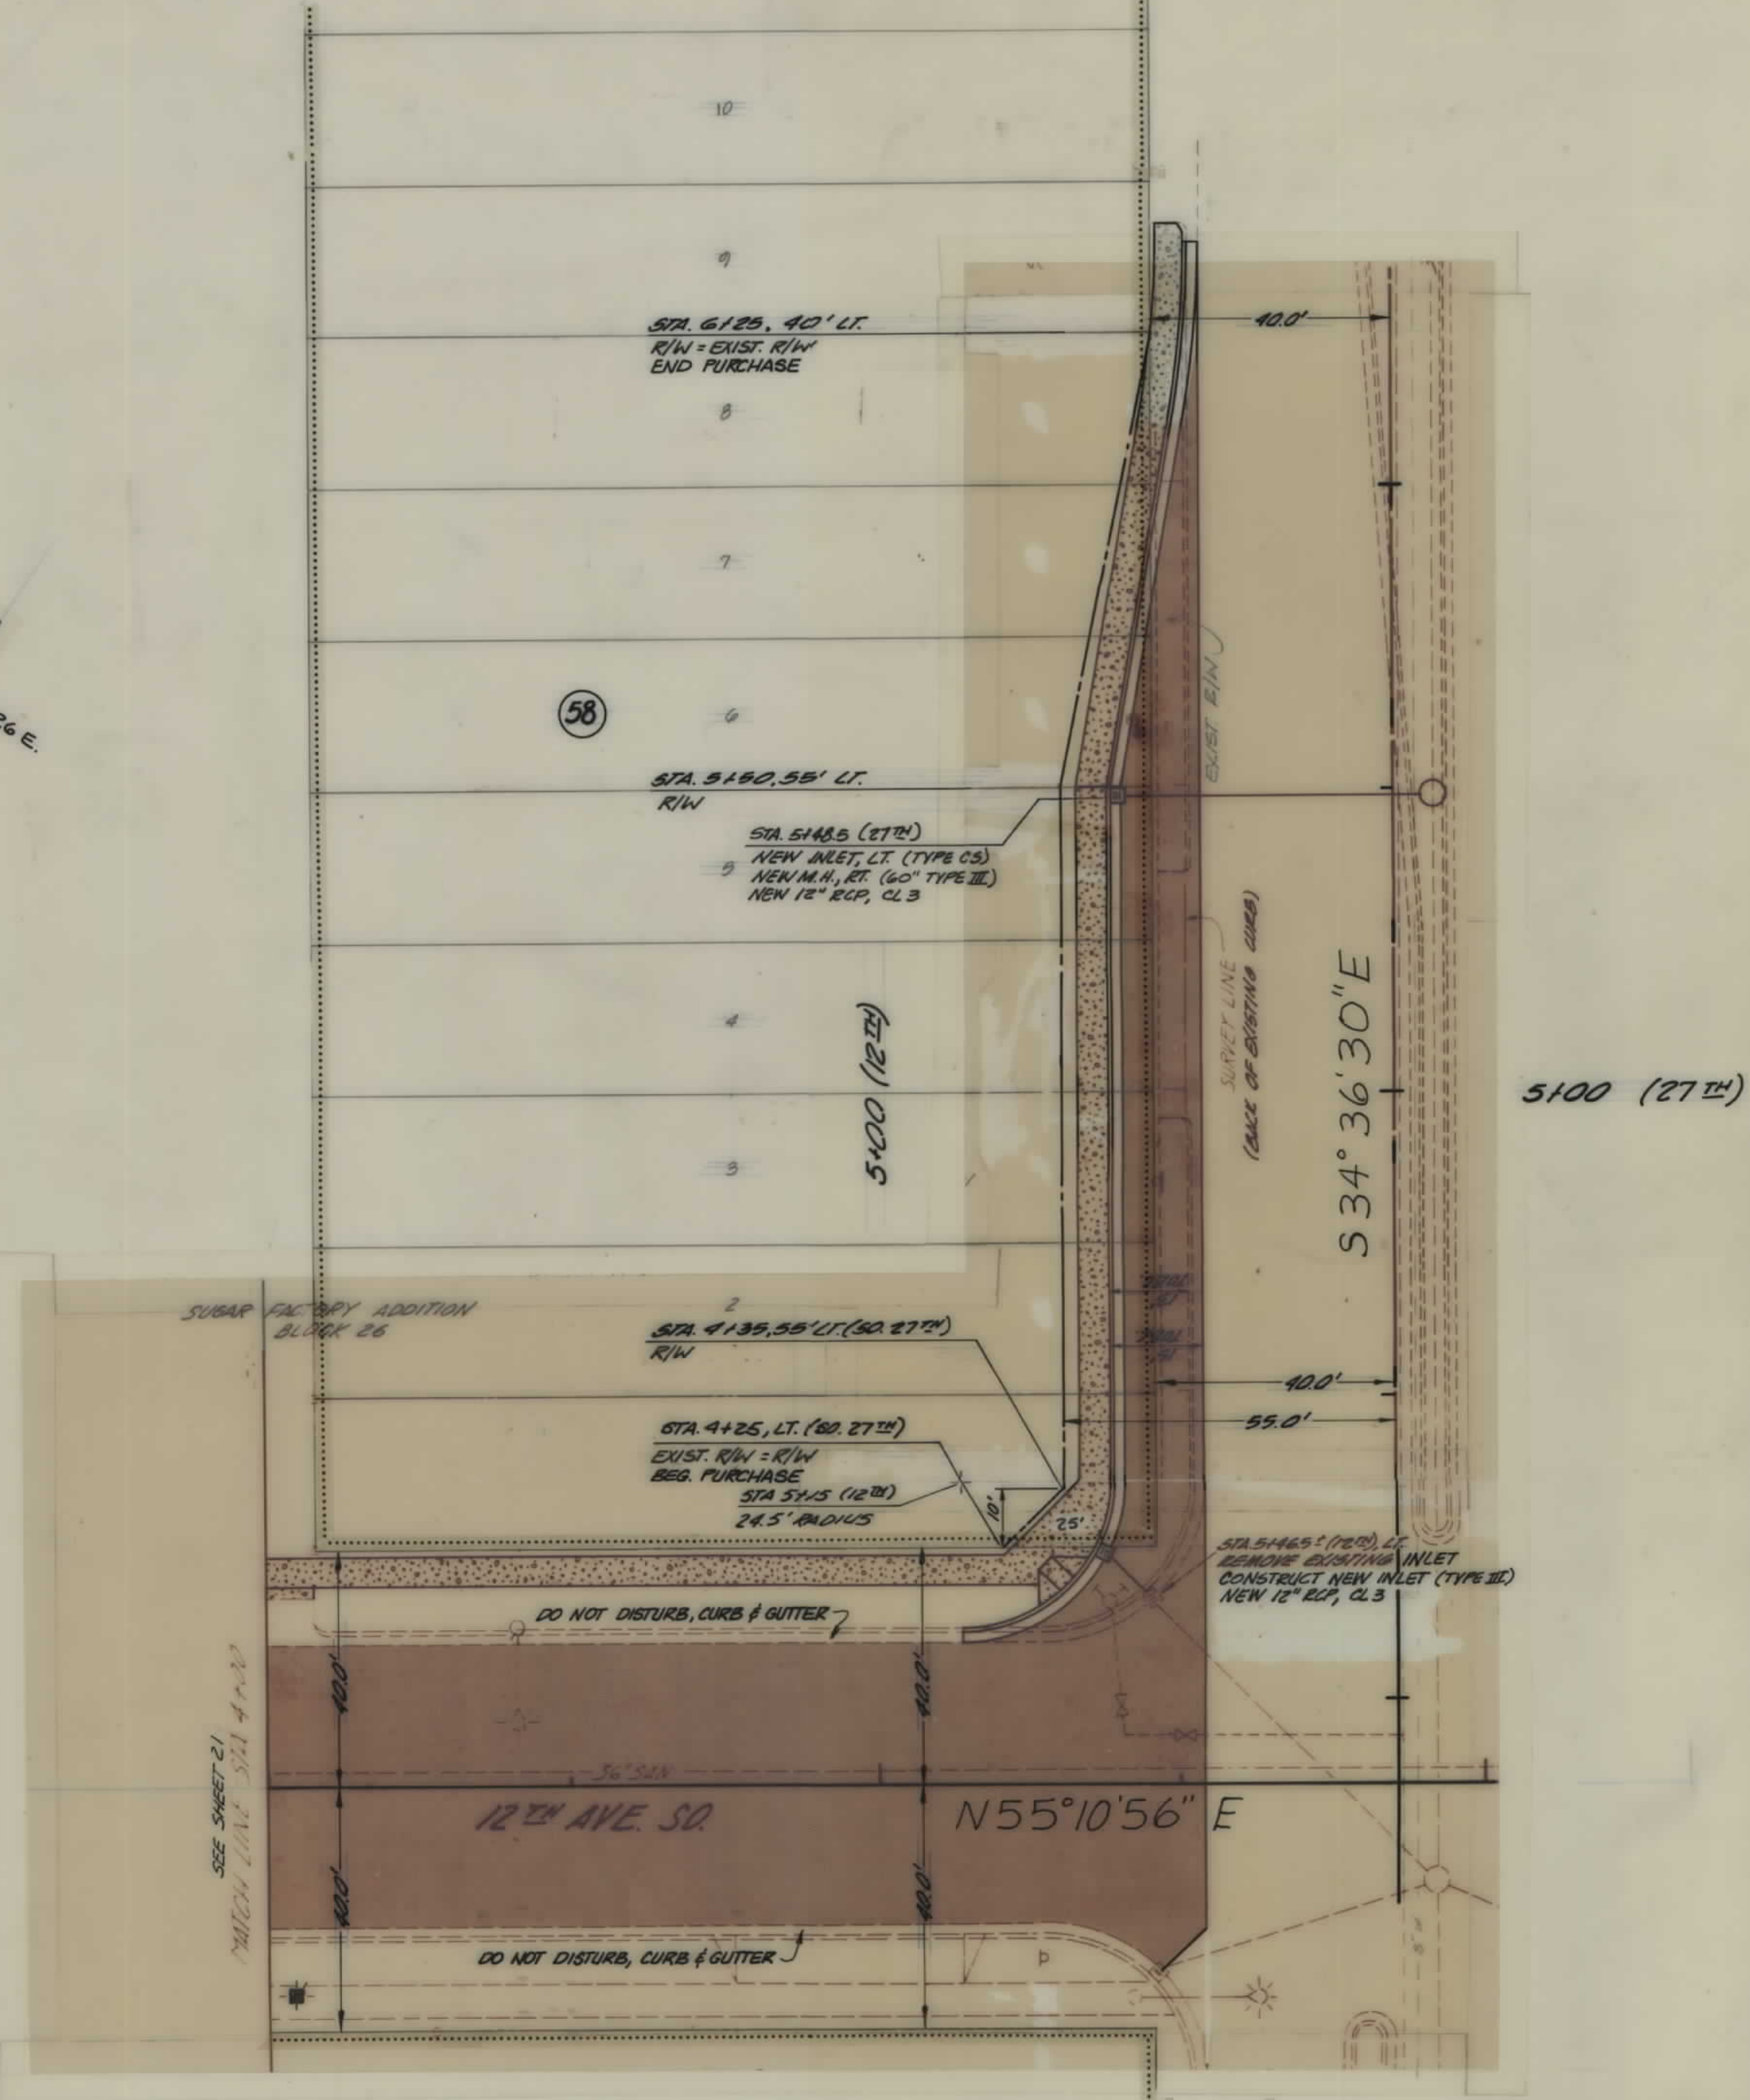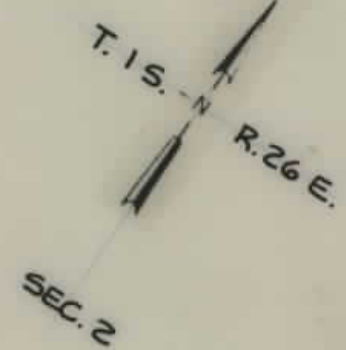

BACKSLOPE LIMITS INCLUDE ROUNDING
CONSTRUCTION LIMITS
TOP OF CUT
TOE OF FILL

FHWA APPROVAL 1-4-89