


PLANS
NOT
TO
SCALE

U. S. DEPARTMENT OF TRANSPORTATION
FEDERAL HIGHWAY ADMINISTRATION
REGION 3
"AS CONSTRUCTED" PLANS

PROJECT NO. - DESIGNATION	SHEET NO.	TOTAL SHEETS
FHP 42-C4 THRU J2, UNIT 2 & 42-C5 THRU J4	1	2
WEST GALLATIN HIGHWAY		

BEG. PROJ. 42-C4 D2 E3 F2 G2 H2 J2 Unit 1
END PROJ. 42-C4 D2 E3 F2 G2 H2 J2 Unit 2
This Section Included in
42-C5 D3 E4 F3 G3 H3 J3 J4

4261
YWH NITALLAD T2SW ANATIOM
42 UNT 20-54 & 51NU, SL UNT 40-54 9.HH
PAM '004
NOSAM.A.M

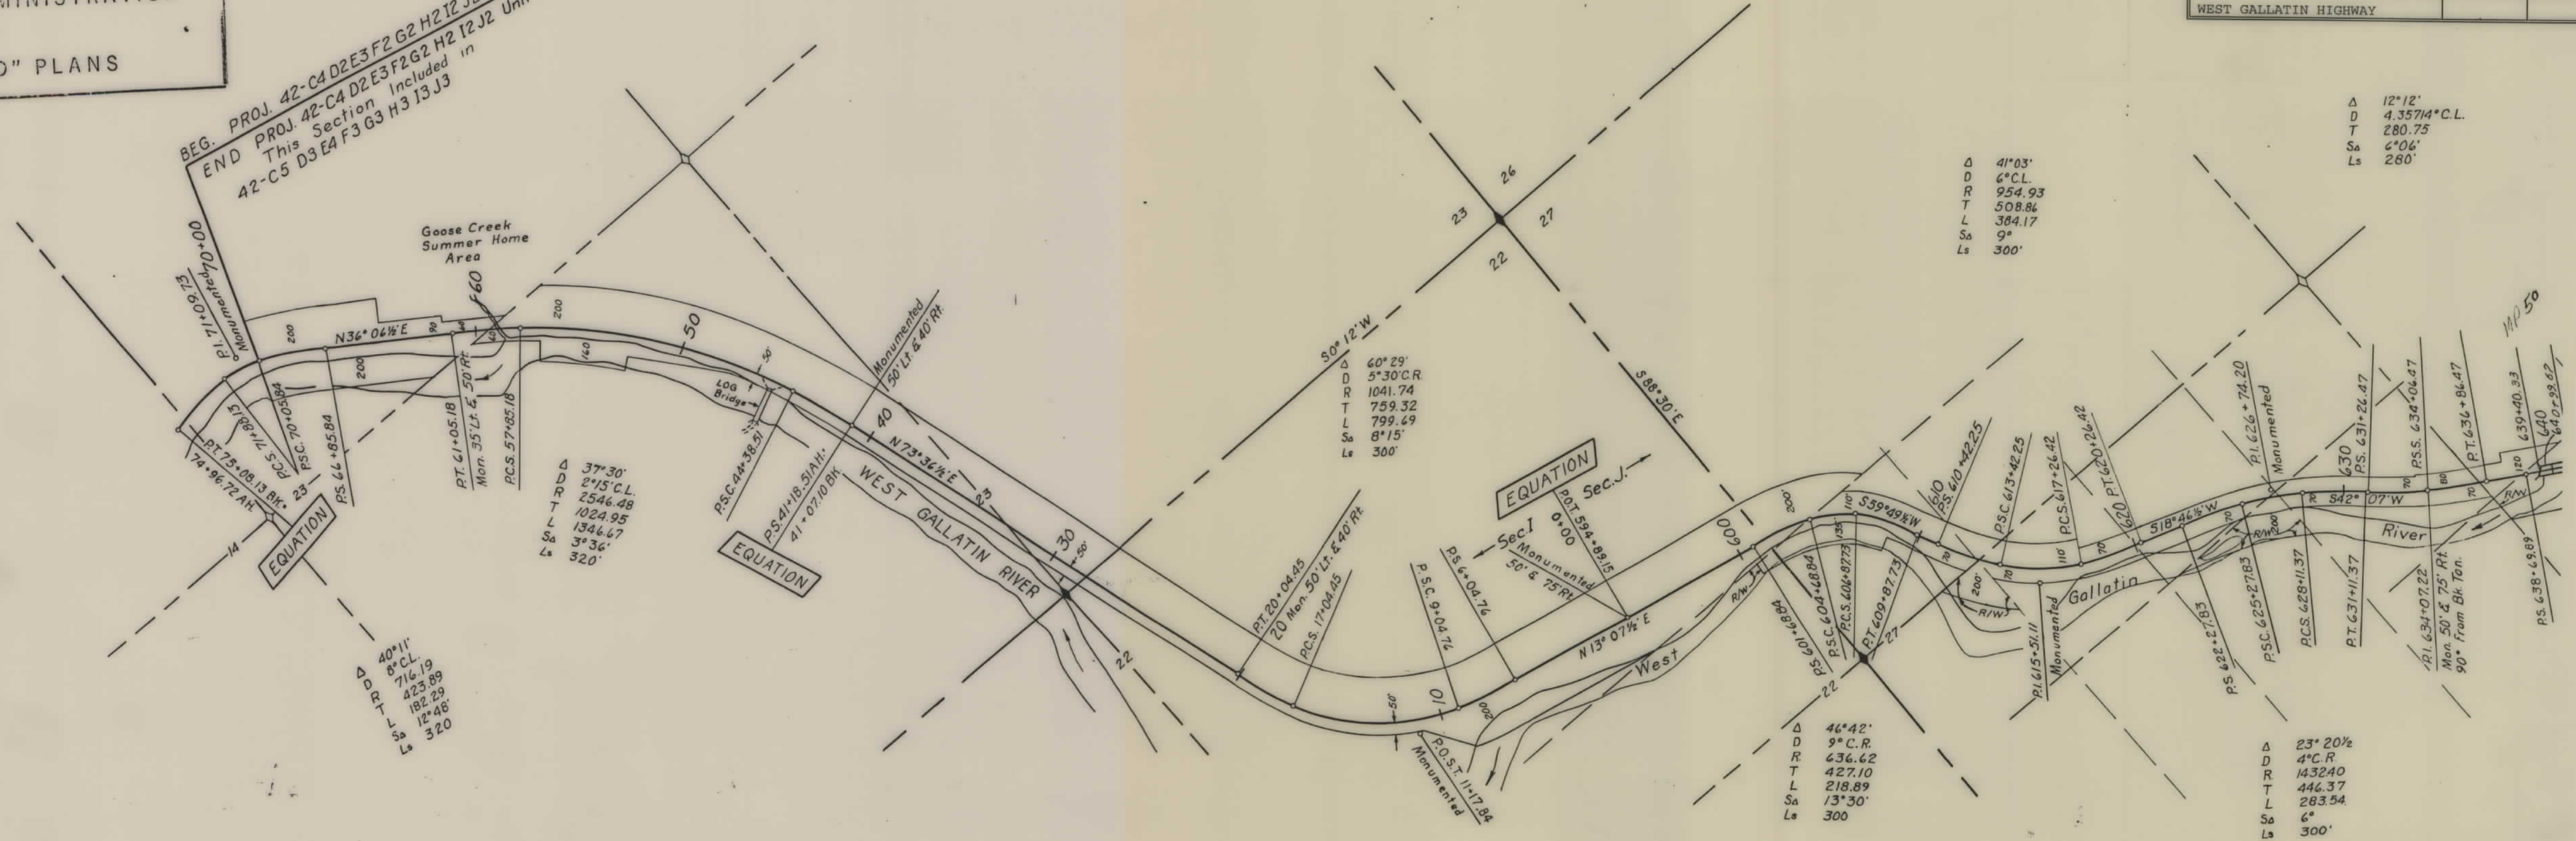

GALLATIN

NATIONAL

FOREST

CLASSIFICATION
CLEARING


DRAINAGE
STRUCTURES

BENCH MARKS

PROFILE
HOR: 400'
VERT: 40'

RES. ENGR. M.A. MASON
PLOTTED BY " "
CHECKED BY
TRACED BY R.J. EDINGER

WEST GALLATIN HWY.
42-C4 Thru J2 Unit 2
3.9559 MILES - 1954
42-C5 Thru J4
13.020 MILES - 1955

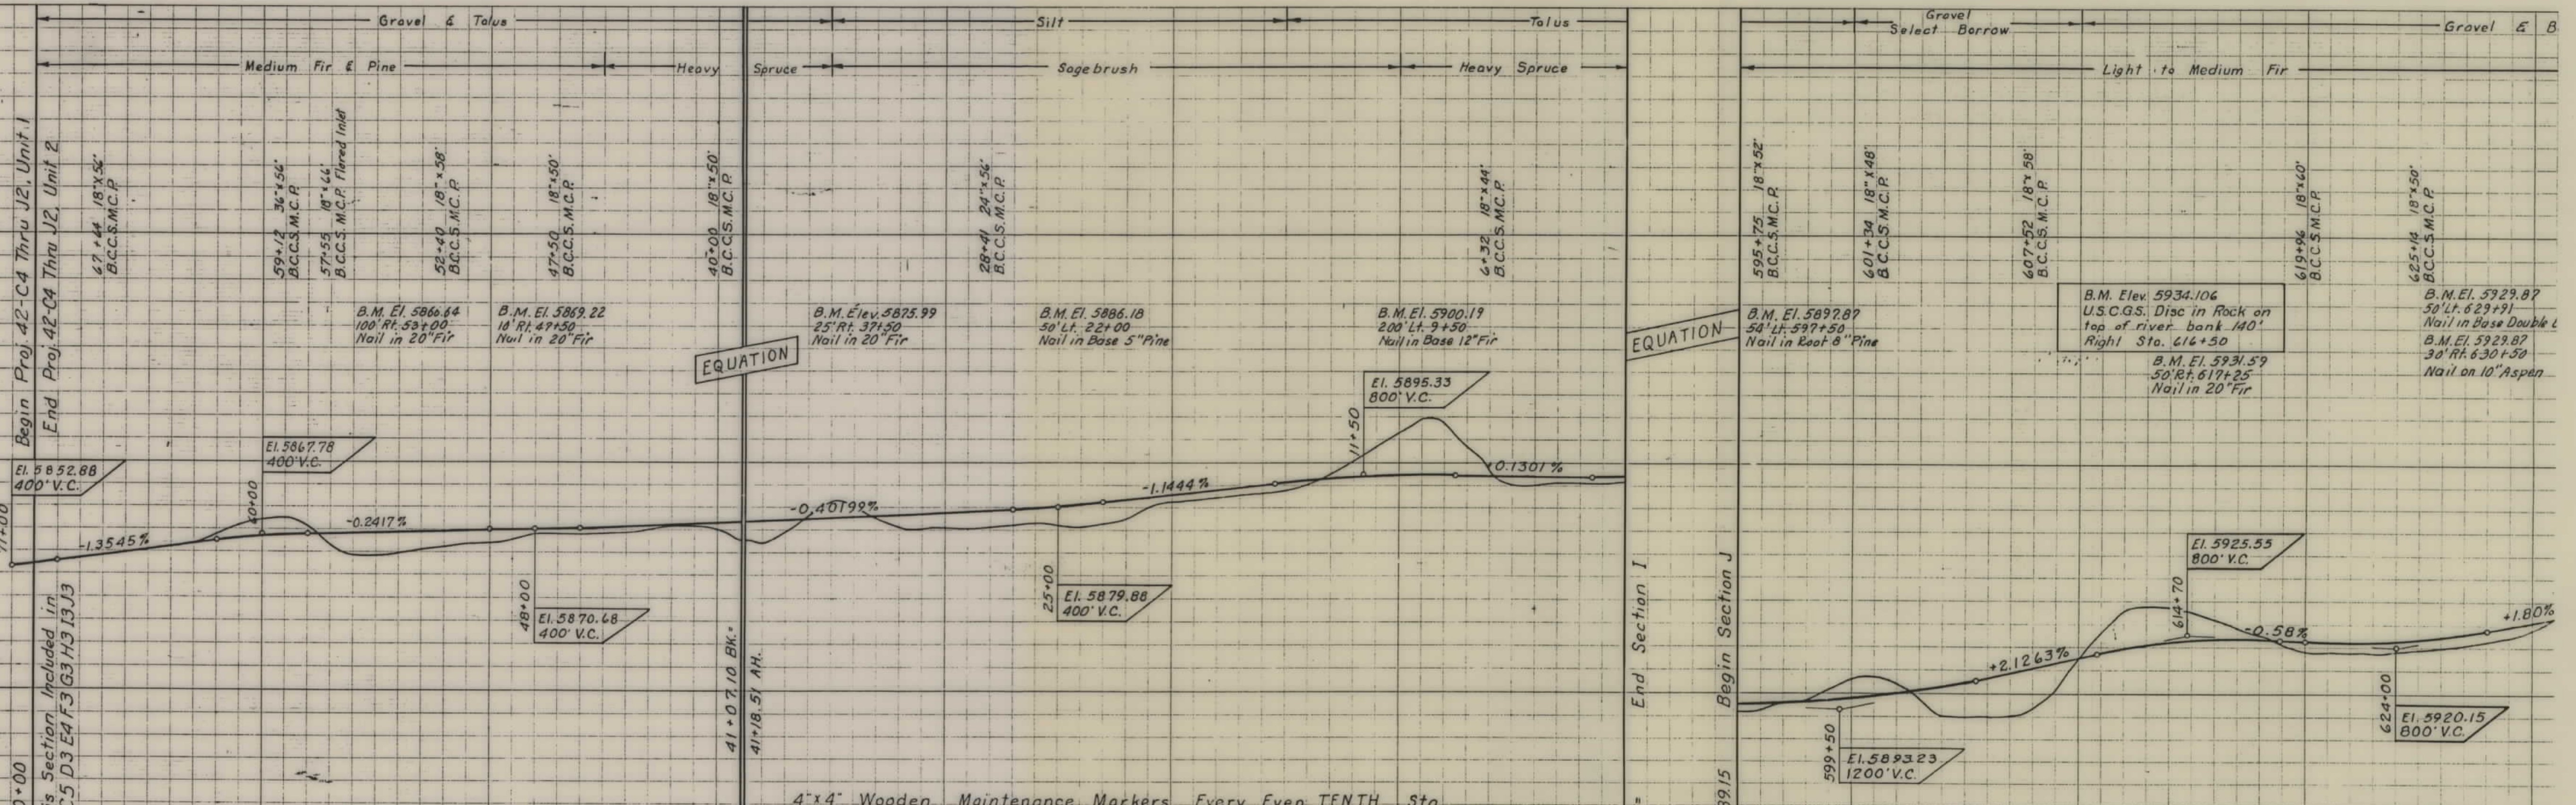


PROJECT NO. - DESIGNATION	SHEET NO.	TOTAL SHEETS
FHP 42-C4 THRU J2, UNIT 2 & 42-C5 THRU J4	2	2
WEST GALLATIN HIGHWAY		

"AS CONSTRUCTED" PI

DEPARTMENT C
FEDERAL HIGHWAY

REGIO

"AS CONSTRUCTED"

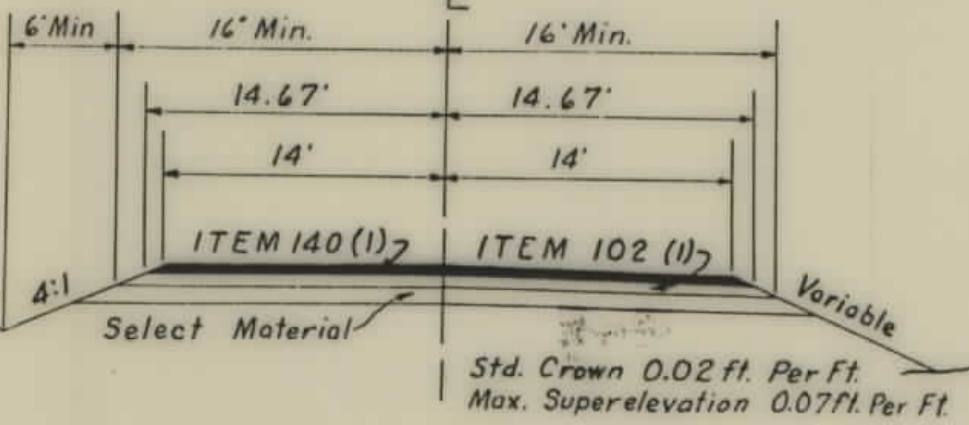

M.A. MASON
400' W.B.P.
MONTANA WEST GALLATIN
F.H.P. 42-C4 THRU J2, UNIT 2 & 42-C5 THRU J4
1924

