


PLANS
NOT
TO
SCALE


FED. ROAD DIST. NO.	STATE	FED. AID PROJ. NO.	R/W NO.	SHEET NO.	TOTAL SHEETS
1	MONT.	S 93(2)	3093-02	1	4

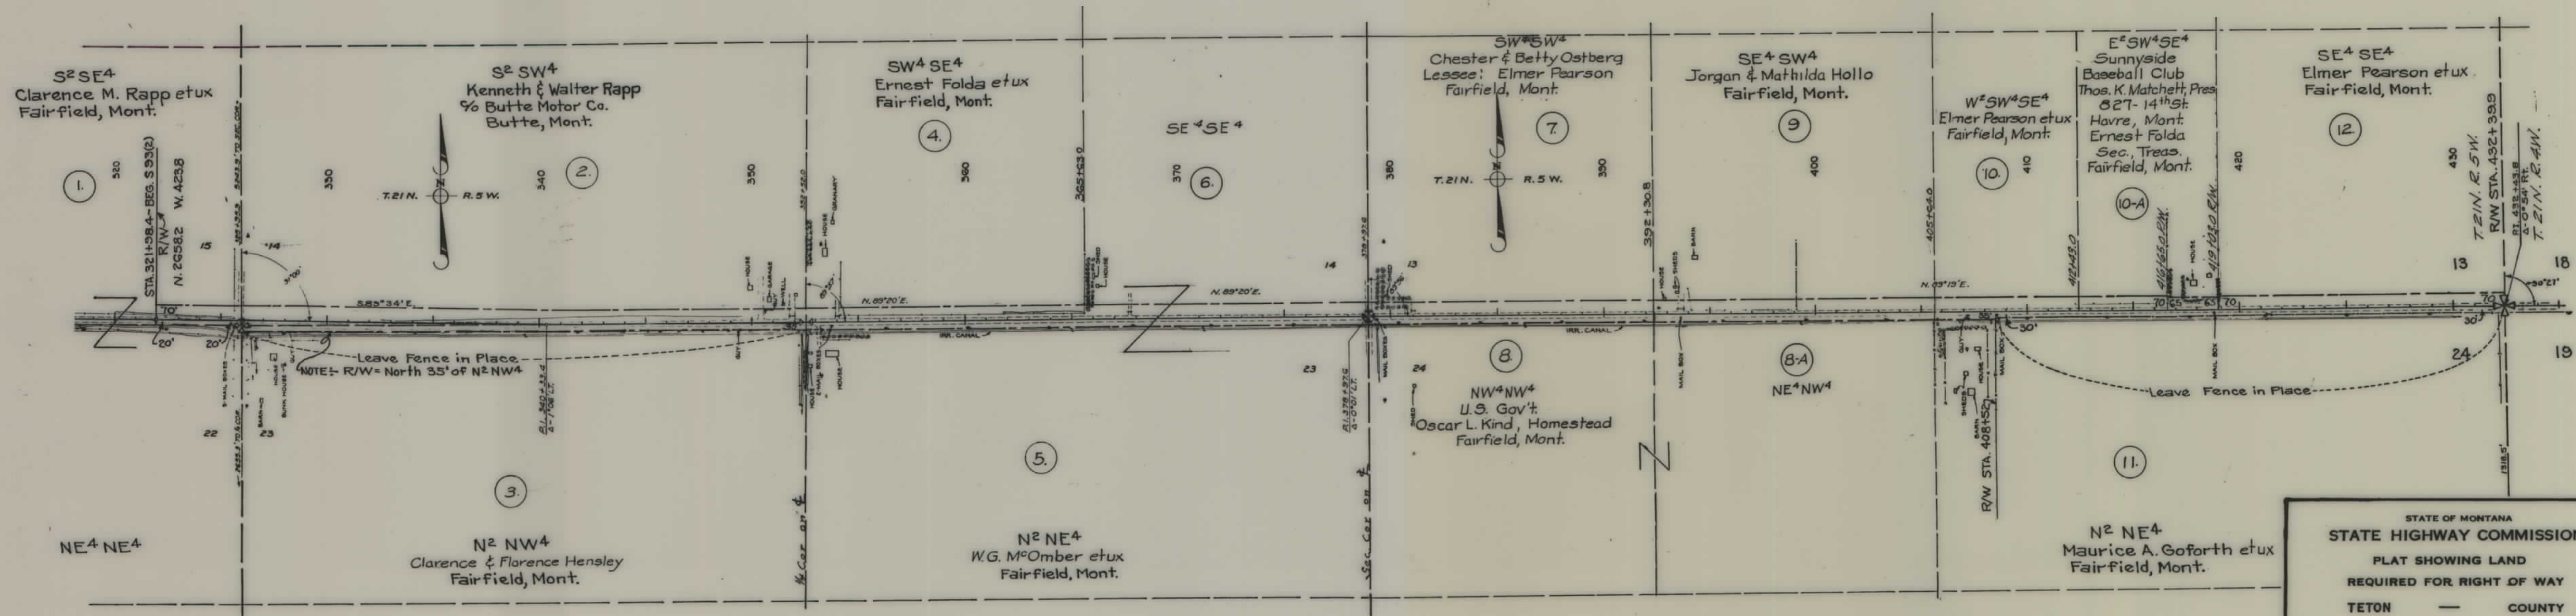

STATE OF MONTANA
 STATE HIGHWAY COMMISSION
 PLAT SHOWING LAND
 REQUIRED FOR RIGHT OF WAY
 TETON — COUNTY

SCALE 1" = 400' MAP COMPLETED 2-4-52
 DESCRIPTIONS WRITTEN BY L.B. DATE 2-4-52
 DESCRIPTIONS CHECKED BY J.F.P. DATE 2-4-52
 APPROVED BY Malcolm Bowden R/W ENGINEER

FED. ROAD DIST. NO.	STATE	FED. AID PROJ. NO.	R/W NO.	SHEET NO.	TOTAL SHEETS
8	MONT.	93 (2)	3093 (2)	2	4

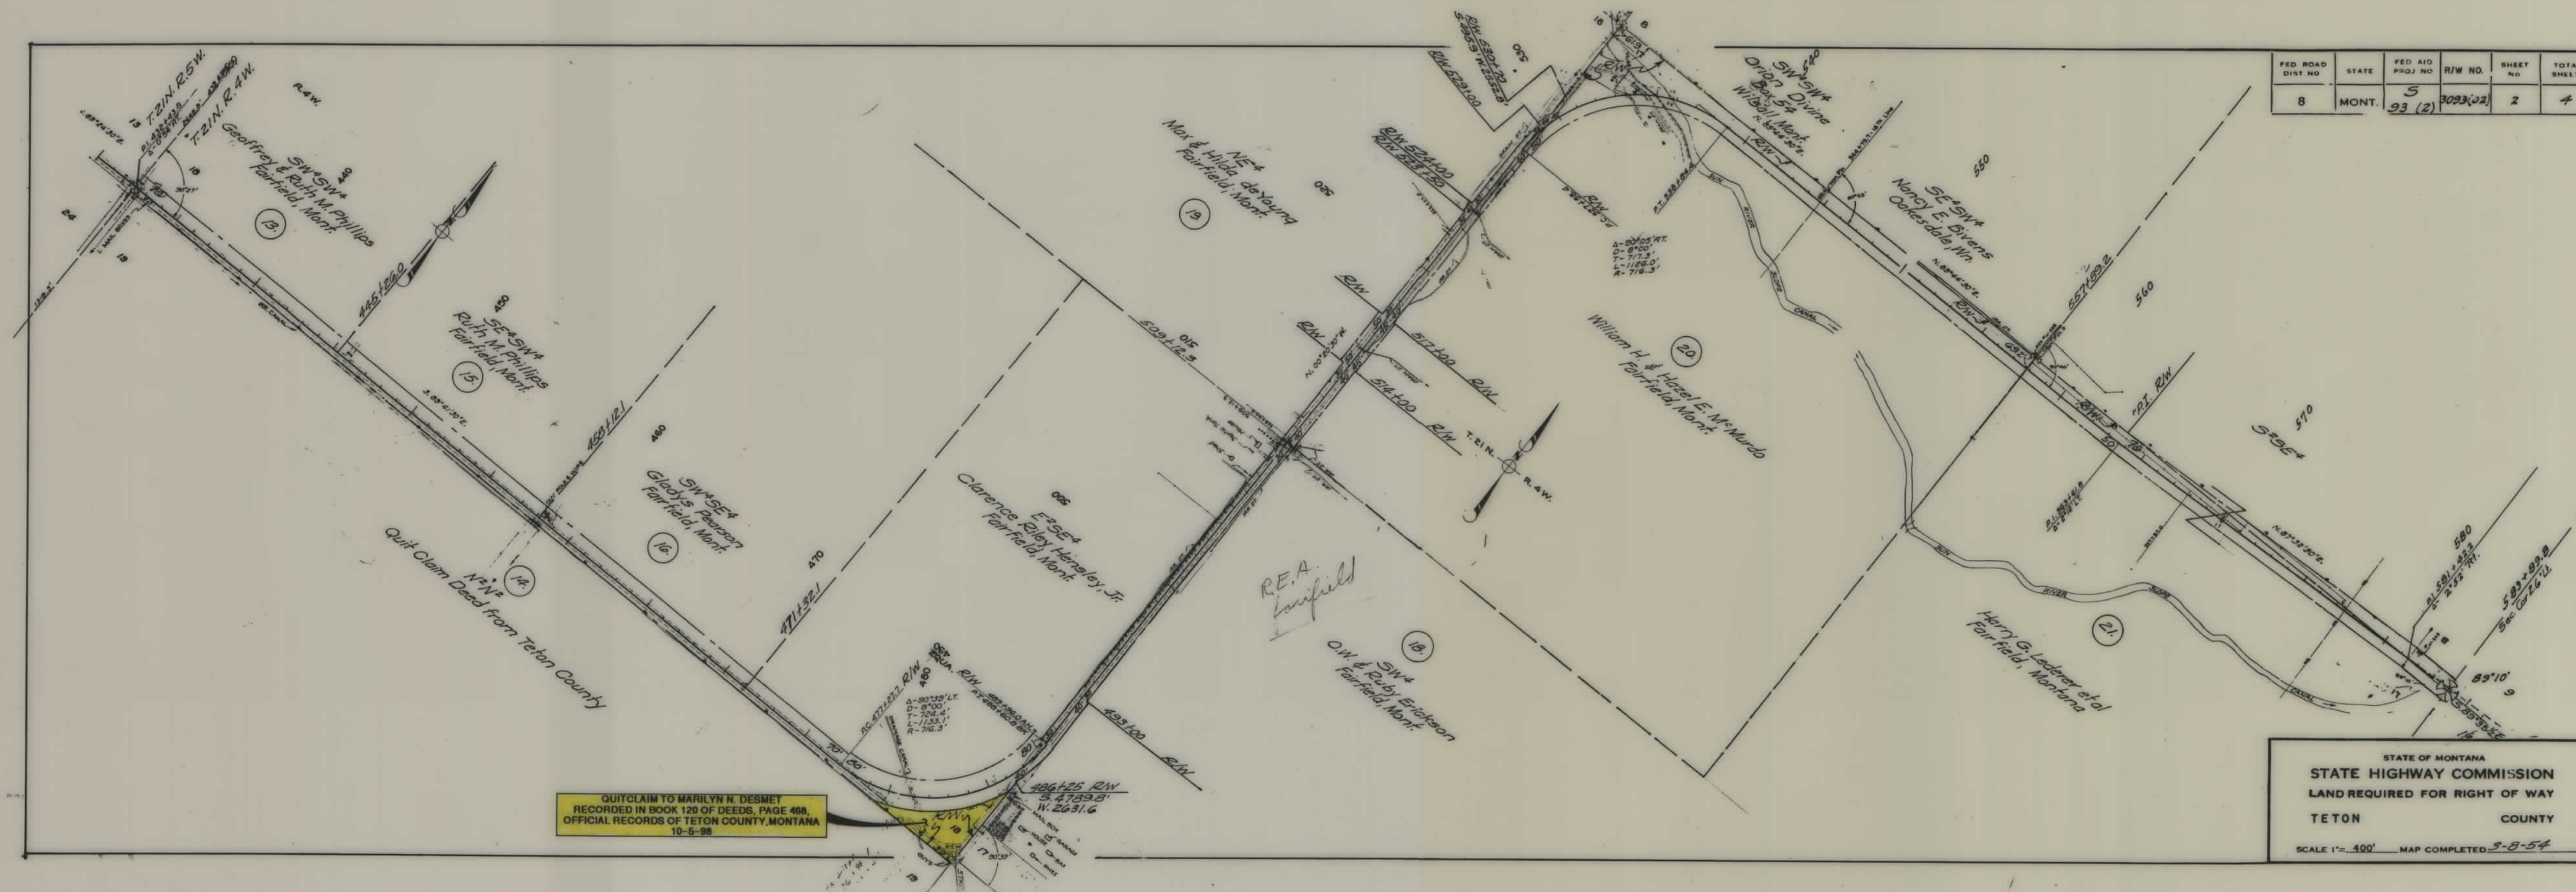

QUITCLAIM TO MARILYN N. DESMET
RECORDED IN BOOK 120 OF DEEDS, PAGE 468,
OFFICIAL RECORDS OF TETON COUNTY, MONTANA
10-5-98

STATE OF MONTANA
STATE HIGHWAY COMMISSION
LAND REQUIRED FOR RIGHT OF WAY
TETON COUNTY
SCALE 1" = 400' MAP COMPLETED 3-8-54

FED ROAD DIST NO	STATE	FED AID PROJ NO	R/W NO.	SHEET NO	TO SH
8	MONT.	5 93 (2)	3093 (02)	4	

M-012846

DEPARTMENT OF THE INTERIOR
BUREAU OF LAND MANAGEMENT
LAND OFFICE - BILLINGS, MONTANA

I HEREBY CERTIFY THAT THE RIGHT OF WAY REPRESENTED
HEREBON IN THE SE~~3~~⁴SE~~3~~⁴ SECTION 11, AND THE NE~~3~~⁴NE~~3~~⁴,
NW~~3~~⁴NE~~3~~⁴ SECTION 13, T 21 N, R 4 W, IS PUBLIC DO-
MAIN WITHDRAWN FOR RECLAMATION PURPOSES UNDER
FIRST FORM WITHDRAWAL, ACT OF JUNE 17, 1902, BY
ORDER OF THE SECRETARY OF THE INTERIOR, DATED
JANUARY 8, 1926, AND IS EMBRACED WITHIN THE
BOUNDARIES OF THE GREENFIELDS IRRIGATION DISTRICT.

Orval G. Hadley
ORVAL G. HADLEY, Manager

APRIL 27 1954
(date)

STATE OF MONTANA
STATE HIGHWAY COMMISSION
LAND REQUIRED FOR RIGHT OF WAY
TETON COUNTY

SCALE 1" = 400' MAP COMPLETED 3-9-54

S 93(2) SHT 4 OF 4

