

**PLANS
NOT
TO
SCALE**

PLAN	SURVISED	BY	DATE
NOTE BOOK	PLOTTED	R.A. Frame	1959
	ALIGNMENT CHECKED	" "	1960
	RT. OF WAY CHECKED		
NO.	DRAFTED	CAL Larson	1-1961

U. S. DEPARTMENT OF INTERIOR
NATIONAL PARK SERVICE
AS CONSTRUCTED PLANS OF
GLACIER NATIONAL PARK
PROJECTS 2-A2, B2 & 12-A2
TWO MEDICINE ROAD & APPROACH
MONTANA

BEGAN 7-61	COMPLETED 8-63
PROJECT LENGTH OF MILES	
1	1
2	2
3	3
100	100


GRADING	7.181 MILES
BASE(2 BRIDGES INCL.)	7.219 MILES

TOTAL	7.219 MILES
-------	-------------


RES. ENGR.
PREPARED BY
CHECKED BY

R. A. FRAME
J. F. McGUIRE
W. L. BECKER

STA. 42+87.00 BEGIN PROJECT 12-A2

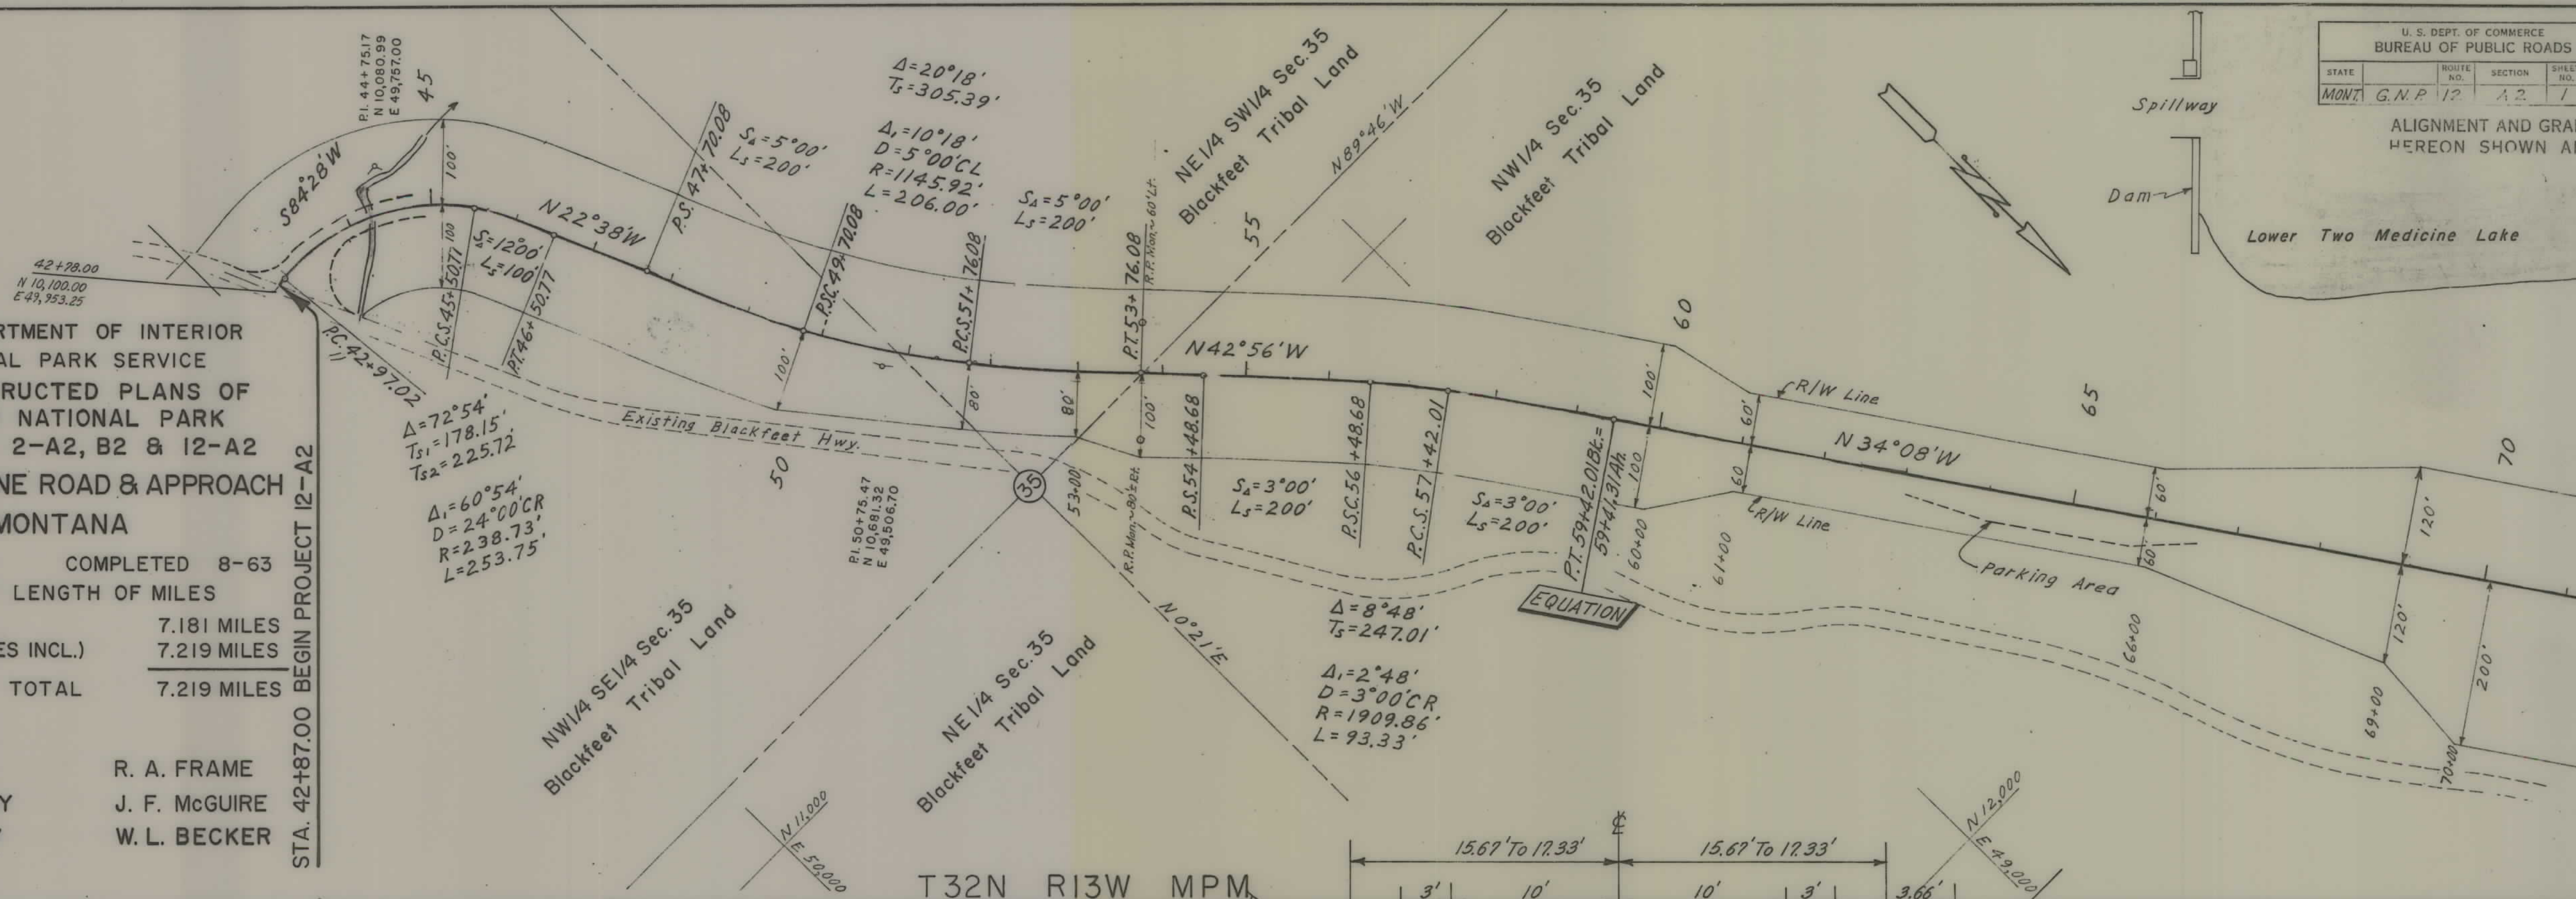


PROFILE		BY	DATE
SURVIVED			
PLOTTED			
NOTE BOOK			
GRADES CHECKED			
B.M.'s NOTED			
STRUCTURE NOTATION			
NO.			

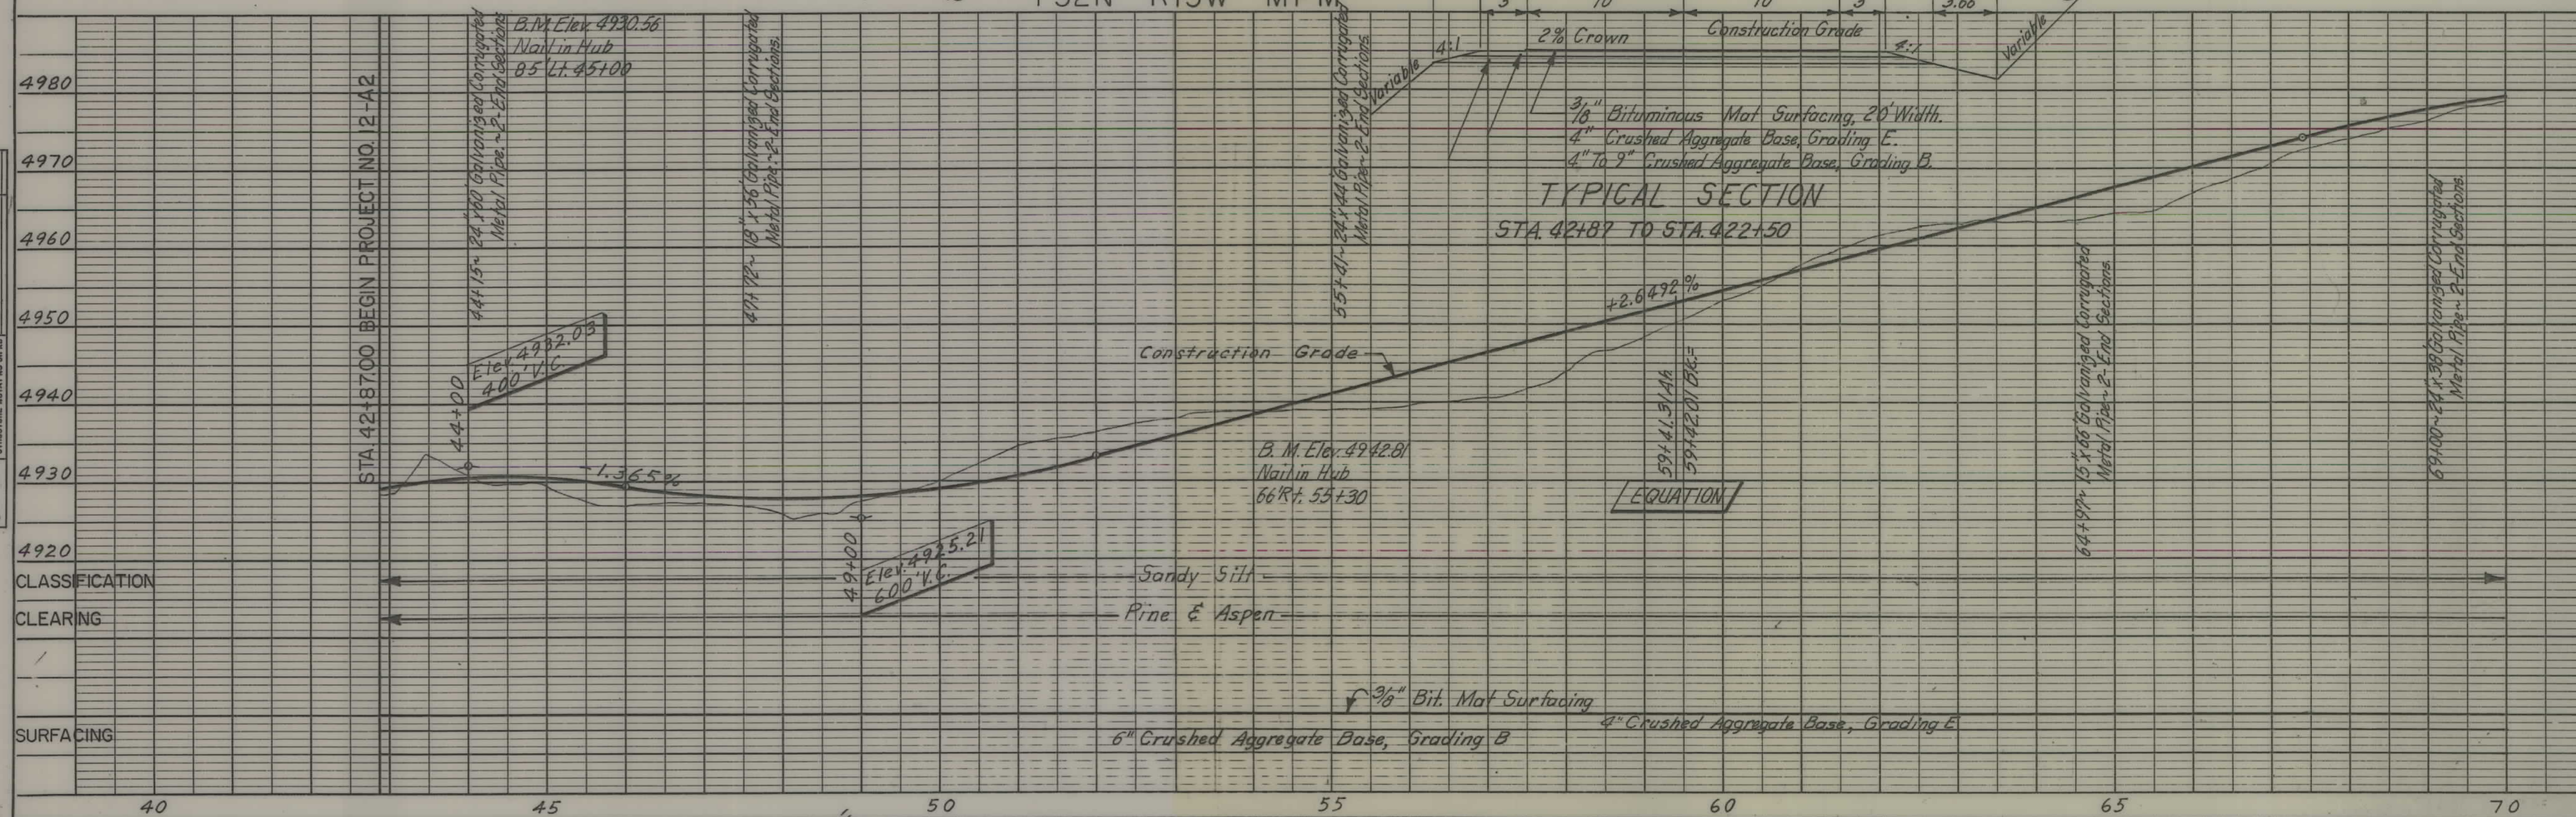


PLAN		DATE
SURVEYED	BY	1952
PLOTTED	R.A. Frazee	1962
NOTE BOOK		
ALIGNED	CHECKED	
RE. OF	NOTED	
DEPARTED	CAL. LOCATED	11/8/62
NO.		

PROFILE		DATE
SURVEYED	BY	
PLOTTED		
NOTE BOOK		
STRUCTURE NOTATIONS CHD		
NO.		

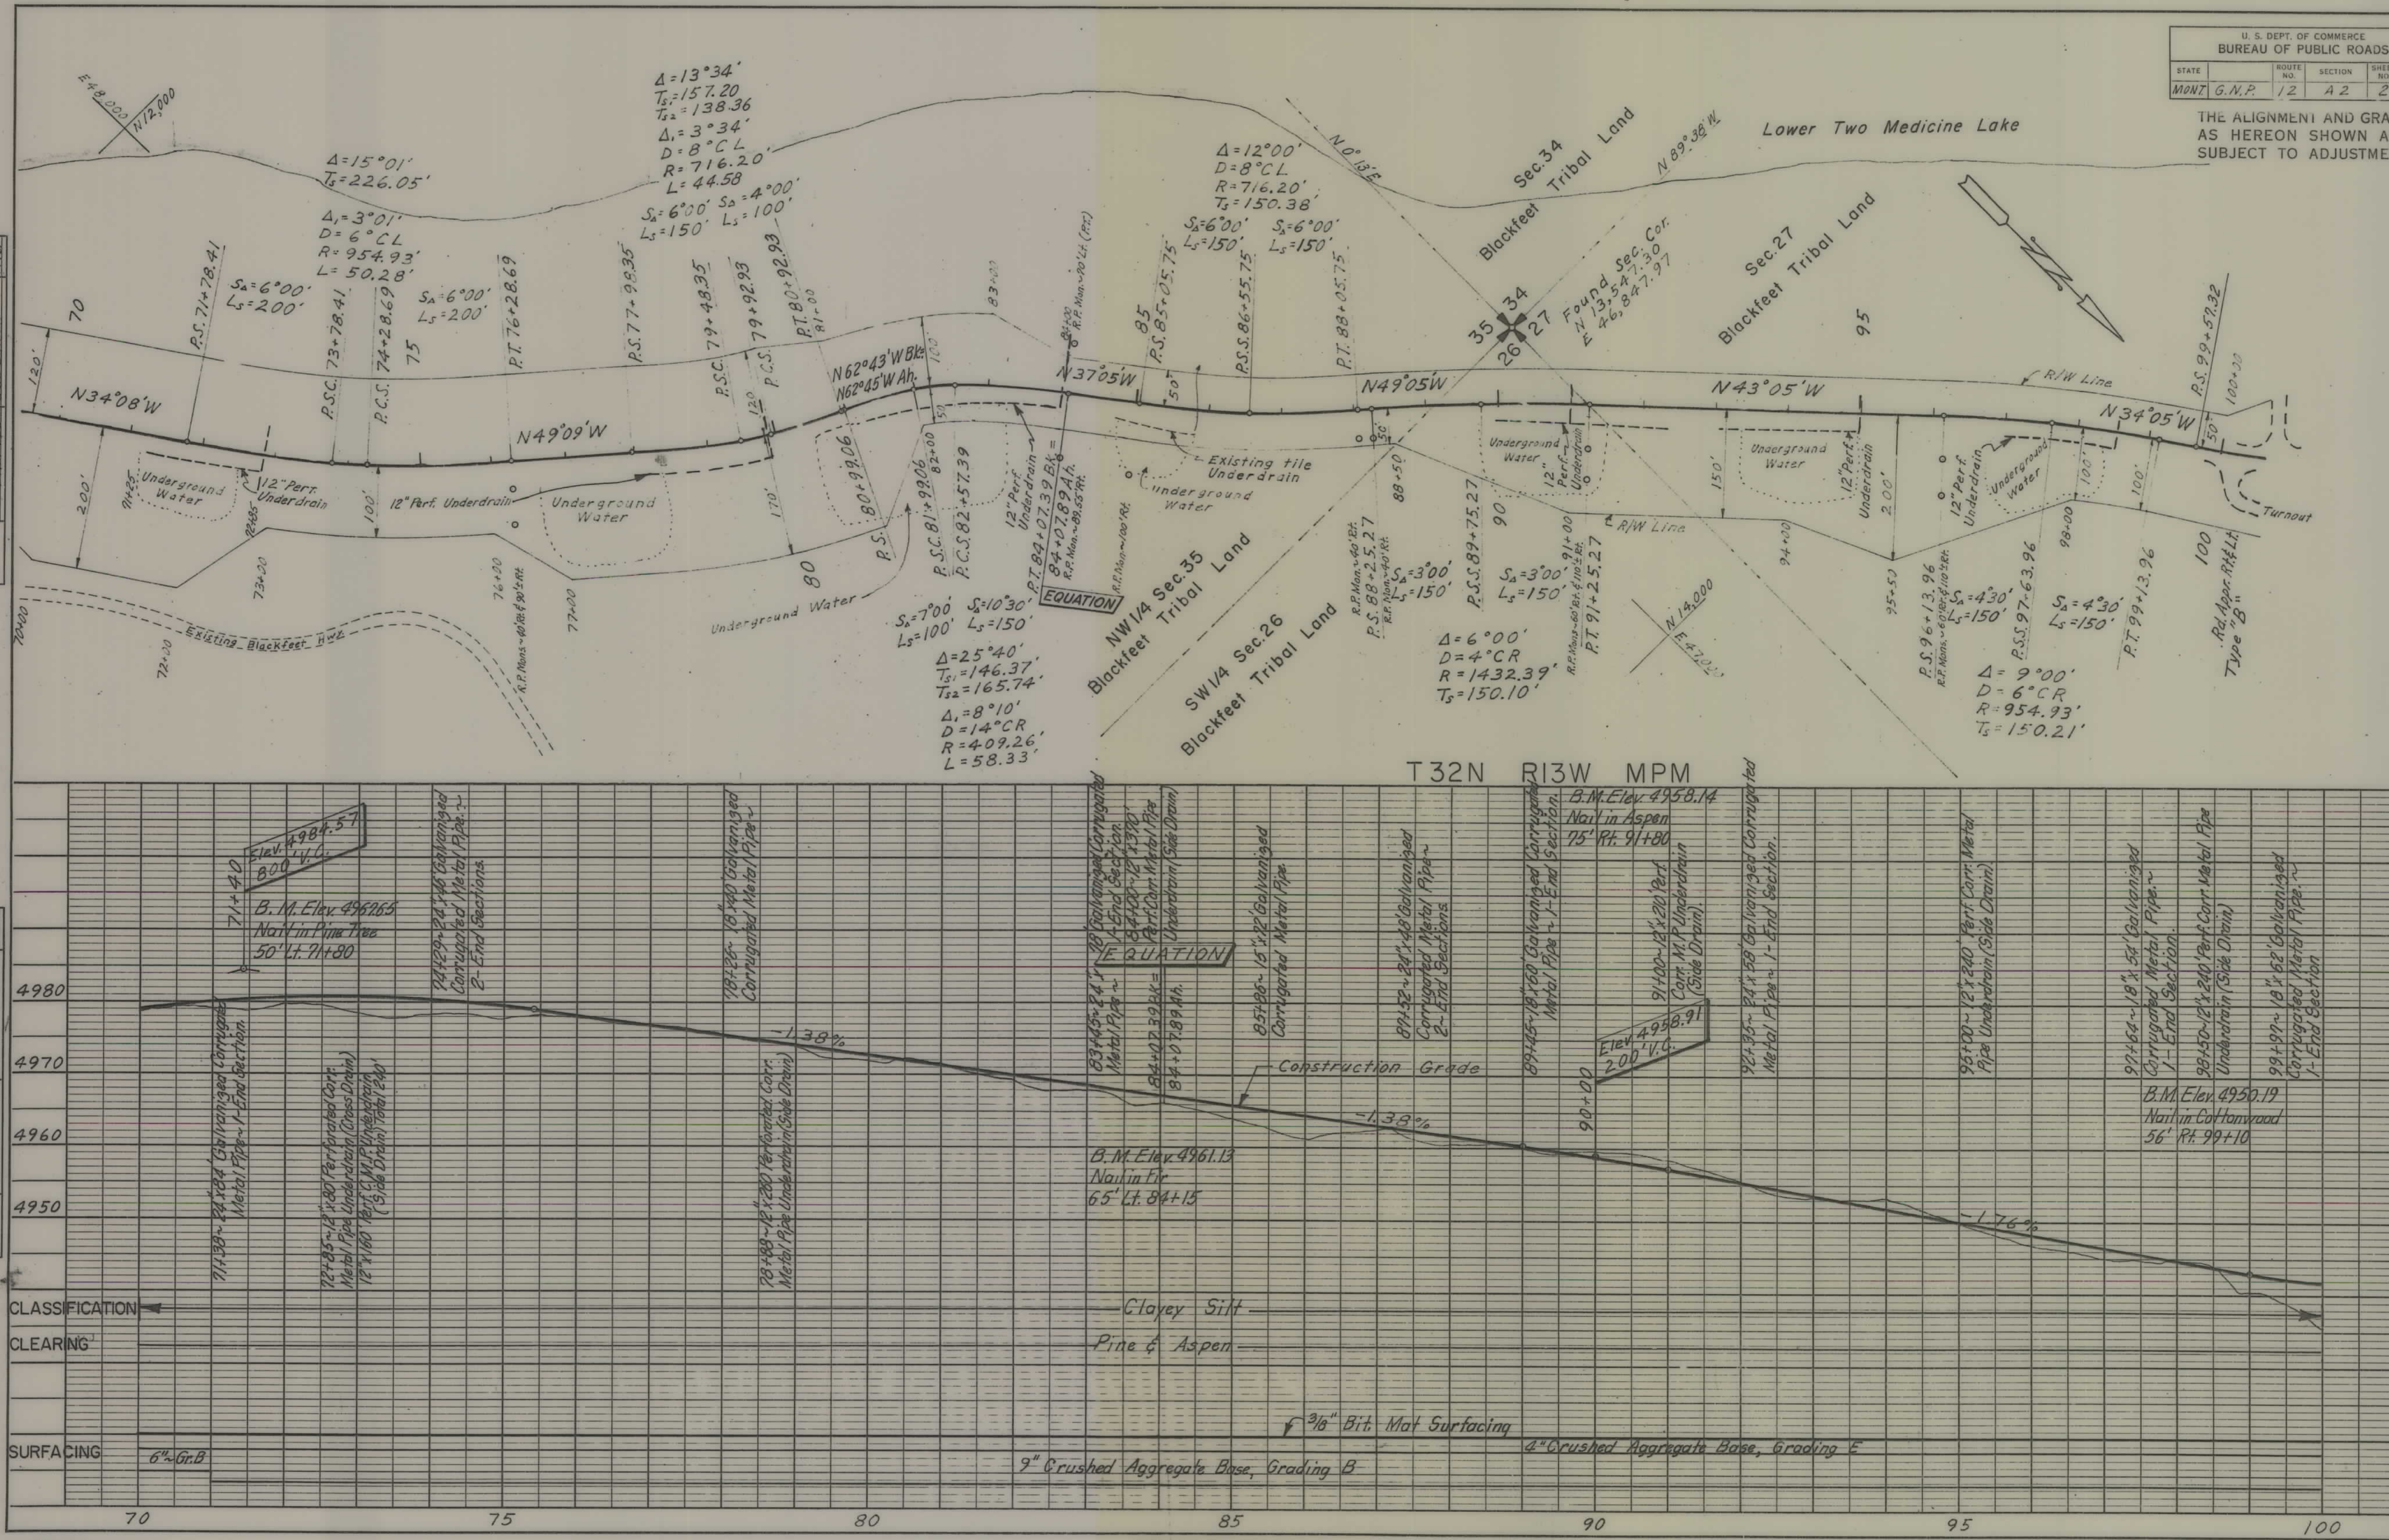

PLAN	BY			DATE
	SURVEYED	ALIGNED	CHECKED	
NOTE BOOK				1959
				1960
NO.				1-1961

PROFILE		BY	DATE
NOTE BOOK	SURVEYED		
	PLOTTED		
	GRADES CHECKED		
	B.M. NOTED		
	STRUCTURE NOTATIONS CHECKED		


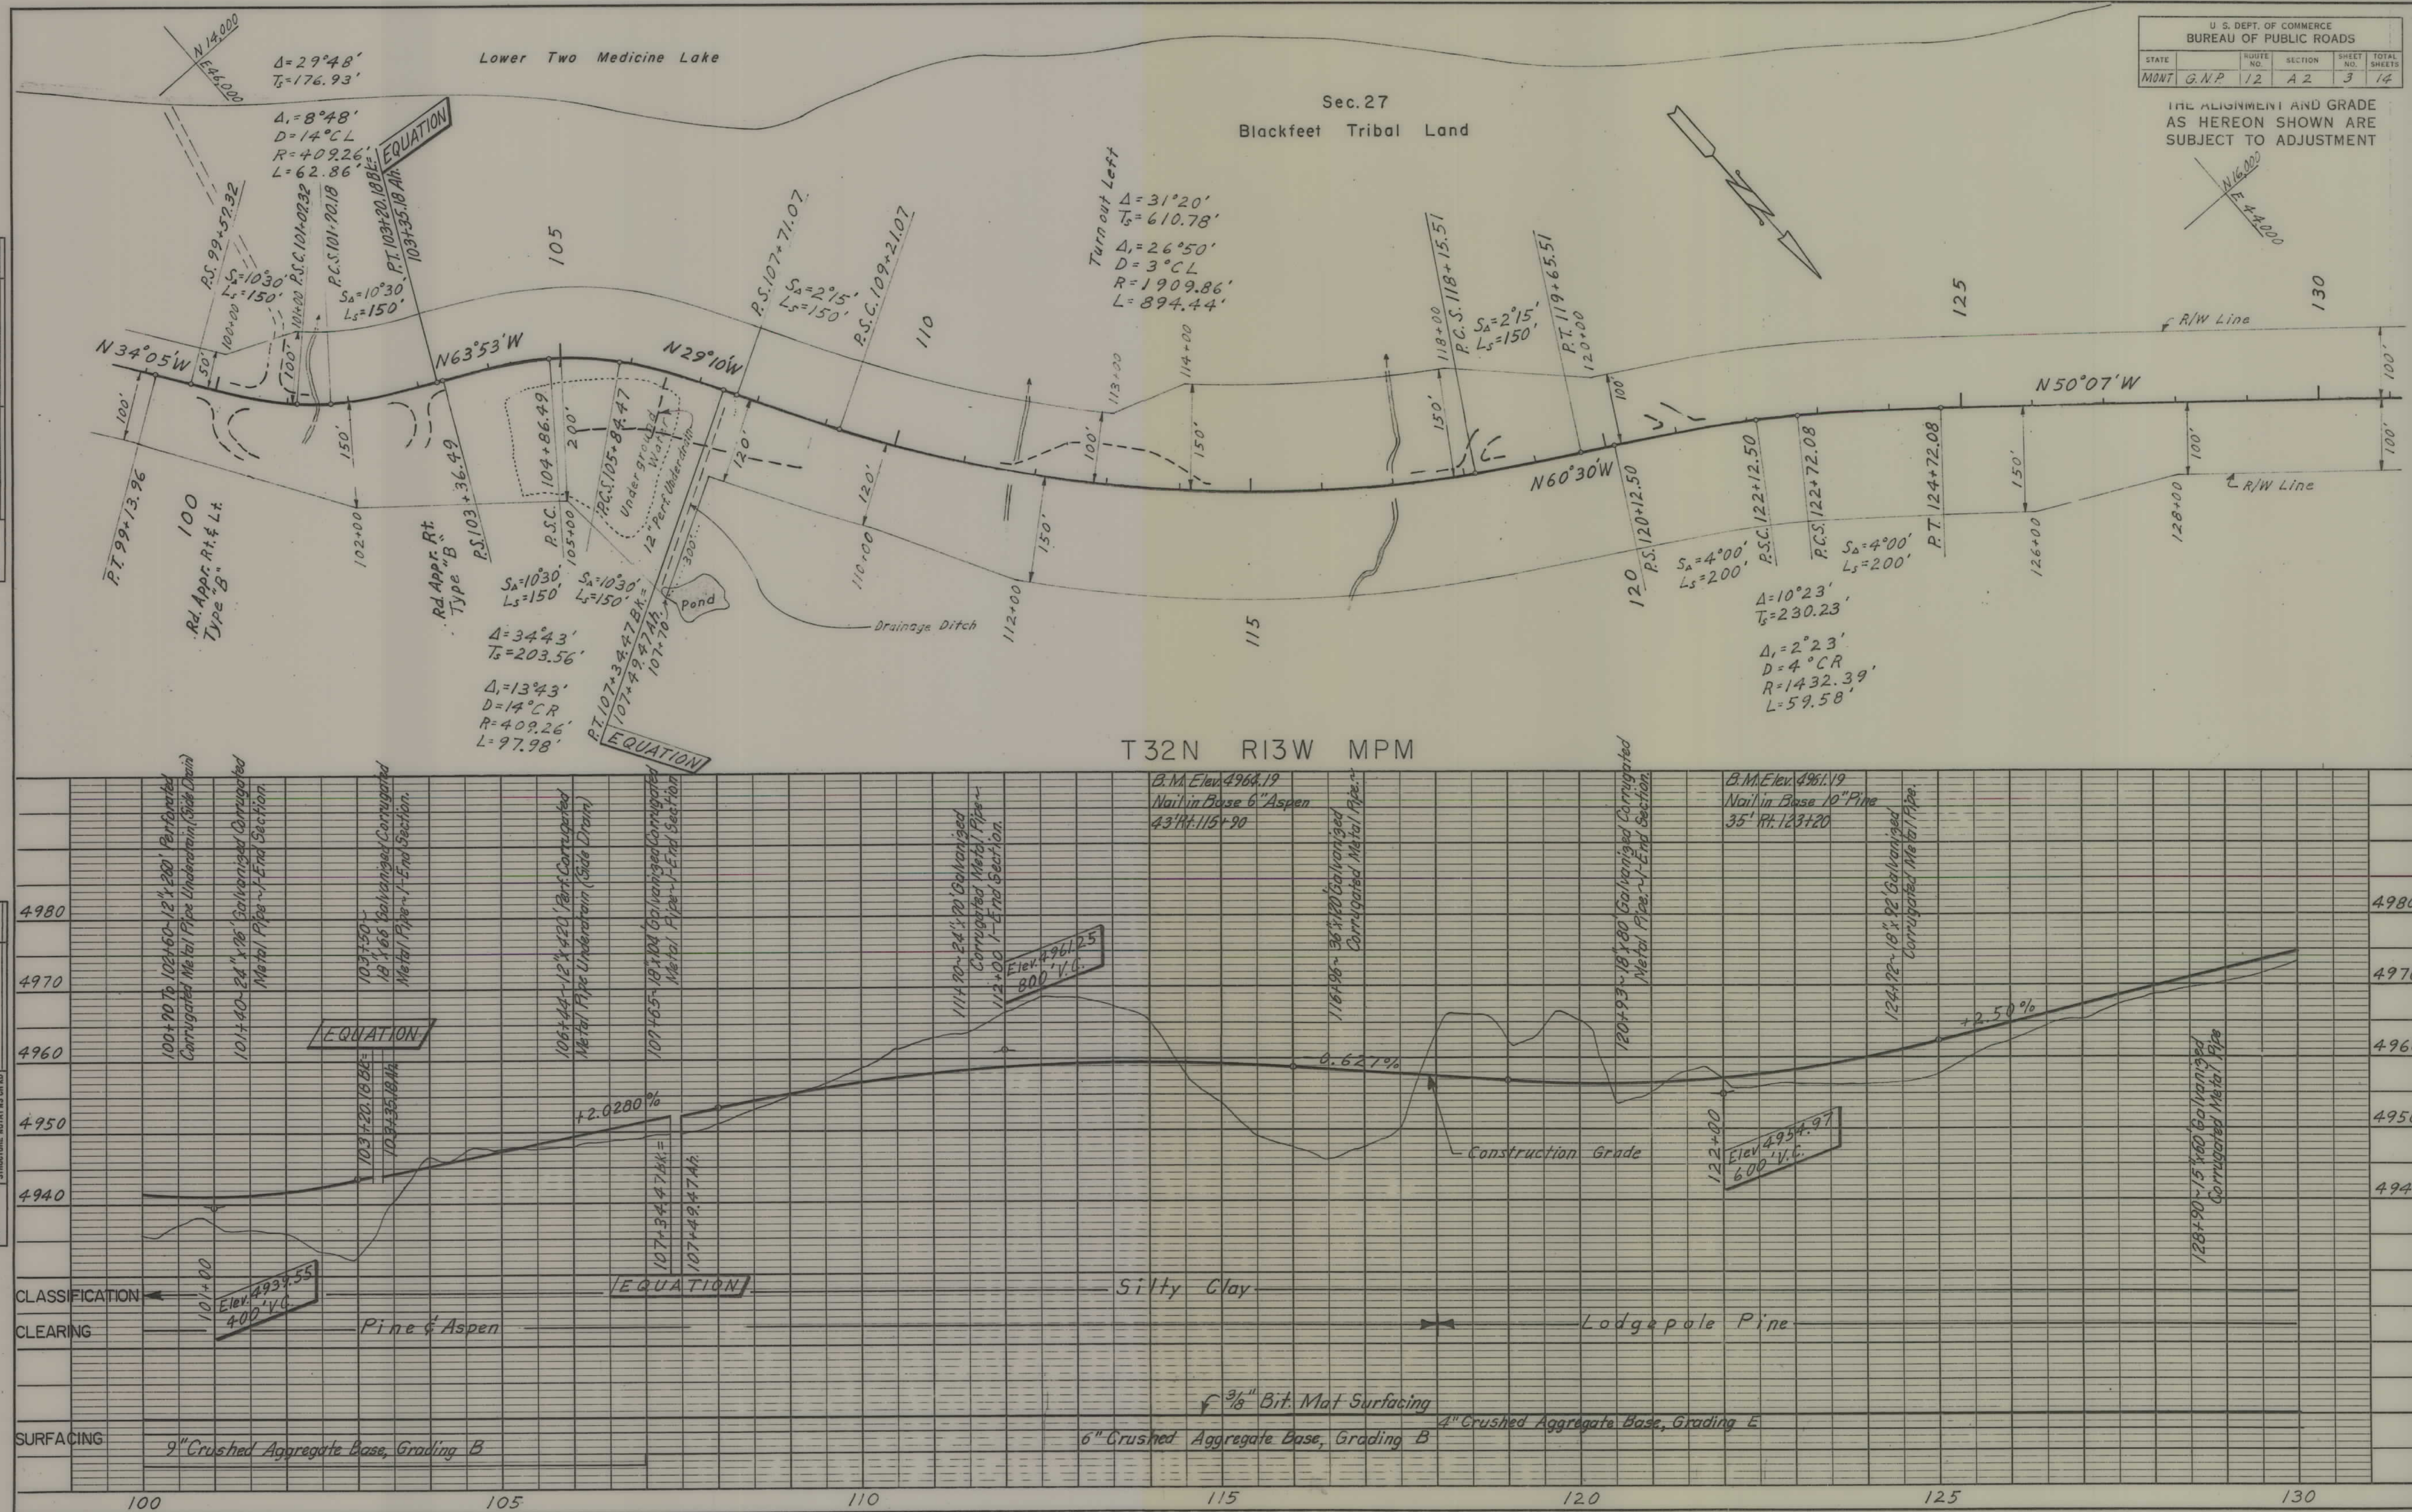


PLAN	DATE	BY
SURVEYED	1952	R.A. Frazee
NOTE BOOK	1952	
ALIGNED CHECKED	1952	
RT. OF WAY CHECKED	1952	
DRAFTED	1952	Cal. L. L. L. L.

PROFILE	DATE	BY
SURVEYED		
PLOTTED		
GRADES CHECKED		
STRUCTURE NOTATIONS DTD		

U. S. DEPT. OF COMMERCE BUREAU OF PUBLIC ROADS				
STATE	ROUTE NO.	SECTION	SHEET NO.	TOTAL SHEETS
MONT.	G.N.P.	12	A2	4

THE ALIGNMENT AND GRADE AS HEREON SHOWN ARE SUBJECT TO ADJUSTMENT

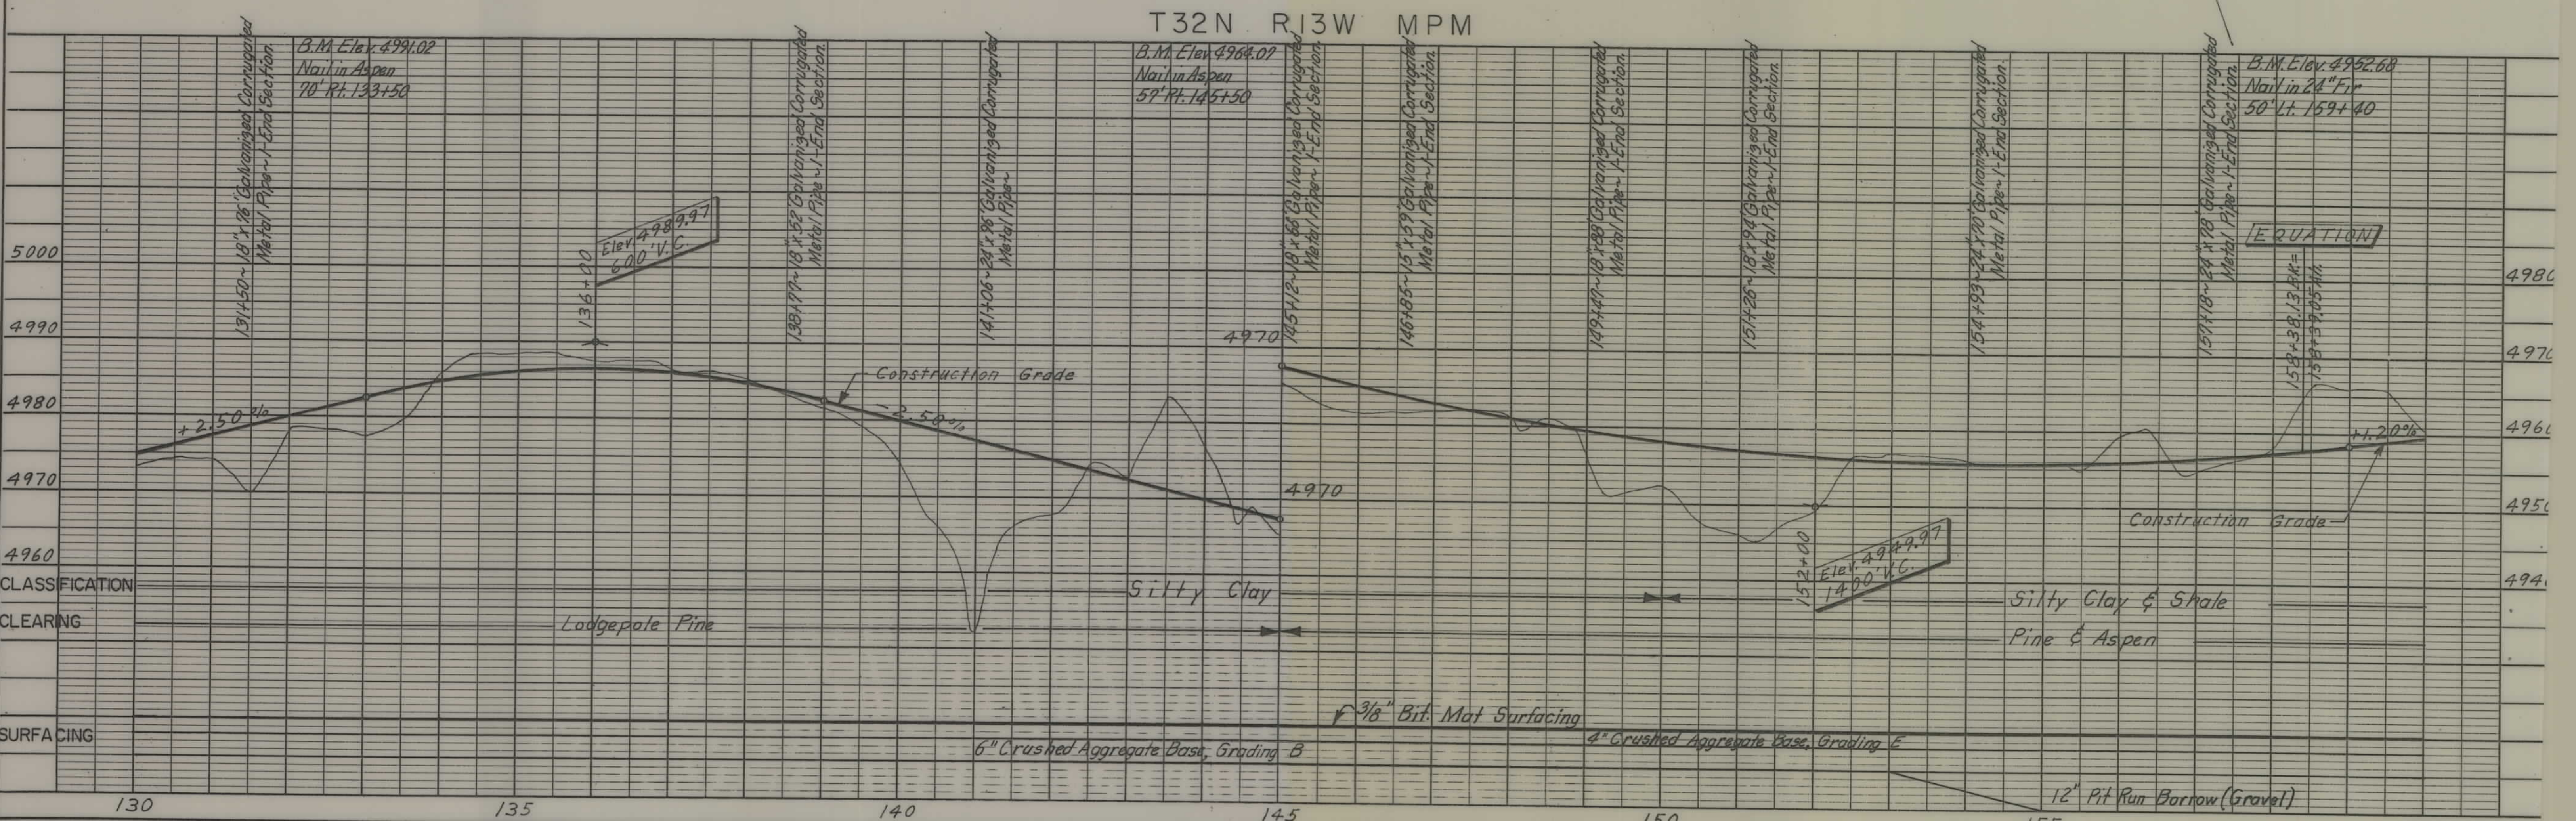
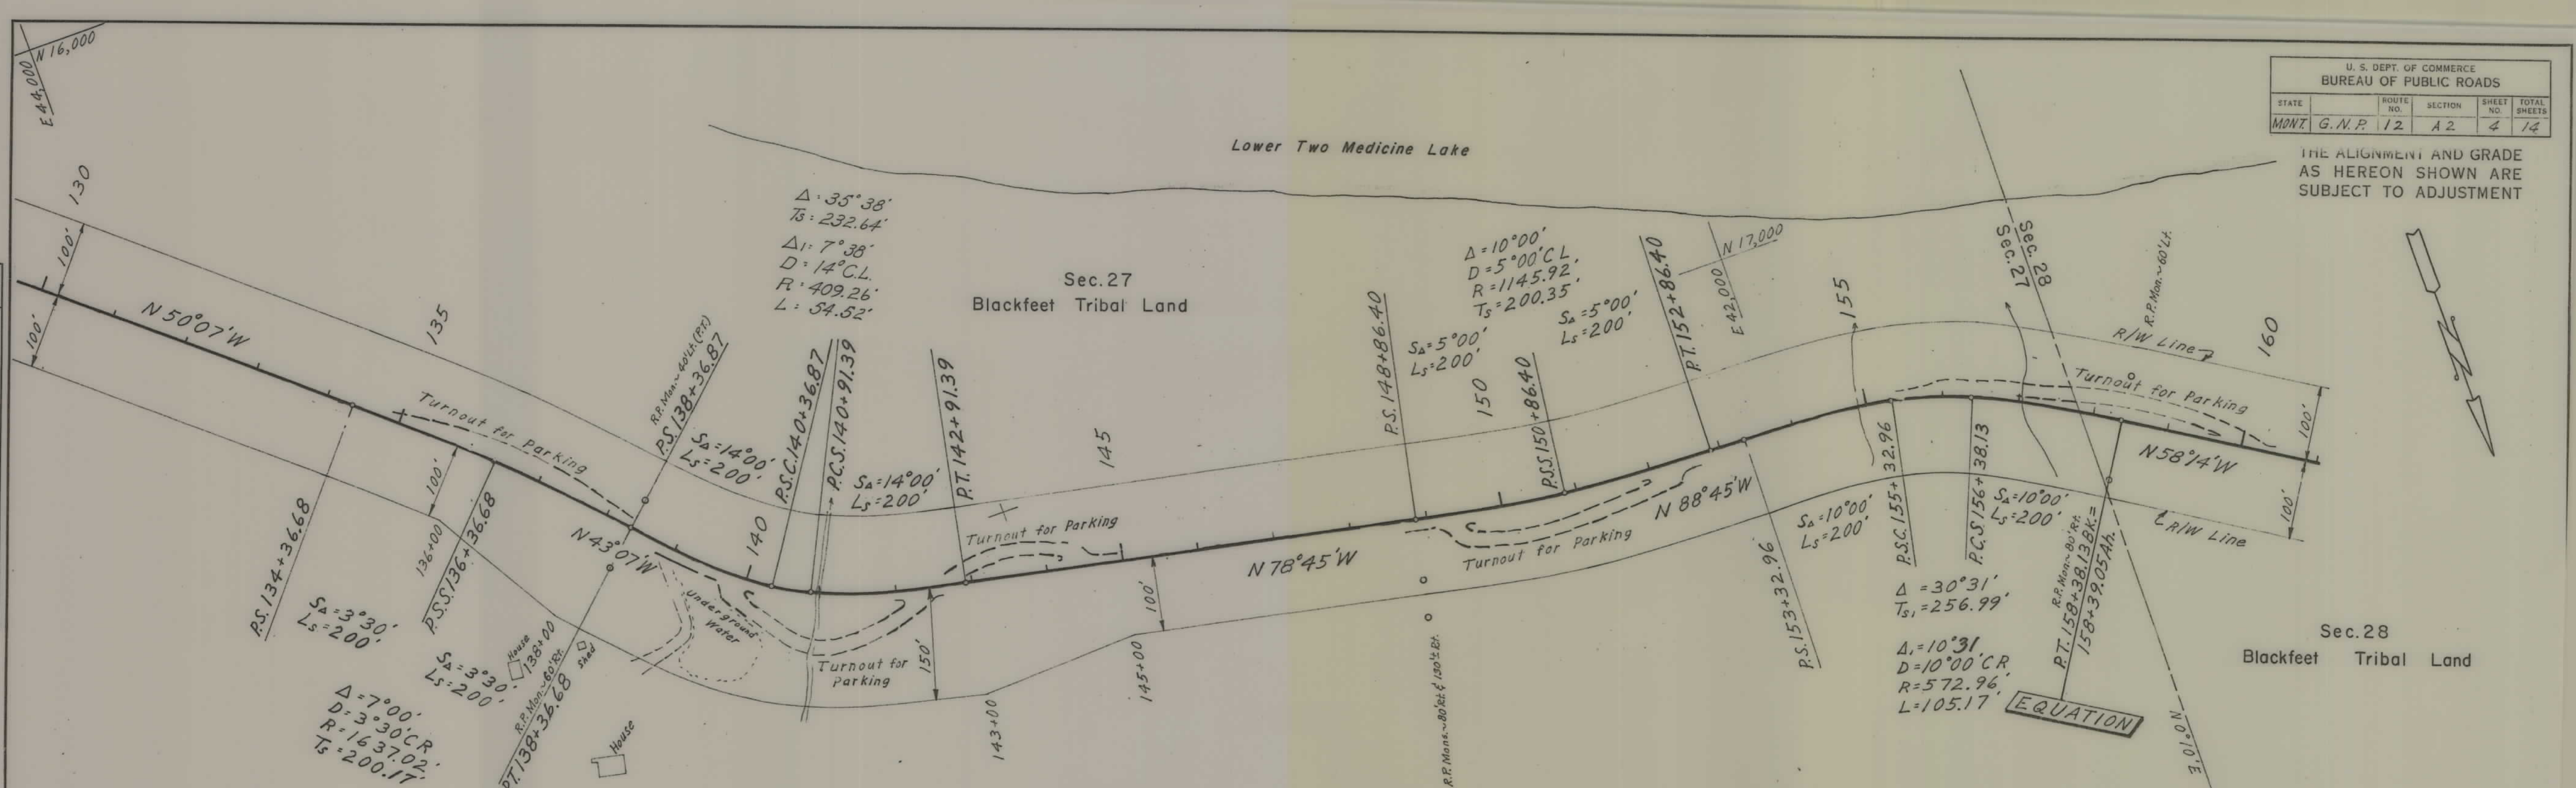


PLAN	DATE
SURVEYED	1952
PLOTTED	1962
NOTED	1962
BY	R.A. Larson
NO.	1282

PROFILE	DATE
SURVEYED	
PLOTTED	
NOTED	
BY	
NO.	

STATE	ROUTE NO.	SECTION	SHEET NO.	TOTAL SHEETS
MONT.	G.N.P.	12	A2	5

THE ALIGNMENT AND GRADE AS HEREON SHOWN ARE SUBJECT TO ADJUSTMENT

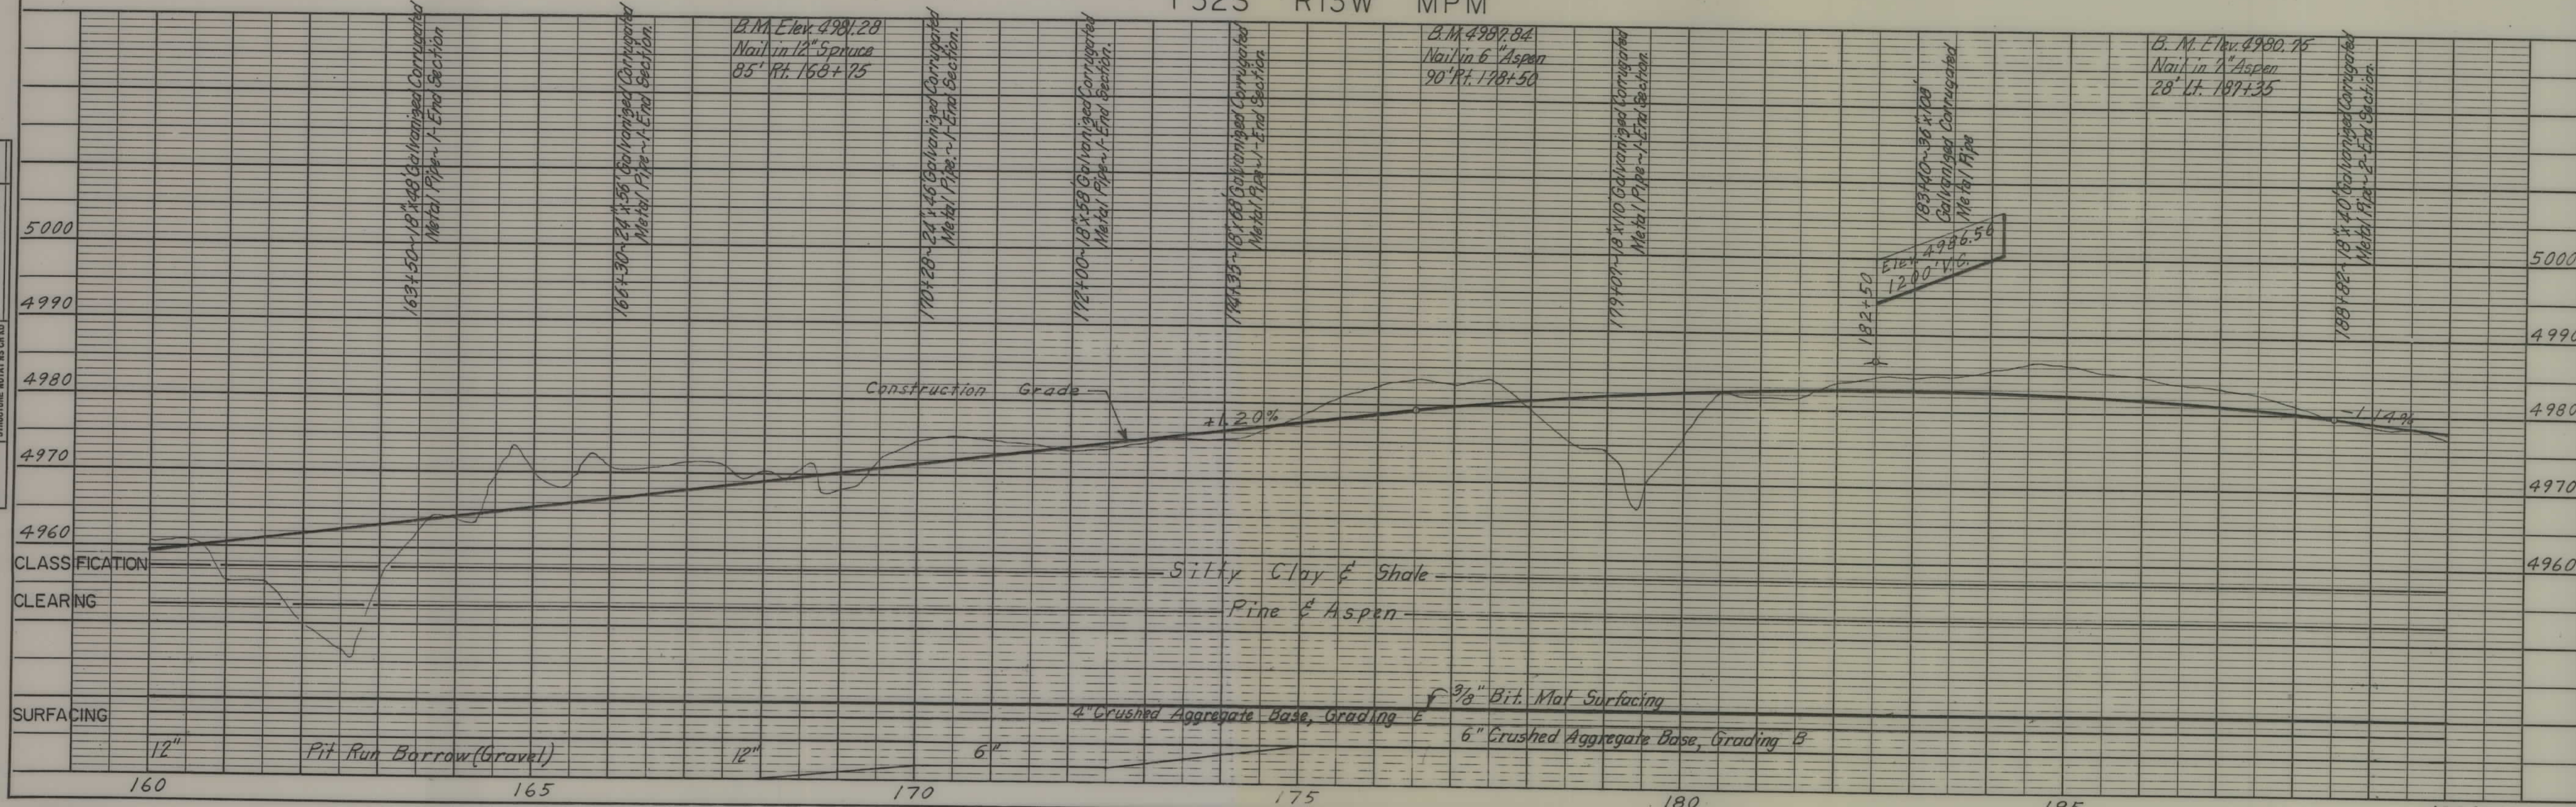
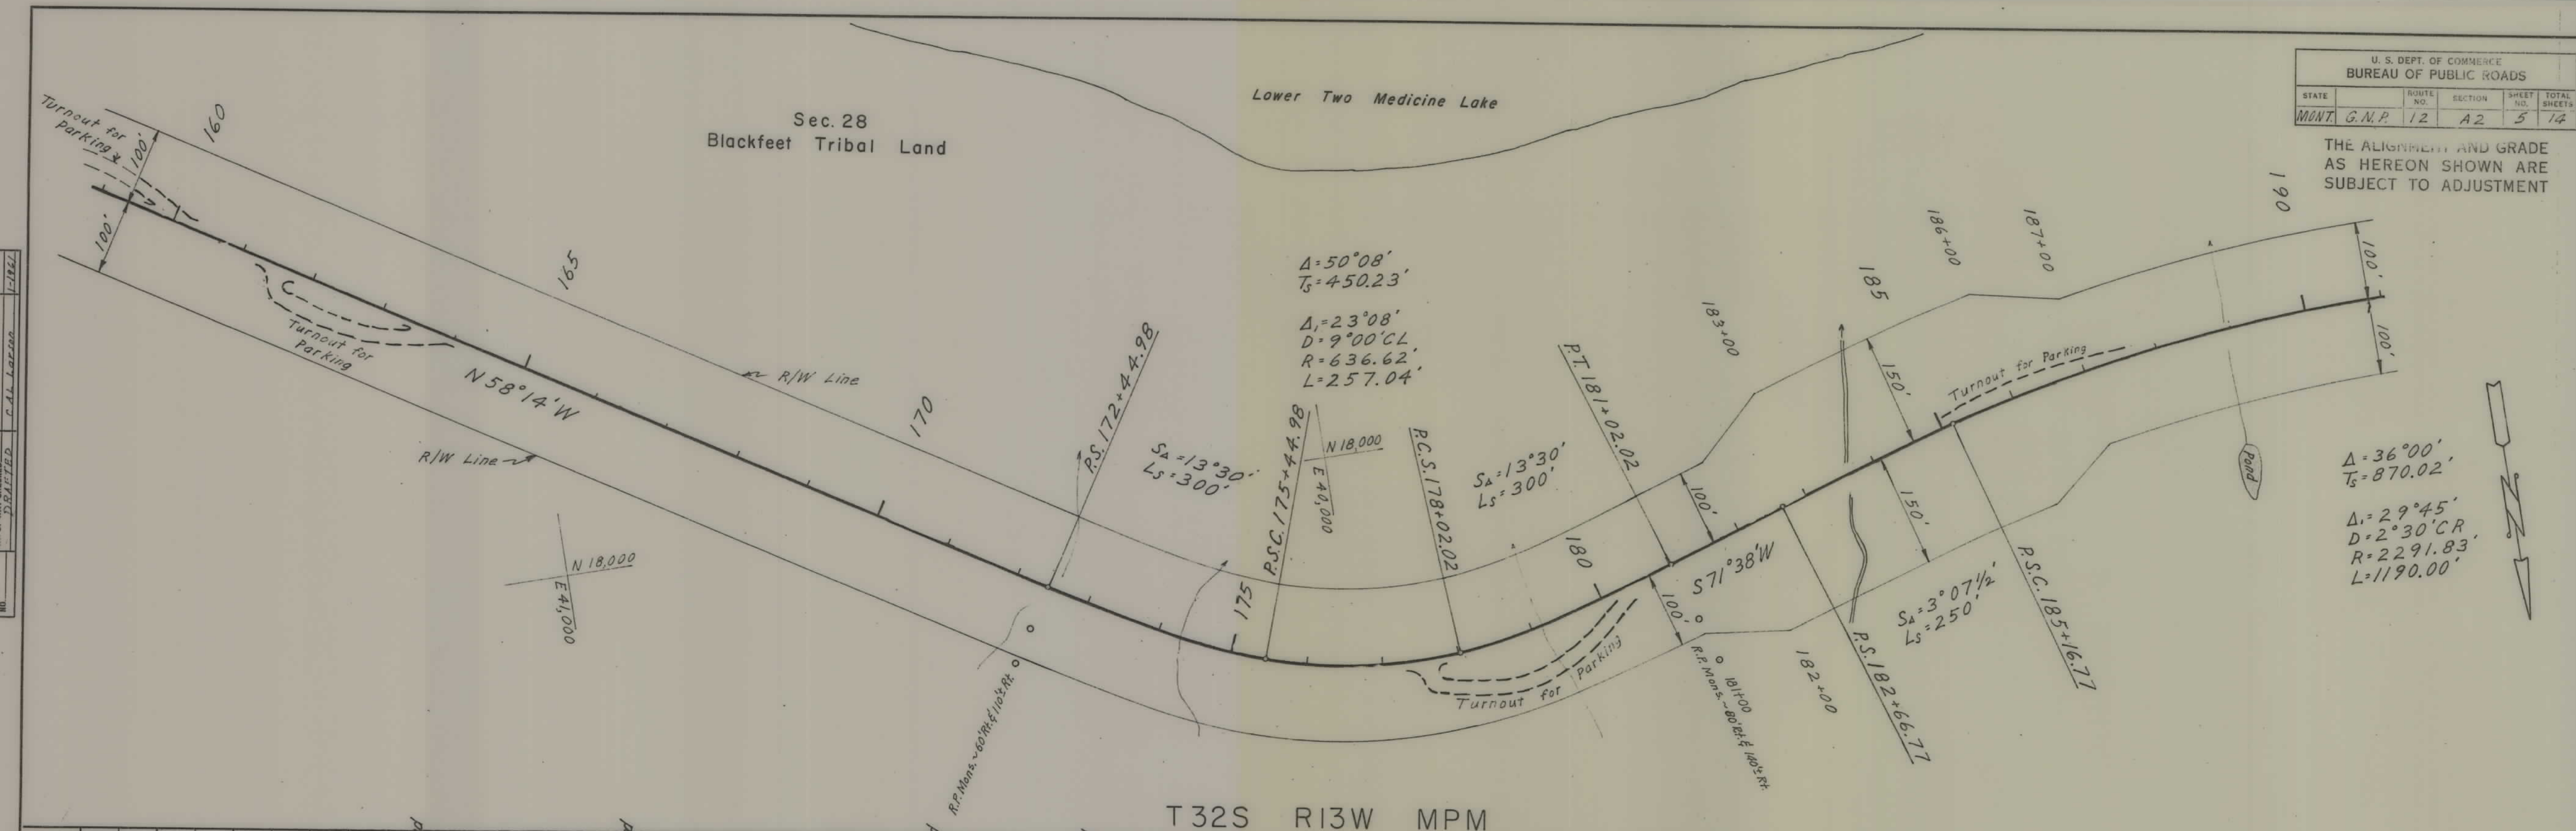


PLAN		BY	DATE
NOTE BOOK	SURVEYED	P. A. F. 12/22/22	12-22
NO.	PLOTTED	"	12-22
	ALIGNMENT CHECKED		
	RT. OF WAY CHECKED		
	DRAWN	CAL. 1-25-23	2-19-23

PROFILE	BY	DATE
SURVEYED		
PLOTTED		
GRADES CHECKED		
RECAL. NOTED		
STRUCTURE NOTATIONS CHKD		


U. S. DEPT. OF COMMERCE BUREAU OF PUBLIC ROADS					
STATE		ROUTE NO.	SECTION	SHEET NO.	TOTAL SHEETS
MONT.	G. N. P.	12	A 2	6	14

THE ALIGNMENT AND GRADE
AS HEREON SHOWN ARE
SUBJECT TO ADJUSTMENT

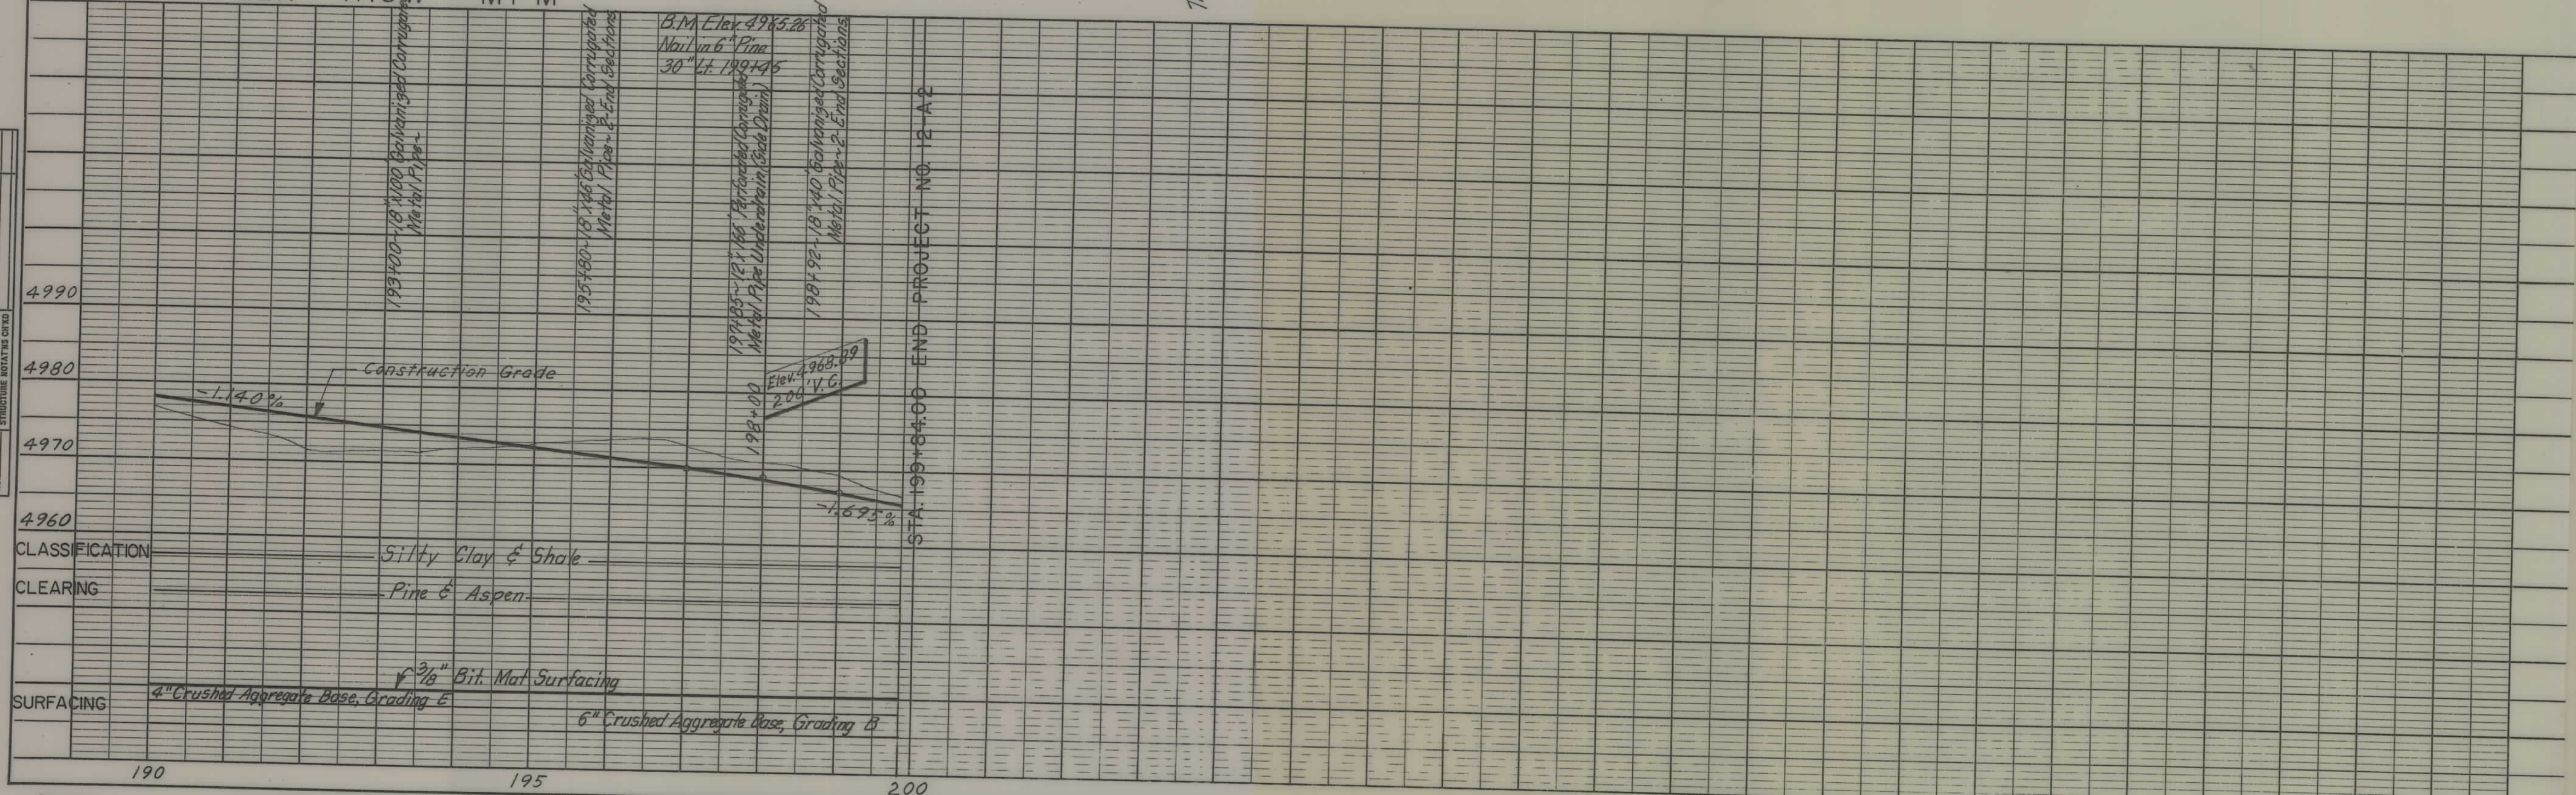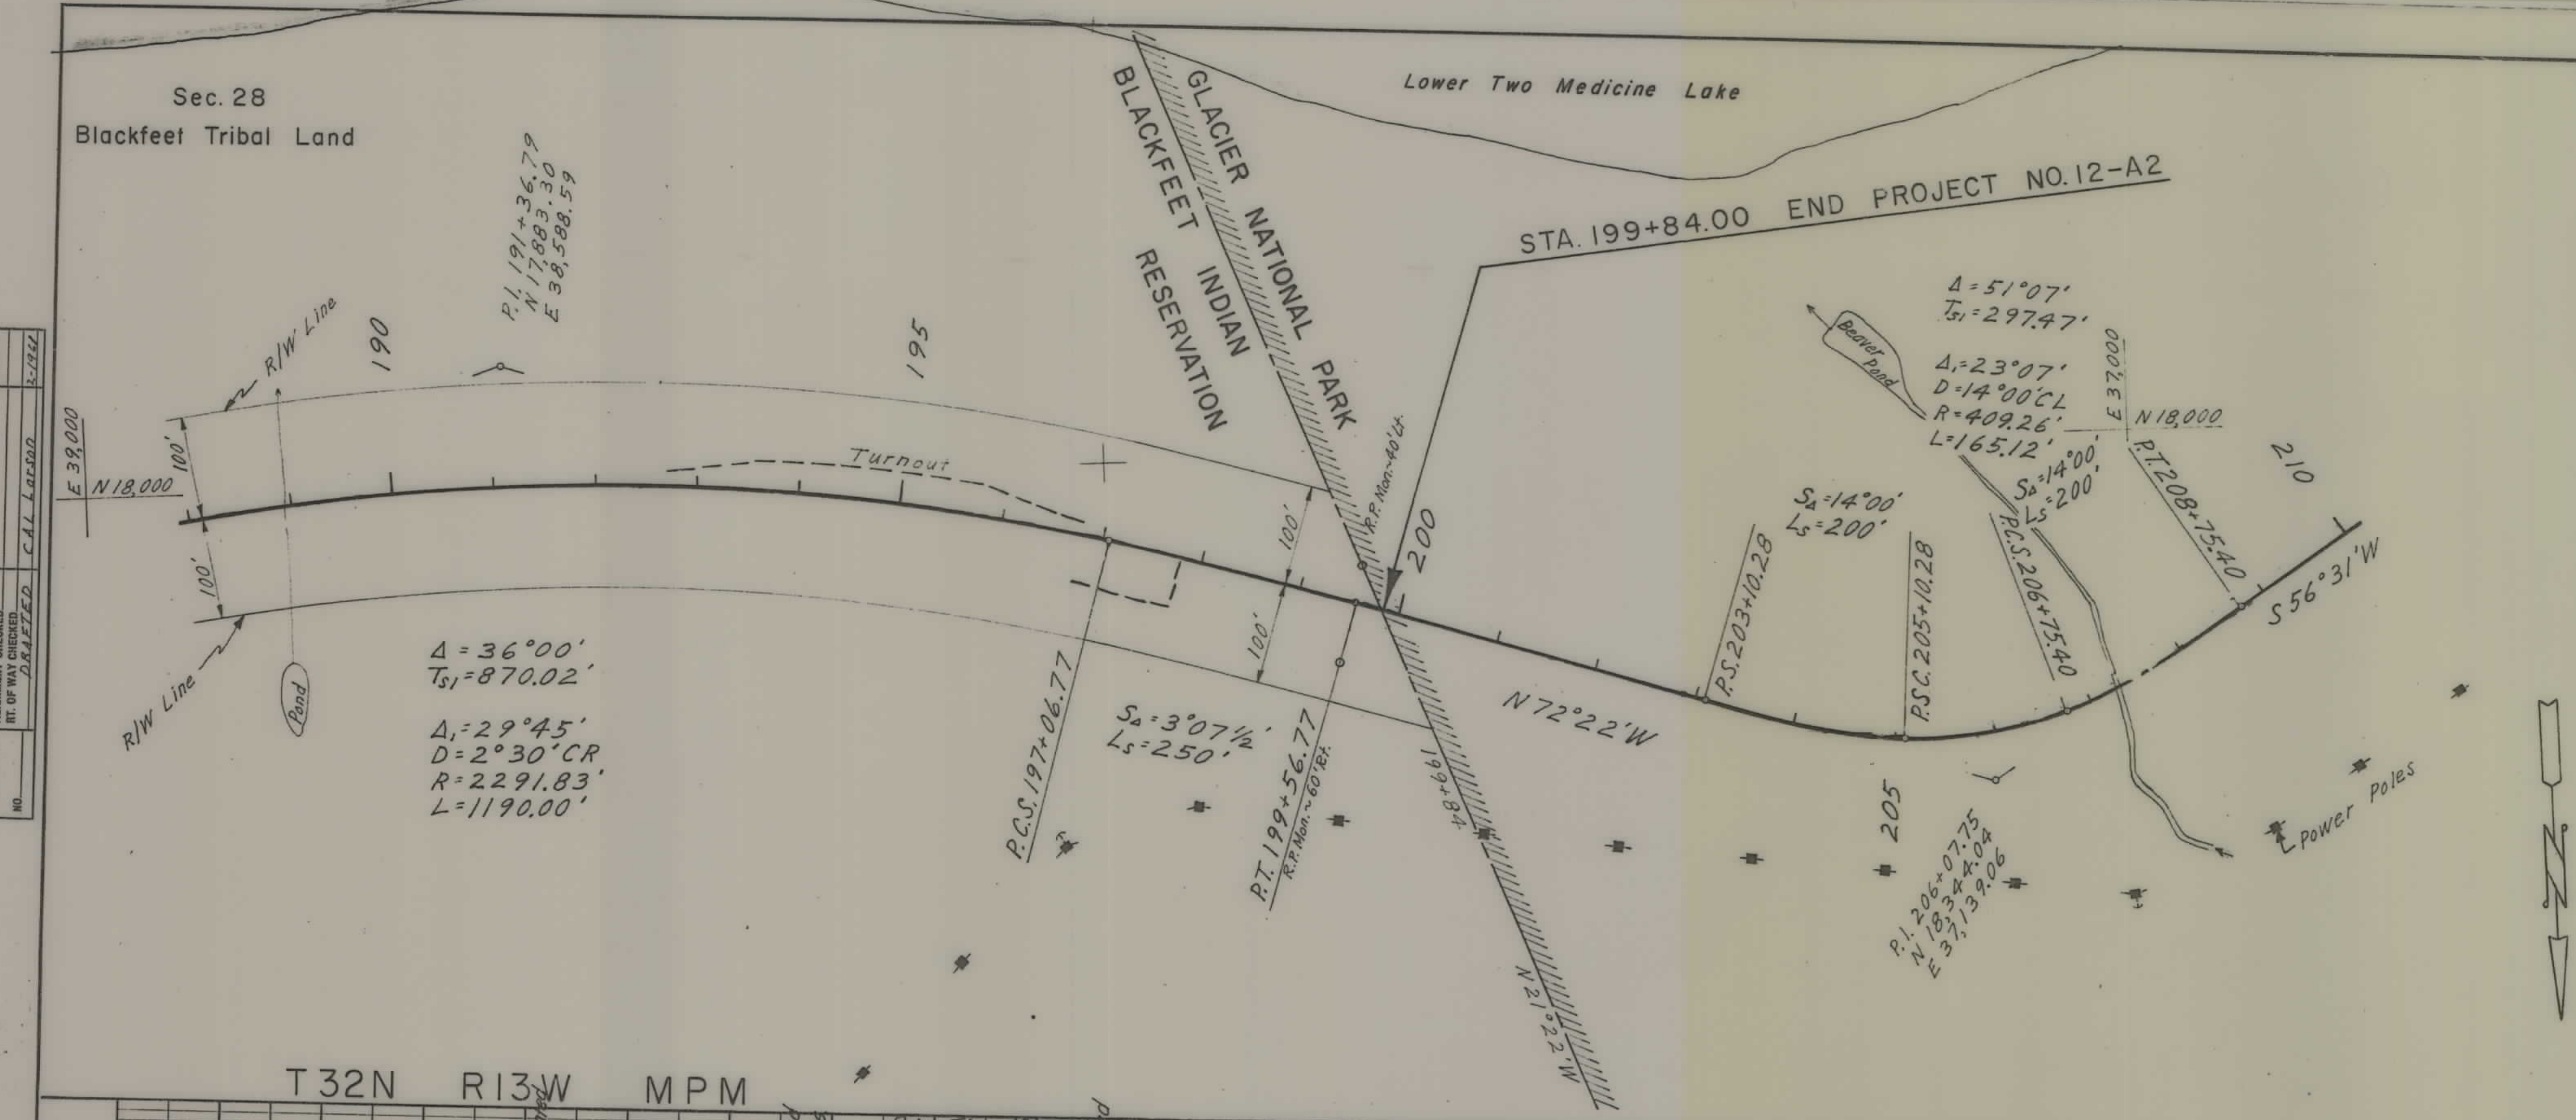

PLAN	NO.	DATE	BY	DATE
SURVEYED		1954	R.A. Evans	
NOTED		1961	"	
ALIGNED			"	
CHECKED			"	
REVISION			"	
DELETED			"	
NO.			"	

PROFILE	NO.	DATE	BY	DATE
SURVEYED				
NOTED				
CHECKED				
REVISION				
DELETED				
NO.				


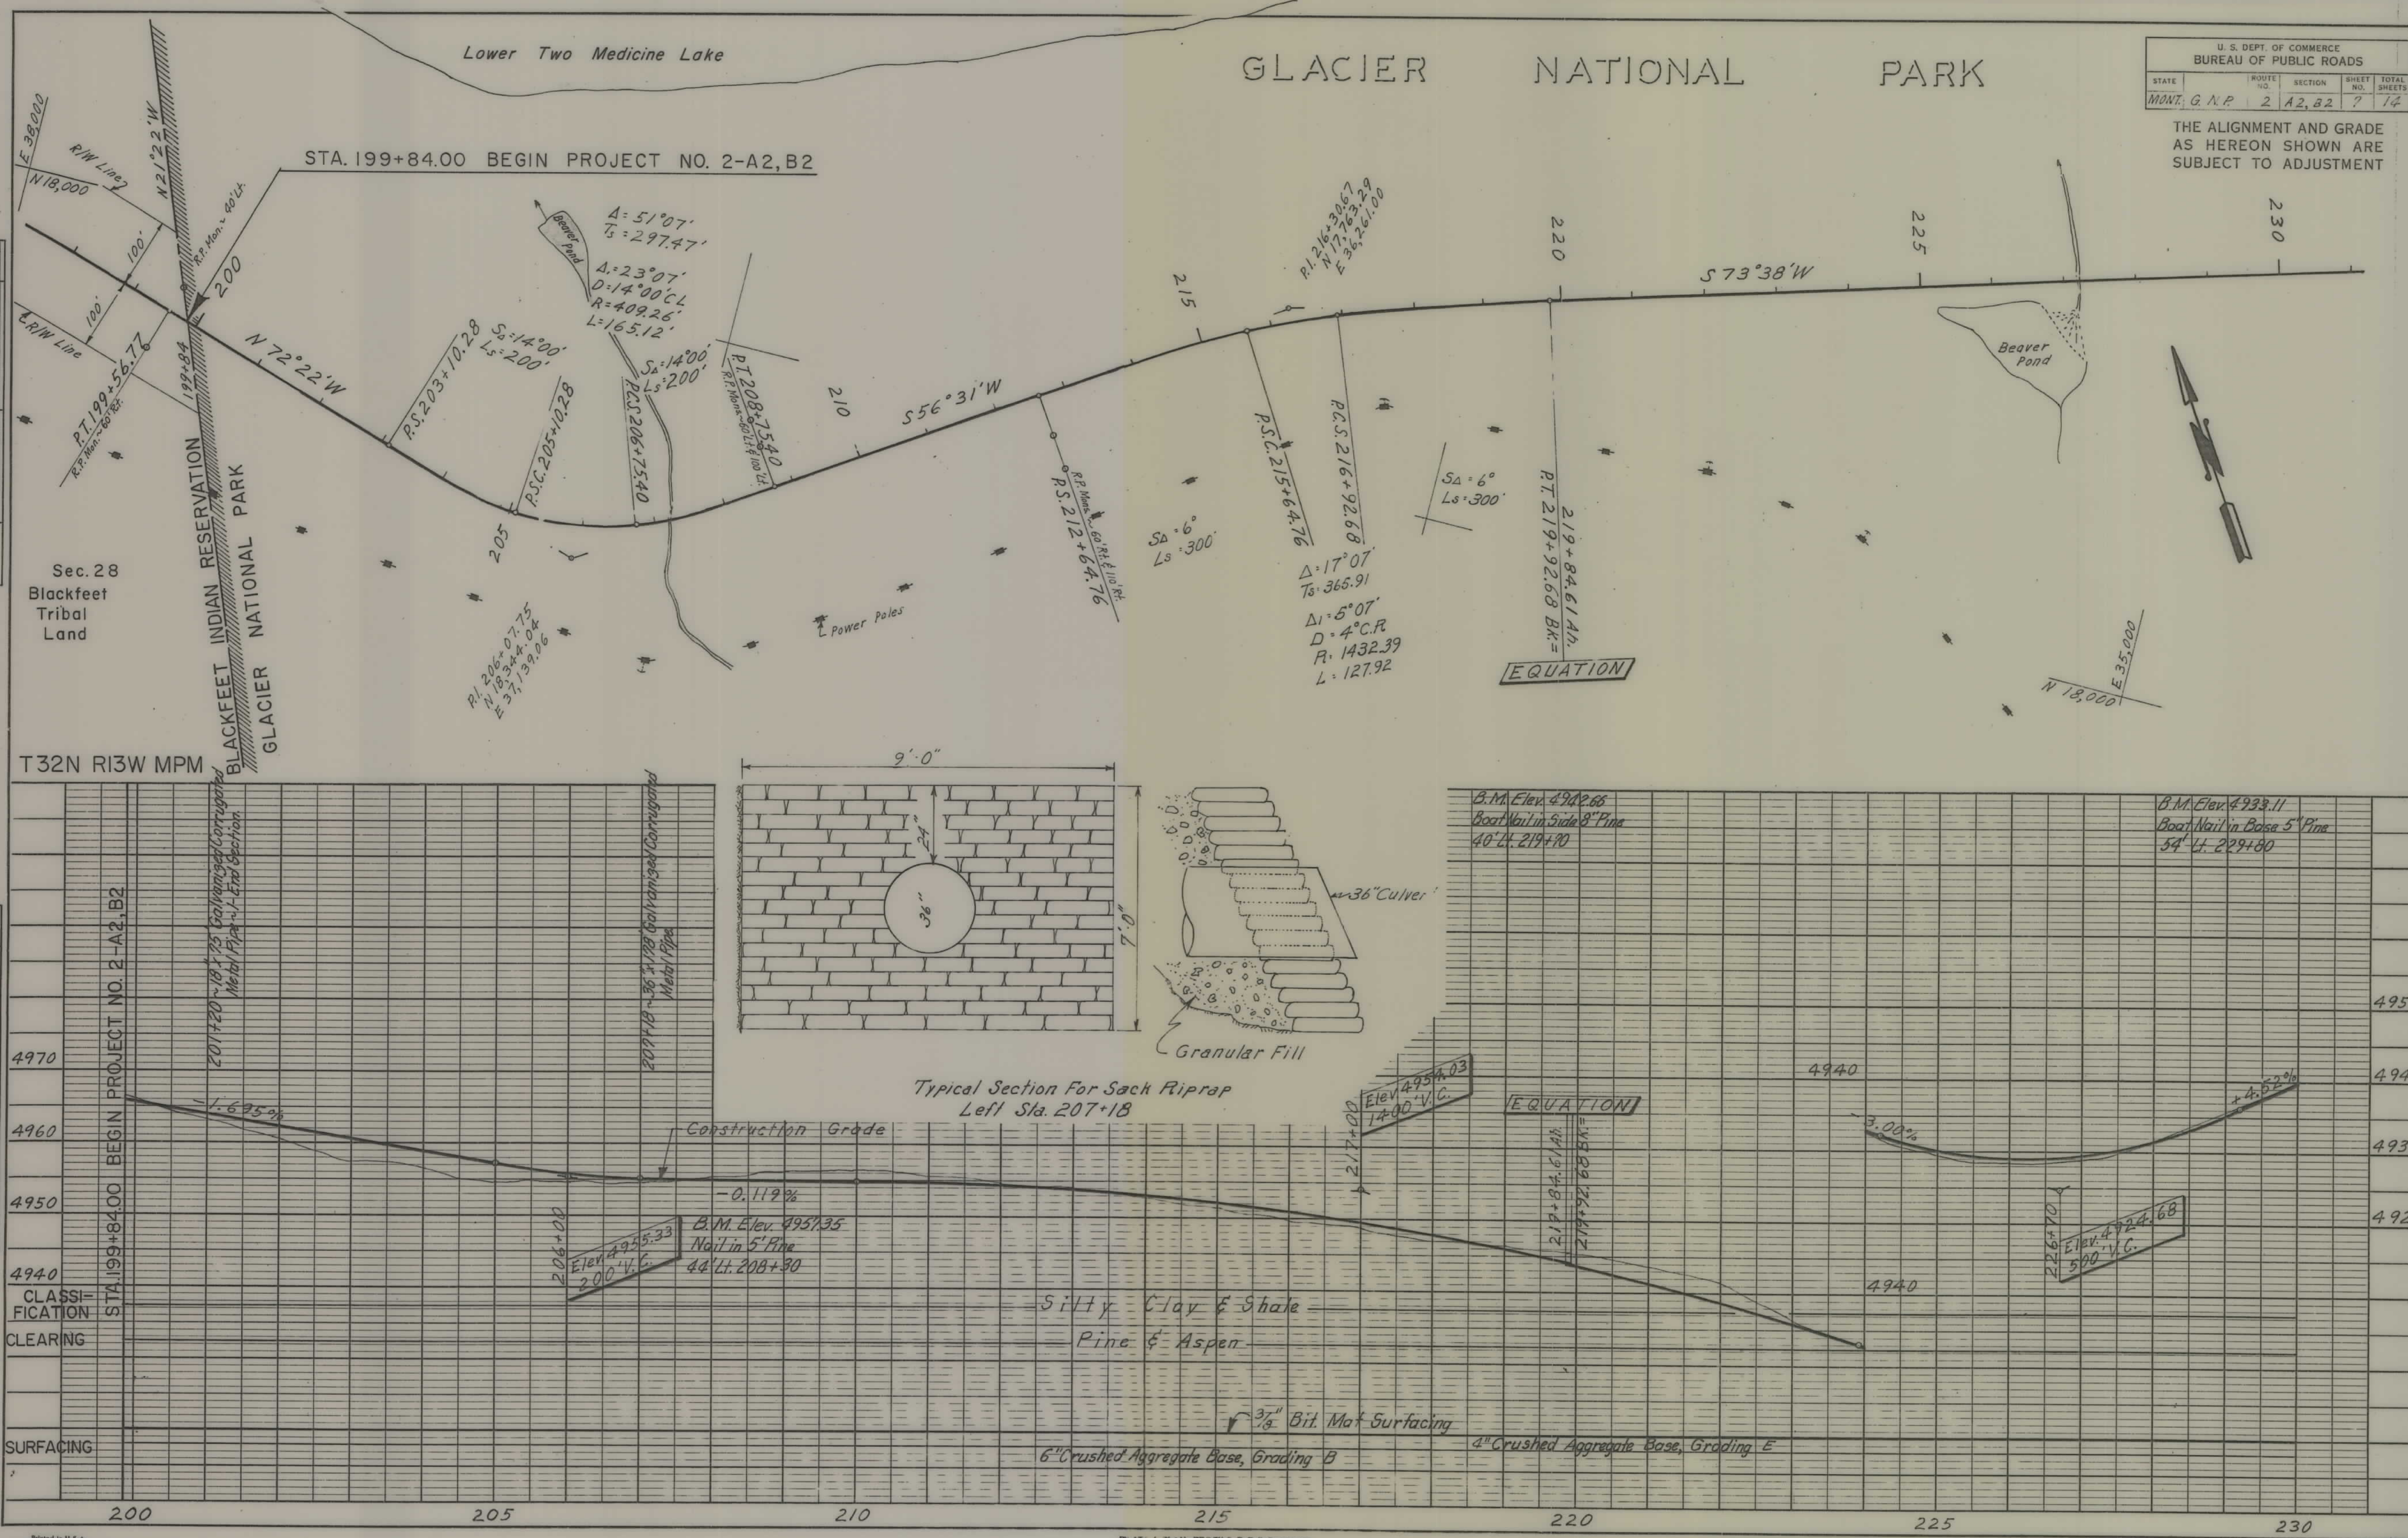


U. S. DEPT. OF COMMERCE BUREAU OF PUBLIC ROADS				
STATE	ROUTE NO.	SECTION	SHEET NO.	TOTAL SHEETS
MONT.	G. N. P.	2	A2, B2	7

THE ALIGNMENT AND GRADE AS HEREON SHOWN ARE SUBJECT TO ADJUSTMENT

PLAN	NO.	NOTE BOOK	SURVEYED	PLOTTED	ALIGNED	CHECKED	BY	DATE
							R.A. Frazee	1952
							CAL. LORSON	1960

PROFILE	NO.	NOTE BOOK	SURVEYED	PLOTTED	GRADES	CHECKED	BY	DATE

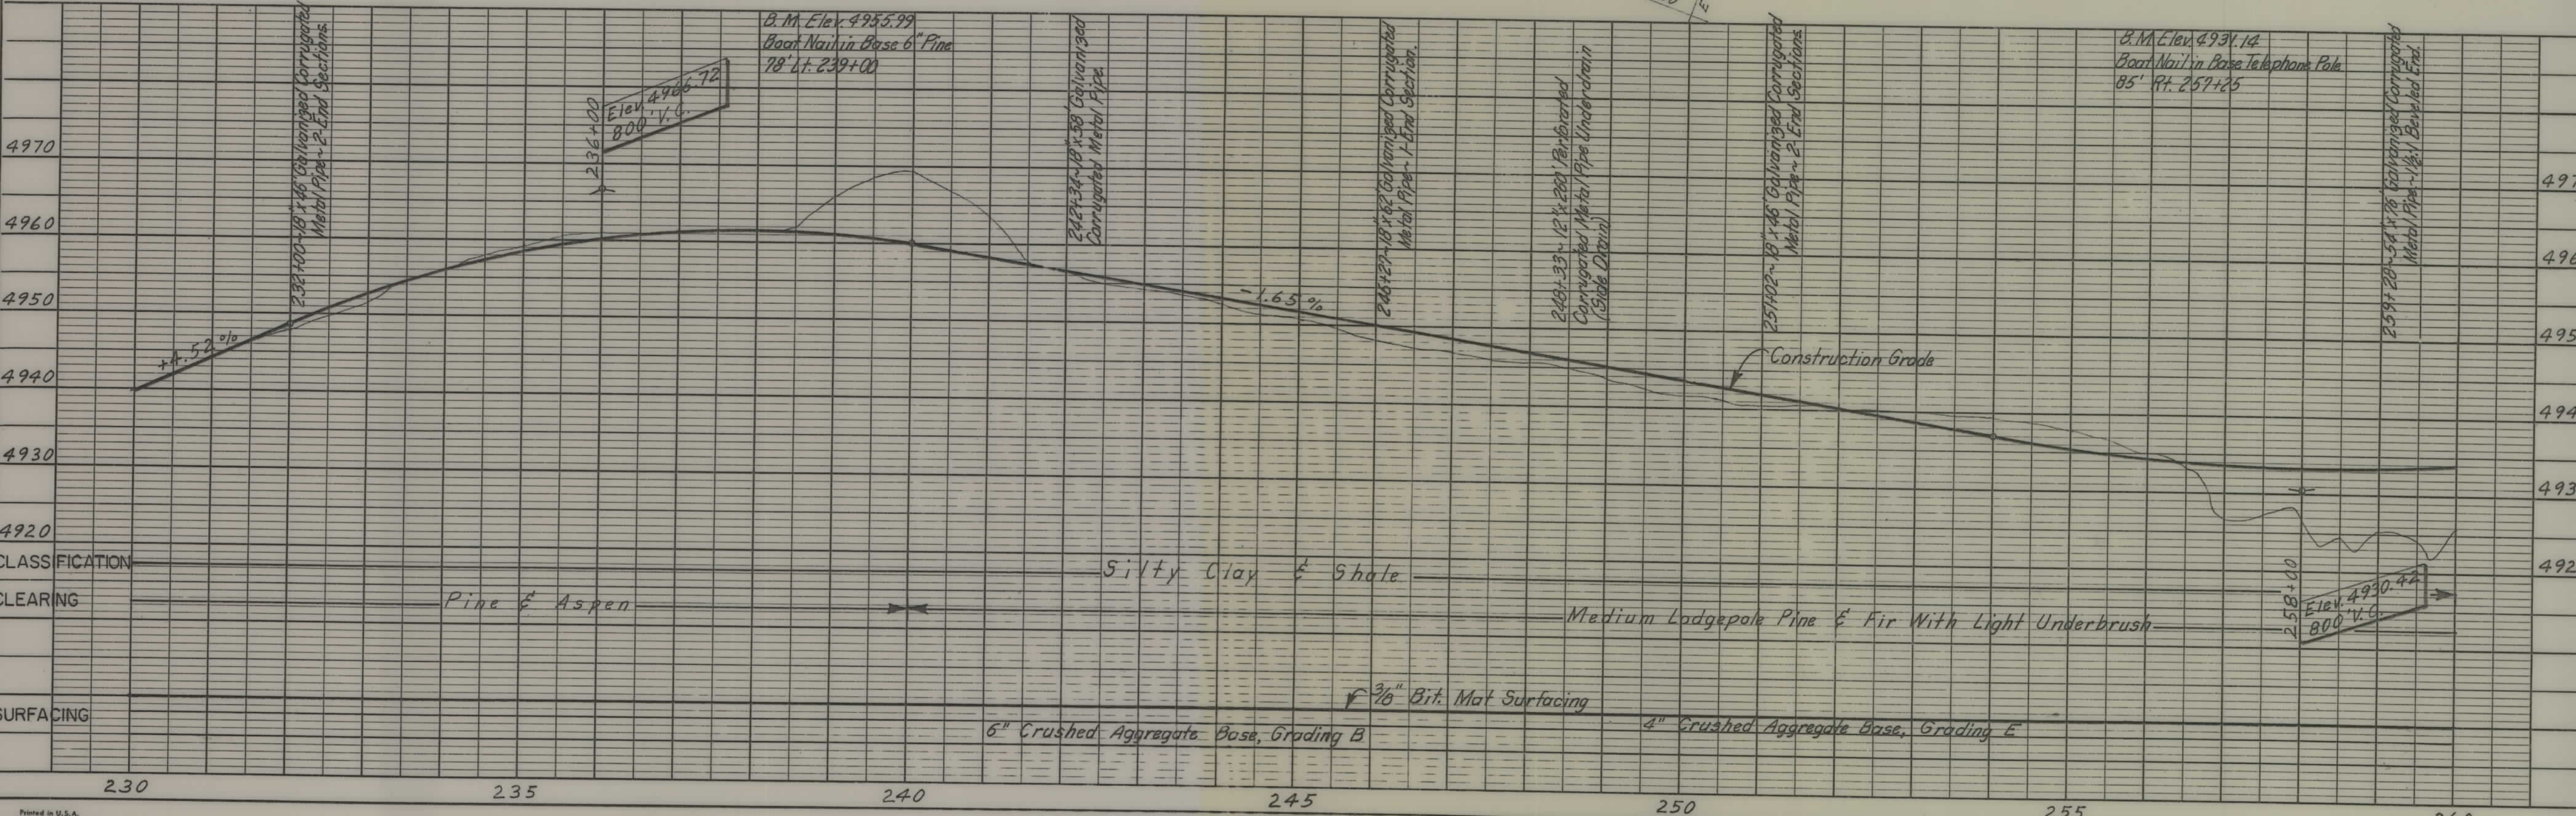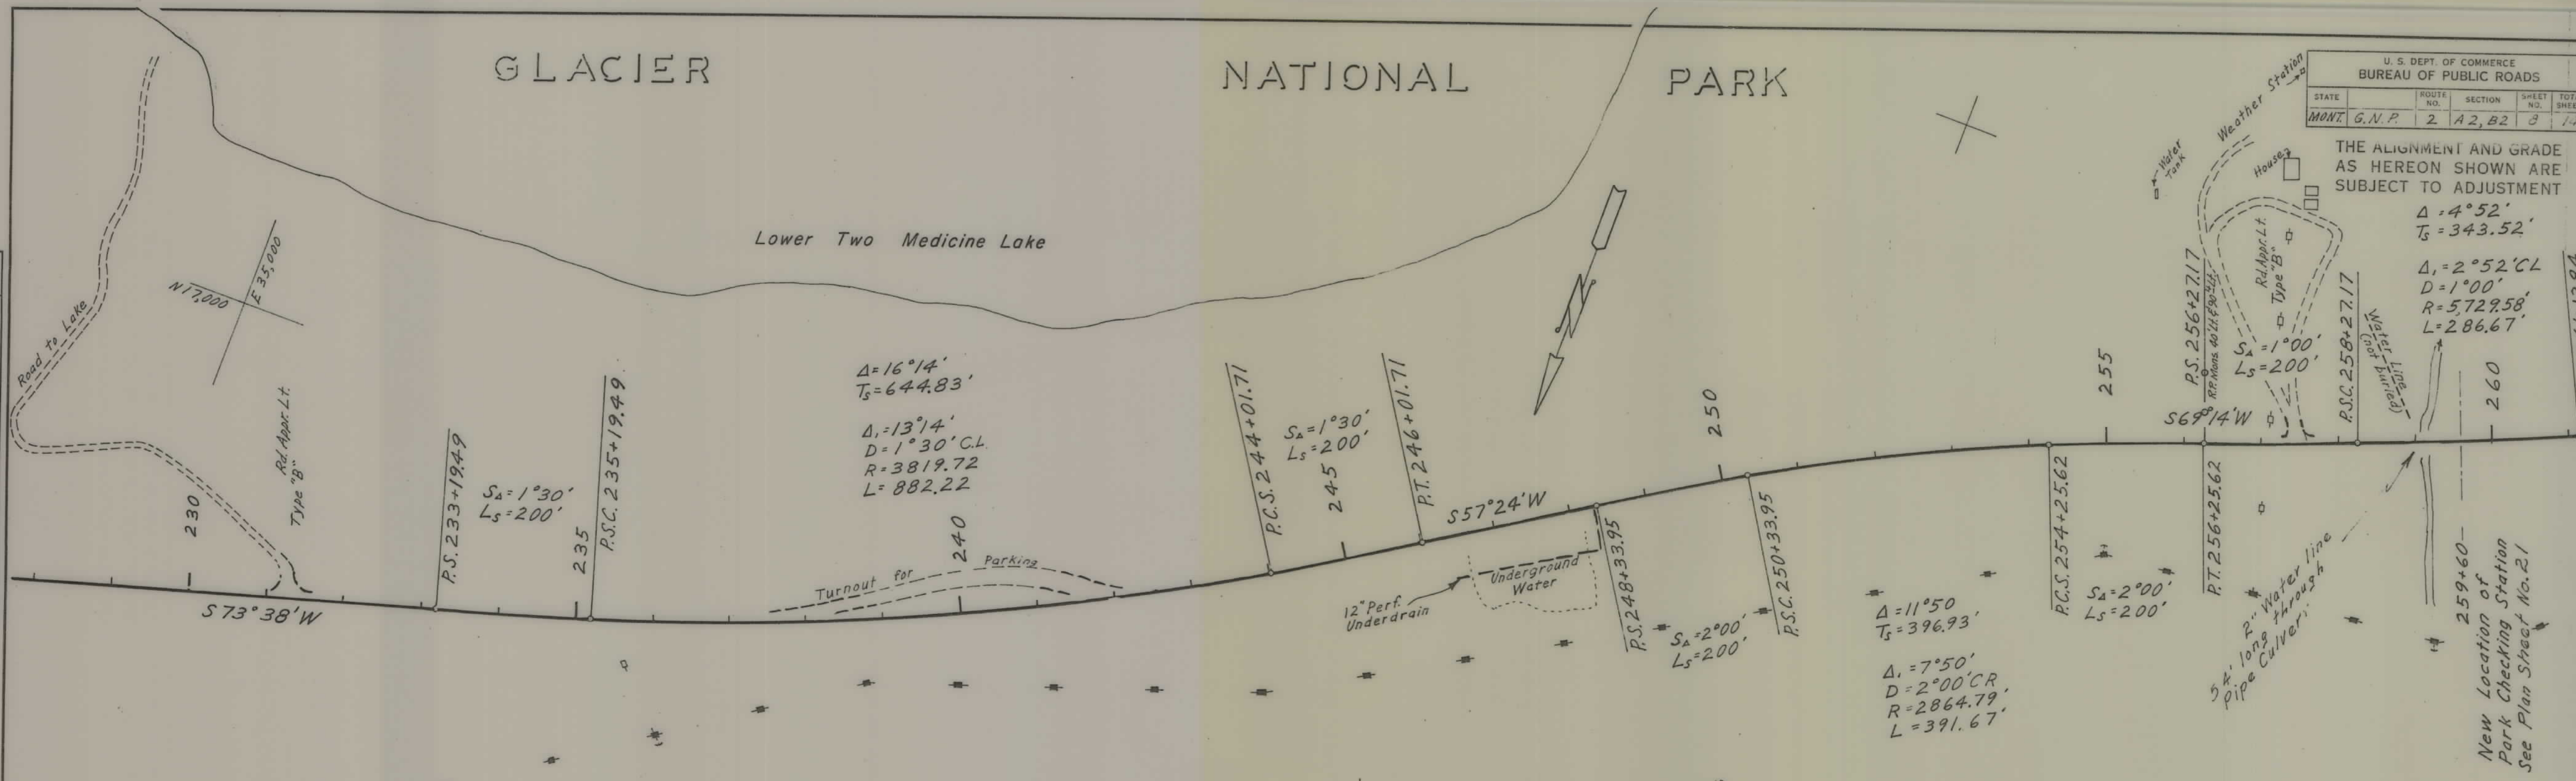



GLACIER NATIONAL PARK

U. S. DEPT. OF COMMERCE BUREAU OF PUBLIC ROADS				
STATE	ROUTE NO.	SECTION	SHEET NO.	TOTAL SHEETS
MONT.	G. N. P.	2	A2, B2	9

THE ALIGNMENT AND GRADE
AS HEREON SHOWN ARE
SUBJECT TO ADJUSTMENT


PLAN	DATE	BY
SURVEYED	1922	R. A. Frazee
PLOTTED	1940	
NOTE BOOK		
NO.		

PROFILE	DATE	BY
SURVEYED		
PLOTTED		
NOTE BOOK		
NO.		

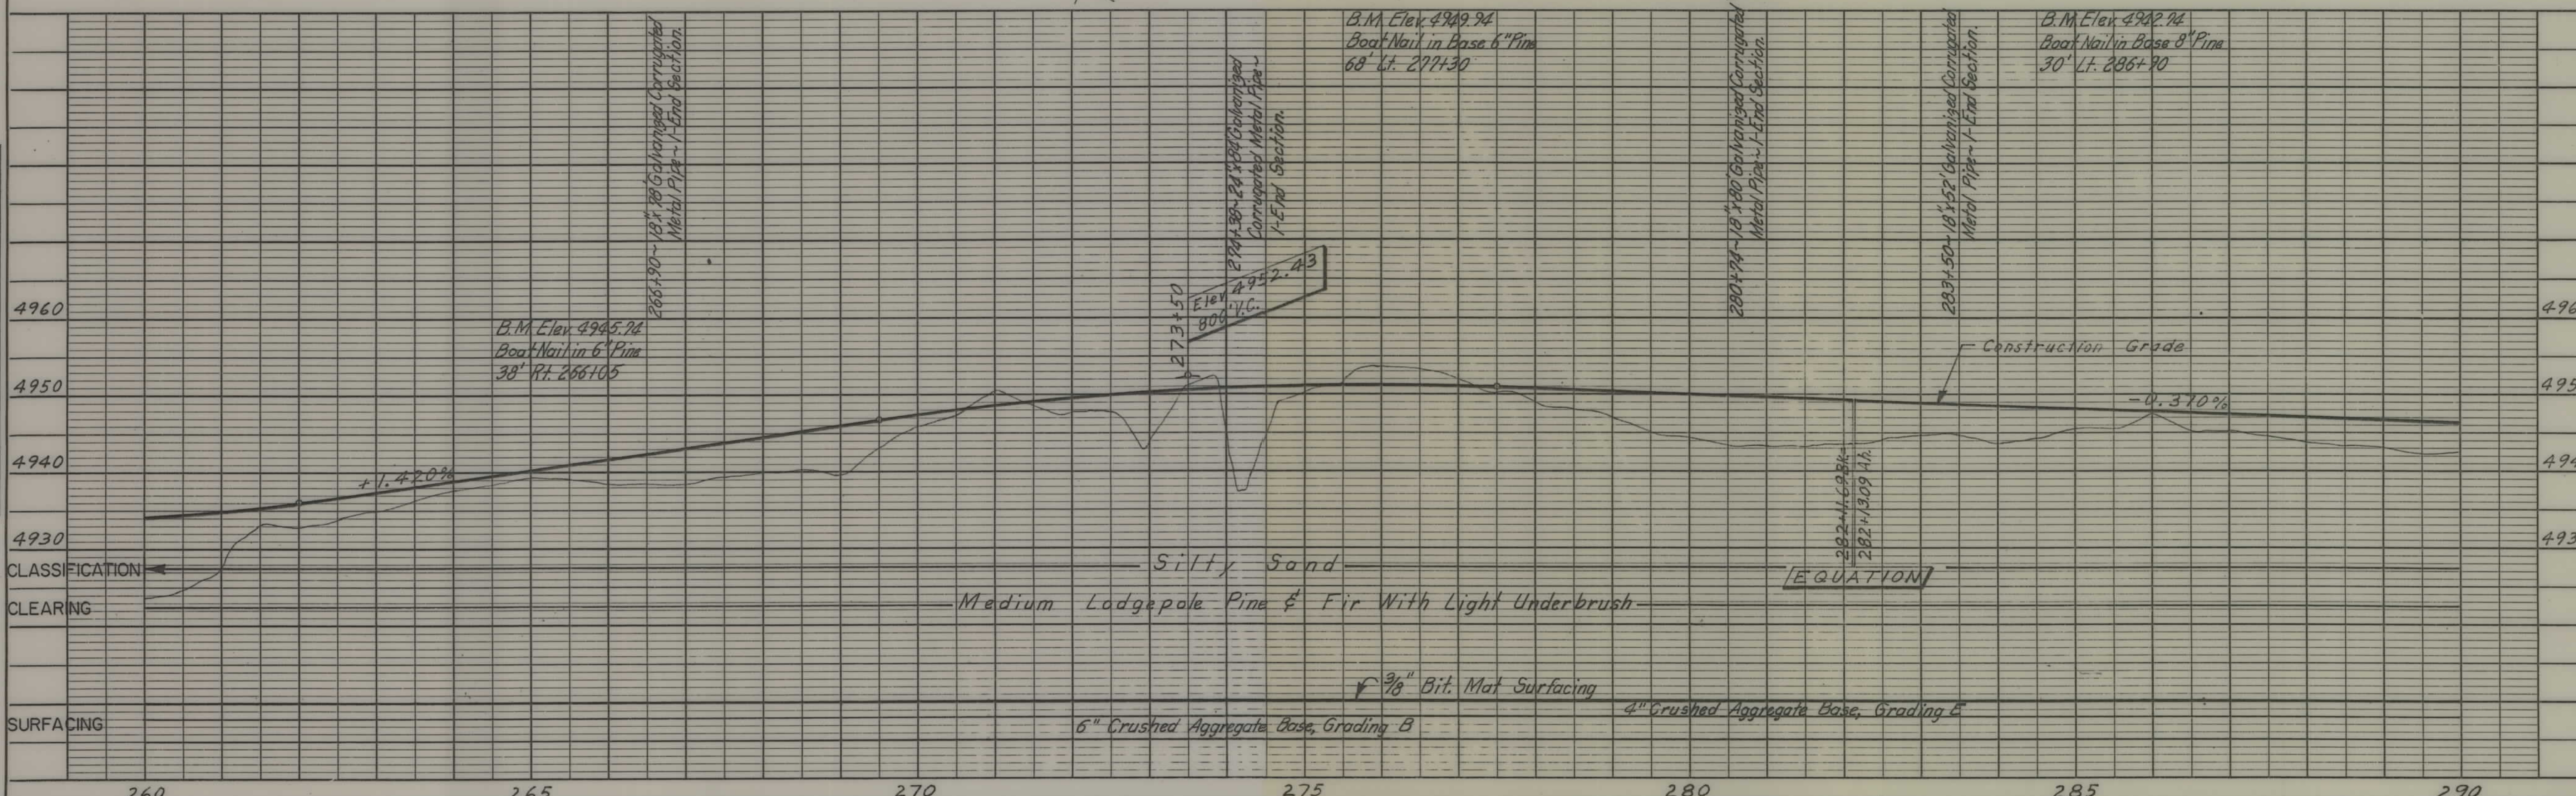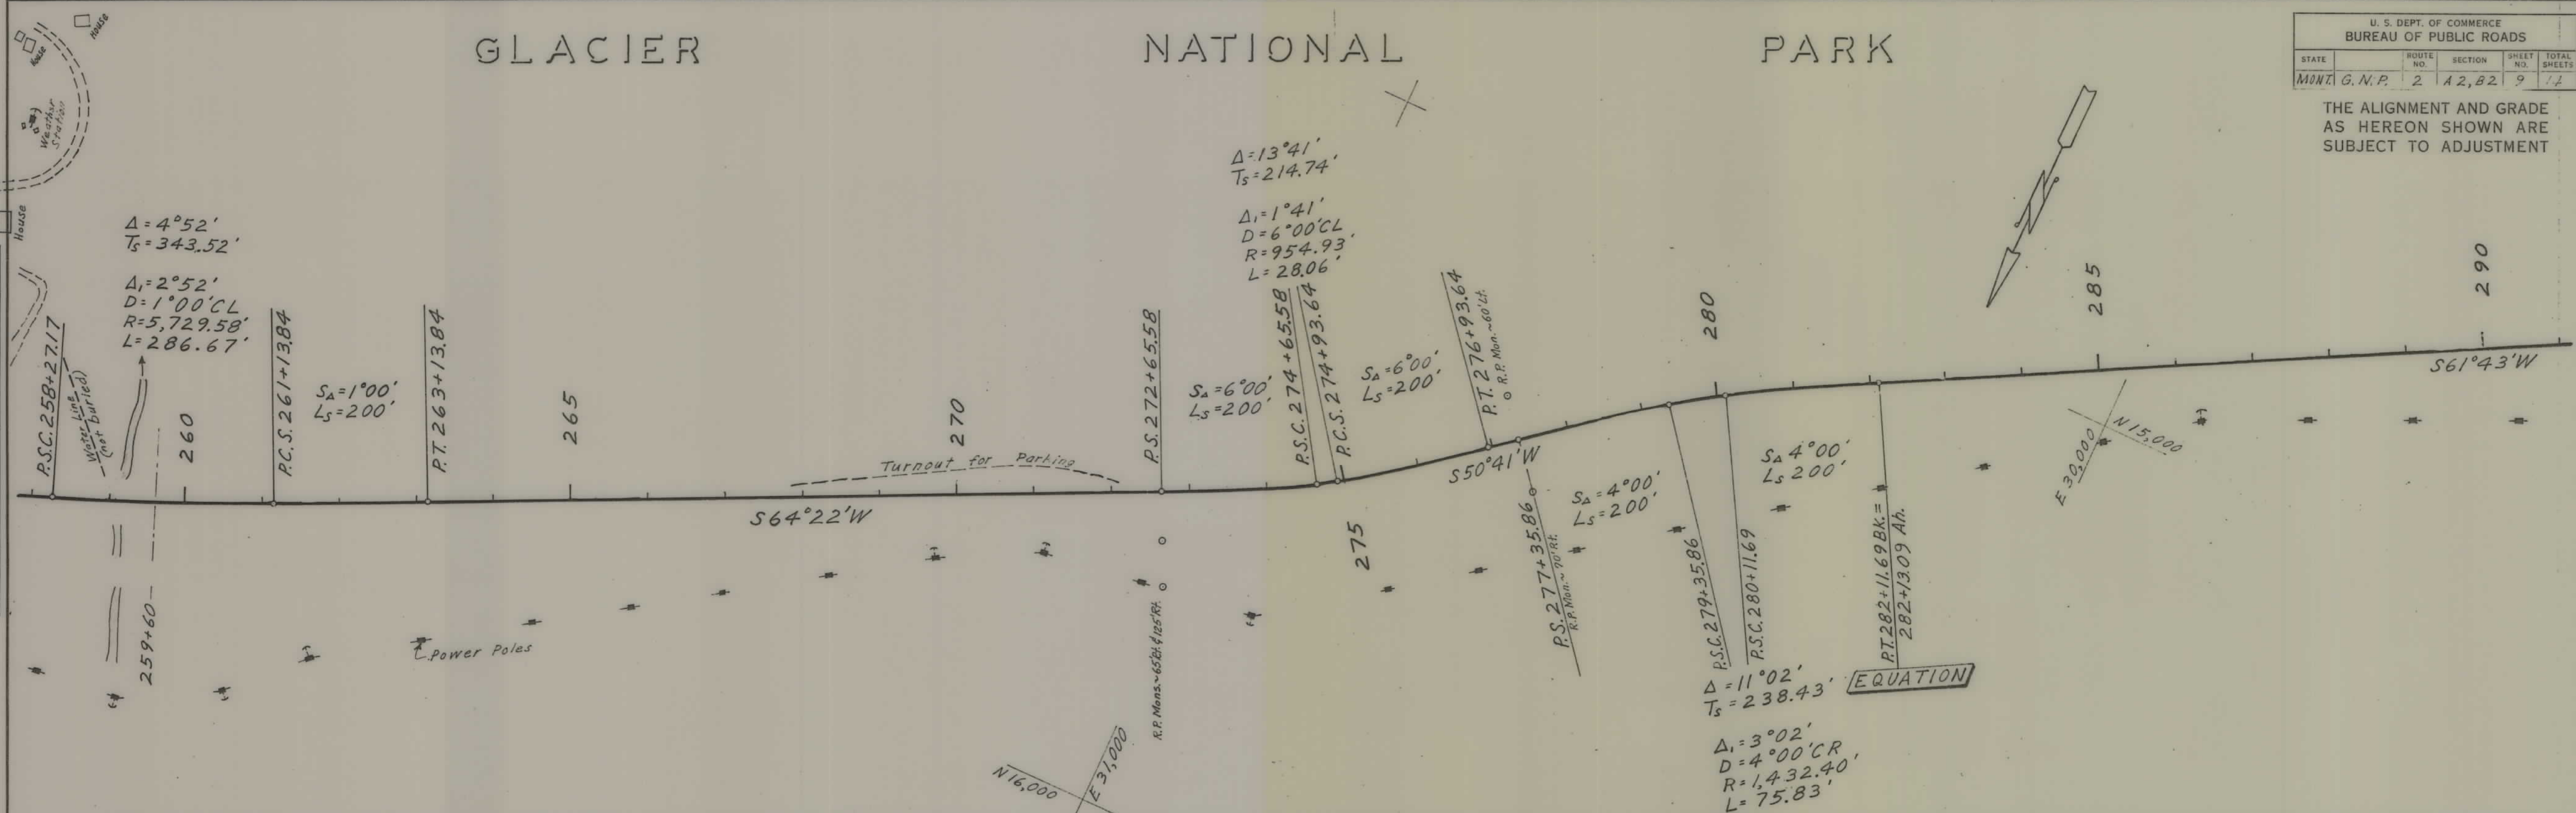


PLAN		DATE	
NO.	PLAN	BY	DATE
	NO.		DATE
	NO.		DATE
	NO.		DATE

PROFILE		DATE	
NO.	PROFILE	BY	DATE
	NO.		DATE
	NO.		DATE
	NO.		DATE

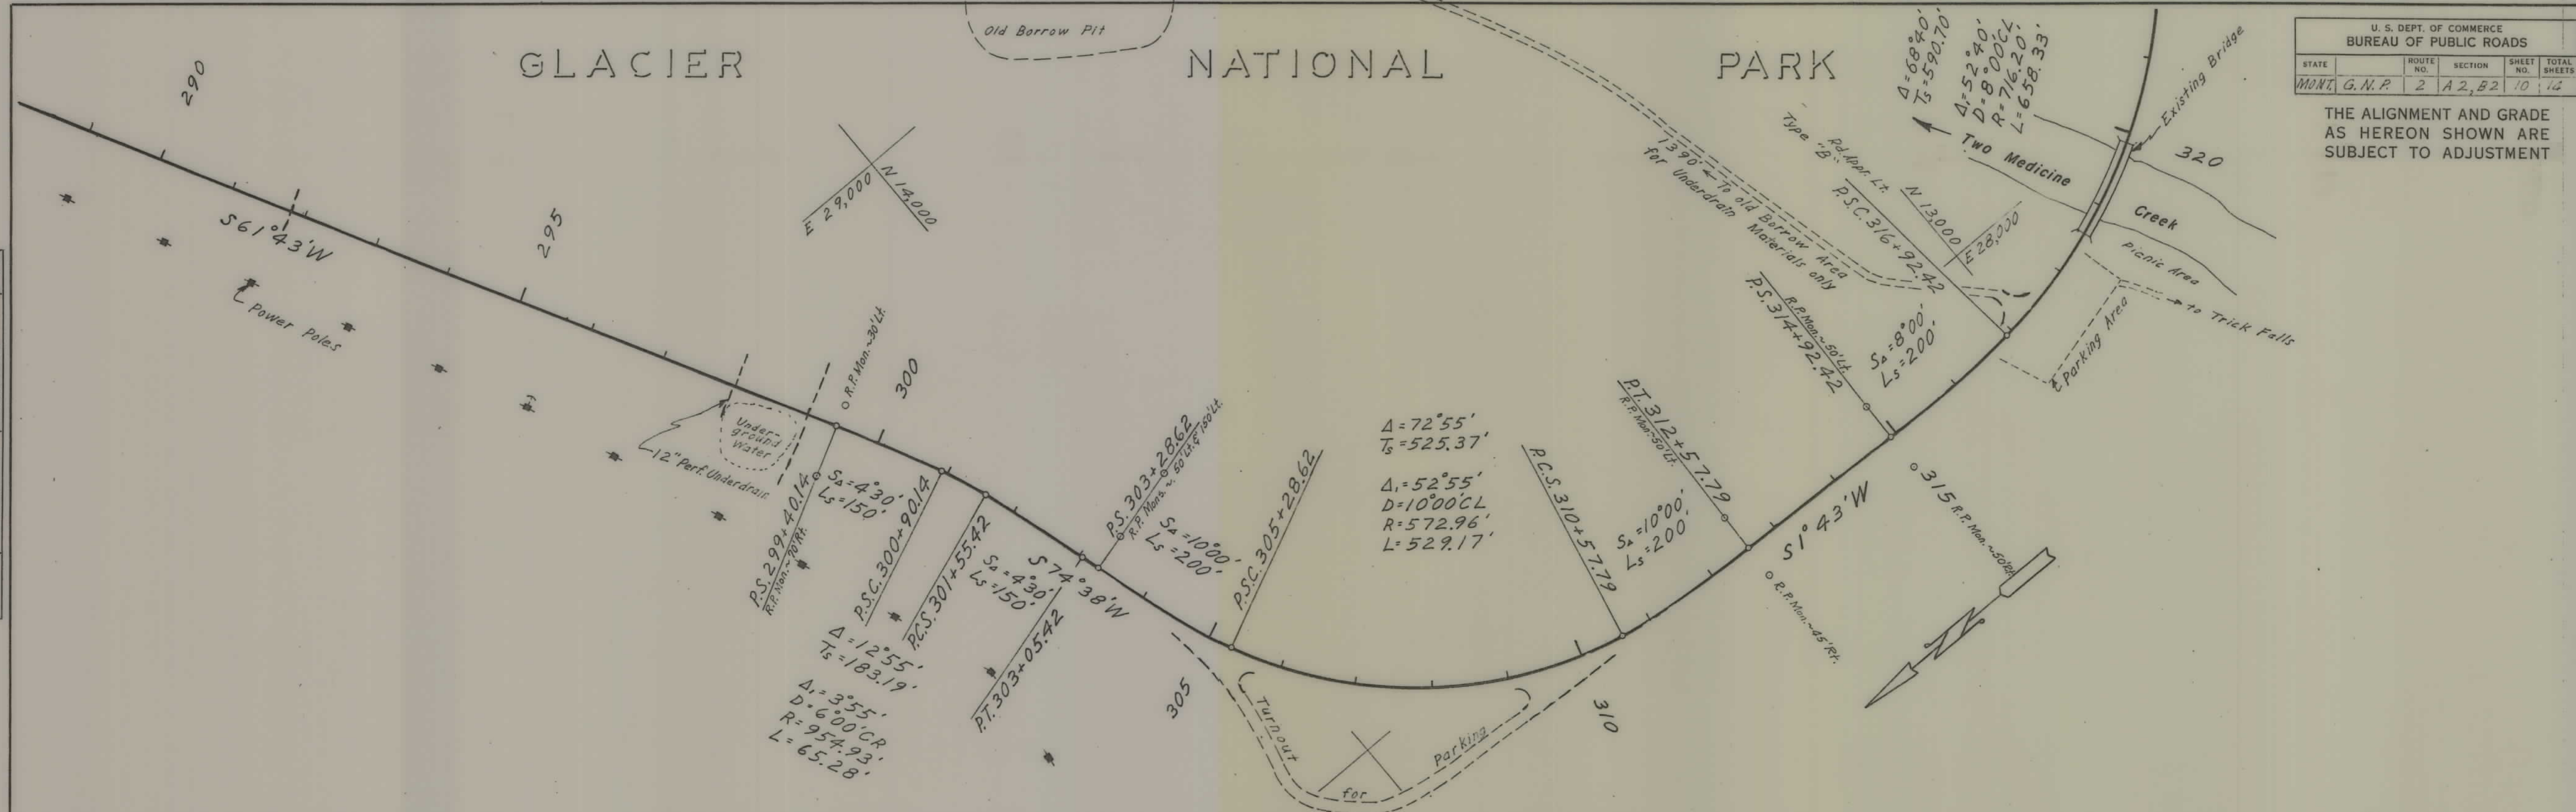

U. S. DEPT. OF COMMERCE BUREAU OF PUBLIC ROADS				
STATE	ROUTE NO.	SECTION	SHEET NO.	TOTAL SHEETS
MONT.	G.N.P.	2	A2, B2	10

THE ALIGNMENT AND GRADE AS HEREON SHOWN ARE SUBJECT TO ADJUSTMENT

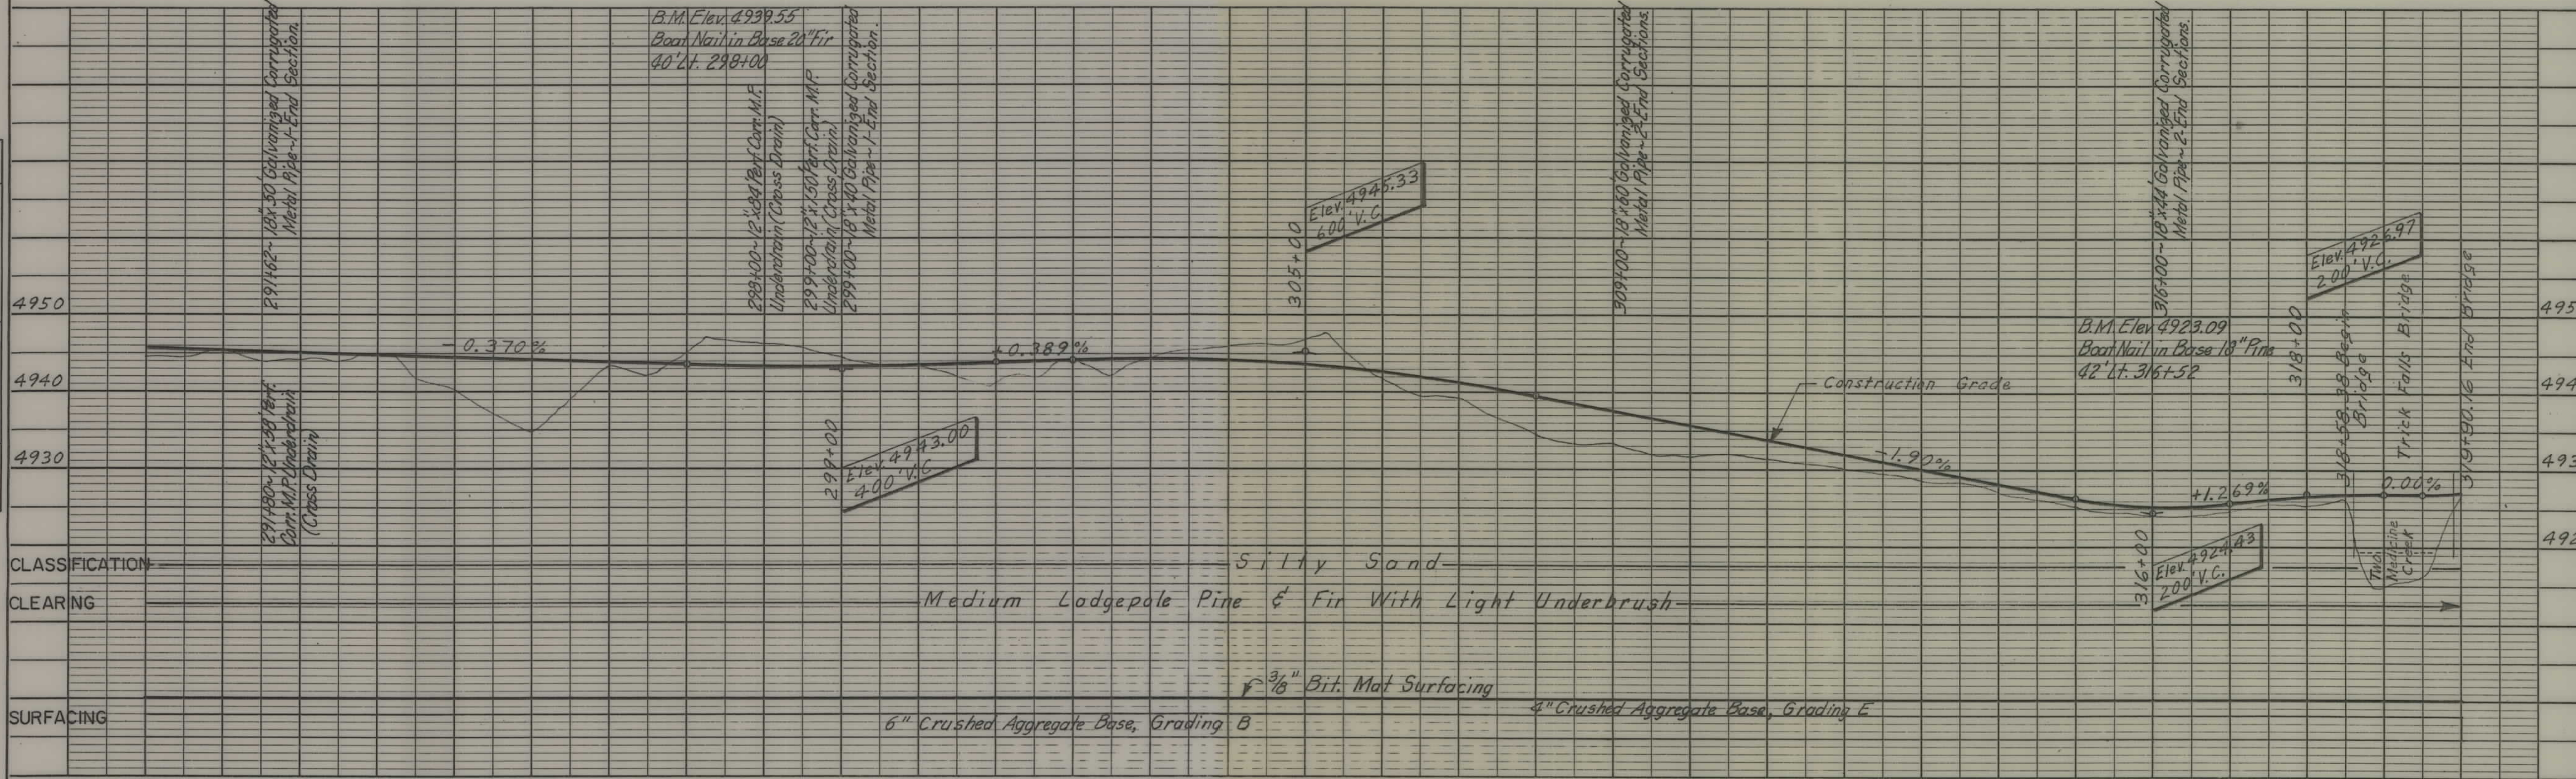



PLAN	DATE
NOTE BOOK	1959
	1960
	4-11-60

PROFILE		BY	DATE
SURVEYED			
PLOTTED			
GRADES CHECKED			
E.M.t. NOTED			

GLACIER NATIONAL PARK

U. S. DEPT. OF COMMERCE BUREAU OF PUBLIC ROADS					
STATE		ROUTE NO.	SECTION	SHEET NO.	TOTAL SHEETS
MONT.	G. N. P.	2	A2, B2	11	12

THE ALIGNMENT AND GRADE
AS HEREON SHOWN ARE
SUBJECT TO ADJUSTMENT

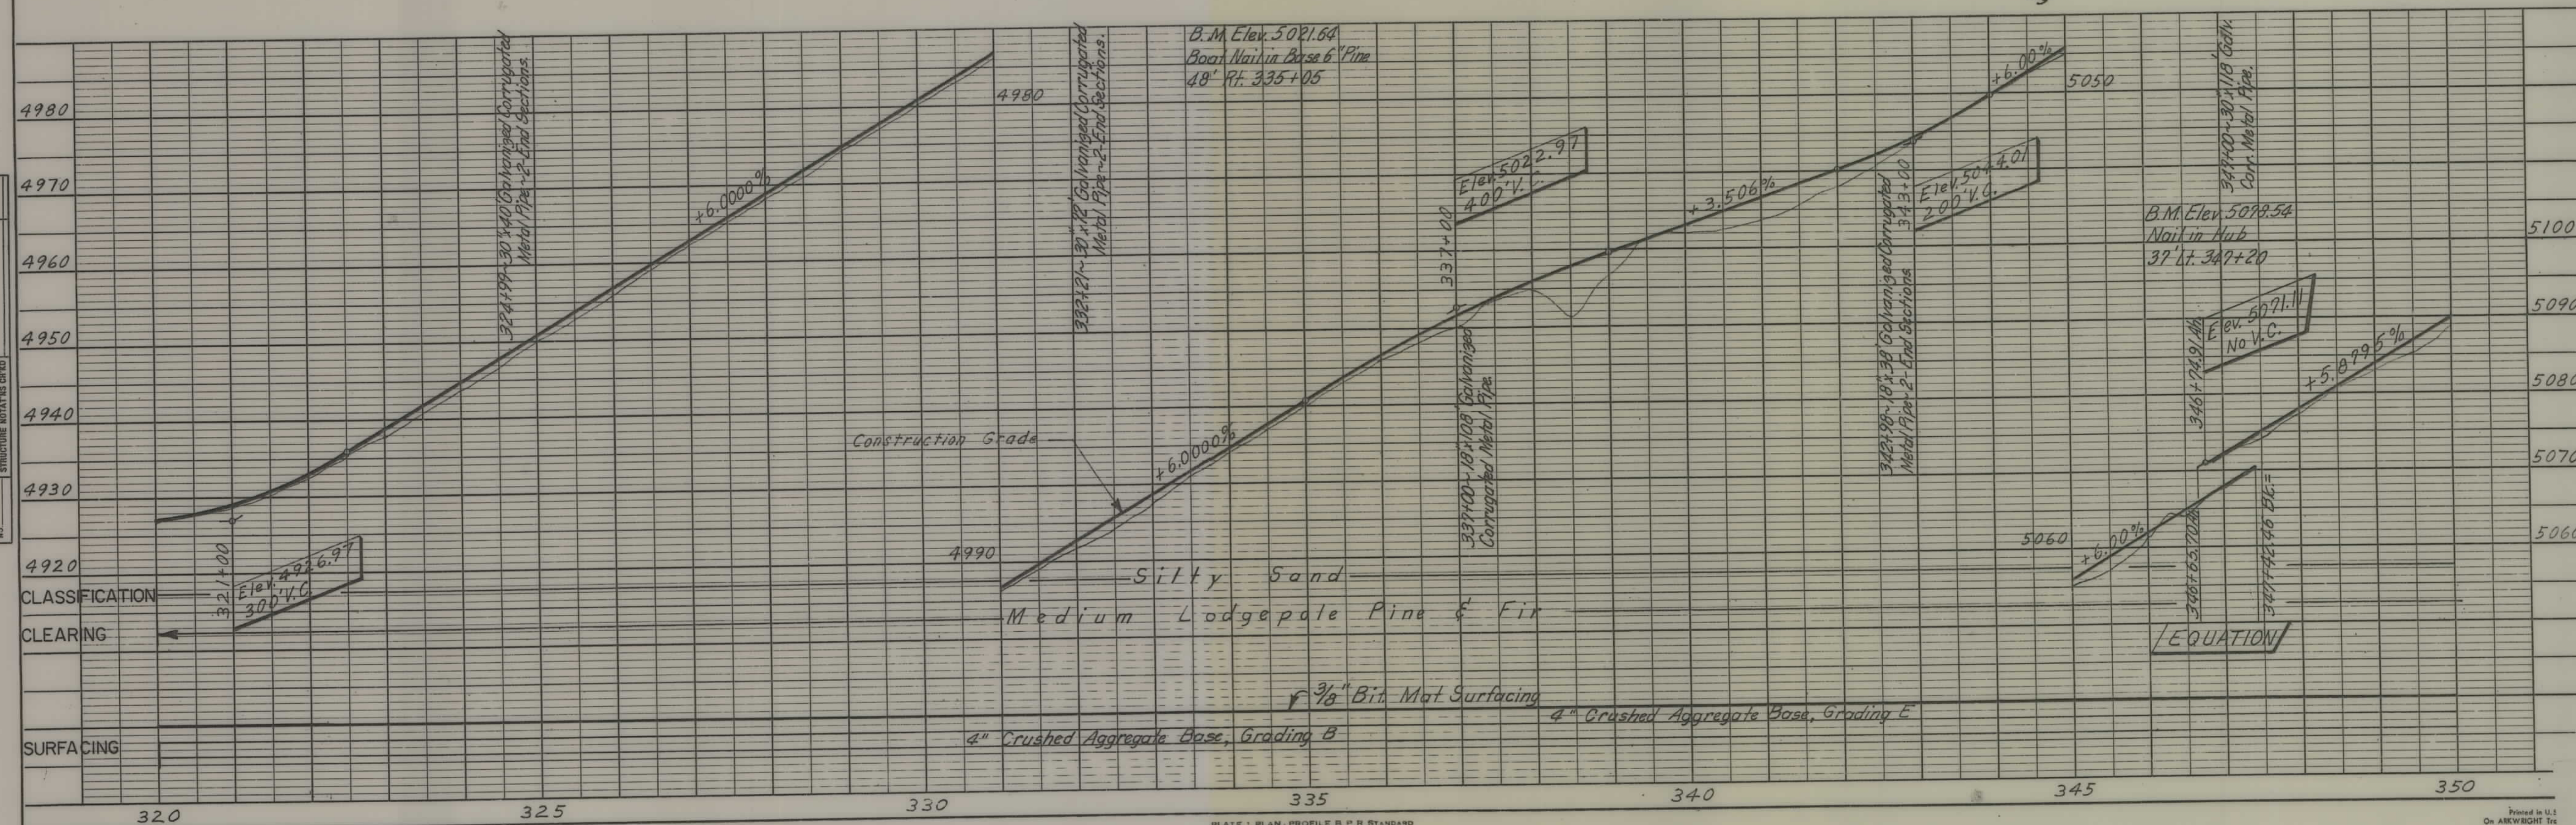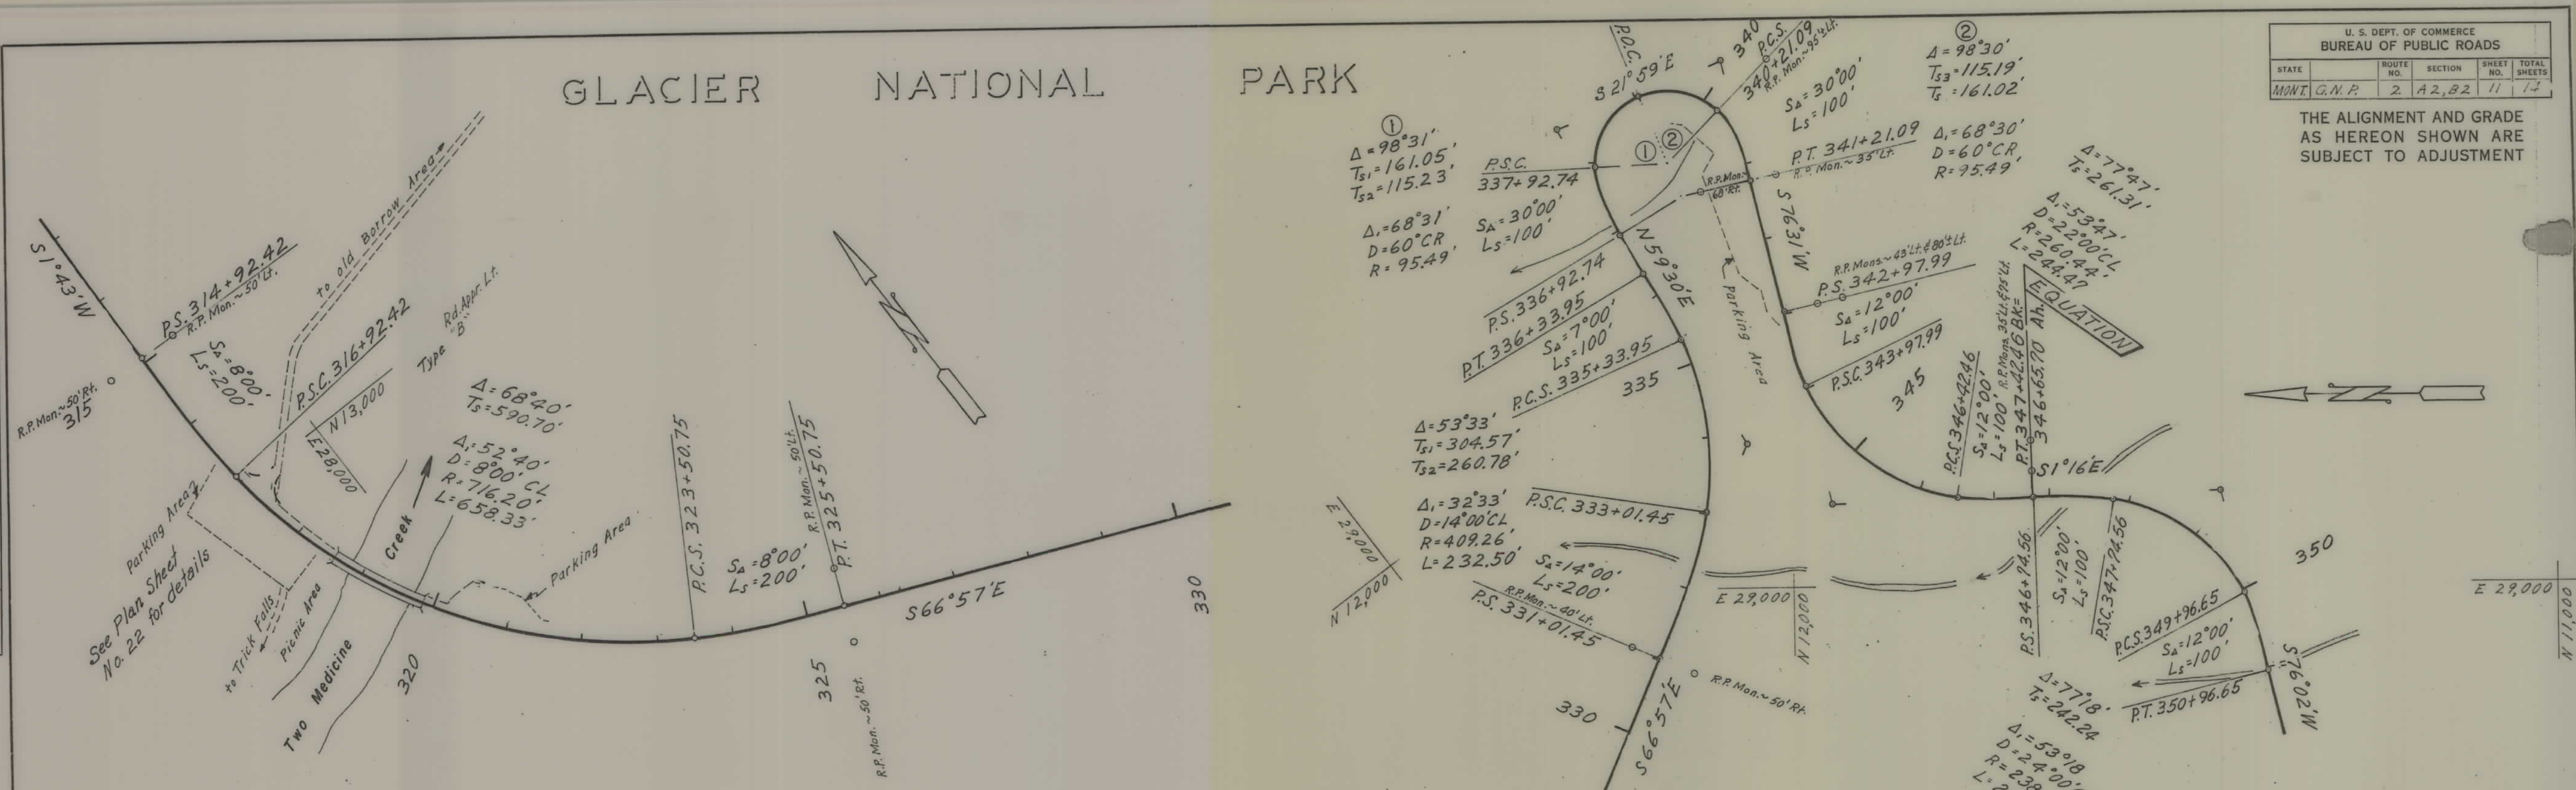

PLAN	SURVISED	BY	DATE
NOTE BOOK	PLOTTED	RA. Frame	1959
	ALIGNMENT CHECKED	" "	1960
	RT. OF WAY CHECKED		
NO.	DRAWED	CALLAN	4-12-60

PROFILE	BY	DATE
SURVEYED		
PLOTTED		
GRADES CHECKED		
B.M.s. NOTED		
STRUCTURE NOTATIONS CHECKED		
NO.		



GLACIER

NATIONAL

PARK

U. S. DEPT. OF COMMERCE BUREAU OF PUBLIC ROADS					
STATE		ROUTE NO.	SECTION	SHEET NO.	TOTAL SHEET
MONT.	G. N. P.	2	A 2, B 2	12	14

THE ALIGNMENT AND GRADE
AS HEREON SHOWN ARE
SUBJECT TO ADJUSTMENT

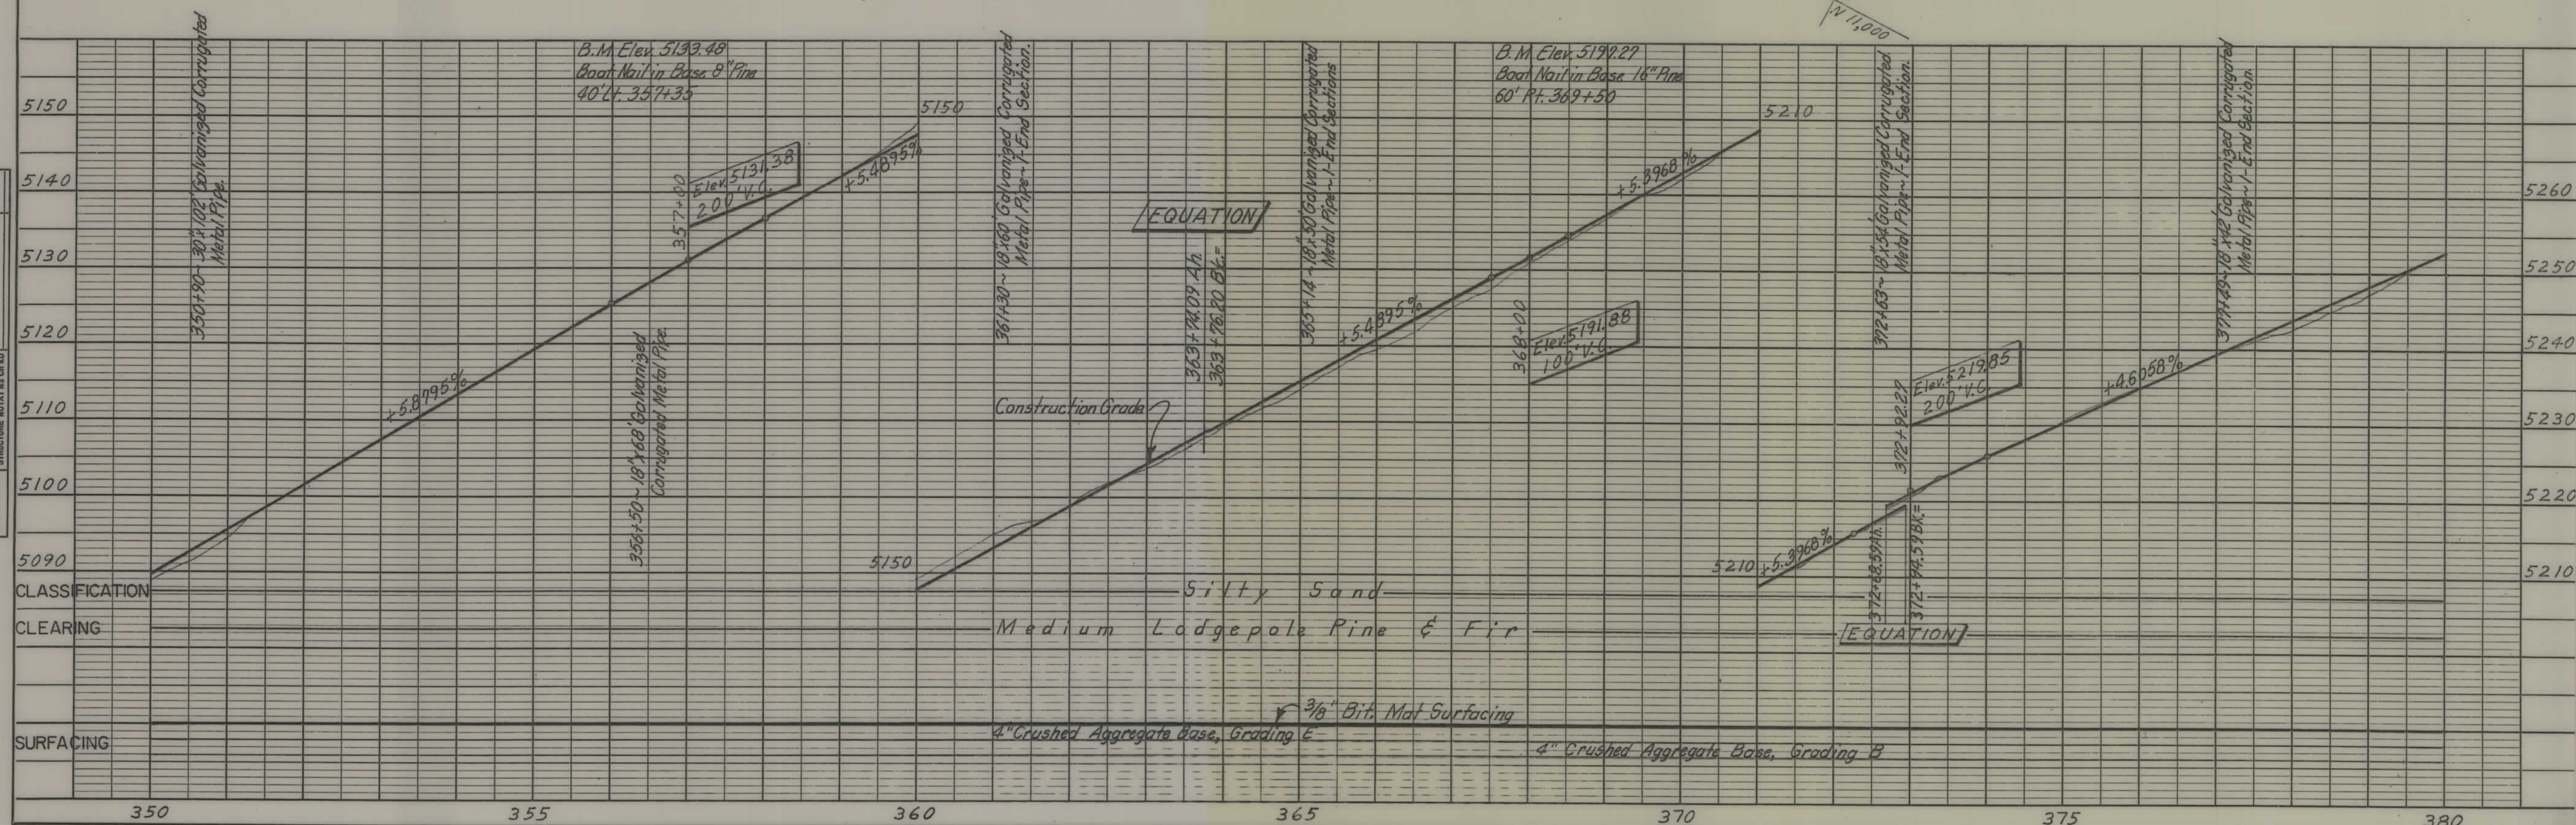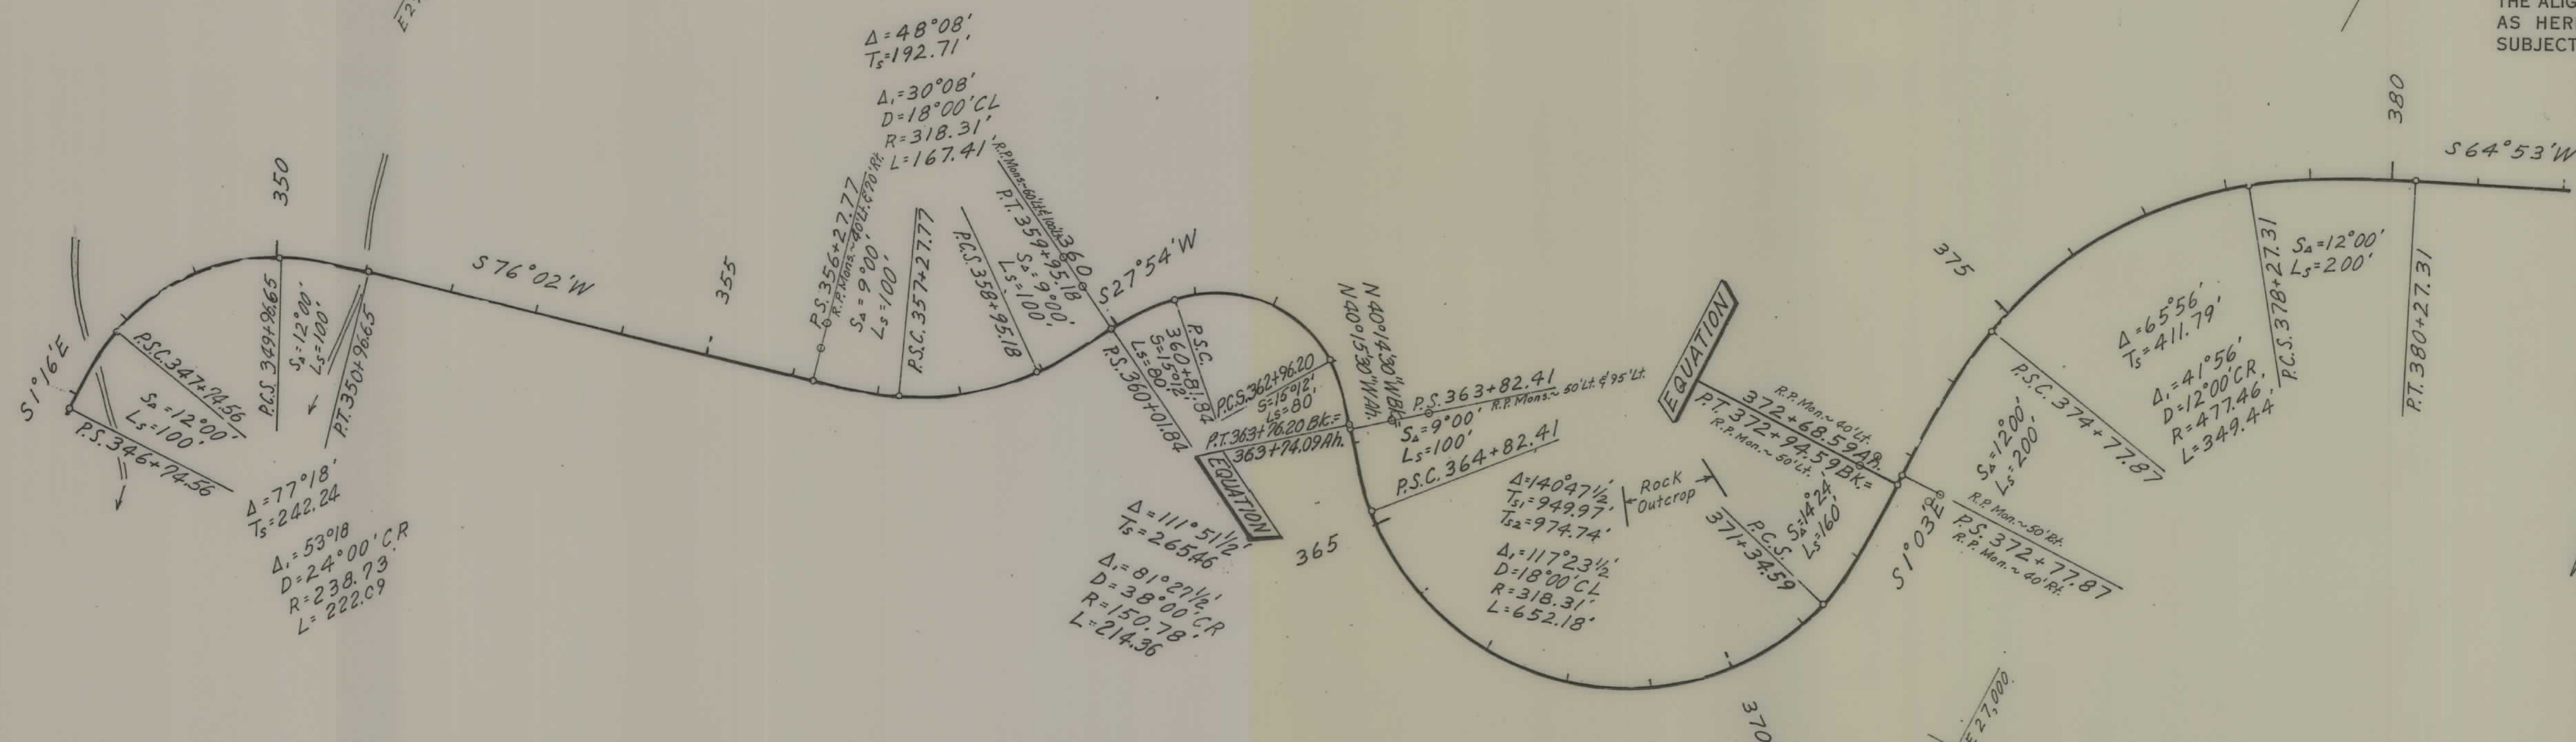


GLACIER NATIONAL PARK


U. S. DEPT. OF COMMERCE BUREAU OF PUBLIC ROADS				
STATE	ROUTE NO.	SECTION	SHEET NO.	TOTAL SHEETS
MONT.	G. N. P.	2	A 2, B 2	13

THE ALIGNMENT AND GRADE
AS HEREON SHOWN ARE
SUBJECT TO ADJUSTMENT

PLAN	DATE	BY
SURVEYED	1929	R. A. Frame
NOTED	1950	"
REVISION		CAL. Larson

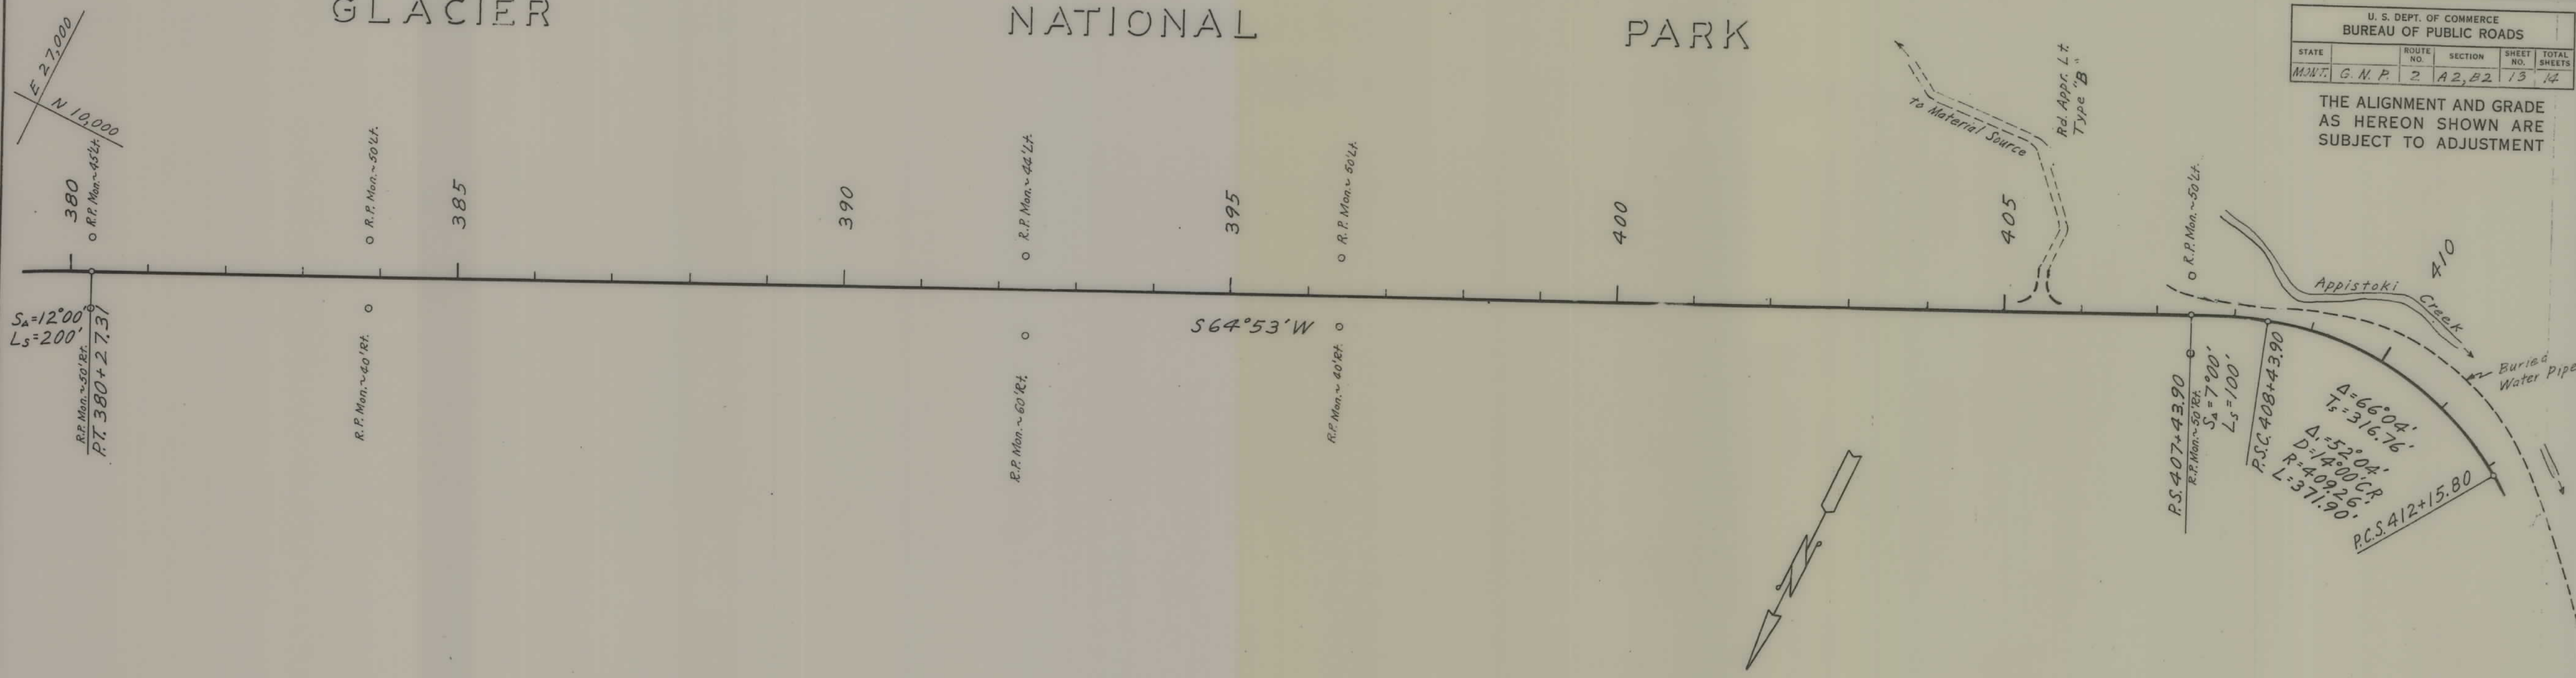

PROFILE	DATE	BY
SURVEYED		
NOTED		
REVISION		

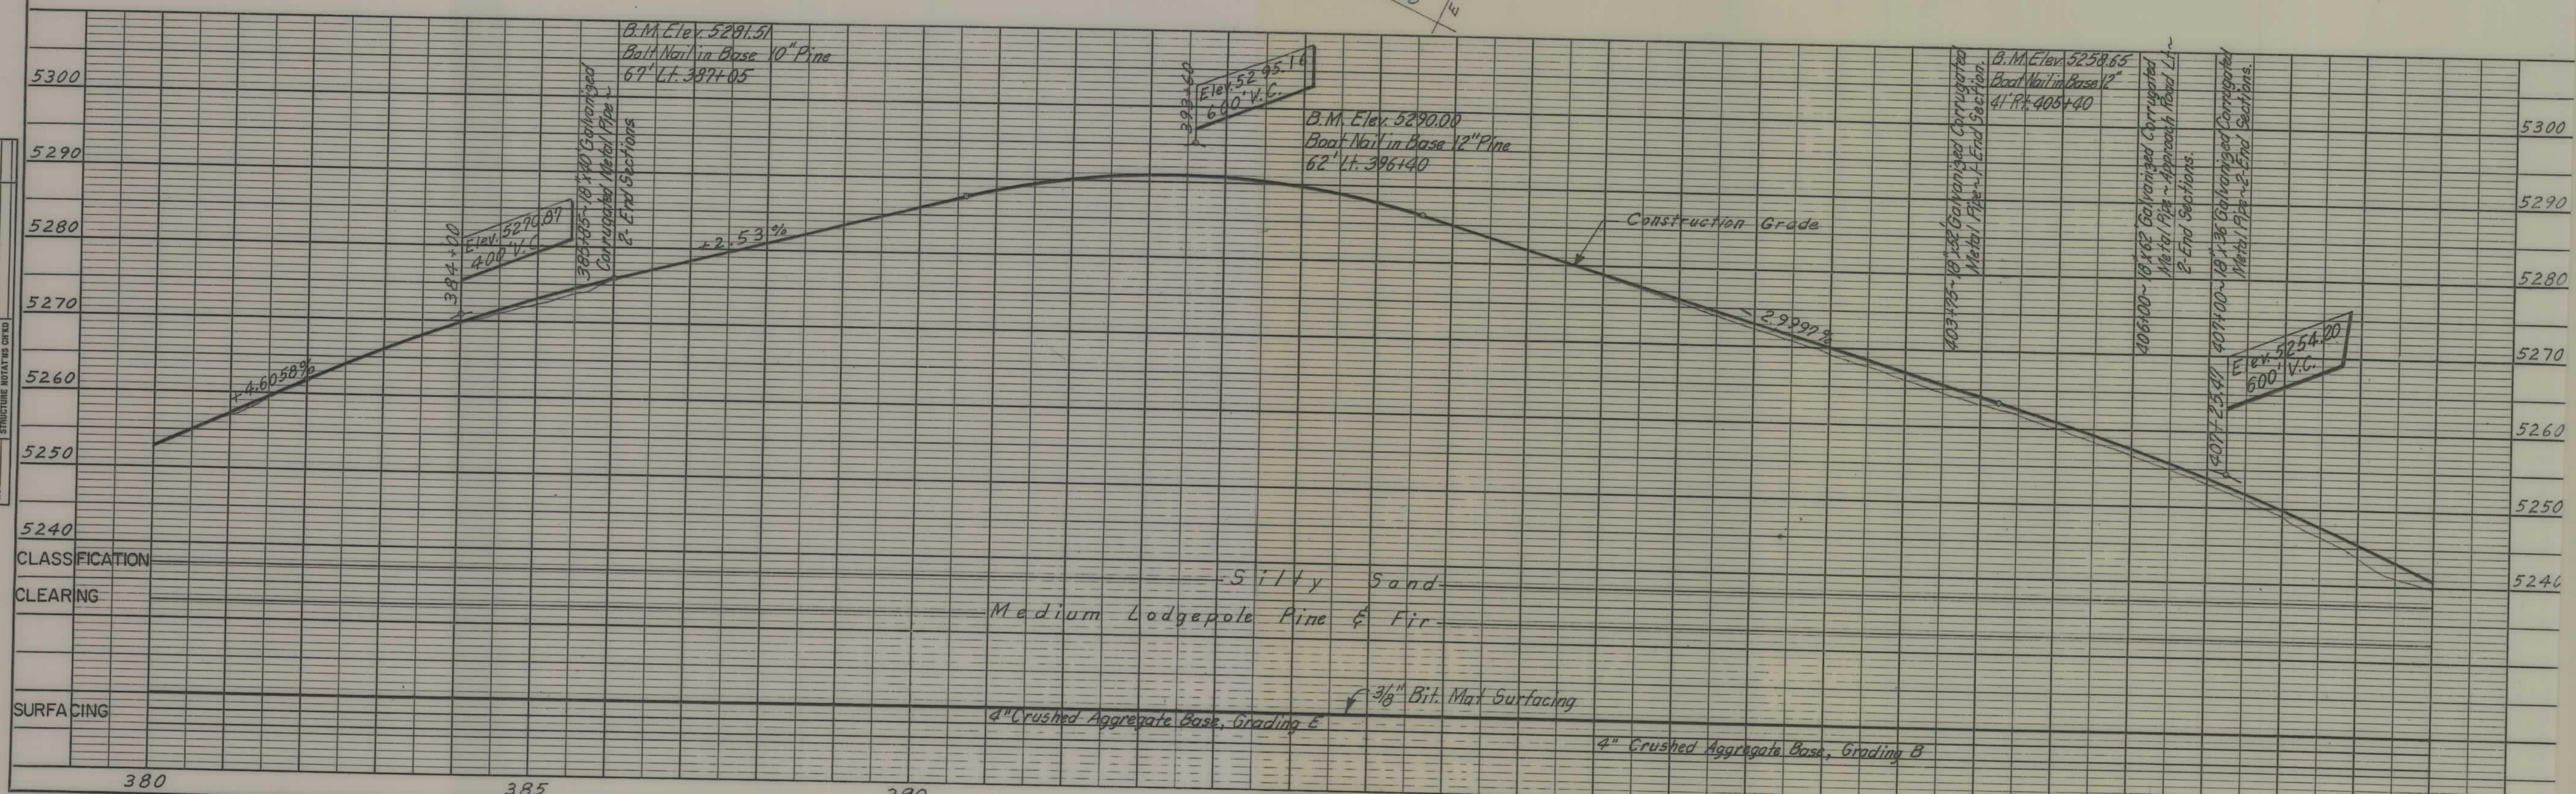

GLACIER

NATIONAL


PARK

U. S. DEPT. OF COMMERCE BUREAU OF PUBLIC ROADS				
STATE	ROUTE NO.	SECTION	SHEET NO.	TOTAL SHEETS
MONT.	G. M. P.	2	A 2, B 2	14


THE ALIGNMENT AND GRADE
AS HEREON SHOWN ARE
SUBJECT TO ADJUSTMENT

STA. 422+50 END PROJECT NO. 2-A2,B2

PLAN	DATE	BY
NO. 1	1952	R. A. Frame
NOTE BOOK	1960	
NO.	31466	

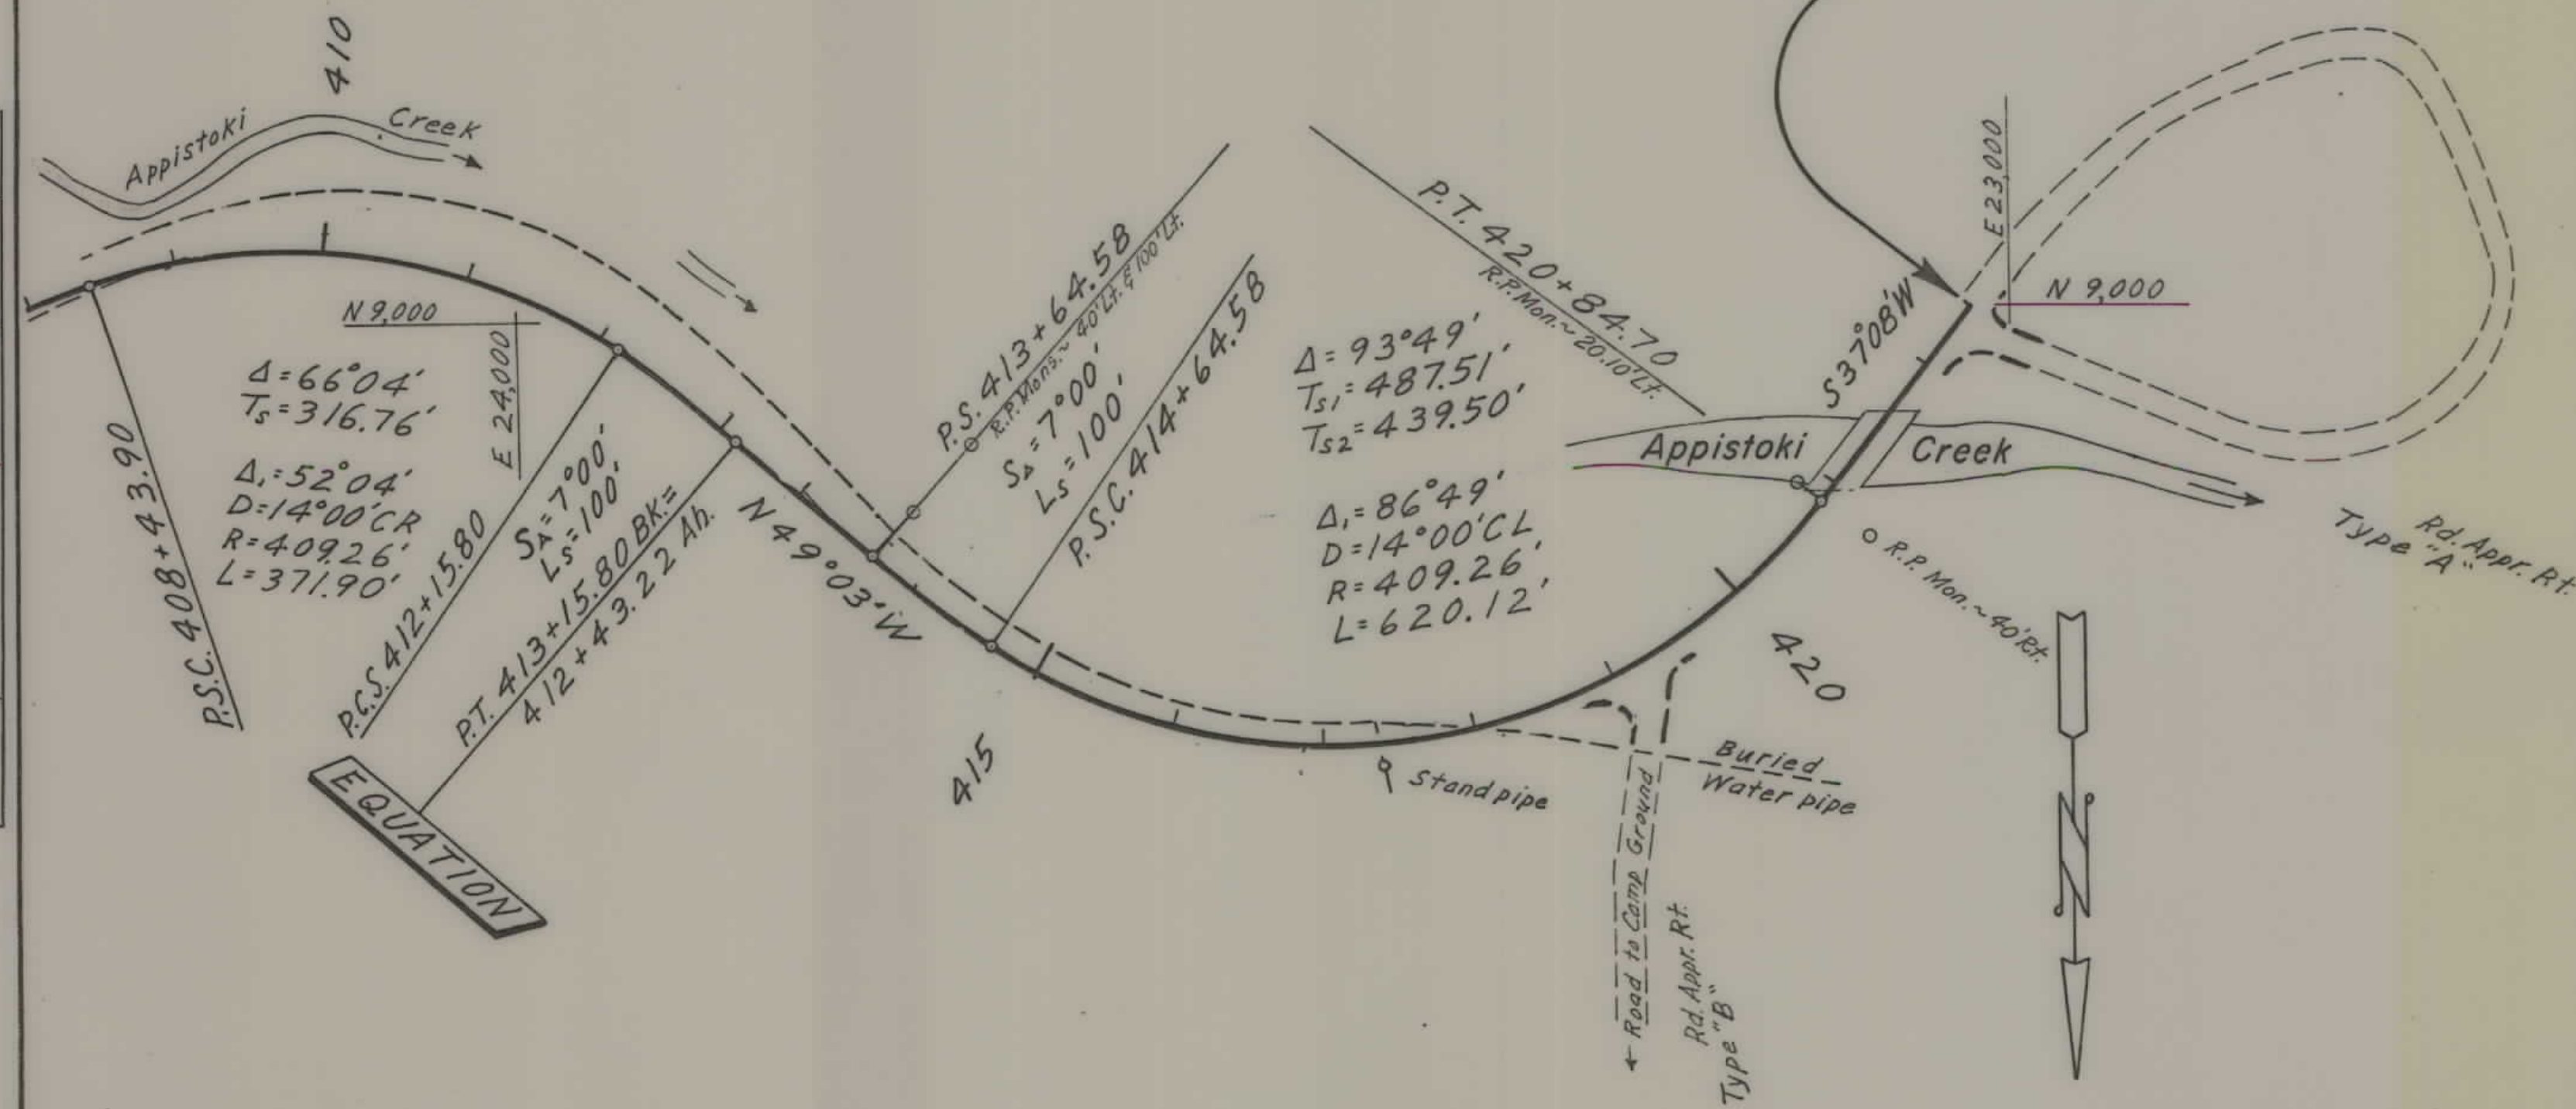

PROFILE	DATE	BY
NO. 1		
NOTE BOOK		
NO.		

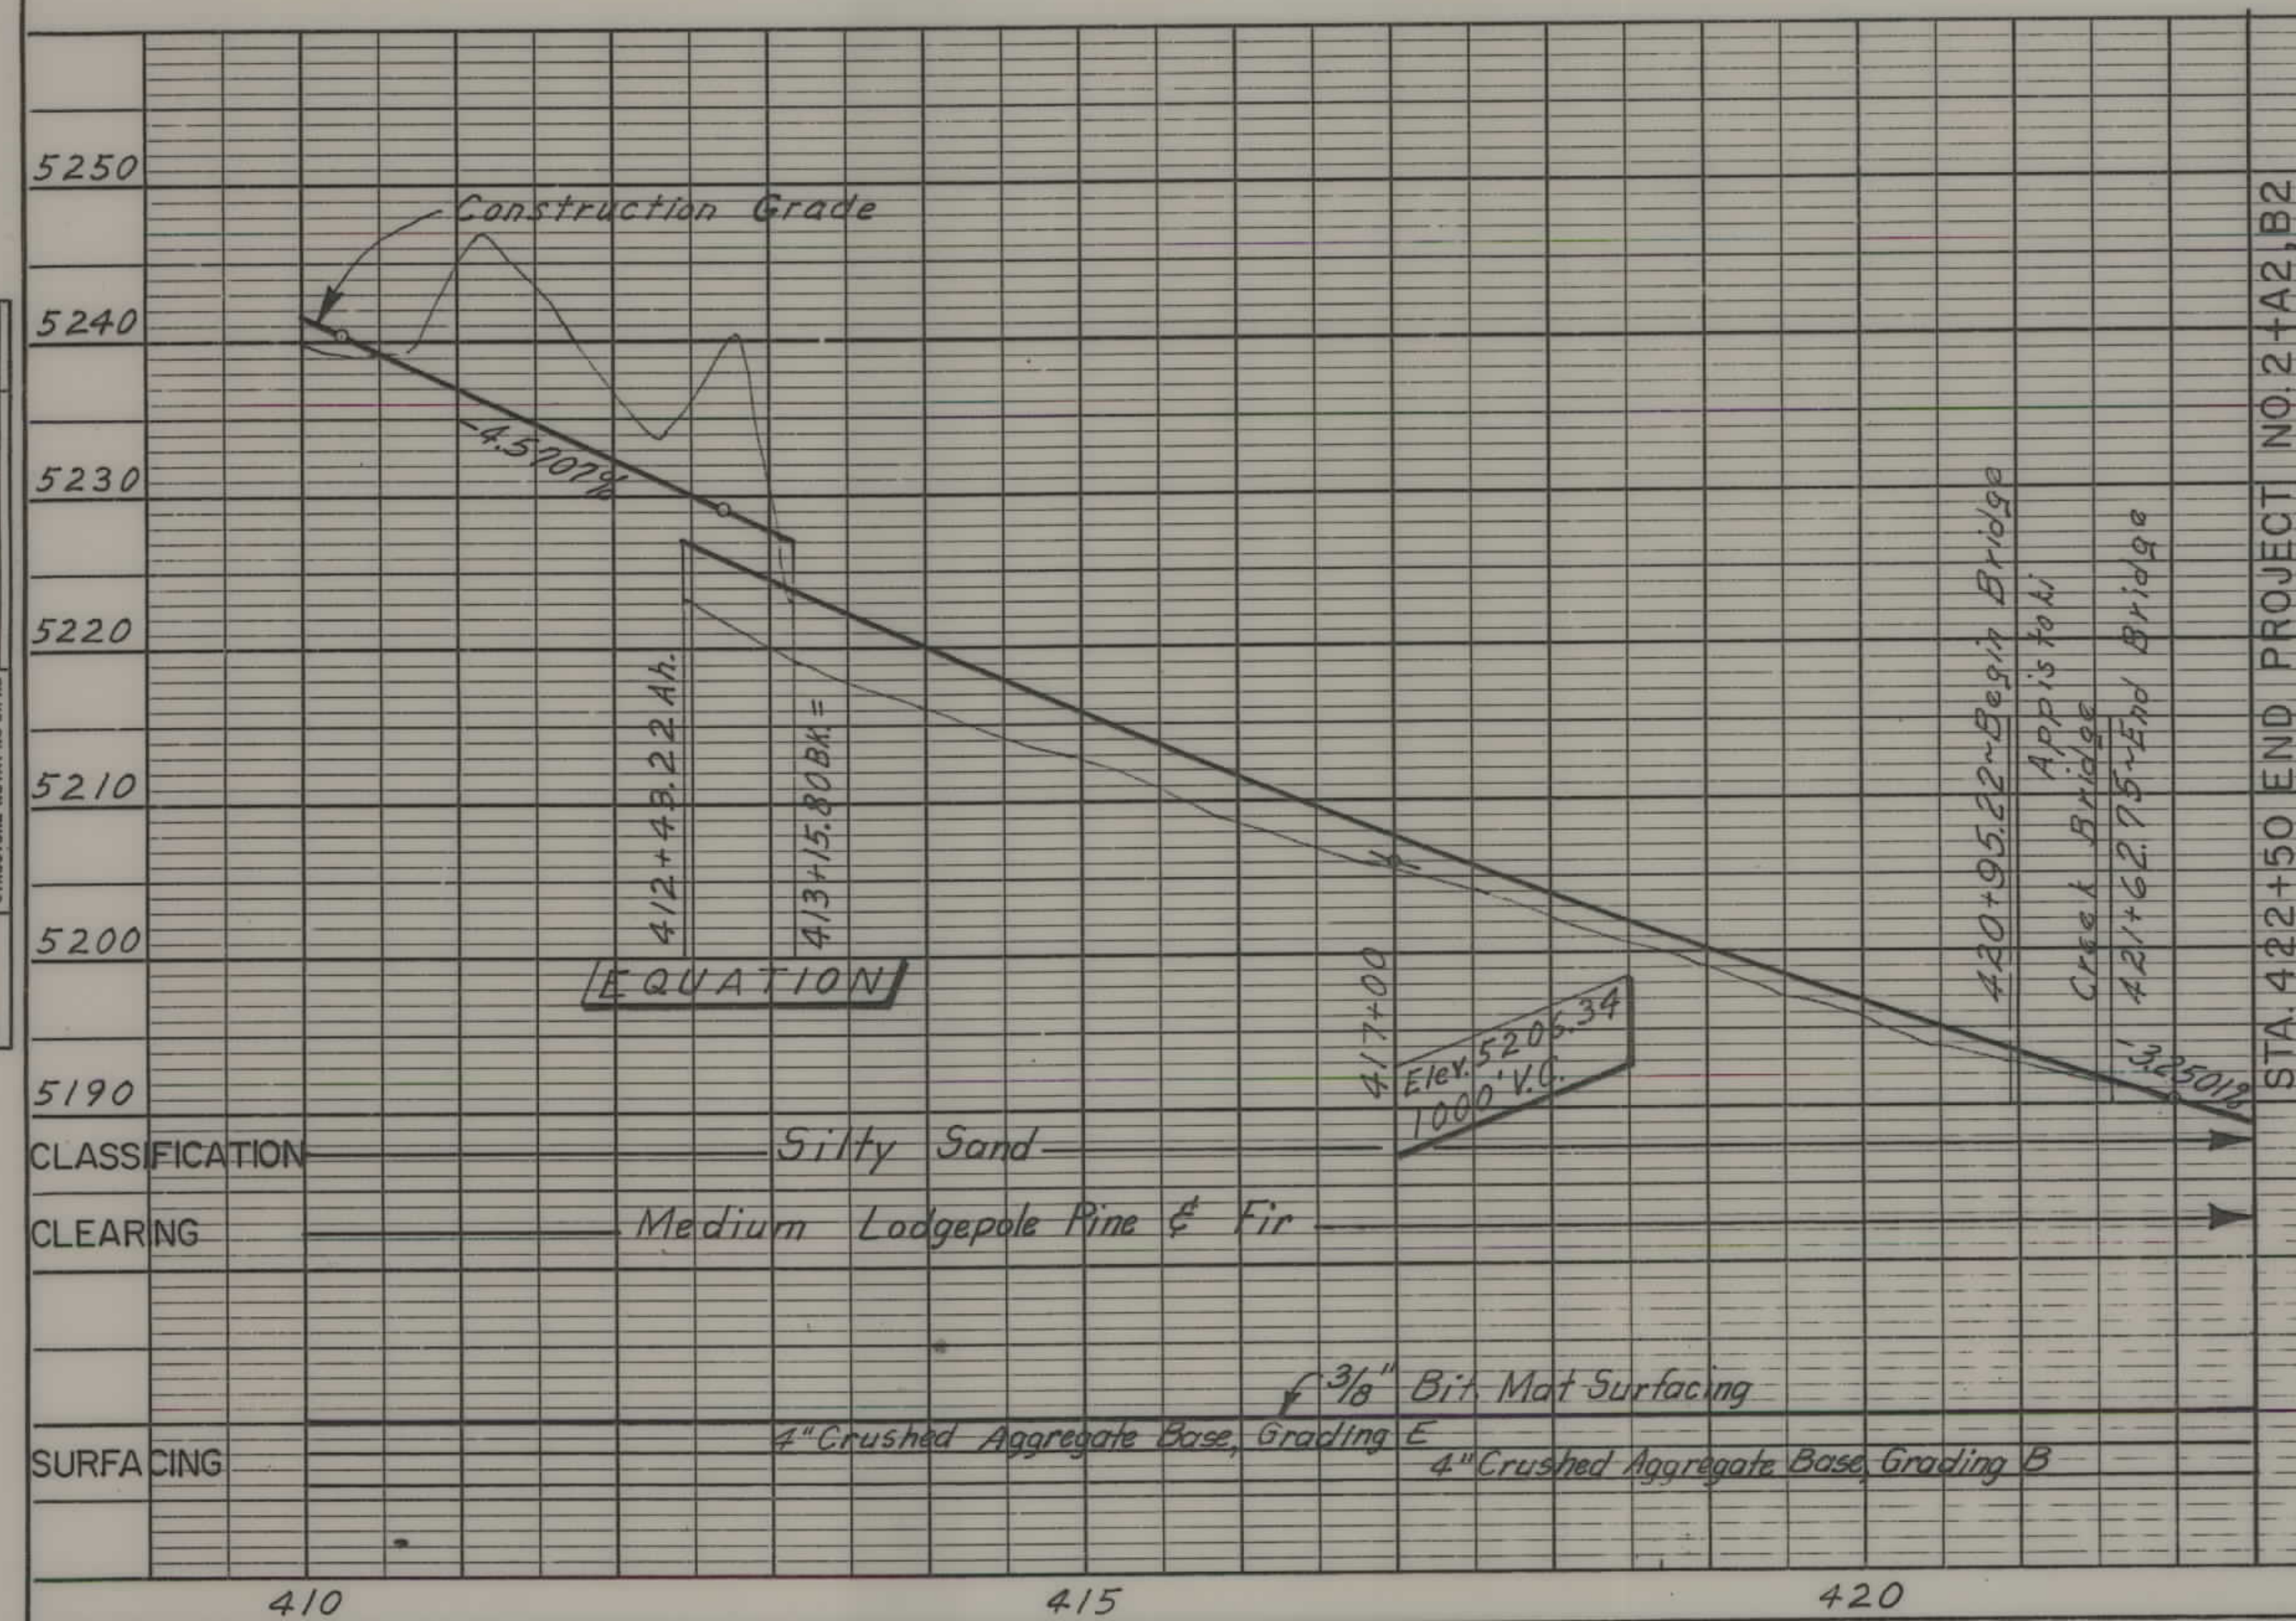

STA. 422+50 END PROJECT NO. 2-A2,B2