

"AS CONSTRUCTED" PLANS
SCALE: 1"=400'

PROJECT 59-2(4) & FL 59(4)

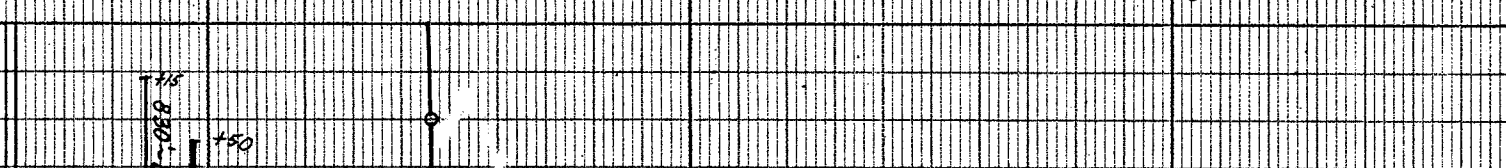


O.I.P. REFERENCE POINT MONUMENT
(2 1/2" IRON PIPE WITH BRASS CAP)

**CLASSIFICATIO
CLEARING**

T 85 R 19E M. P.

CLASSIFICATION	
CLEARING	

[illegible]

GUARDRAIL
FENCING
SURFACING