

PLANS
NOT
TO
SCALE

STATE	PROJECT NUMBER	SHEET	TOTAL
		NO.	SHEETS
MONTANA	F 52 - 2 (12) 34	1A	28

CRESTON N & S

INDEX

(CONTINUED FROM SHEET 1)

BACKSLOPE LIMITS INCLUDE ROUNDING
CONSTRUCTION LIMITS CUT SECTION

TOE OF FILL

TOP OF CUT
DITCH BOTTOM

FHWA/DOH APPROVAL 2-19-91

MAP REVISED 7-3-91, 11-22-91, 2-6-92, 2-25-92
4-24-92, 5-7-92, 5-12-92, 7-22-92, 8/31/92, 12-10-92
4-22-92, 5-7-92, 9-30-92, 5-21-94, 1-11-95, 2-3-95
10-14-95 11-6-95, 11-20-95

STATE OF MONTANA
DEPARTMENT OF HIGHWAYS
LAND REQUIRED FOR RIGHT OF WAY
FLATHEAD COUNTY

SCALE: 1" = 0

NOTE: U = UTILITIES INVOLVED

3	6	9	MONTANA CADD	07-FEB-1991
2	5	8		05:14
1		7		RDRW

2000: [32, 6] 0768 hwy 1, row: 1

F 52-2(12)34 SHT 1A OF 29

OWNERSHIPS									
PARCEL	NAME	ADDRESS	TOTAL AREA	GROSS R/W AREA	P.T.W. AREA	AREA TO BE ACQUIRED	REMAINDER LEFT	REMAINDER RIGHT	CONST. PERM. AREA
1	HAZEL I. CROSKREY, TRUSTEE			2.34 AC.	0.56 AC.	1.78 AC.			
2	MARY I. BRITTON ET AL.			0.89 AC.	0	0.89 AC.			
3	GEORGE DARROW			SEE SHEET NO. 3					
4	LARRY STREETER, ET AL.		0.782 AC.	NEGOTIATIONS ONLY		FOR ACCESS CONTROL			
5	MANDATORY WATER USERS ASSOCIATION		504 SF						224 SF
6	LARRY STREETER		40,119 SF						540 SF
7	DALE J. SINGER, ET AL.		1.382 AC.	NEGOTIATIONS ONLY		FOR ACCESS CONTROL			1800 SF
177	EARL C. & JOY E. BOSTEDT								
178	ELMER G. HOLAND ET AL.			NEGOTIATIONS ONLY		FOR ACCESS CONTROL			
179	ELWOOD T. MCKAY ET AL.			NEGOTIATIONS ONLY					

STATE	PROJECT NO.	SHEET NO.	TOTAL SHEETS
MONT.	F52-2(12)34	2	28

CRESTON N & S

STA. 19+70 ±
FLASHING LIGHT
X-ING &
19.3' CL.

STA. 16+70 ±
TEL. LINE X-ING &
BURIED


STA. 14+00 ±
TEL. X-ING &
18.8' CL.

STA. 10+19 ±
BURIED TEL.
X-ING &

STA. 5+85 ±
O.H. GUY WIRE
X-ING & 21.1' CL.

SW*
SEC.24

NW*
SEC.24

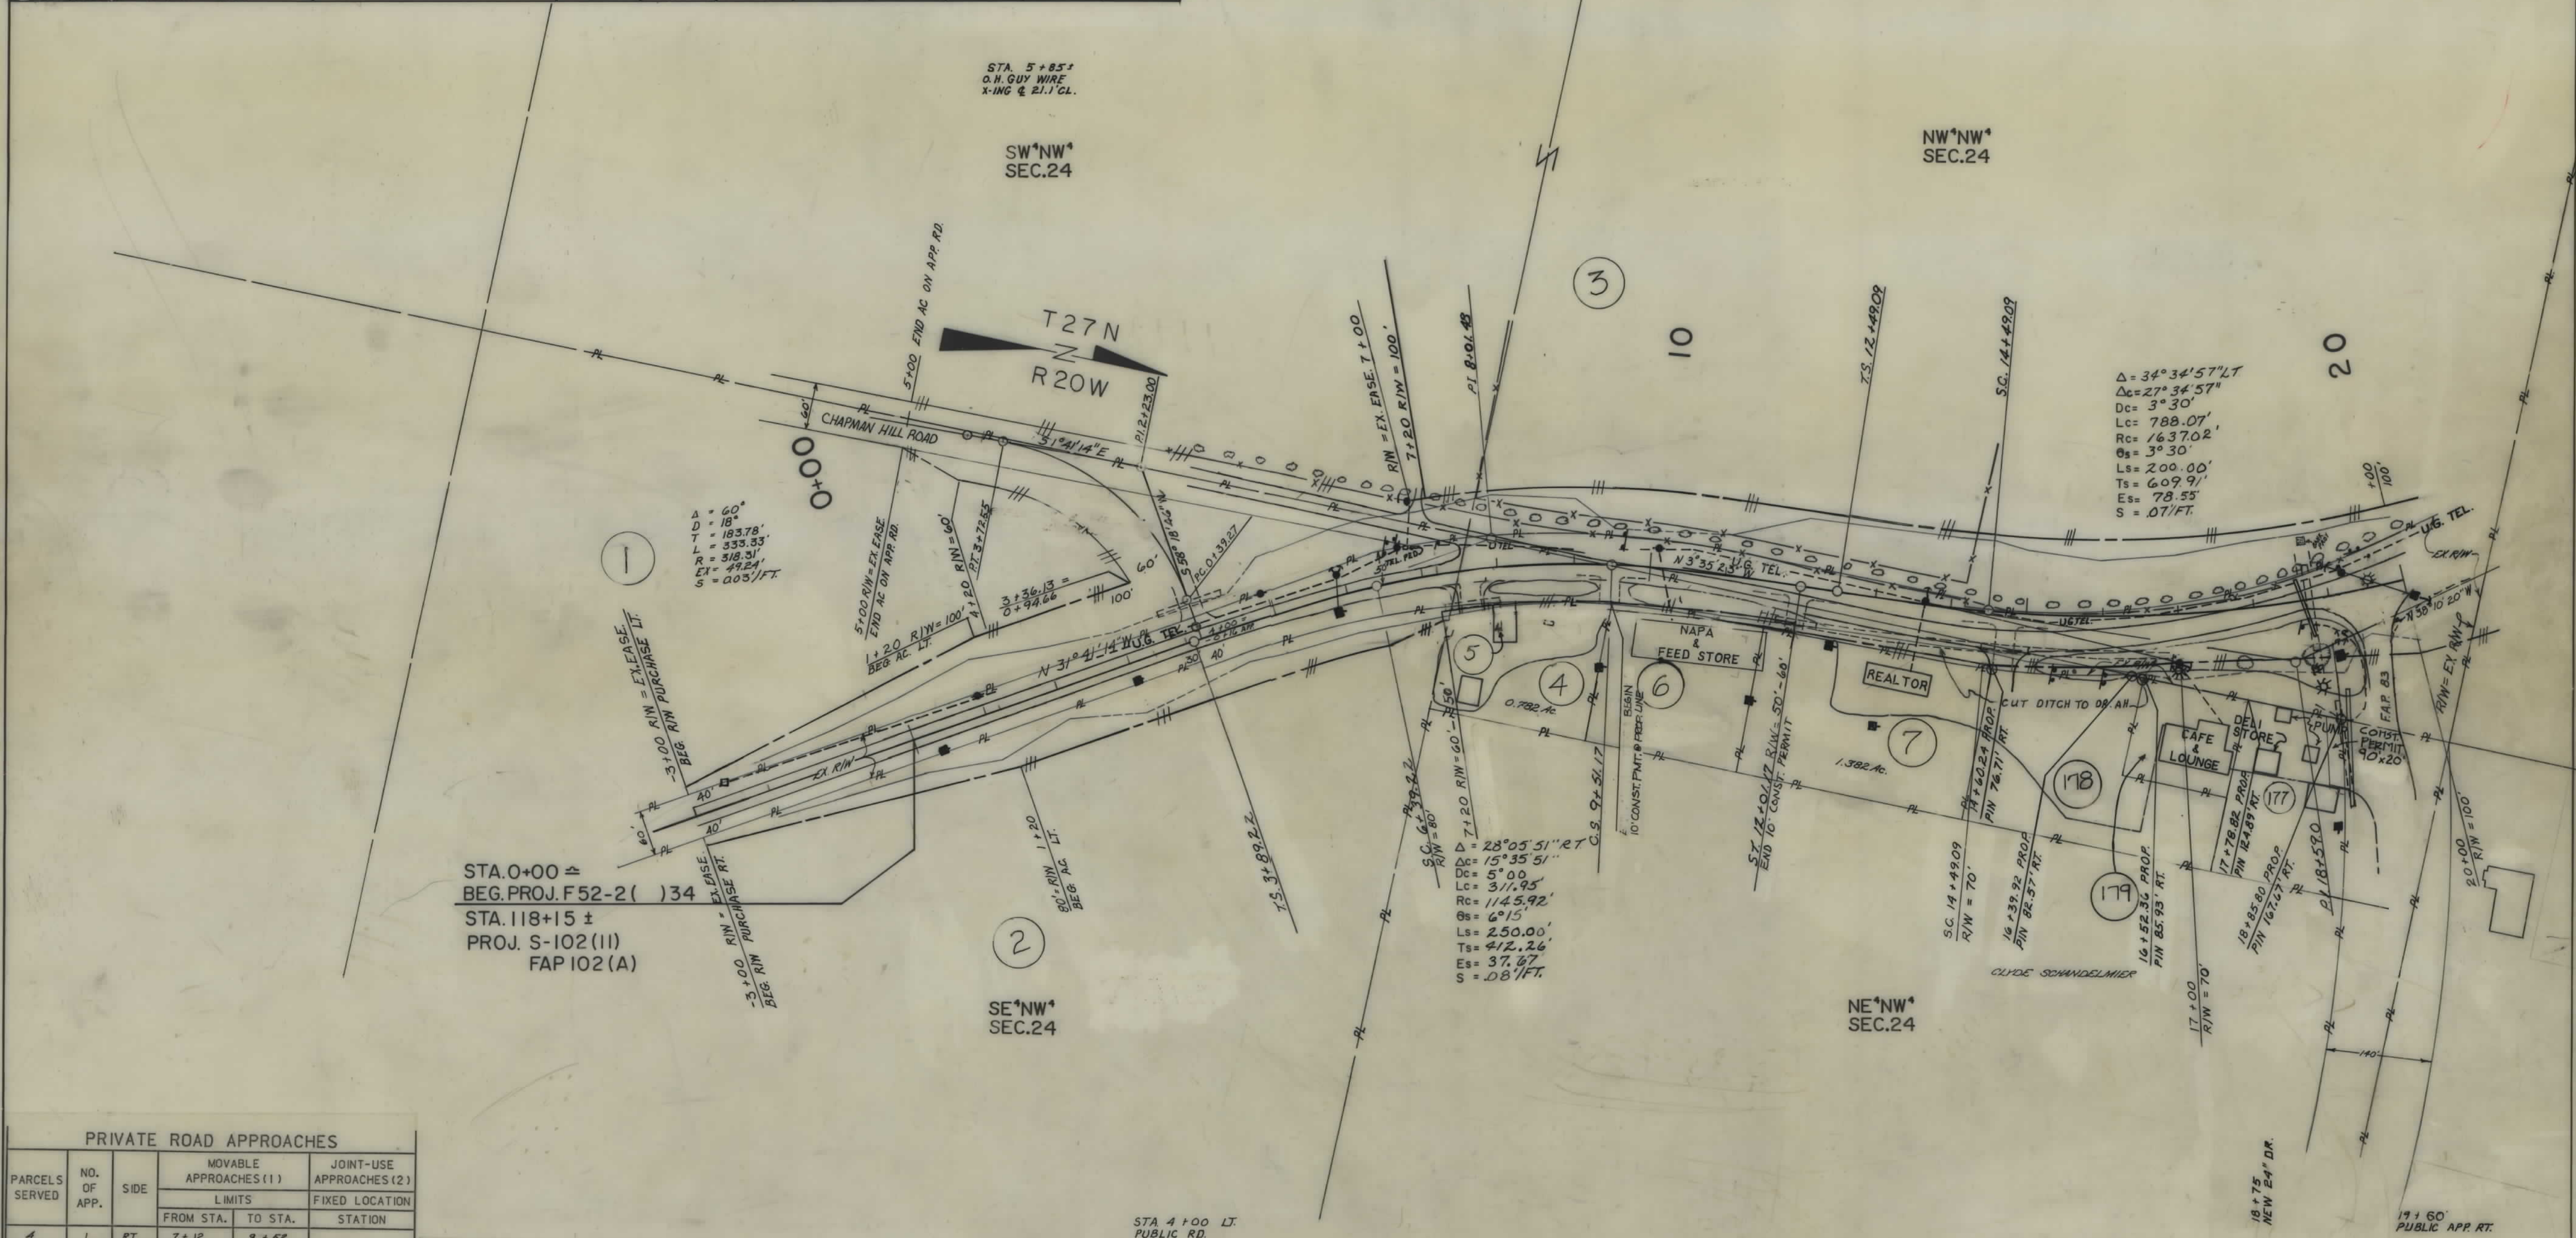

PRIVATE ROAD APPROACHES				
PARCELS SERVED	NO. OF APP.	SIDE	MOVABLE APPROACHES (1)	JOINT-USE APPROACHES (2)
			LIMITS	FIXED LOCATION
			FROM STA. TO STA.	STATION
4	1	RT	7+12 9+52	
4 & 6	1	RT		9+51
7	1	RT	11+69 14+60	
178	1	RT	14+60 16+50	
3	1	LT		**9+70
3	1	LT		19+50
1	1	LT	1+20 2+30	
1	1	LT	4+20* 5+00*	

(1) MOVABLE ROAD APPROACHES MAY BE RELOCATED BETWEEN THE SPECIFIED STATIONS AFTER THE INITIAL CONSTRUCTION. BEFORE RECONSTRUCTION, A PERMIT MUST BE OBTAINED FROM THE MDOT OFFICE IN MISSOULA.

(2) JOINT-USE ROAD APPROACH RELOCATIONS "RESTRICTED". (SEE LIMITED ACCESS RESOLUTION, SHEET NO. 1A.)

* CHAPMAN HILL ROAD ** REVISE APPROACH PER AS-BUILT INFORMATION SUPPLIED BY THE DISTRICT 1-5-98


REVISED-3-20-96
1-9-98
1-13-98

BACKSLOPE LIMITS INCLUDE ROUNDING CONSTRUCTION LIMITS TOP OF CUT TOE OF FILL	
MAP TRANS. TO R/W	5-9-91
MAP REVISED	6-5-94, 7-30-91, 11-23-91, 5-7-92, 8/3/92, 10/24/92, 6-9-93, 8-23-93, 5-21-94, 7-21-95
APPROVAL	2-19-91

STATE OF MONTANA
DEPARTMENT OF HIGHWAYS
LAND REQUIRED FOR RIGHT OF WAY
FLATHEAD COUNTY
SCALE 1"=100' MAP COMPLETED

OWNERSHIPS									
PARCEL	NAME	ADDRESS	TOTAL AREA	GROSS R/W AREA	P.T.W. AREA	AREA TO BE ACQUIRED	REMAINDER		CONST. PERM. AREA
							LEFT	RIGHT	
3	GEORGE DARROW			2.73 AC.	0.56 AC.	2.17 AC.			
8	FLATHEAD ELECTRIC CO-OPERATIVE, INC.	A MT CORP.	6452 SF	6452 SF	0	6452 SF			
9	FLOYD W. & SARAH COVERDELL TRUST			6.47 AC.	2.86 AC.	3.61 AC.			0.11 AC.
10	SKYE K. MARSHALL ETAL		2.59 AC.	0.07 AC.	0	0.07 AC.		2.52 AC.	
11	BEVERLY OSTROOD, ETAL			SEE SHEET	NO. 4				
12	JORGENSENS FAMILY TRUST NO. 1		1.49 AC.	0.39 AC.	0.10 AC.	0.29 AC.		1.10 AC.	
13	GORDON A. & LORNA NICHOLS		6.72 AC.	0.17 AC.	0	0.17 AC.		6.55 AC.	
14	VIOLET L. & GORDON ARTHUR NICHOLS			SEE SHEET	NO. 4				

STATE	PROJECT NO.	SHEET TOTAL
MONT.	F52-2(12)34	3 28
	CRESTON N & S	

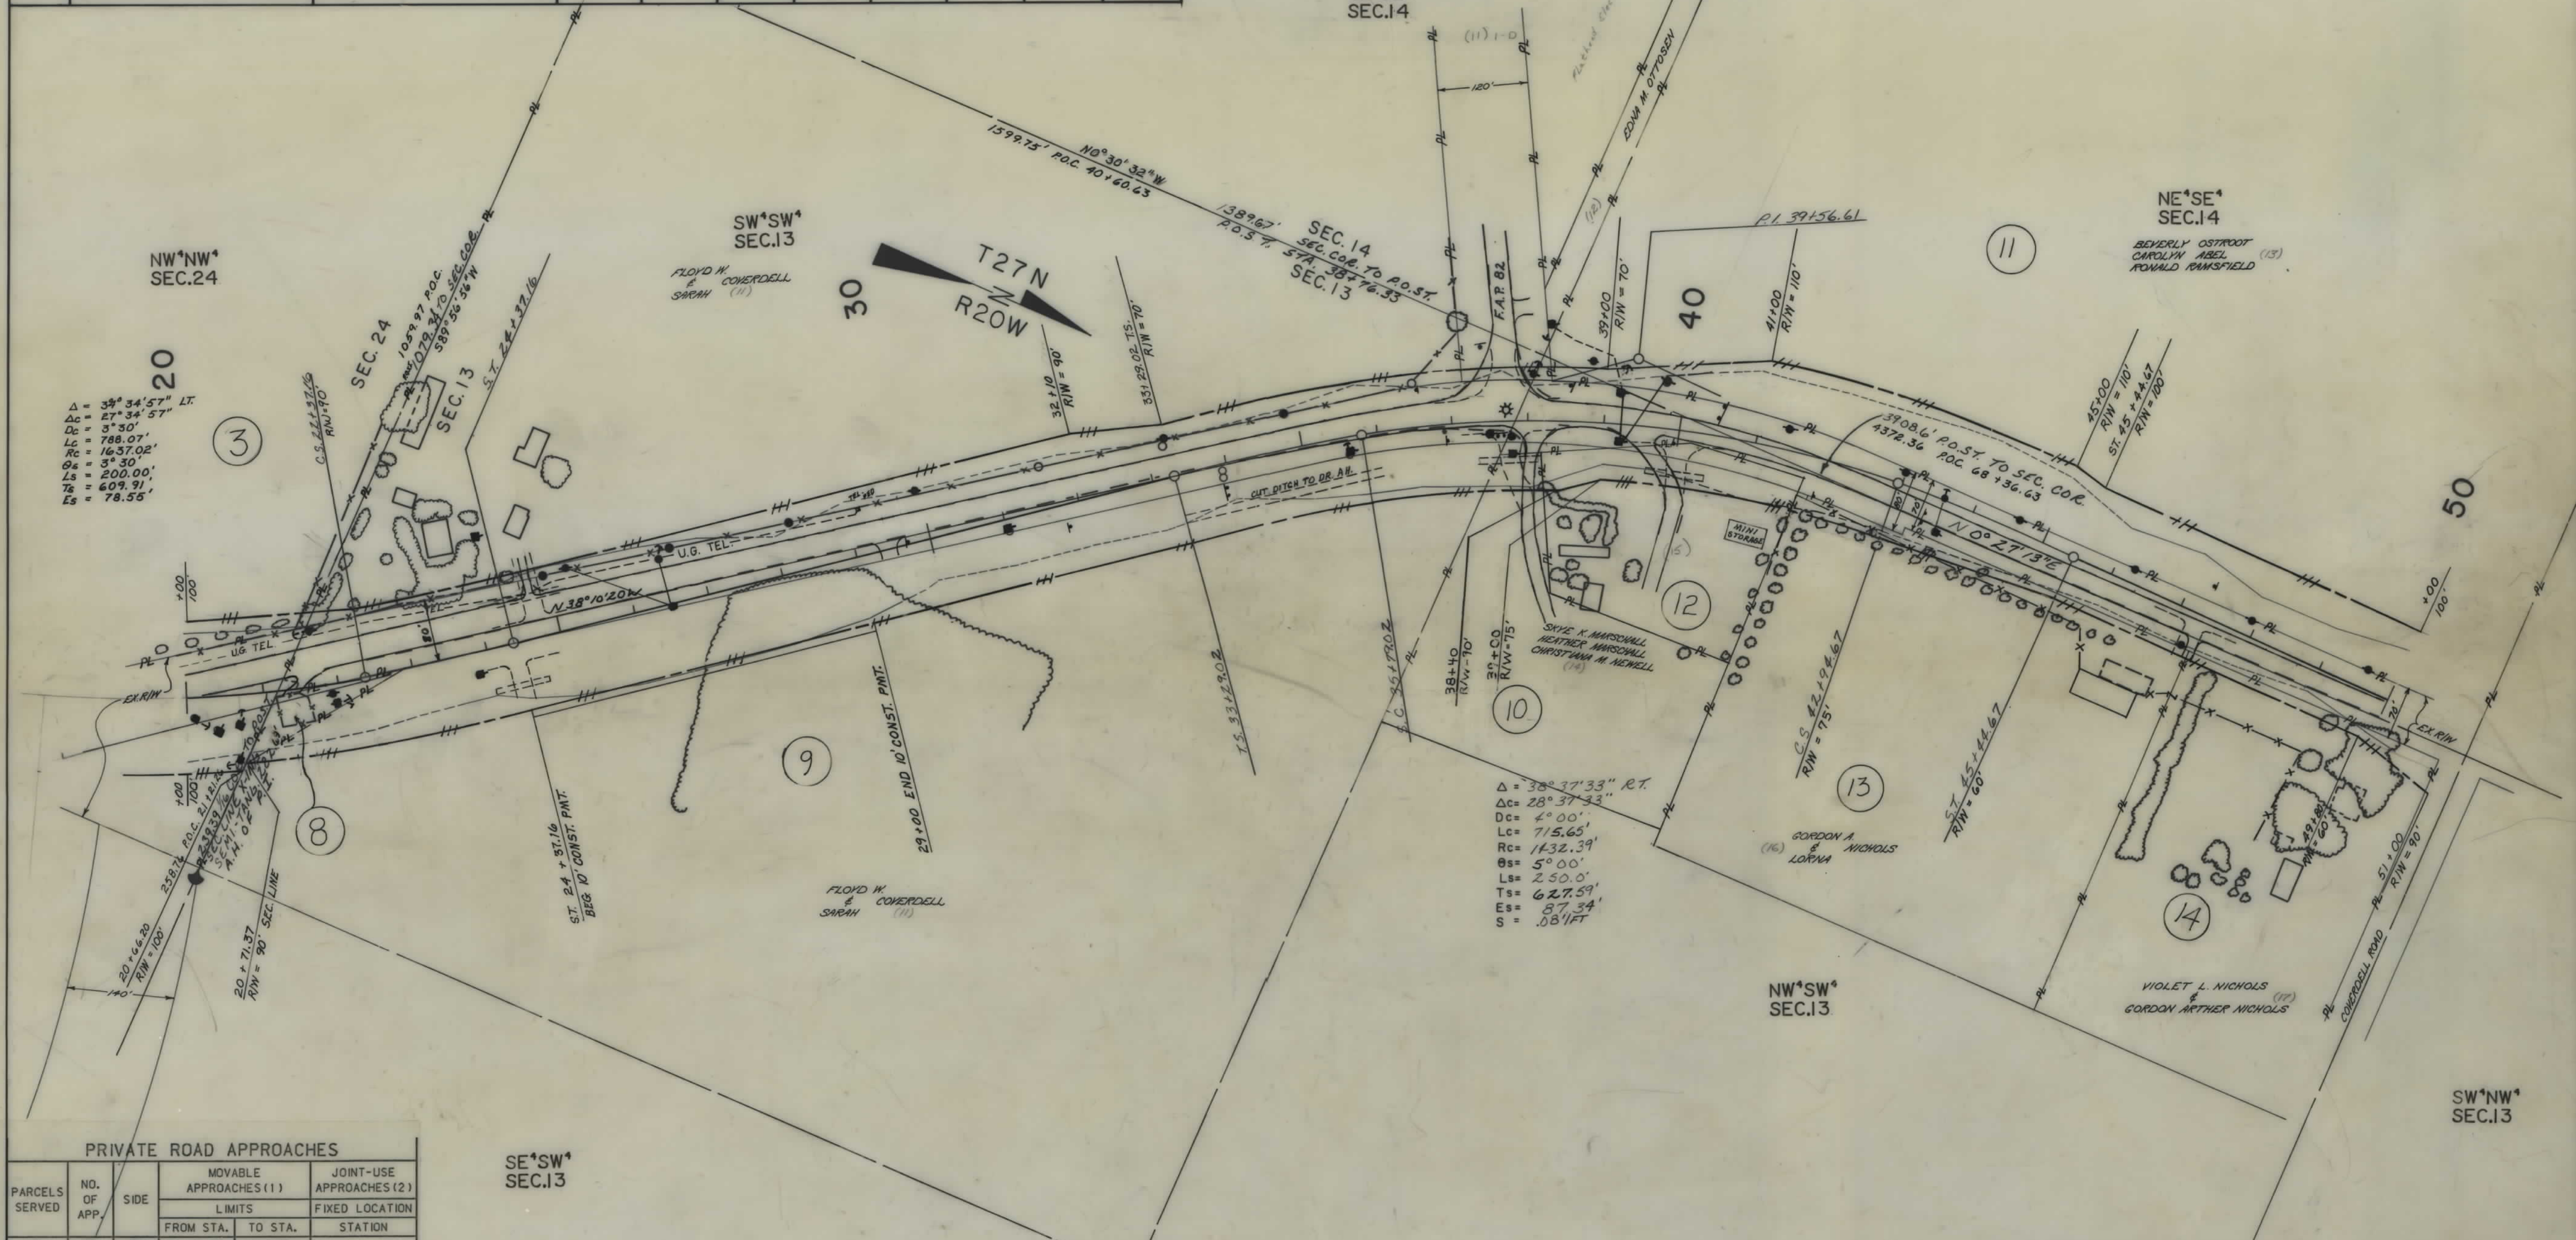

PRIVATE ROAD APPROACHES					
PARCELS SERVED	NO. OF APP.	SIDE	MOVABLE APPROACHES (1)		JOINT-USE APPROACHES (2)
			LIMITS	FIXED LOCATION	
			FROM STA.	TO STA.	STATION
9	2	RT	21+31.37	37+38	
9	2	LT	21+82	36+56	
10	1	RT	37+38	38+18	
12	1	RT	38+18	41+63	
13 & 14	1	RT			47+25

(1) MOVABLE ROAD APPROACHES MAY BE RELOCATED BETWEEN THE SPECIFIED STATIONS AFTER THE INITIAL CONSTRUCTION. BEFORE RECONSTRUCTION, A PERMIT MUST BE OBTAINED FROM THE MDOT OFFICE IN MISSOULA.

(2) JOINT-USE ROAD APPROACH RELOCATIONS "RESTRICTED". (SEE LIMITED ACCESS RESOLUTION, SHEET NO. 1A.)

BACKSLOPE LIMITS
INCLUDE ROUNDING
CONSTRUCTION LIMITS
TOP OF CUT
TOE OF FILL

STATE OF MONTANA
DEPARTMENT OF HIGHWAYS
LAND REQUIRED FOR RIGHT OF WAY
FLATHEAD COUNTY
SCALE 1"=100' MAP COMPLETED

MAP TRANS. TO R/W
MAP REVISED
APPROVAL

10-13-92 2-22-93 8-11-93
2-19-91 7-15-94

OWNERSHIPS											PRIVATE ROAD APPROACHES						STATE		PROJECT NO.		SHEET TOTAL	
PARCEL	NAME	ADDRESS	TOTAL AREA	GROSS R/W AREA	P.T.W. AREA	AREA TO BE ACQUIRED	REMAINDER		CONST. PERM. AREA	CONST. SEASE AREA	PARCELS SERVED	NO. OF APP.	SIDE	MOVABLE APPROACHES (1)		JOINT-USE APPROACHES (2)	NO.	SHEETS				
							LEFT	RIGHT						LIMITS		FIXED LOCATION						
														FROM STA.	TO STA.	STATION						
21	U.S.A. - FOREST SERVICE			0.96 AC.	0	0.96 AC.																
22	LAWRENCE O. & SERENA A. STREETER	CP Louis G. THIESEN		3.76 AC.	1.54 AC.	2.22 AC.																
23	THE BIGFORK CONGREGATION OF JEHOVANS WITNESSES		13560 SF	671 SF	0	671 SF	42889 SF															
24	E. VIRGINIA ROATH			5743 SF	0	5743 SF																
175	DANIEL W. & TERILYN HARDING			434 SF	0	434 SF																
25	"			8346 SF	0	8346 SF																
26	E. VICTORIA ROATH ETAL			0.31 AC.	0	0.31 AC.																
27	CROSSBOW CORPORATION, A MT CORP.			SEE SHEET	NO. 6																	
28	1ST BAPTIST CHURCH			51962 SF	0	51962 SF																
29	DON B. TORGERSON			10458 SF	0	10458 SF																
30	GERALD L. & SHIRLEY P. PARKER			16250 SF	0	16250 SF																
31	TERRY L. & ALETA ANN PARKER			SEE SHEET	NO. 6																	

(1) MOVABLE ROAD APPROACHES MAY BE RELOCATED BETWEEN THE SPECIFIED STATIONS AFTER THE INITIAL CONSTRUCTION. BEFORE RECONSTRUCTION, A PERMIT MUST BE OBTAINED FROM THE MDOT OFFICE IN MISSOULA.


(2) JOINT-USE ROAD APPROACH RELOCATIONS "RESTRICTED". (SEE LIMITED ACCESS RESOLUTION, SHEET NO. 1A.)

MONT.	F52-2(12)34	5	28
CRESTON N & S			

(1) MOVABLE ROAD APPROACHES MAY BE RELOCATED BETWEEN THE SPECIFIED STATIONS AFTER THE INITIAL CONSTRUCTION. BEFORE RECONSTRUCTION, A PERMIT MUST BE OBTAINED FROM THE MDOH OFFICE IN MISSOULA.

(2) JOINT-USE ROAD APPROACH RELOCATIONS "RESTRICTED". (SEE LIMITED ACCESS RESOLUTION, SHEET NO. 1A.)

STATE	PROJECT NO.	SHEET TOTAL
MONT.	F52-2(12)34	5 28
	CRESTON N & S	

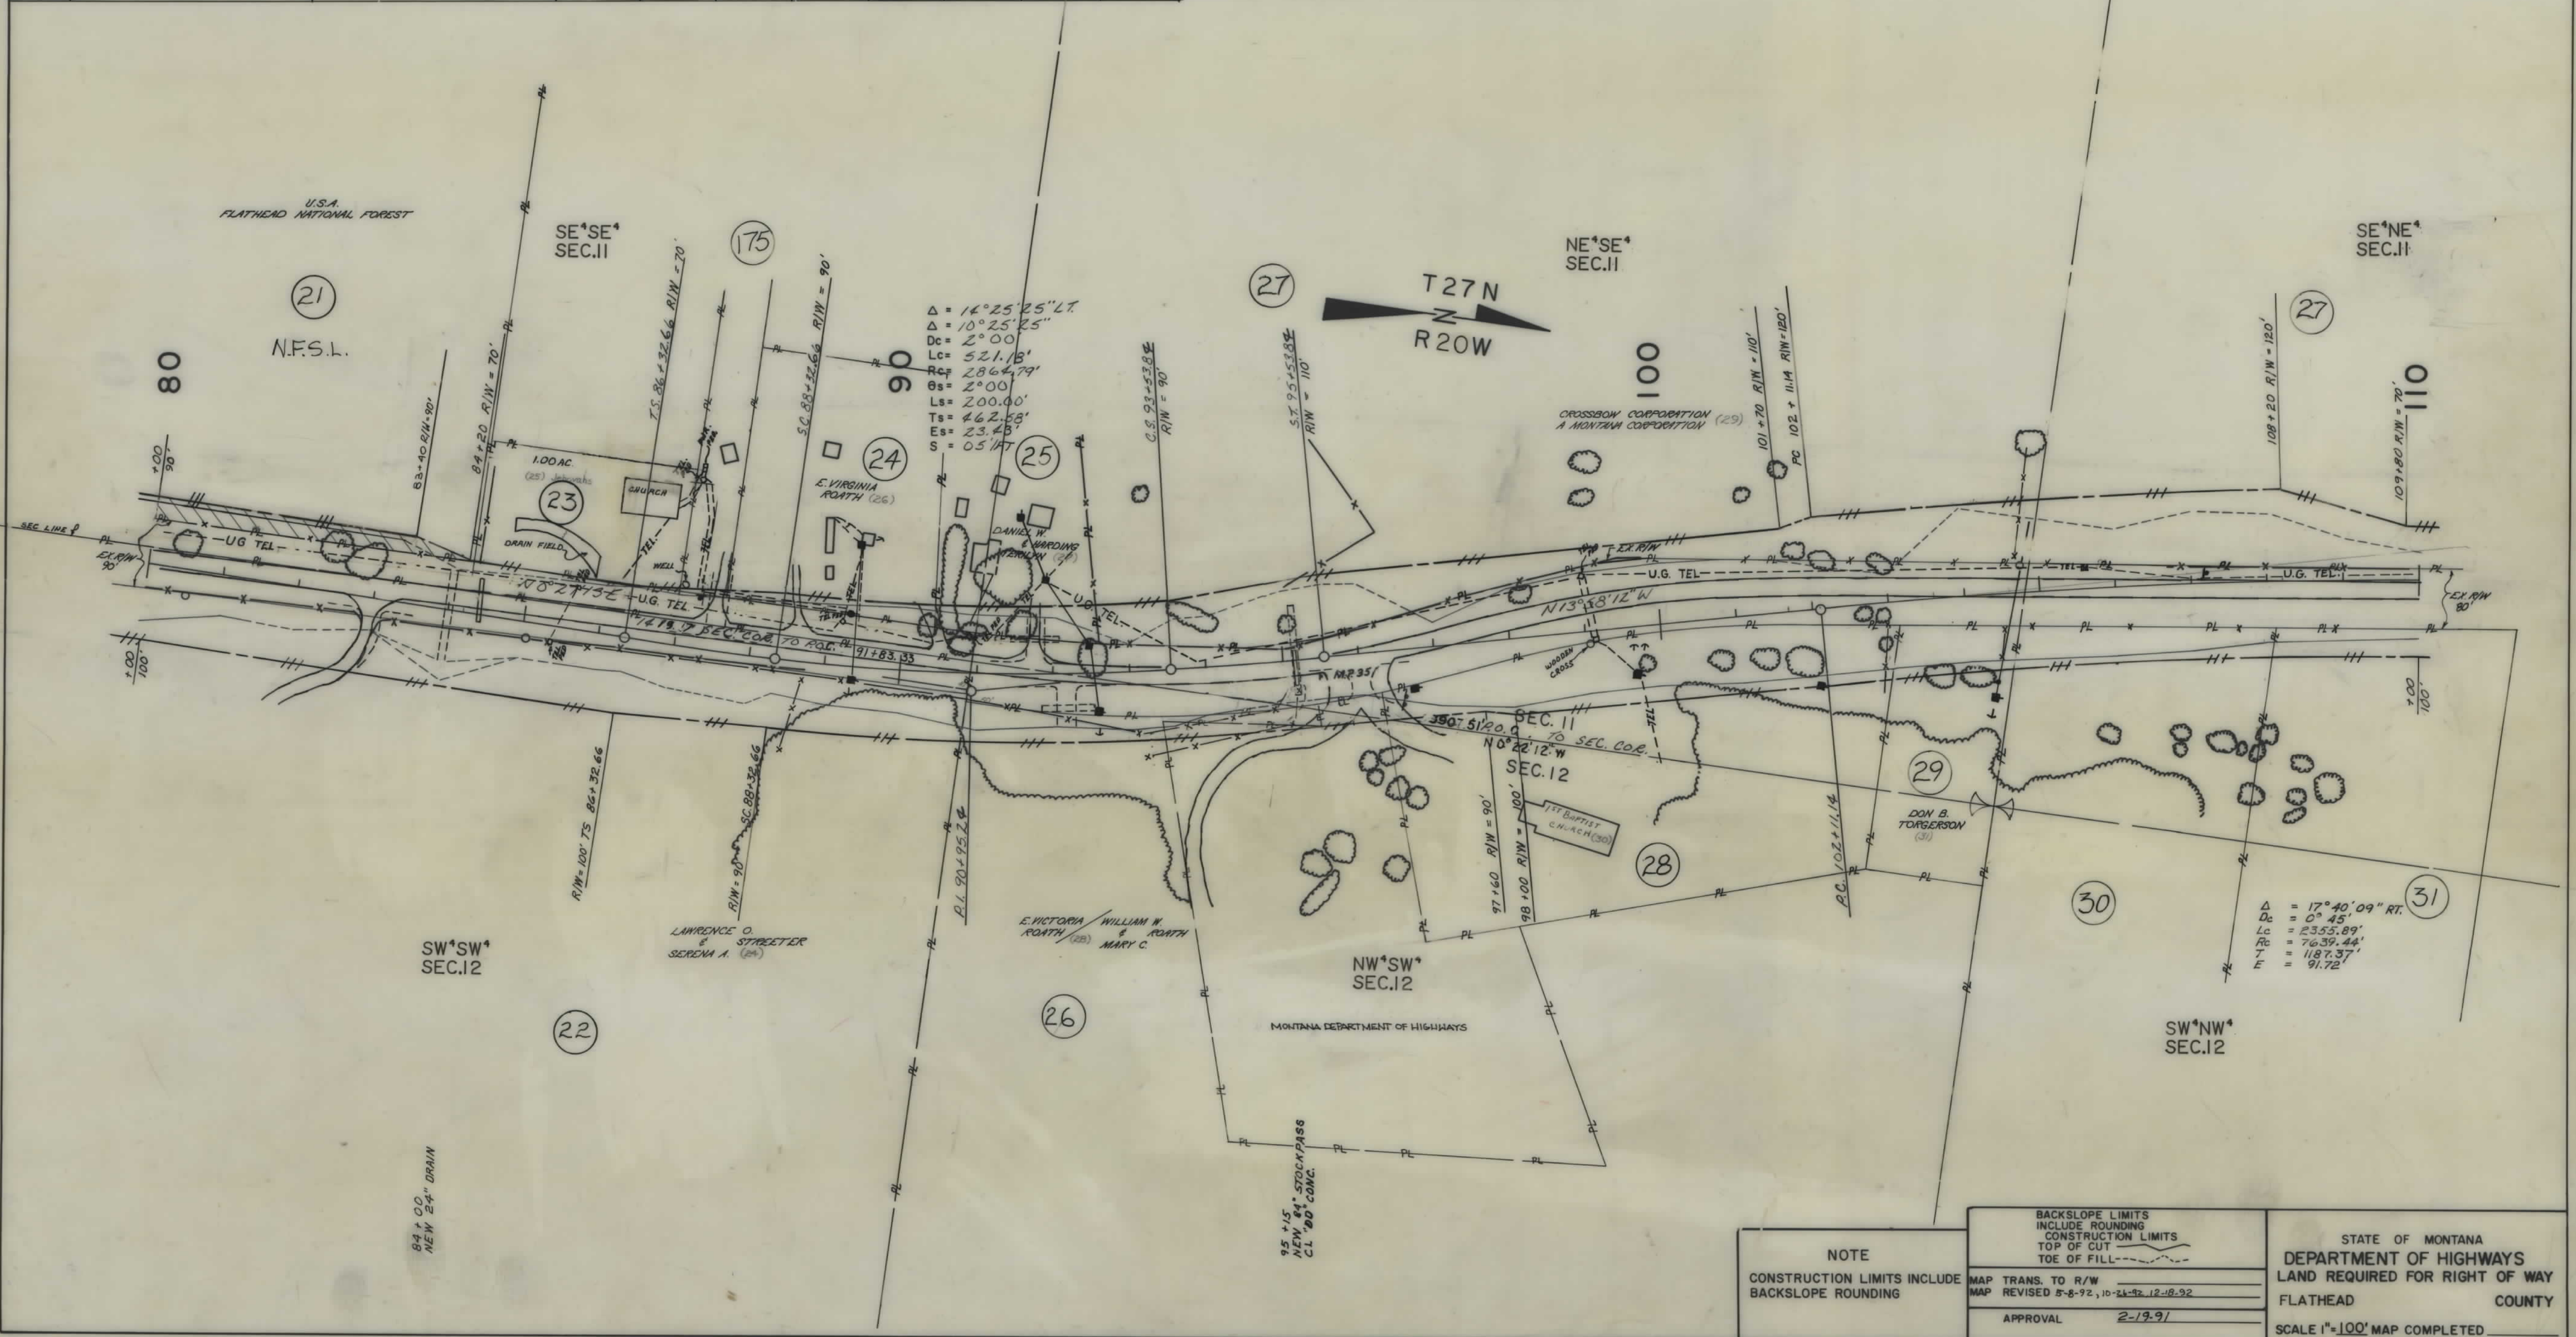

OWNERSHIPS									
PARCEL	NAME	ADDRESS	TOTAL AREA	GROSS R/W AREA	P.T.W. AREA	AREA TO BE ACQUIRED	REMAINDER		CONST. PERM. CONST. EASE AREA
							LEFT	RIGHT	
38	EUGENE & RUTH A. SULLIVAN			9.60 AC.	1.94 AC.	7.66 AC.			
39	ALBERT L. & HERMELINDA CHRISTIANSEN			2.784 SF.	0	2.784 SF.			
40	FLATHEAD COUNTY			7628 SF.	0	7628 SF.			
41	ALBERT L. & HERMELINDA CHRISTIANSEN			9280 SF.	0	9280 SF.			
42	DELETED								
43	ALBERT L. & HERMELINDA CHRISTIANSEN		196,020 SF.	31892 SF.	0	31892 SF.	164128 SF.		
44	CLARA A. FOX, ET AL.			SEE SHEET NO. 10					


PRIVATE ROAD APPROACHES					
PARCELS SERVED	NO. OF APP.	SIDE	MOVABLE APPROACHES (1)		JOINT-USE APPROACHES (2)
			LIMITS		FIXED LOCATION
			FROM STA.	TO STA.	
39	2	RT	145+40	152+30	
41, 40	1	RT			155+25
44	1	LT	160+60	176+50	
38	1	LT	131+80	158+10	
40	1	RT	152+50	152+75	
43	1	LT	158+20	160+60	

(1) MOVABLE ROAD APPROACHES MAY BE RELOCATED BETWEEN THE SPECIFIED STATIONS AFTER THE INITIAL CONSTRUCTION. BEFORE RECONSTRUCTION, A PERMIT MUST BE OBTAINED FROM THE MDOT OFFICE IN MISSOULA.

(2) JOINT-USE ROAD APPROACH RELOCATIONS "RESTRICTED". (SEE LIMITED ACCESS RESOLUTION, SHEET NO. 1A.)

STATE	PROJECT NO.	SHEET NO.	TOTAL SHEETS
MONT.	F52-2(12)34	7	28

CRESTON N & S

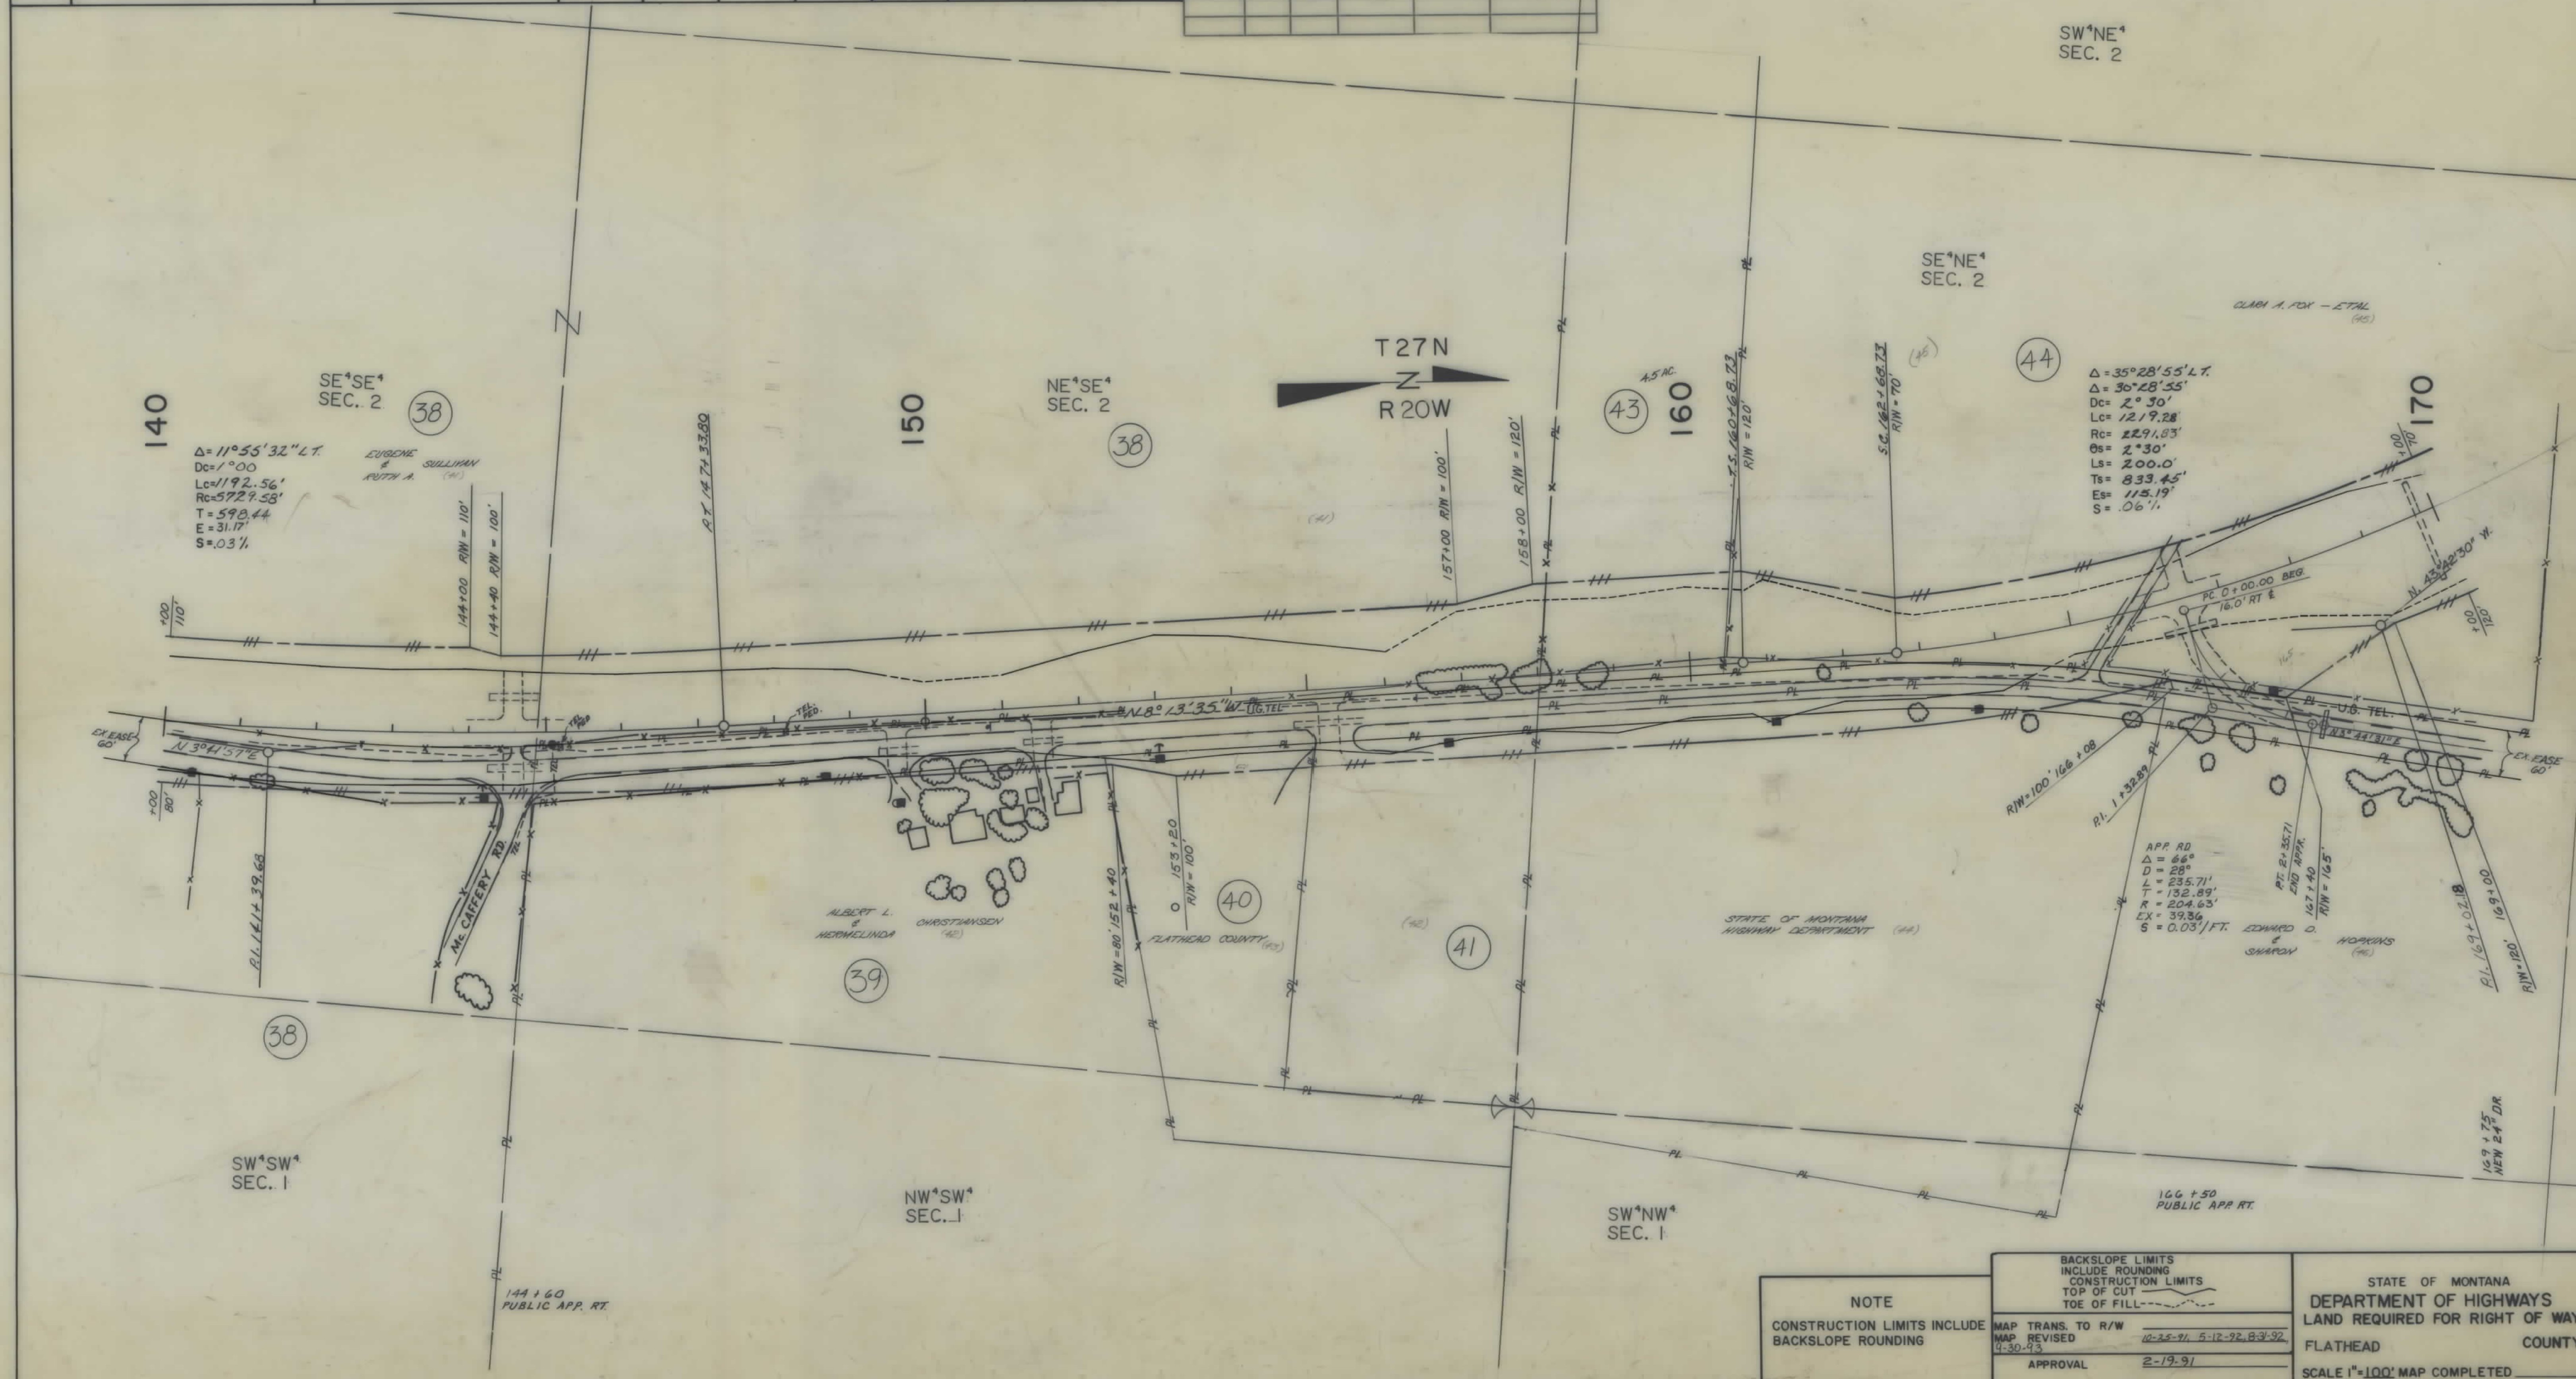

NOTE
CONSTRUCTION LIMITS INCLUDE
BACKSLOPE ROUNDING

BACKSLOPE LIMITS INCLUDE ROUNDING CONSTRUCTION LIMITS TOP OF CUT TOE OF FILL	
MAP TRANS. TO R/W	12-25-91, 5-12-92, 8-3-92
MAP REVISED	4-30-93
APPROVAL	2-19-91

STATE OF MONTANA
DEPARTMENT OF HIGHWAYS
LAND REQUIRED FOR RIGHT OF WAY
FLATHEAD COUNTY
SCALE 1"=100' MAP COMPLETED

OWNERSHIPS									
PARCEL	NAME	ADDRESS	TOTAL AREA	GROSS R/W AREA	P.T.W. AREA	AREA TO BE ACQUIRED	REMAINDER LEFT	REMAINDER RIGHT	CONST. PERM. CONSTEASE AREA
44	CLARA A. FOX - ET AL			4.36 AC.	0	4.36 AC.		1.15 AC.	
45	WILLIAM F. & M. LOUISE AMBROSE			2.35 AC.	0	2.35 AC.	0.86 AC.		
46	VERNON J. & SHARON L. CORNELIUSON			1.41 AC.	0	1.41 AC.		0.06 AC.	
47	WILLIAM F. & M. LOUISE AMBROSE			2.18 AC.	0	2.18 AC.	0.44 AC.		
48	VERNON J. & SHARON L. CORNELIUSON			0.13 AC.	0	0.13 AC.		0.09 AC.	
49	WILLIAM F. & M. LOUISE AMBROSE			2.64 SF	0	2.64 SF			
50	WILLIAM F. & M. LOUISE AMBROSE			0.27 AC.	0	0.27 AC.	0.08 AC.		
51	WILLIAM F. & M. LOUISE AMBROSE			2.40 AC.	0.18 AC.	2.22 AC.		0.39 AC.	
52	NIELS H. FAUERSO			65,150 SF	8441 SF	0	8441 SF	56,709 SF	
53	WALDO K. & HILDE D. SOLOVAR			20.057 AC.	0.30 AC.	0	0.30 AC.	19.757 AC.	
54	NIELS H. FAUERSO, ET AL			SEE SHEET NO. 9					


PRIVATE ROAD APPROACHES					
PARCELS SERVED	NO. OF APP.	SIDE	MOVABLE APPROACHES (1) LIMITS FROM STA. TO STA.	JOINT-USE APPROACHES (2) FIXED LOCATION STATION	
45, 46	1	LT.		176+60	
48, 49, 51	1	LT.		184+50	

(1) MOVABLE ROAD APPROACHES MAY BE RELOCATED BETWEEN THE SPECIFIED STATIONS AFTER THE INITIAL CONSTRUCTION. BEFORE RECONSTRUCTION, A PERMIT MUST BE OBTAINED FROM THE MOH OFFICE IN MISSOULA.

(2) JOINT-USE ROAD APPROACH RELOCATIONS "RESTRICTED". (SEE LIMITED ACCESS RESOLUTION, SHEET NO. 1A.)

STATE	PROJECT NO.	SHEET TOTAL NO.	TOTAL SHEETS
MONT.	F52-2(12)34	8	28

CRESTON N & S

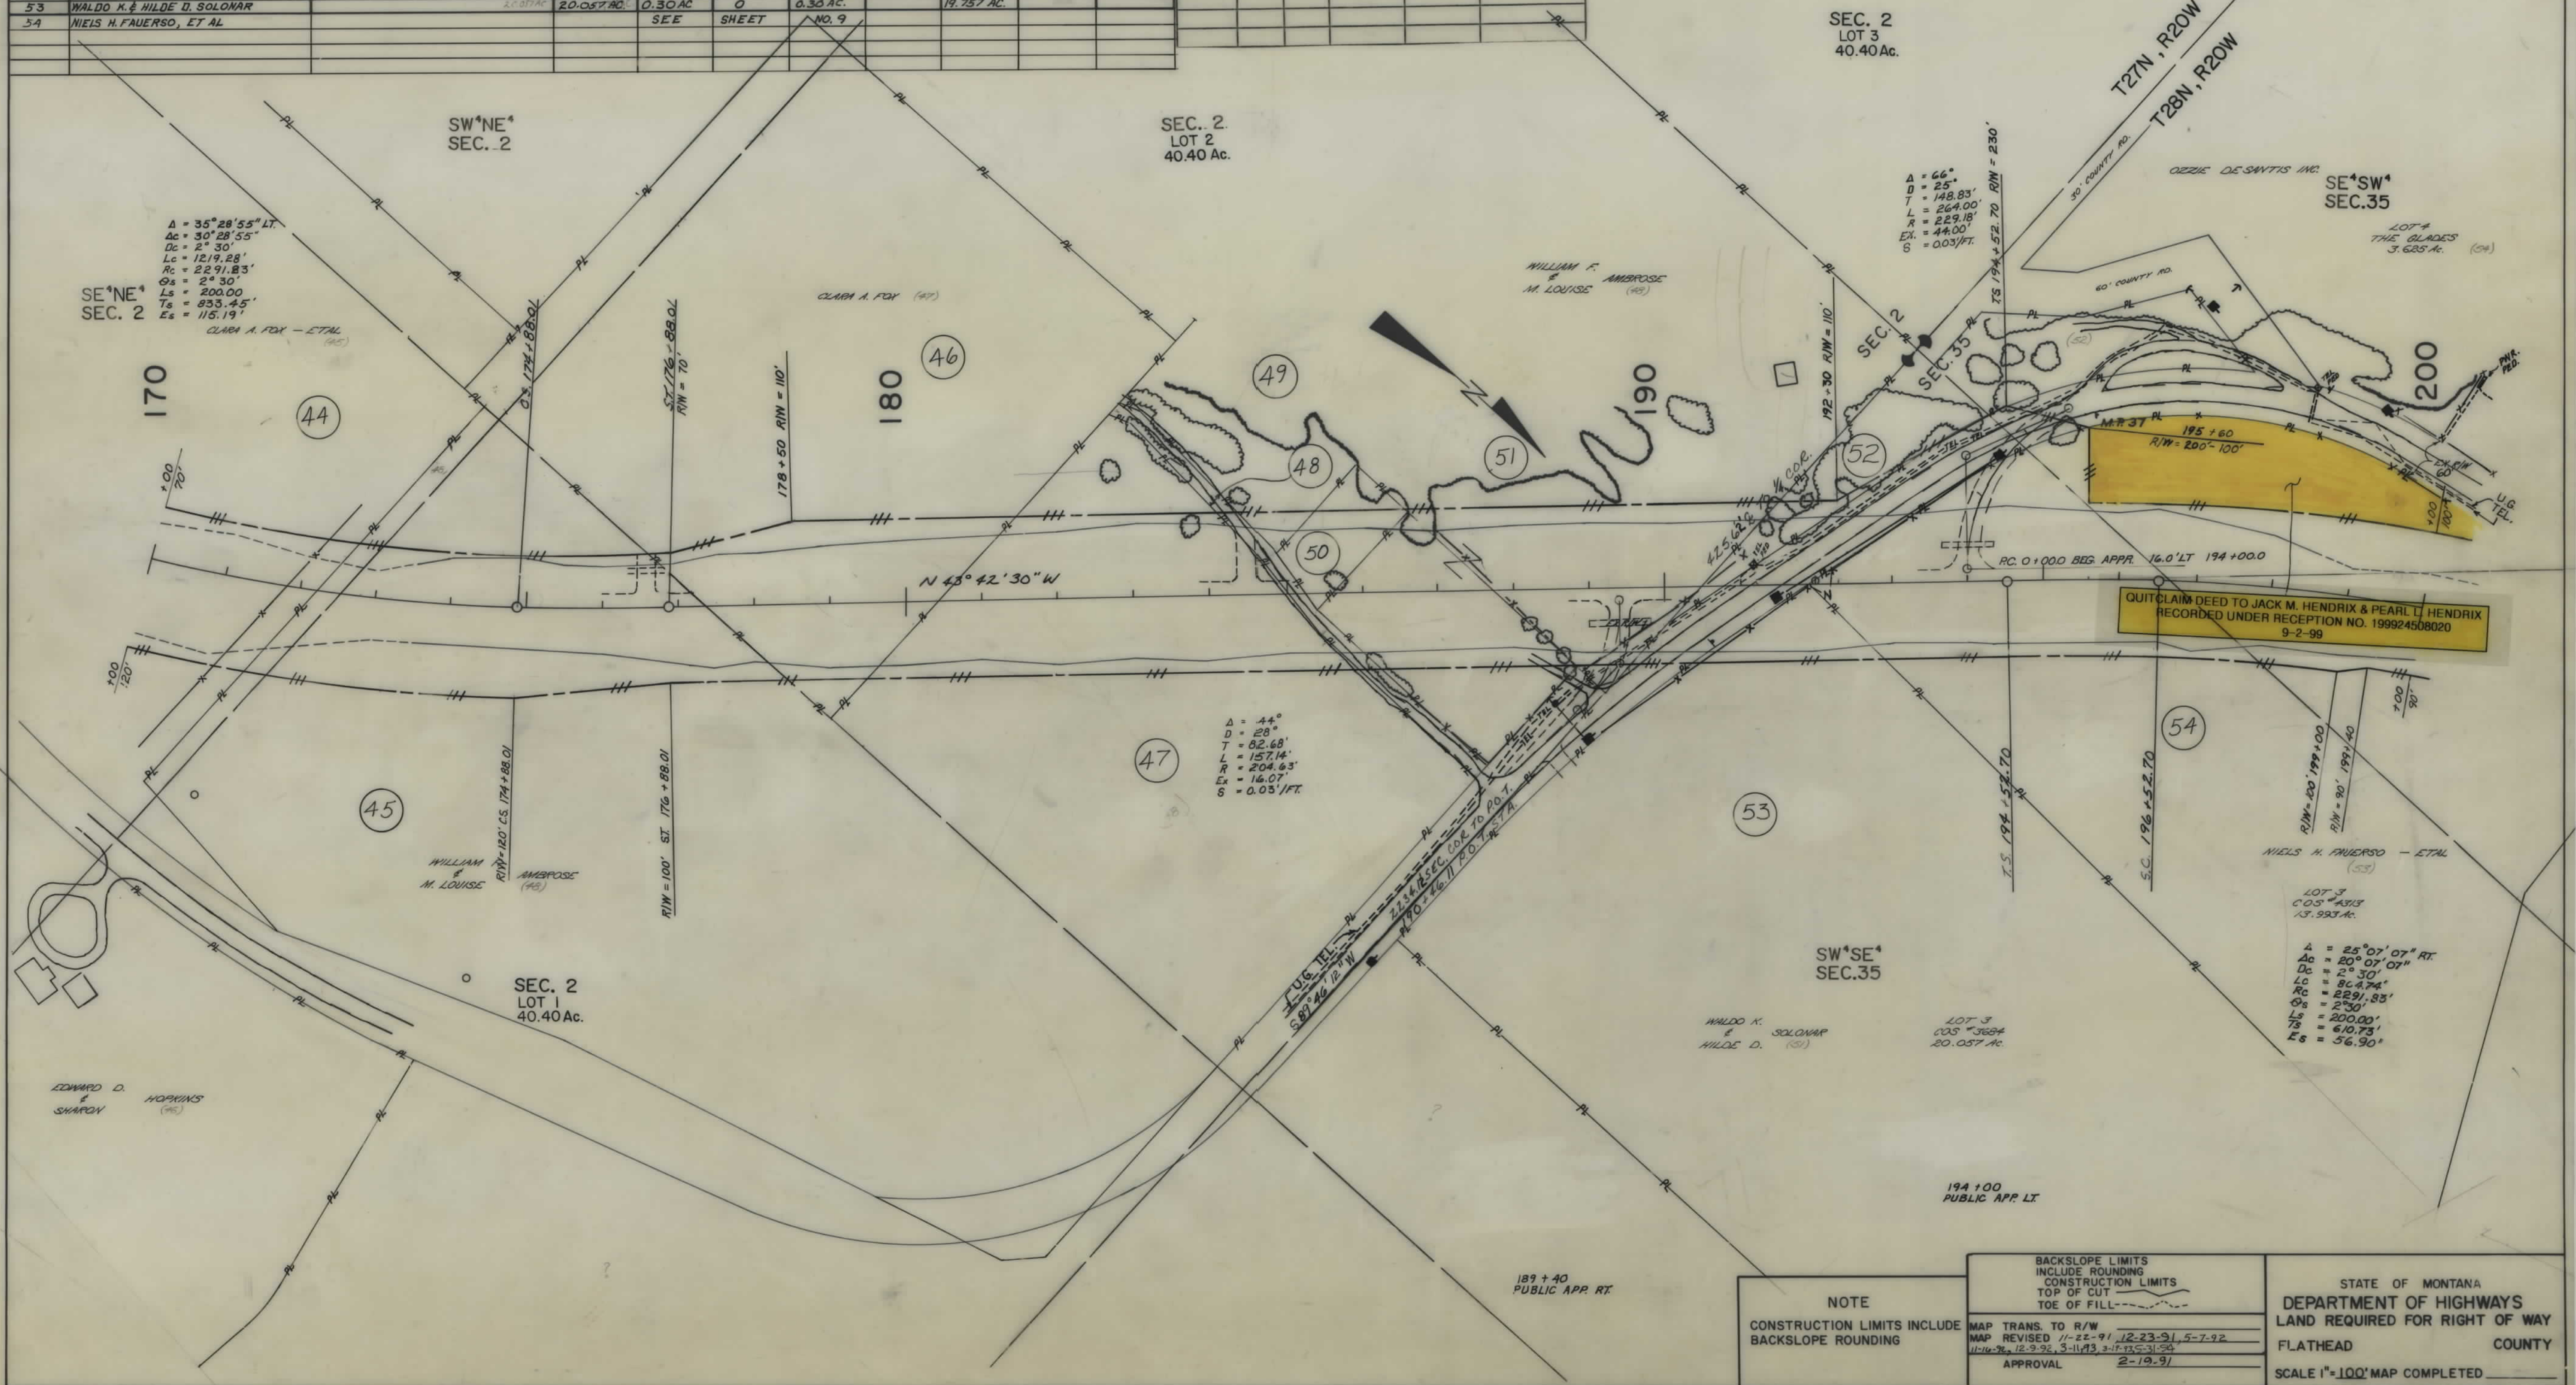

NOTE

CONSTRUCTION LIMITS INCLUDE BACKSLOPE ROUNDING

BACKSLOPE LIMITS INCLUDE ROUNDING CONSTRUCTION LIMITS TOP OF CUT TOE OF FILL

MAP TRANS. TO R/W 11-22-91 12-23-91 5-7-92 11-16-92 12-9-92 3-11-93 3-11-93 3-11-93


APPROVAL 2-19-91

STATE OF MONTANA
DEPARTMENT OF HIGHWAYS
LAND REQUIRED FOR RIGHT OF WAY
FLATHEAD COUNTY

SCALE 1" = 100' MAP COMPLETED

(1) MOVABLE ROAD APPROACHES MAY BE RELOCATED BETWEEN THE SPECIFIED STATIONS AFTER THE INITIAL CONSTRUCTION. BEFORE RECONSTRUCTION, A PERMIT MUST BE OBTAINED FROM THE MDOT OFFICE IN MISSOULA

(2) JOINT-USE ROAD APPROACH RELOCATIONS "RESTRICTED". (SEE LIMITED ACCESS RESOLUTION, SHEET NO. 1A.)

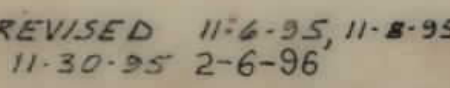

BACKSLOPE LIMITS
INCLUDE ROUNDING
CONSTRUCTION LIMITS
TOP OF CUT
TOE OF FILL

MAP TRANS. TO R/W
MAP REVISED
5-12-92, 8-31-92, 10-26-92, 12-23-91, 1-24-92, 2-4-92, 3-27-92, 1-11-95, 8-8-95
APPROVAL 2-19-91

STATE OF MONTANA
DEPARTMENT OF HIGHWAYS
LAND REQUIRED FOR RIGHT OF WAY
FLATHEAD COUNTY
SCALE 1"=100' MAP COMPLETED _____

OWNERSHIPS											PRIVATE ROAD APPROACHES					STATE	PROJECT NO.	SHEET TOTAL	
PARCEL	NAME	ADDRESS	TOTAL AREA	GROSS R/W AREA	P.T.W. AREA	AREA TO BE ACQUIRED	REMAINDER		CONST. PERM. AREA	EASE AREA	PARCELS SERVED	NO. OF APP.	SIDE	MOVABLE APPROACHES (1) LIMITS FROM STA. TO STA.	JOINT-USE APPROACHES (2) FIXED LOCATION STATION	MONT.	F52-2(12)34	12	28
65	SHEILA C. BUCK			4.11 AC	0	4.11 AC													
67	STEPHEN J. & SHERI NICHOLLS			1.01 AC	0	1.01 AC													
68	MARY A. BENSON			0.16 AC	0	0.16 AC													
69	JAMES J. & MARTI JO CLOUSE			2.60 AC	0.68 AC	1.92 AC			0.06 AC		67 & 68	1	RT		289+60				
70	JAMES J. & MARTI JO CLOUSE					SEE SHEET NO. 13													
71	ALBERT C. & RUTH A. TEDRICK			"ACCESS CONTROL ONLY"															
72	JOHN D. & EMALYN C. TEDRICK, et al			3.87 AC	1.67 AC	2.20 AC	0.09 AC				68 & 69	1	RT	280+06 298+65	294+75				
73	EILLEN R. CLOUSE					SEE SHEET NO. 13													
68.1	MARY A. BENSON & LLOYD E. MATHWIG	4 LLOYD E. MATHWIG		0.05 AC	0	0.05 AC													


(1) MOVABLE ROAD APPROACHES MAY BE RELOCATED BETWEEN THE SPECIFIED STATIONS AFTER THE INITIAL CONSTRUCTION. BEFORE RECONSTRUCTION, A PERMIT MUST BE OBTAINED FROM THE MDOT OFFICE IN MISSOULA

(2) JOINT-USE ROAD APPROACH RELOCATIONS "RESTRICTED". (SEE LIMITED ACCESS RESOLUTION, SHEET NO. 1A.)

CRESTON N & S

(1) MOVABLE ROAD APPROACHES MAY BE RELOCATED BETWEEN THE SPECIFIED STATIONS AFTER THE INITIAL CONSTRUCTION. BEFORE RECONSTRUCTION, A PERMIT MUST BE OBTAINED FROM THE MDOH OFFICE IN MISSOULA

(2) JOINT-USE ROAD APPROACH RELOCATIONS "RESTRICTED". (SEE LIMITED ACCESS RESOLUTION, SHEET NO. 1A.)

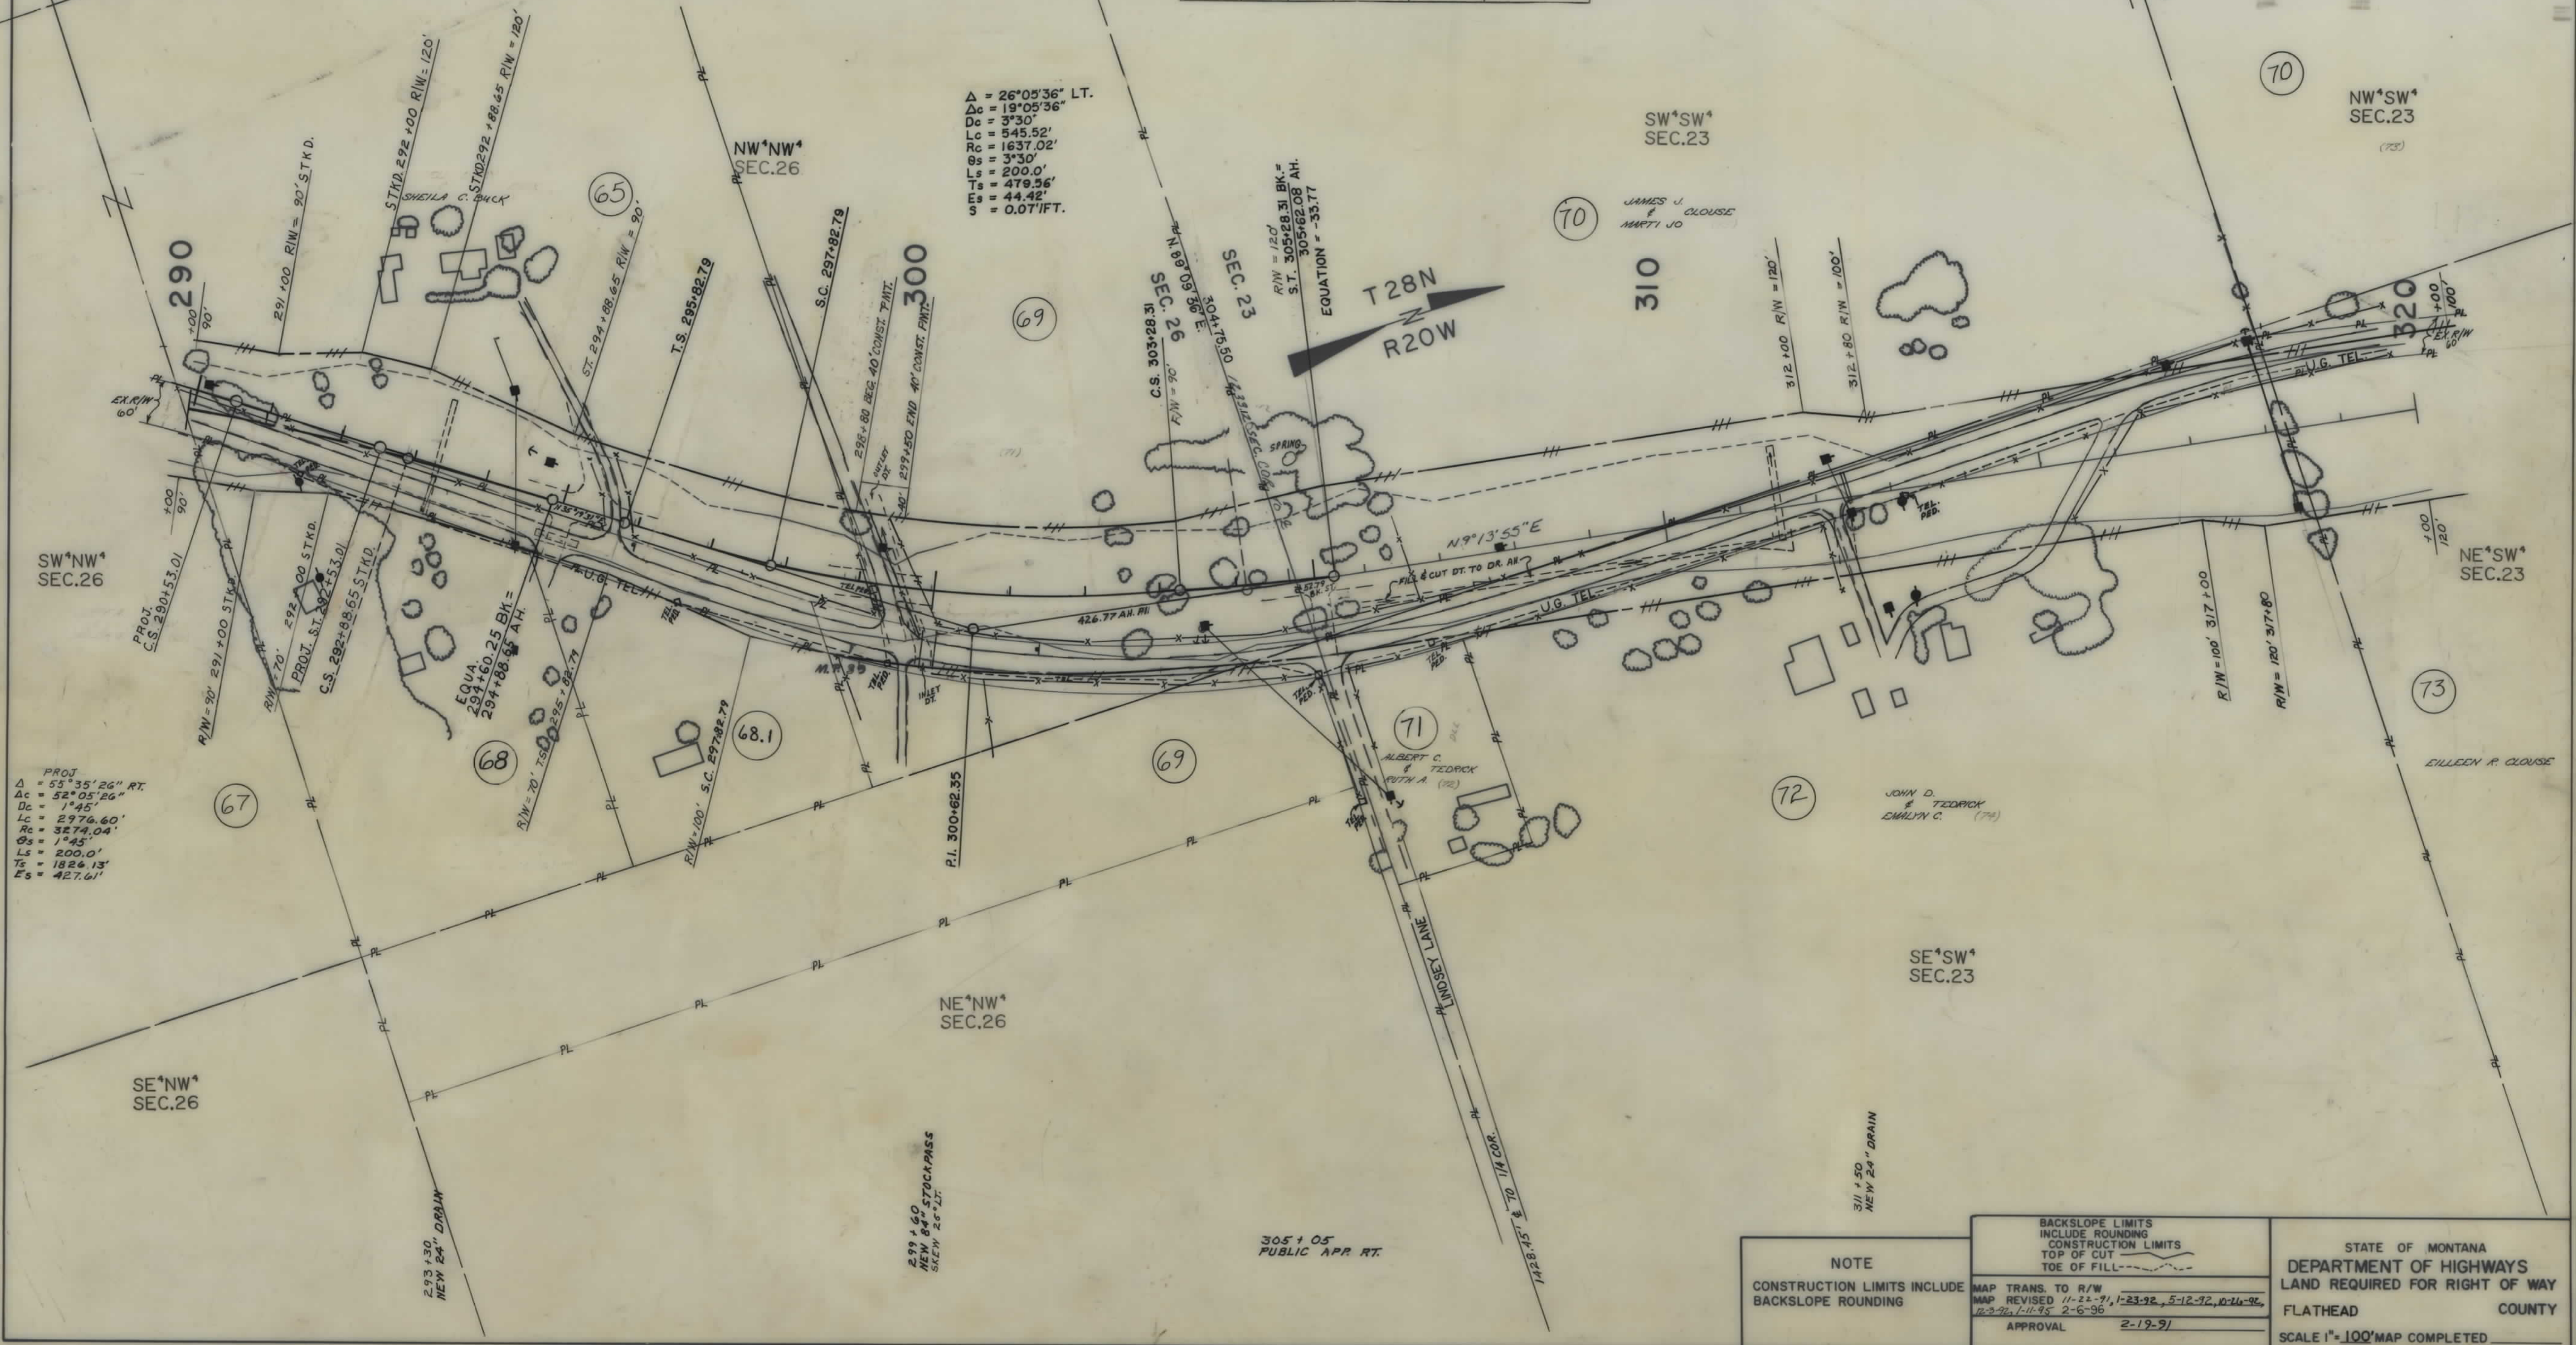

NOTE

CONSTRUCTION LIMITS INCLUDE BACKSLOPE ROUNDING

BACKSLOPE LIMITS INCLUDE ROUNDING

CONSTRUCTION LIMITS TOP OF CUT TOE OF FILL

MAP TRANS. TO R/W

MAP REVISED 11-22-91, 1-23-92, 5-12-92, 10-16-92, 12-3-92, 1-11-95

2-6-96

APPROVAL

2-19-91

STATE OF MONTANA

DEPARTMENT OF HIGHWAYS

LAND REQUIRED FOR RIGHT OF WAY

FLATHEAD COUNTY

SCALE 1"=100' MAP COMPLETED

OWNERSHIPS									
PARCEL	NAME	ADDRESS	TOTAL AREA	GROSS R/W AREA	P.T.W. AREA	AREA TO BE ACQUIRED	REMAINDER		EASE
70	JAMES J. & MARTI JO CLOUSE			3.12 AC.	0	3.12 AC.	LEFT	RIGHT	CONST. PERM. AREA
73	EILEEN R. CLOUSE			3.65 AC.	0	3.65 AC.			0.10 AC.
75	CRESTON CEMETERY ASS.		2.30 AC.	0.29 AC.	0	0.29 AC.		2.01 AC.	
74	EVA W. BUCK			5.49 AC.	1.78 AC.	3.71 AC.			
76	STATE OF MONTANA			0.53 AC.	0.18 AC.	0.37 AC.			
77	LUTHER G. & GERALDINE A. WACHNOLZ			SEE	SHEET	NO. 14			
78	FRANCES L. BALTUSH C/P JACK D. & DONNA L. PAULSON			"	"	"			
70.1	RICK R. & CHRISTINA E. SHEA			NEGOTIATION ACCESS		CONTROL ONLY			


PRIVATE ROAD APPROACHES					
PARCELS SERVED	NO. OF APP.	SIDE	MOVABLE APPROACHES (1)	JOINT-USE APPROACHES (2)	
			LIMITS	FROM STA.	TO STA.
				STATION	
70	1	LT	304+60	324+90	
73	1	RT	318+50	331+50	
74	*3	LT	331+70	348+40	
76	1	RT	344+85	347+25	
75	1	RT	331+70	334+15	
74	*2	RT	334+50	344+50	
70.1	1	LT	324+90	331+60	

(1) MOVABLE ROAD APPROACHES MAY BE RELOCATED BETWEEN THE SPECIFIED STATIONS AFTER THE INITIAL CONSTRUCTION. BEFORE RECONSTRUCTION, A PERMIT MUST BE OBTAINED FROM THE MDH OFFICE IN MISSOULA

(2) JOINT-USE ROAD APPROACH RELOCATIONS "RESTRICTED". (SEE LIMITED ACCESS RESOLUTION, SHEET NO. 1A.)

STATE	PROJECT NO.	SHEET TOTAL	
MONT.	F52-21(12)34	13	28
	CRESTON N & S		

* INCLUDES 1 FUTURE

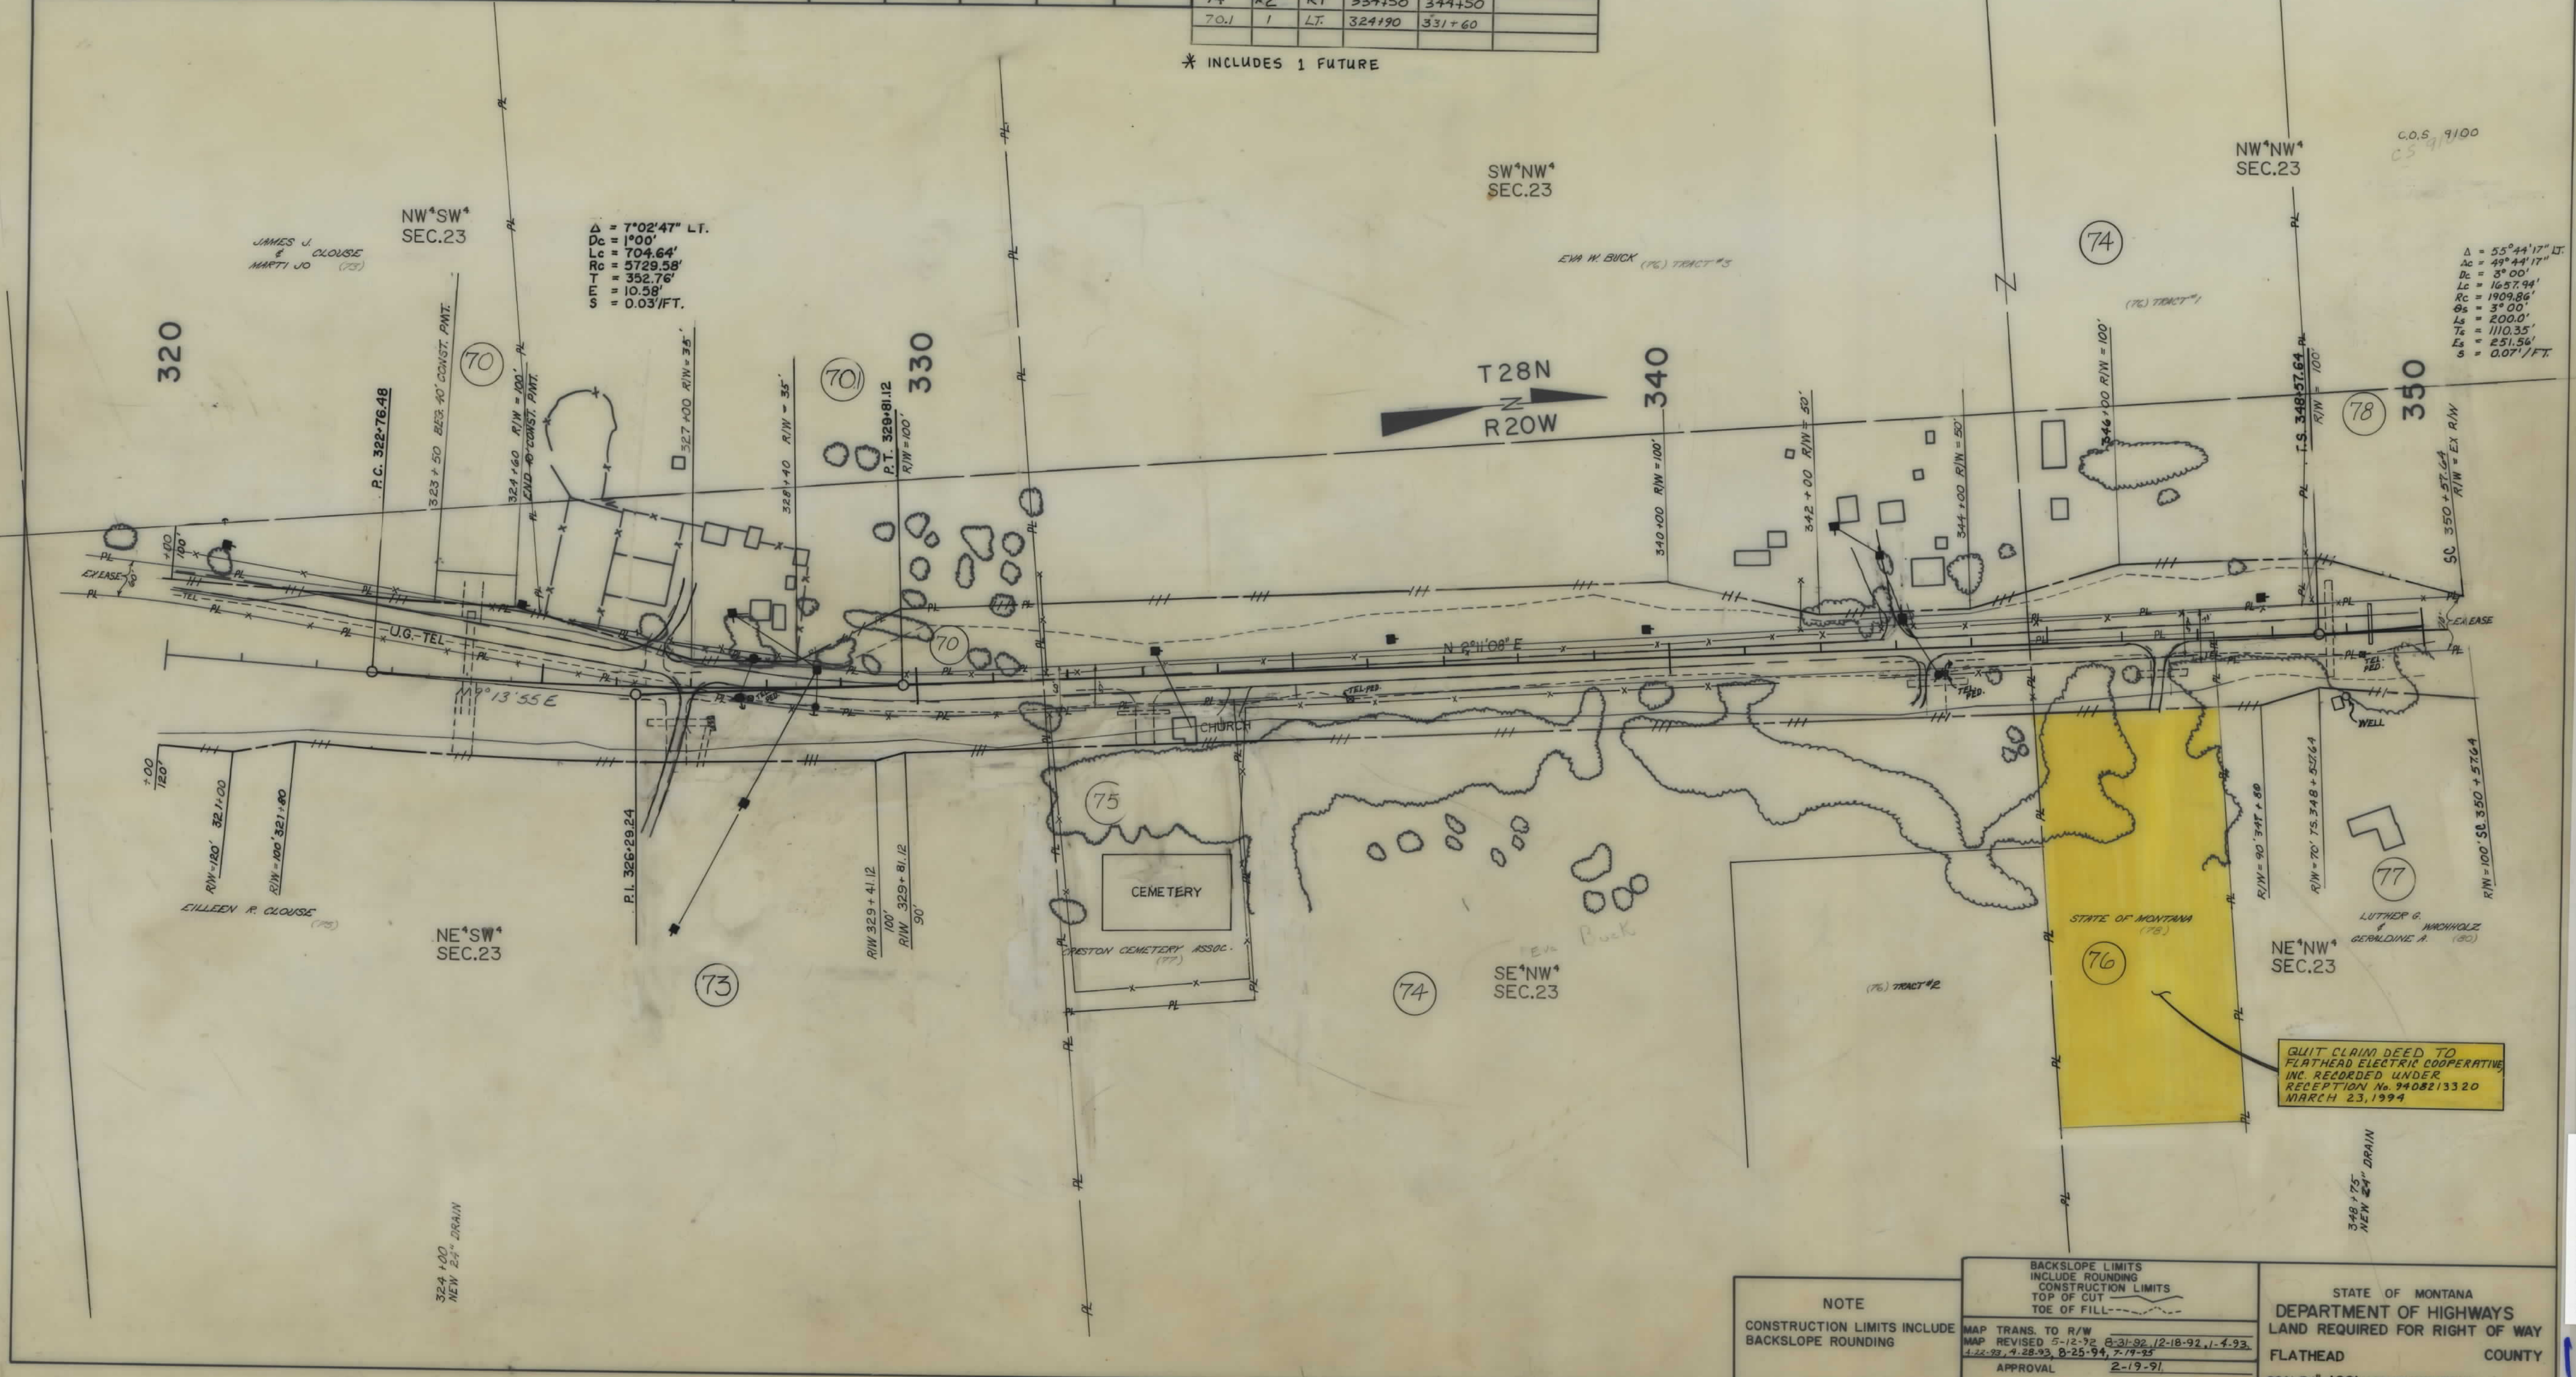

NOTE

CONSTRUCTION LIMITS INCLUDE BACKSLOPE ROUNDING

BACKSLOPE LIMITS INCLUDE ROUNDING CONSTRUCTION LIMITS TOP OF CUT TOE OF FILL

MAP TRANS. TO R/W MAP REVISED 5-12-92 8-31-92 12-18-92 1-4-93 4-22-93 4-28-93 8-25-94 7-19-95

APPROVAL 2-19-91

STATE OF MONTANA DEPARTMENT OF HIGHWAYS LAND REQUIRED FOR RIGHT OF WAY FLATHEAD COUNTY

SCALE 1"=100' MAP COMPLETED


OWNERSHIPS									
PARCEL	NAME	ADDRESS	TOTAL AREA	GROSS R/W AREA	P.T.W. AREA	AREA TO BE ACQUIRED	REMAINDER		TEMP EASE AREA
							LEFT	RIGHT	CONSTEASE AREA
77	LUTHER G. & GERALDINE A. WACHNOLZ			0.78 AC.	0	0.78 AC.			
78	FRANCES L. BALTRUSCH C/P	JACK O. & DONNA L. PAULSON		0.16 AC.	0	0.16 AC.			
79	FRED O. & RUTH BROEDER			0.66 AC.	0	0.66 AC.	0.48 AC.	1.56 AC.	
80	MERVYN M. PRICE & BETTY J. MACDAVID		5.497 AC.	0.916 AC.	0	0.916 AC.		4.518 AC.	
81	JAMES B. & MARCIA L. PORTER		5.385 AC.	0.379 AC.	0	0.379 AC.		5.006 AC.	
82	FRANCES L. BALTRUSCH	KENNETH T. MARVIN		SEE SHEET		NO. 15			
83	"	DOROTHY MAE HARTSOCH		0.30 AC.	0	0.30 AC.			
84	ROBERT H. & ROWENA M. GATISS			SEE SHEET		NO. 15			
83.1	DAVID P. & ROSE E. KINNEY		ACQUISITION	OF ACCESS	RIGHTS ONLY				
78.1	"	"		0.01 AC.	0	0.01 AC.	0.08 AC.		

PRIVATE ROAD APPROACHES					
PARCELS SERVED	NO. OF APP.	SIDE	MOVABLE APPROACHES (1)		JOINT-USE APPROACHES (2)
			LIMITS		FIXED LOCATION STATION
			FROM STA.	TO STA.	
77	1	RT.	347+35	353+11	
78	3	LT.	348+40	358+40	
82	1	RT.	366+00	380+10	
81	1	RT.	360+85	362+80	

(1) MOVABLE ROAD APPROACHES MAY BE RELOCATED BETWEEN THE SPECIFIED STATIONS AFTER THE INITIAL CONSTRUCTION. BEFORE RECONSTRUCTION, A PERMIT MUST BE OBTAINED FROM THE MOOH OFFICE IN MISSOULA

(2) JOINT-USE ROAD APPROACH RELOCATIONS "RESTRICTED". (SEE LIMITED ACCESS RESOLUTION, SHEET NO. 1A.)

STATE	PROJECT NO.	SHEET NO.	TOTAL SHEETS
MONT.	F52-2(12)34	14	28
CRESTON N & S			

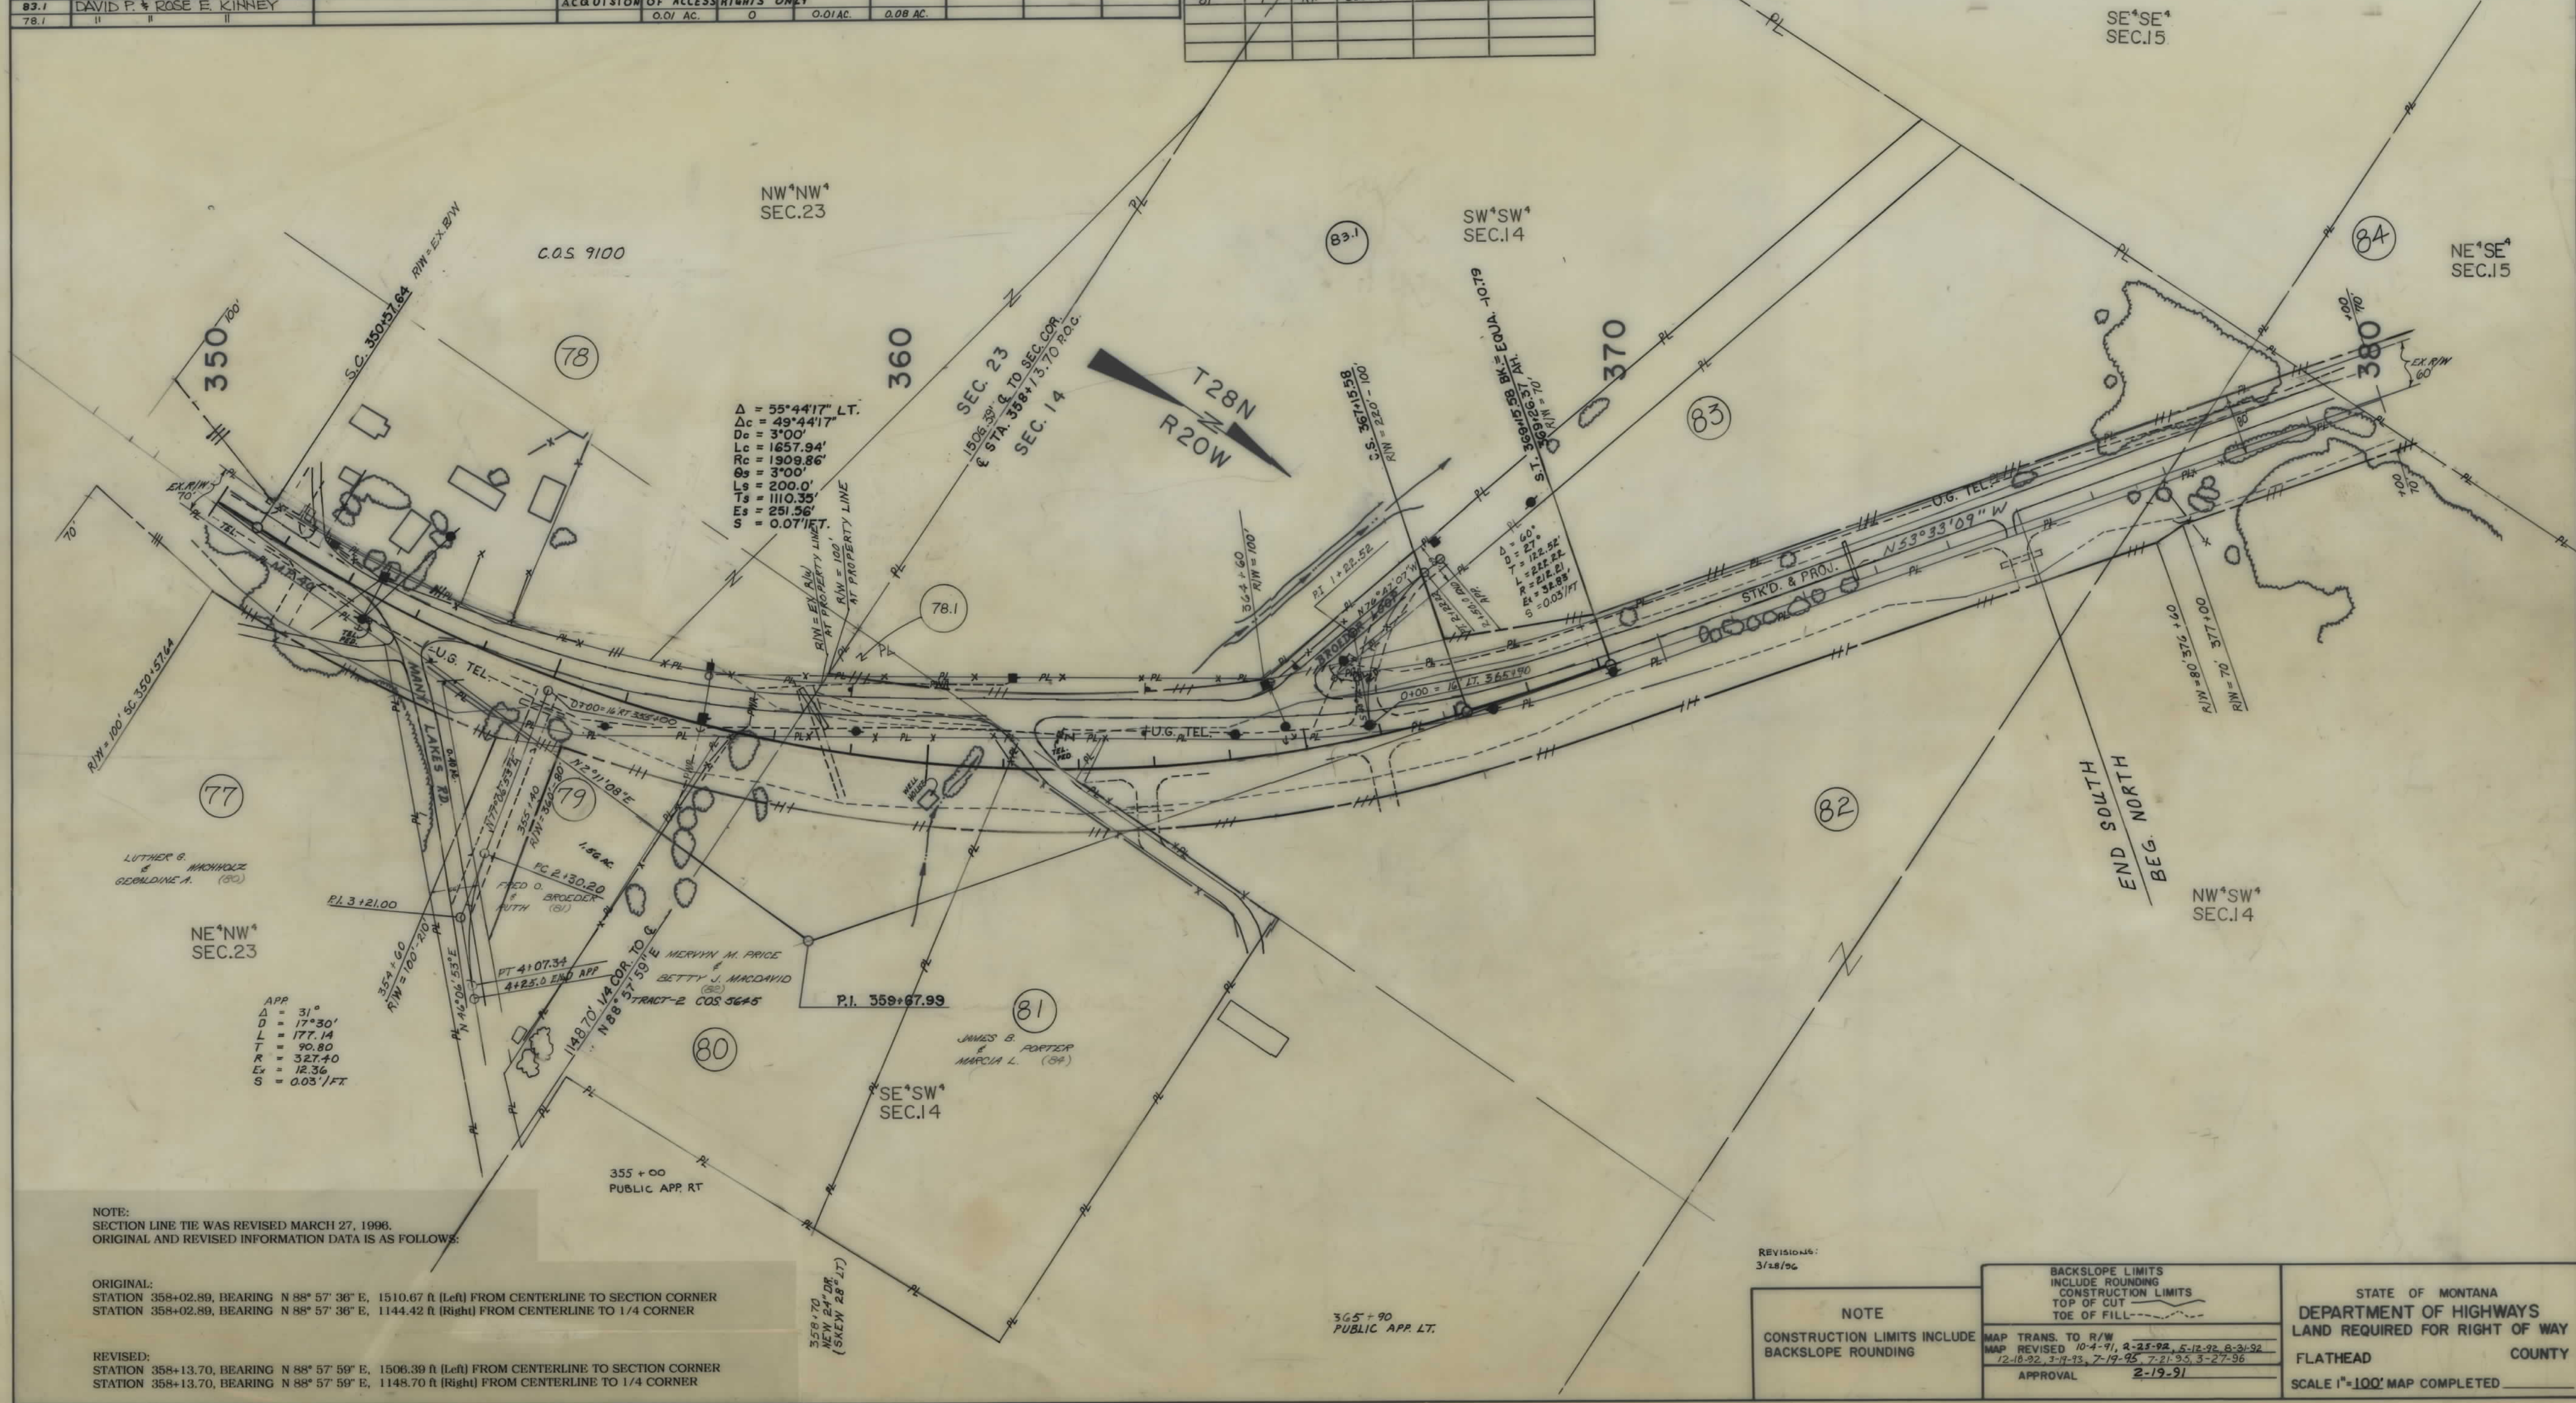

OWNERSHIPS											PRIVATE ROAD APPROACHES					STATE		PROJECT NO.		SHEET TOTAL	
PARCEL	N A M E	A D D R E S S	TOTAL AREA	GROSS R/W AREA	P.T.W. AREA	AREA TO BE ACQUIRED	REMAINDER		CONST. PERM. AREA	EASE AREA	PARCELS SERVED	NO. OF APP.	SIDE	MOVABLE APPROACHES (1)		JOINT-USE APPROACHES (2)		MONT.	F52-2(12)34	15	28
						LEFT	RIGHT			LIMITS				FIXED LOCATION							
										FROM STA.				TO STA.	STATION						
82	WILMA C. BUCK & FRANCES L. BALTRUSCH			3.07 AC.	0	3.07 AC.				0.04 AC.*											
84	DONALD R. & VIOLET M. SIBLERUD			6,234 SF		6,234 SF			0.13 AC.												
85	CHARLES L. & SHIRLEY L. MARVIN			2.62 AC.	0	2.62 AC.			1.36 AC.												
86	DELETED																				
87	PAUL M. & ELIZABETH SIBLERUD			186 SF	0	186 SF			0.26 AC.		86	1	LT.	391+25	392+40						
88	FRED O. BROEDER, TRUST CONRAD NATIONAL BANK OF KALISPELL			3.56 AC.	1.63 AC.	1.93 AC.				0.24 AC.*	87	1	LT.	392+50	398+60						
89	HAZEL J. BROEDER LIVING TRUST			56,674 SF	0	56,674 SF					89,88	1	RT.		403+10						
90	"			700 SF	0	700 SF					90	1	LT.	403+10	404+40						
91	LEWIS ORLANDO GROB			0.12 AC.	0	0.12 AC.				0.12 AC.**	90,92	1	LT.		408+35						
92	CHRIS E. GROB			SEE	SHEET	NO. 16					91	1	RT.	406+35	408+55						
93	J.G. HOCHSTETLER C/D EDWIN H. & EDITH M. SANDERS			"	"	"					92	1	LT.	409+35	414+40						


(1) MOVABLE ROAD APPROACHES MAY BE RELOCATED BETWEEN THE SPECIFIED STATIONS AFTER THE INITIAL CONSTRUCTION. BEFORE RECONSTRUCTION, A PERMIT MUST BE OBTAINED FROM THE MOOH OFFICE IN MISSOULA


(2) JOINT-USE ROAD APPROACH RELOCATIONS "RESTRICTED". (SEE LIMITED ACCESS RESOLUTION, SHEET NO. 1A.)

CRESTON N & S

(1) MOVABLE ROAD APPROACHES MAY BE RELOCATED BETWEEN THE SPECIFIED STATIONS AFTER THE INITIAL CONSTRUCTION. BEFORE RECONSTRUCTION, A PERMIT MUST BE OBTAINED FROM THE MOOH OFFICE IN MISSOULA

(2) JOINT-USE ROAD APPROACH RELOCATIONS "RESTRICTED". (SEE LIMITED ACCESS RESOLUTION, SHEET NO. 1A.)

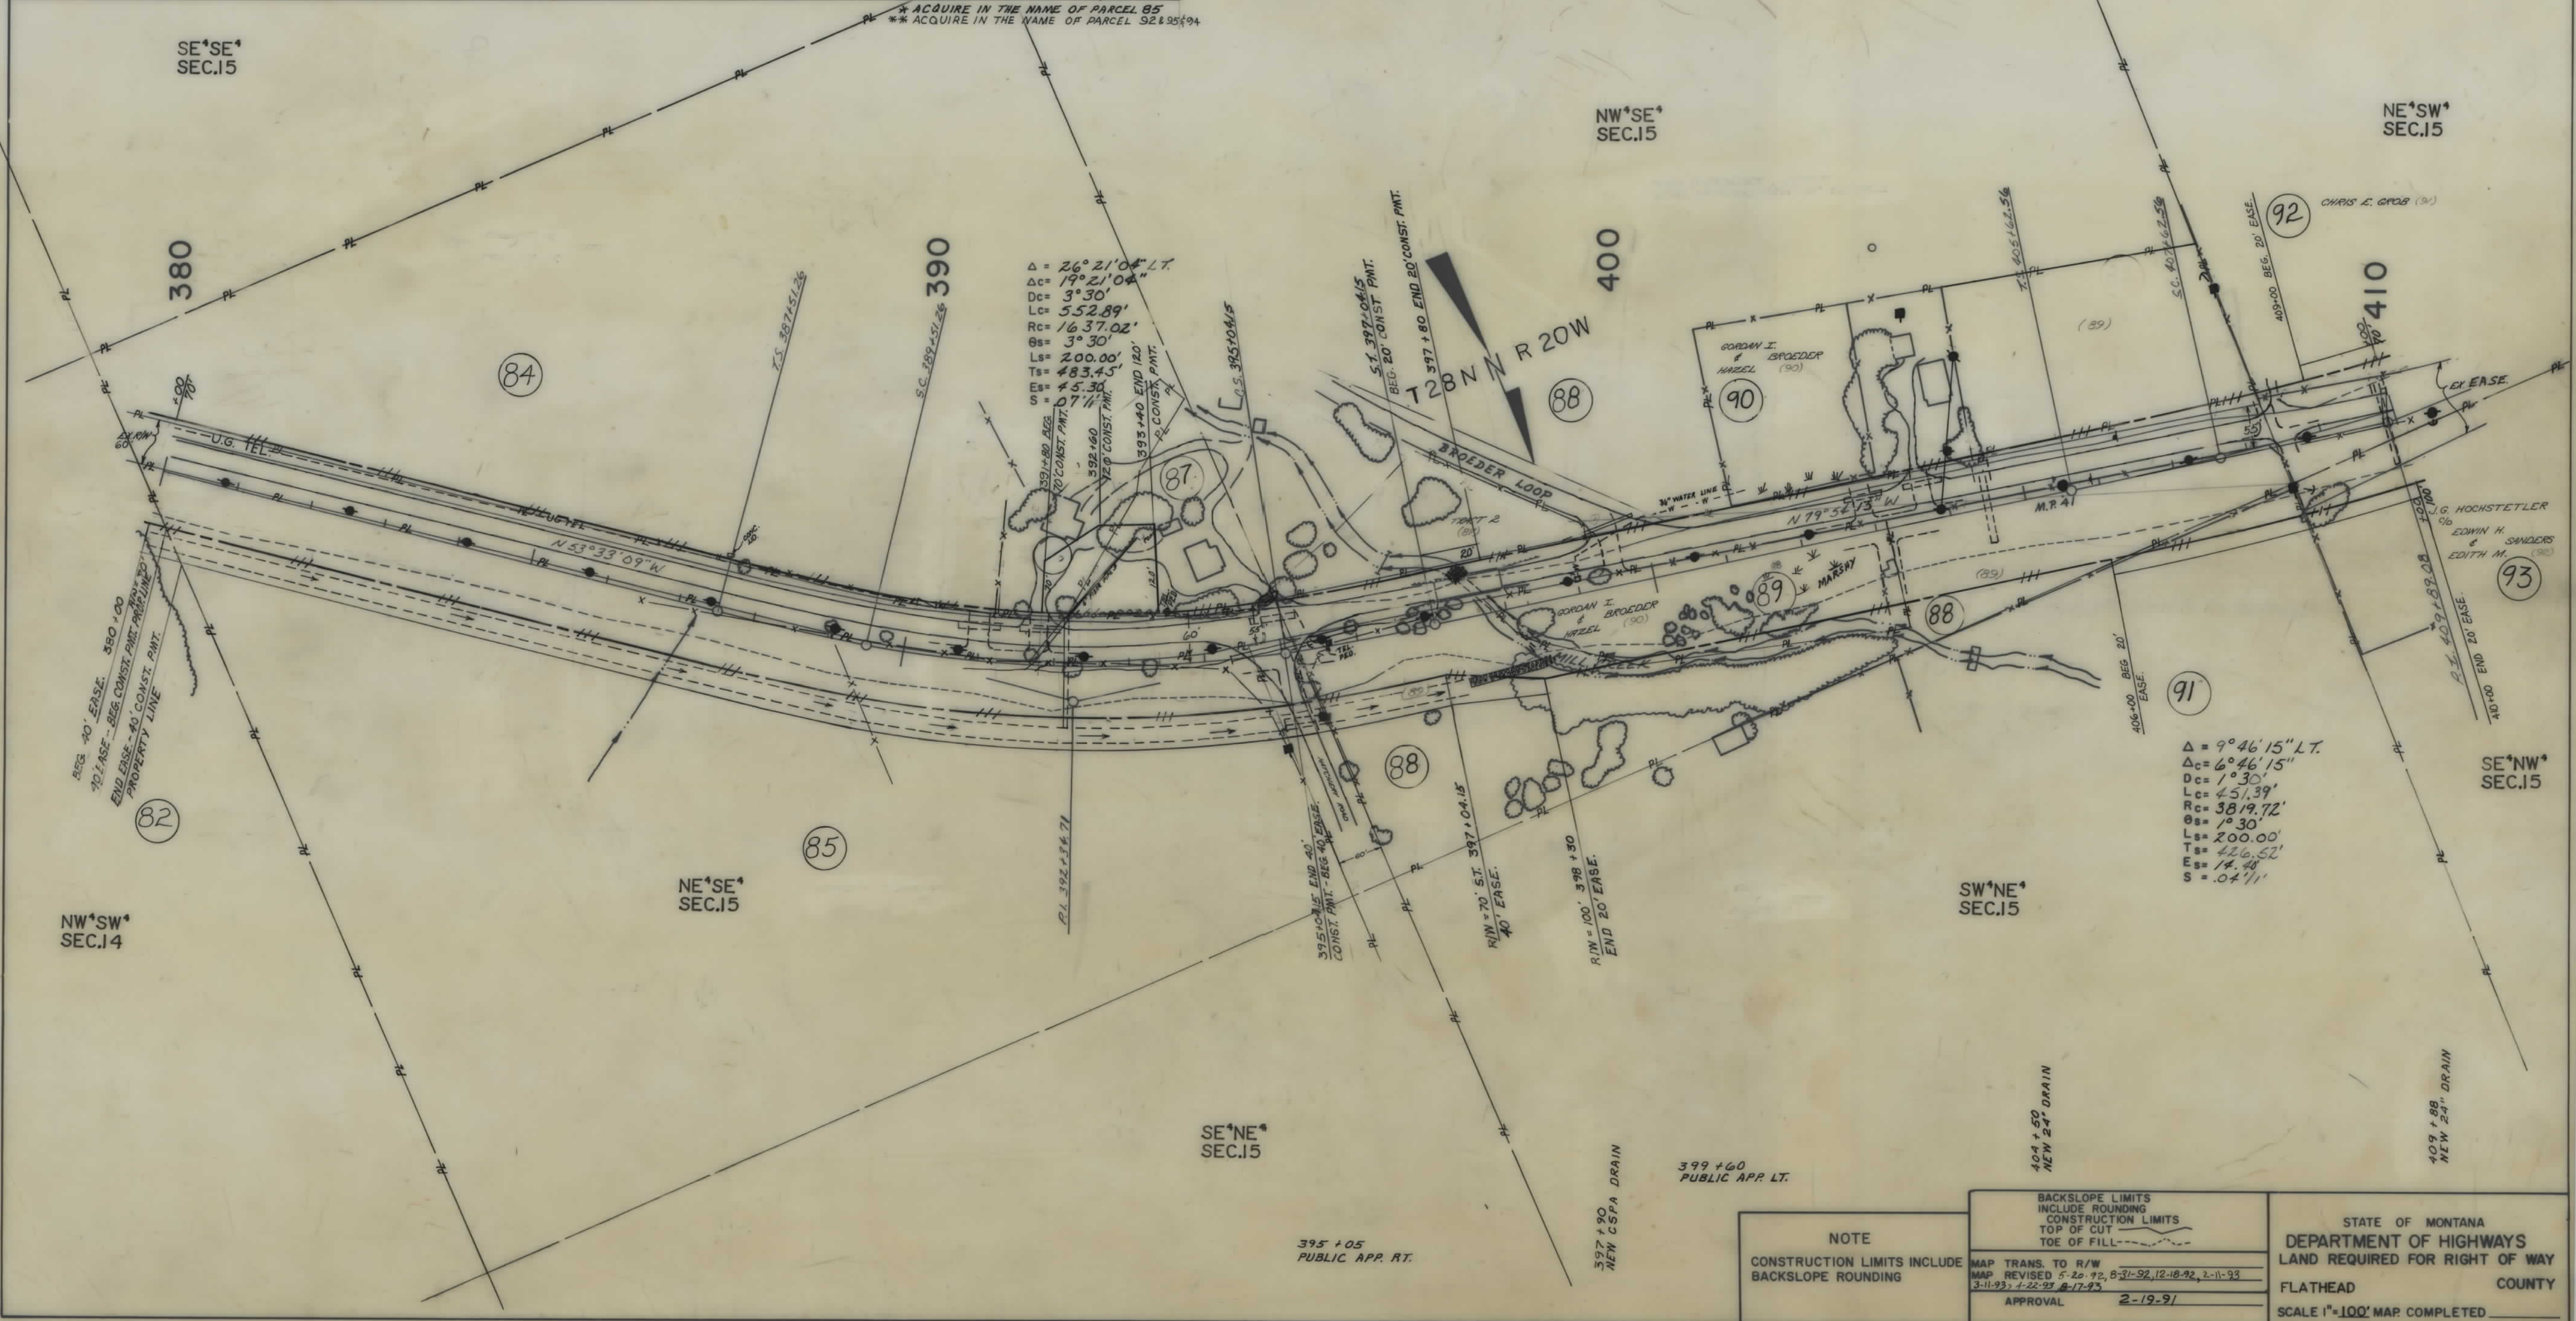

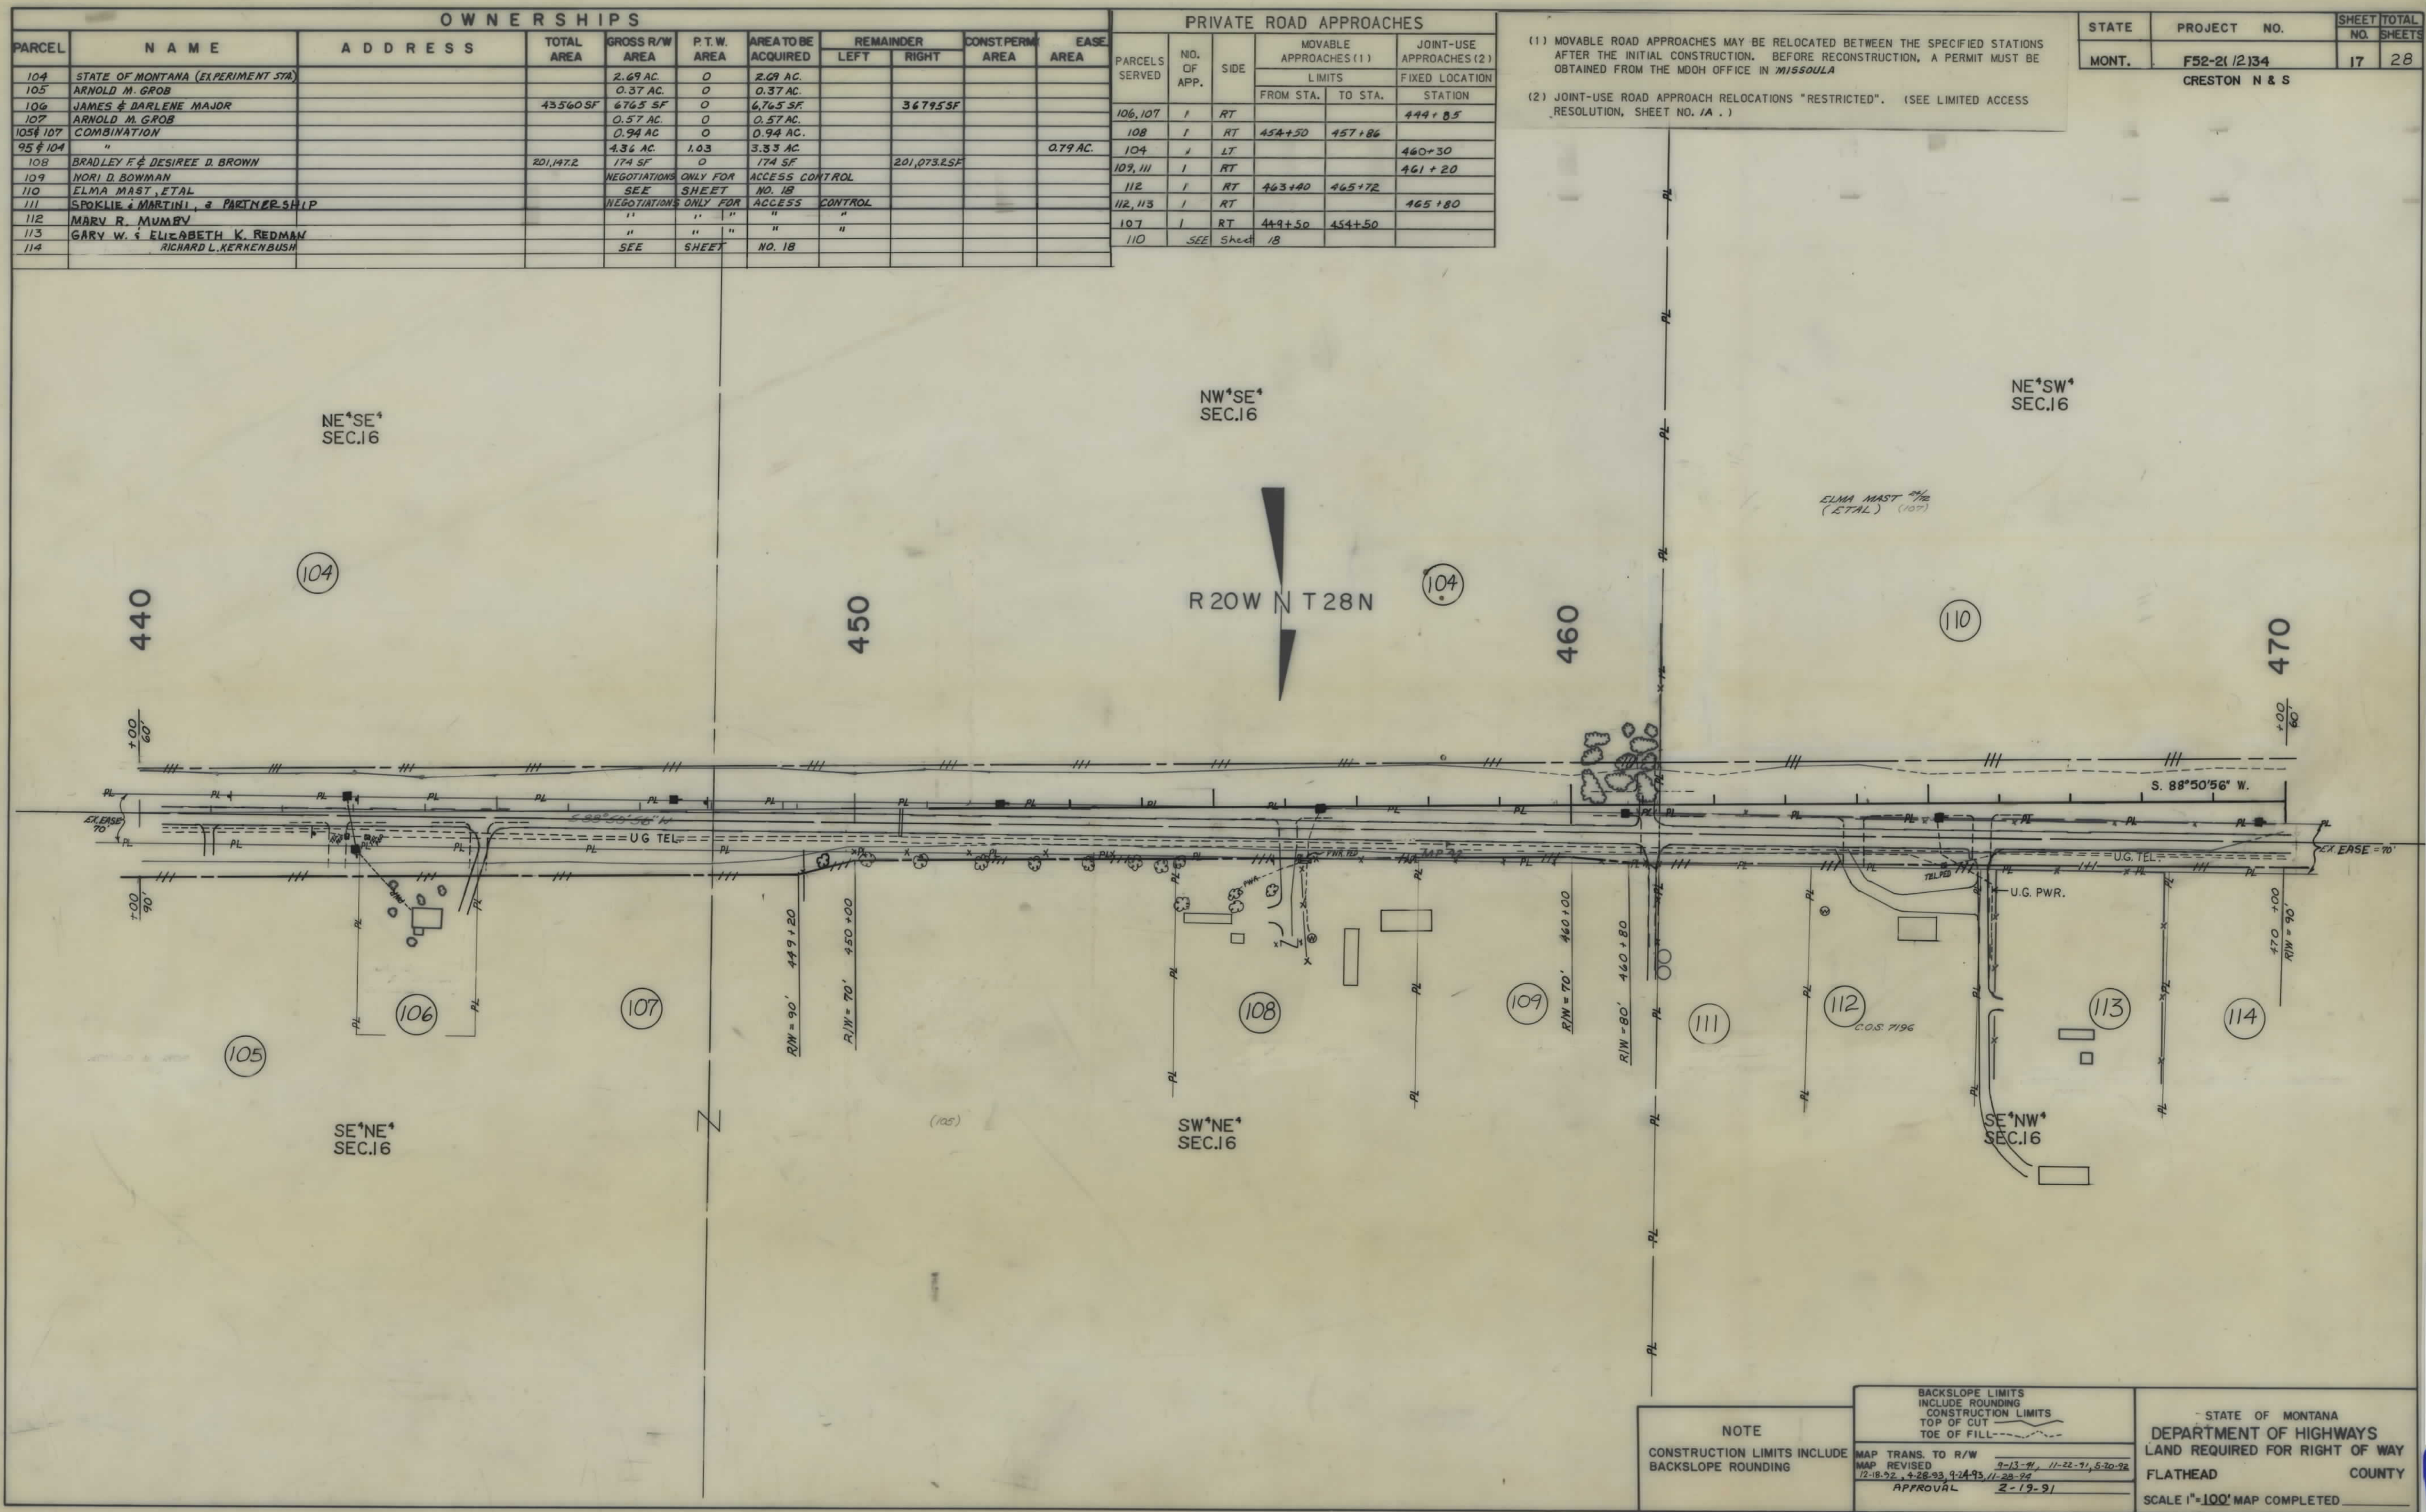


OWNERSHIPS									
PARCEL	NAME	ADDRESS	TOTAL AREA	GROSS R/W AREA	P.T.W. AREA	AREA TO BE ACQUIRED	REMAINDER LEFT	REMAINDER RIGHT	CONST. PERM. AREA
110	ELMA MAST, ETAL			3.83 AC.	0	3.83 AC.			0.51 AC.
114	RICHARD H. KERKENBUSH			NEGOTIATIONS ONLY FOR ACCESS			CONTROL		
115	FRANK A. SHEPARD								
116	DAVID L. REED		4.58 AC.	0.07 AC.	0	0.07 AC.		4.51 AC.	
117	HELEN MAJOR		8.373 AC.	3.20 AC.	0	3.20 AC.	1.21 AC.	3.963 AC.	
118	WILLIAM F. & LOUISE AMBROSE			SEE SHEET		NO. 19			
119	SPOKIE & MARTINI, A PARTNERSHIP			0.41 AC.	0	0.41 AC.			
120	SPOKIE & MARTINI & CYNTHIA R. COLAD			SEE SHEET		NO. 19			
117.1	SPOKIE & MARTINI		7.071 AC.	0.42 AC.	0	0.42 AC.		6.651 AC.	
116.1	MIKE W. & ROBERTA J. COTTON		1.42 AC.	0.59 AC.	0	0.59 AC.		0.83 AC.	

(1) MOVABLE ROAD APPROACHES MAY BE RELOCATED BETWEEN THE SPECIFIED STATIONS AFTER THE INITIAL CONSTRUCTION. BEFORE RECONSTRUCTION, A PERMIT MUST BE OBTAINED FROM THE MDOT OFFICE IN MISSOULA

(2) JOINT-USE ROAD APPROACH RELOCATIONS, "RESTRICTED". (SEE LIMITED ACCESS RESOLUTION, SHEET NO. 1A.)

PRIVATE ROAD APPROACHES					
PARCELS SERVED	NO. OF APP.	SIDE	MOVABLE APPROACHES (1)		JOINT-USE APPROACHES (2)
			LIMITS		FIXED LOCATION
			FROM STA.	TO STA.	STATION
114	1	RT.	468+40	470+90	
115	2	RT.	471+50	475+30	
116	2	RT.	475+35	479+90	
116.1, 117	1	RT.			483+00
117.1, 119	1	RT.			494+30
117	1	RT.	483+62	491+00	
116.1	1	RT.	480+00	482+00	
110	2	LT.			462+12 & 471+85

STATE	PROJECT NO.	SHEET TOTAL	
MONT.	F52-2(12) 134	NO.	SHEETS
	CRESTON N & S	18	28

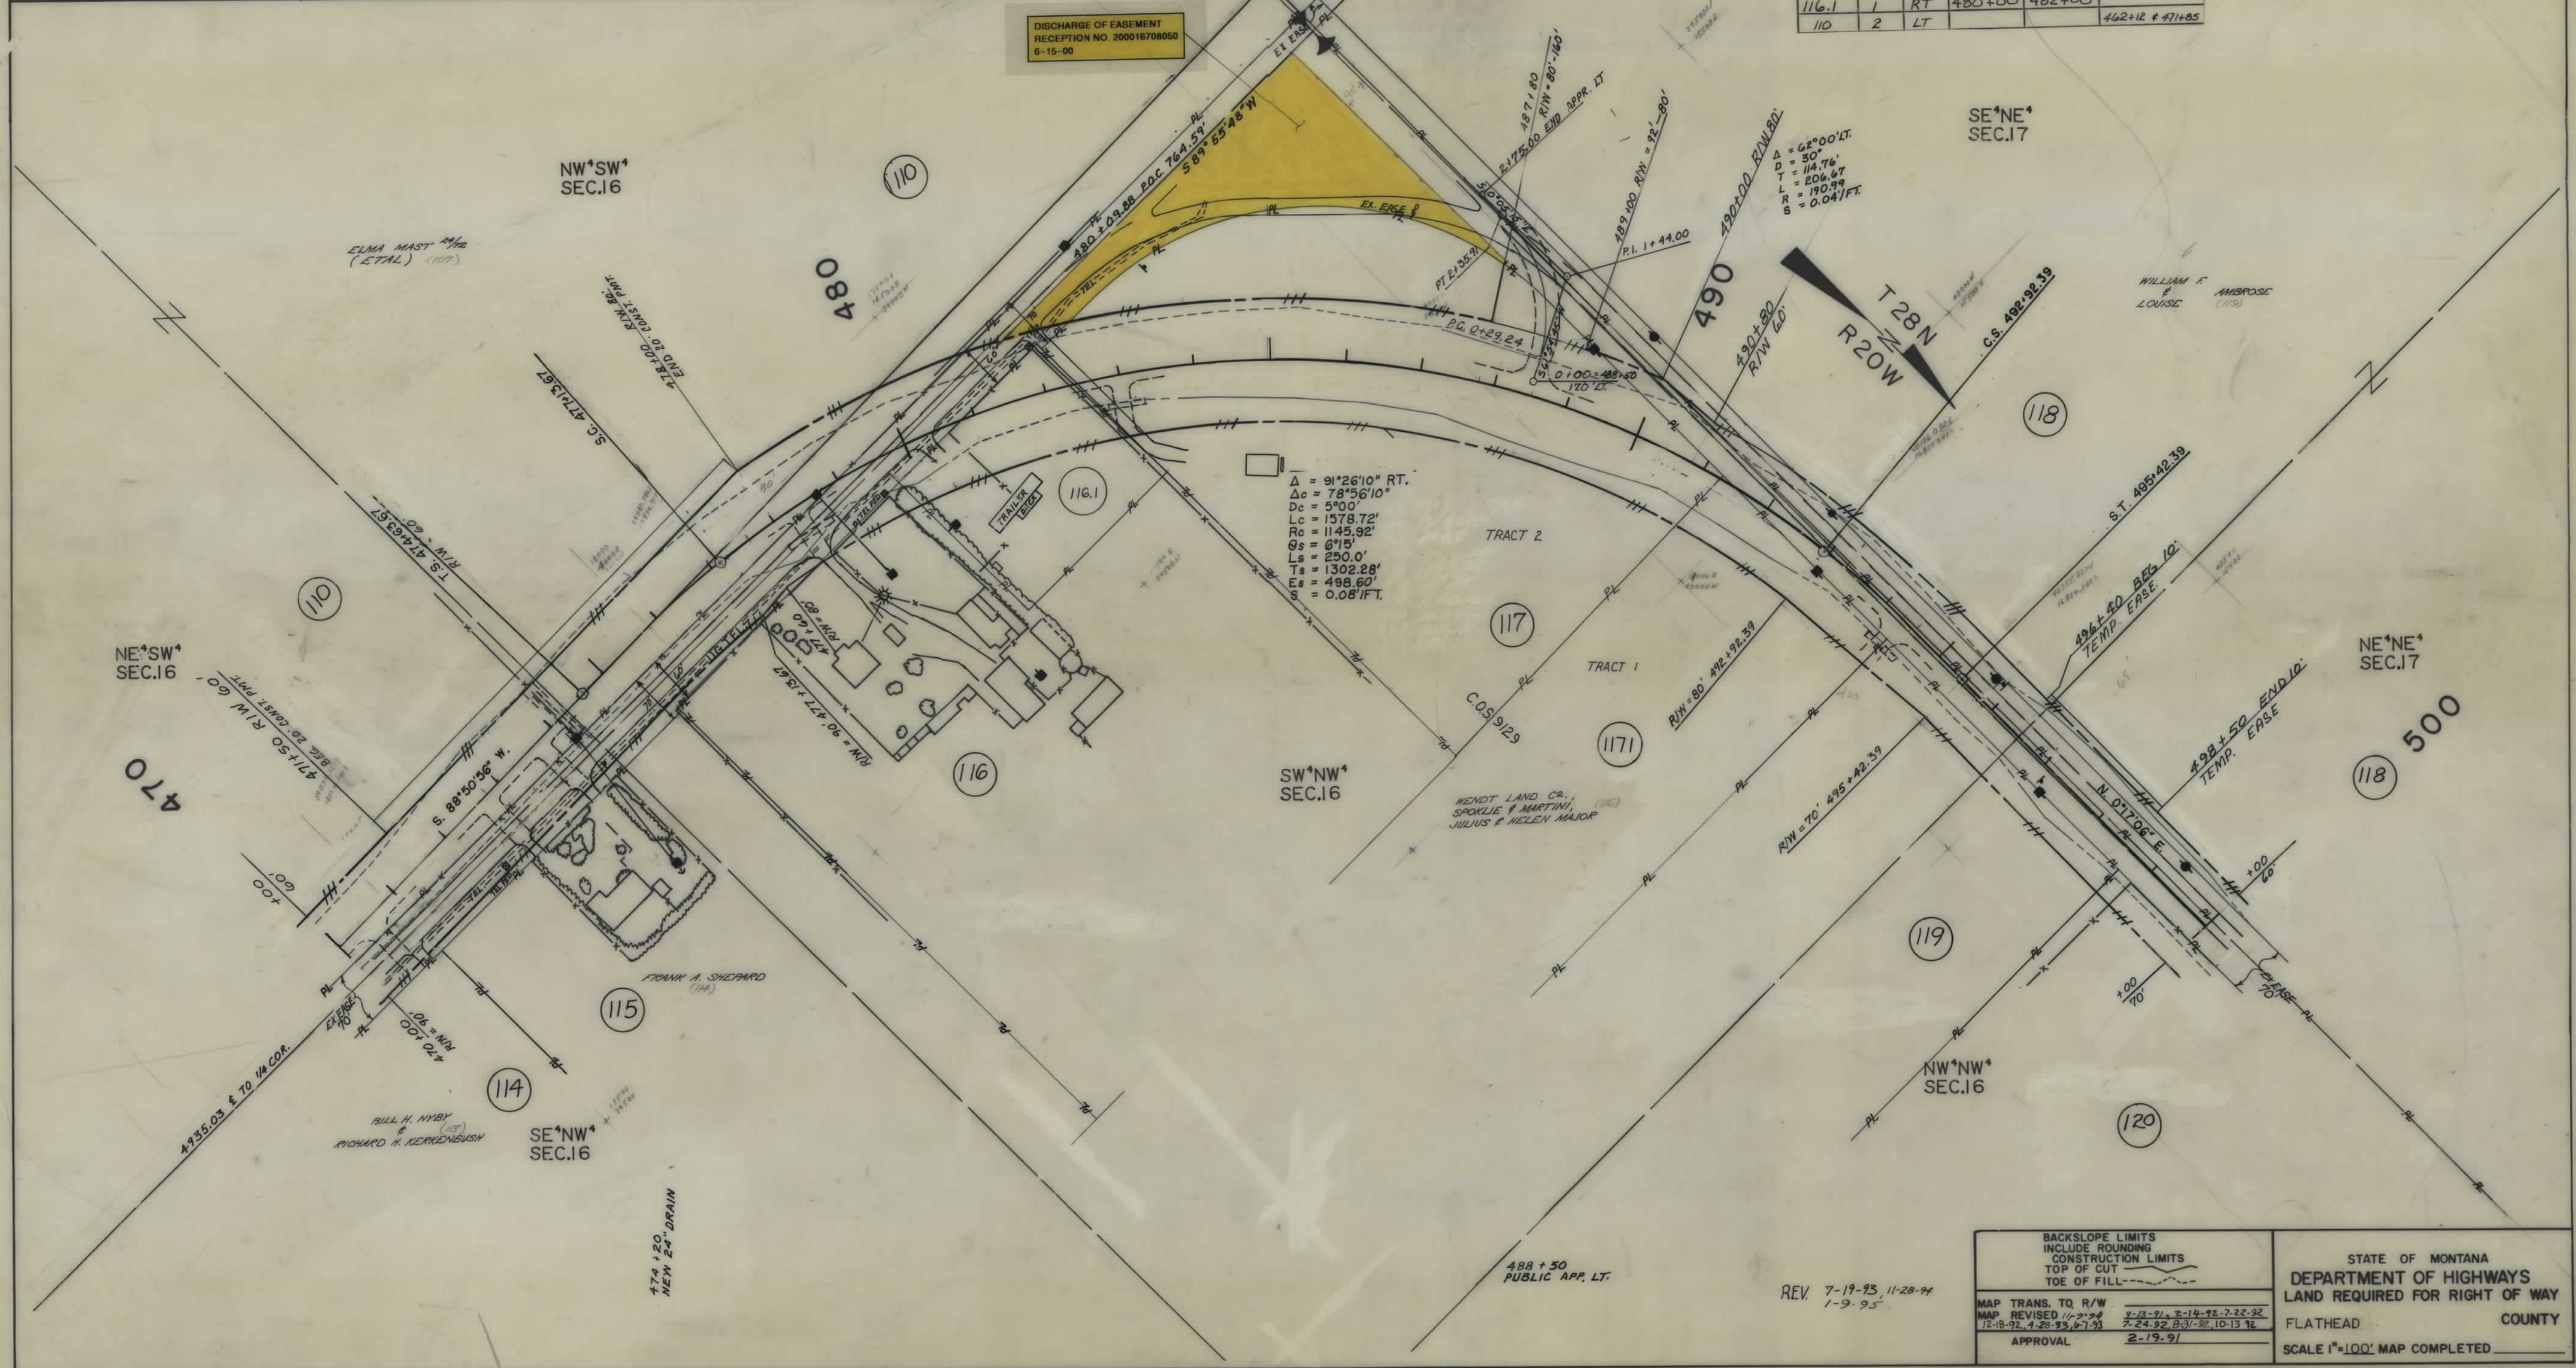

OWNERSHIPS									
PARCEL	NAME	ADDRESS	TOTAL AREA	GROSS R/W AREA	P.T.W. AREA	AREA TO BE ACQUIRED	REMAINDER		CONST. PERM. AREA
122	HUBBARD FARMS INC.			8.17 AC.	3.91 AC.	4.26 AC.			0.02 AC.*
123	ROBERT S. & SHARON K. SNELL			SEE SHEET	NO. 21				
124	FRED O. BROEDER JR. (TRUST) % CONRAD	NATIONAL BANK OF KALISPELL		4.64 AC.	1.81 AC.	2.83 AC.			
125	HERMAN D. & BERNIDA CHEFF BYRD, ET AL			SEE SHEET	NO. 21				

PRIVATE ROAD APPROACHES					
PARCELS SERVED	NO. OF APP.	SIDE	MOVABLE APPROACHES (1)		JOINT-USE APPROACHES (2)
			LIMITS		FIXED LOCATION
			FROM STA.	TO STA.	STATION
124	1	RT.			539+00
123	3	LT.	536+35	561+95	
124, 125	1	RT.			558+75


(1) MOVABLE ROAD APPROACHES MAY BE RELOCATED BETWEEN THE SPECIFIED STATIONS AFTER THE INITIAL CONSTRUCTION. BEFORE RECONSTRUCTION, A PERMIT MUST BE OBTAINED FROM THE MOOH OFFICE IN MISSOULA

(2) JOINT-USE ROAD APPROACH RELOCATIONS "RESTRICTED". (SEE LIMITED ACCESS RESOLUTION, SHEET NO. 1A.)

STATE	PROJECT NO.	SHEET NO.	TOTAL SHEETS
MONT.	F52-2(12)34	20	28

CRESTON N & S

* CHANGED TO TEMP EASEMENT FOR CONDEMNATION

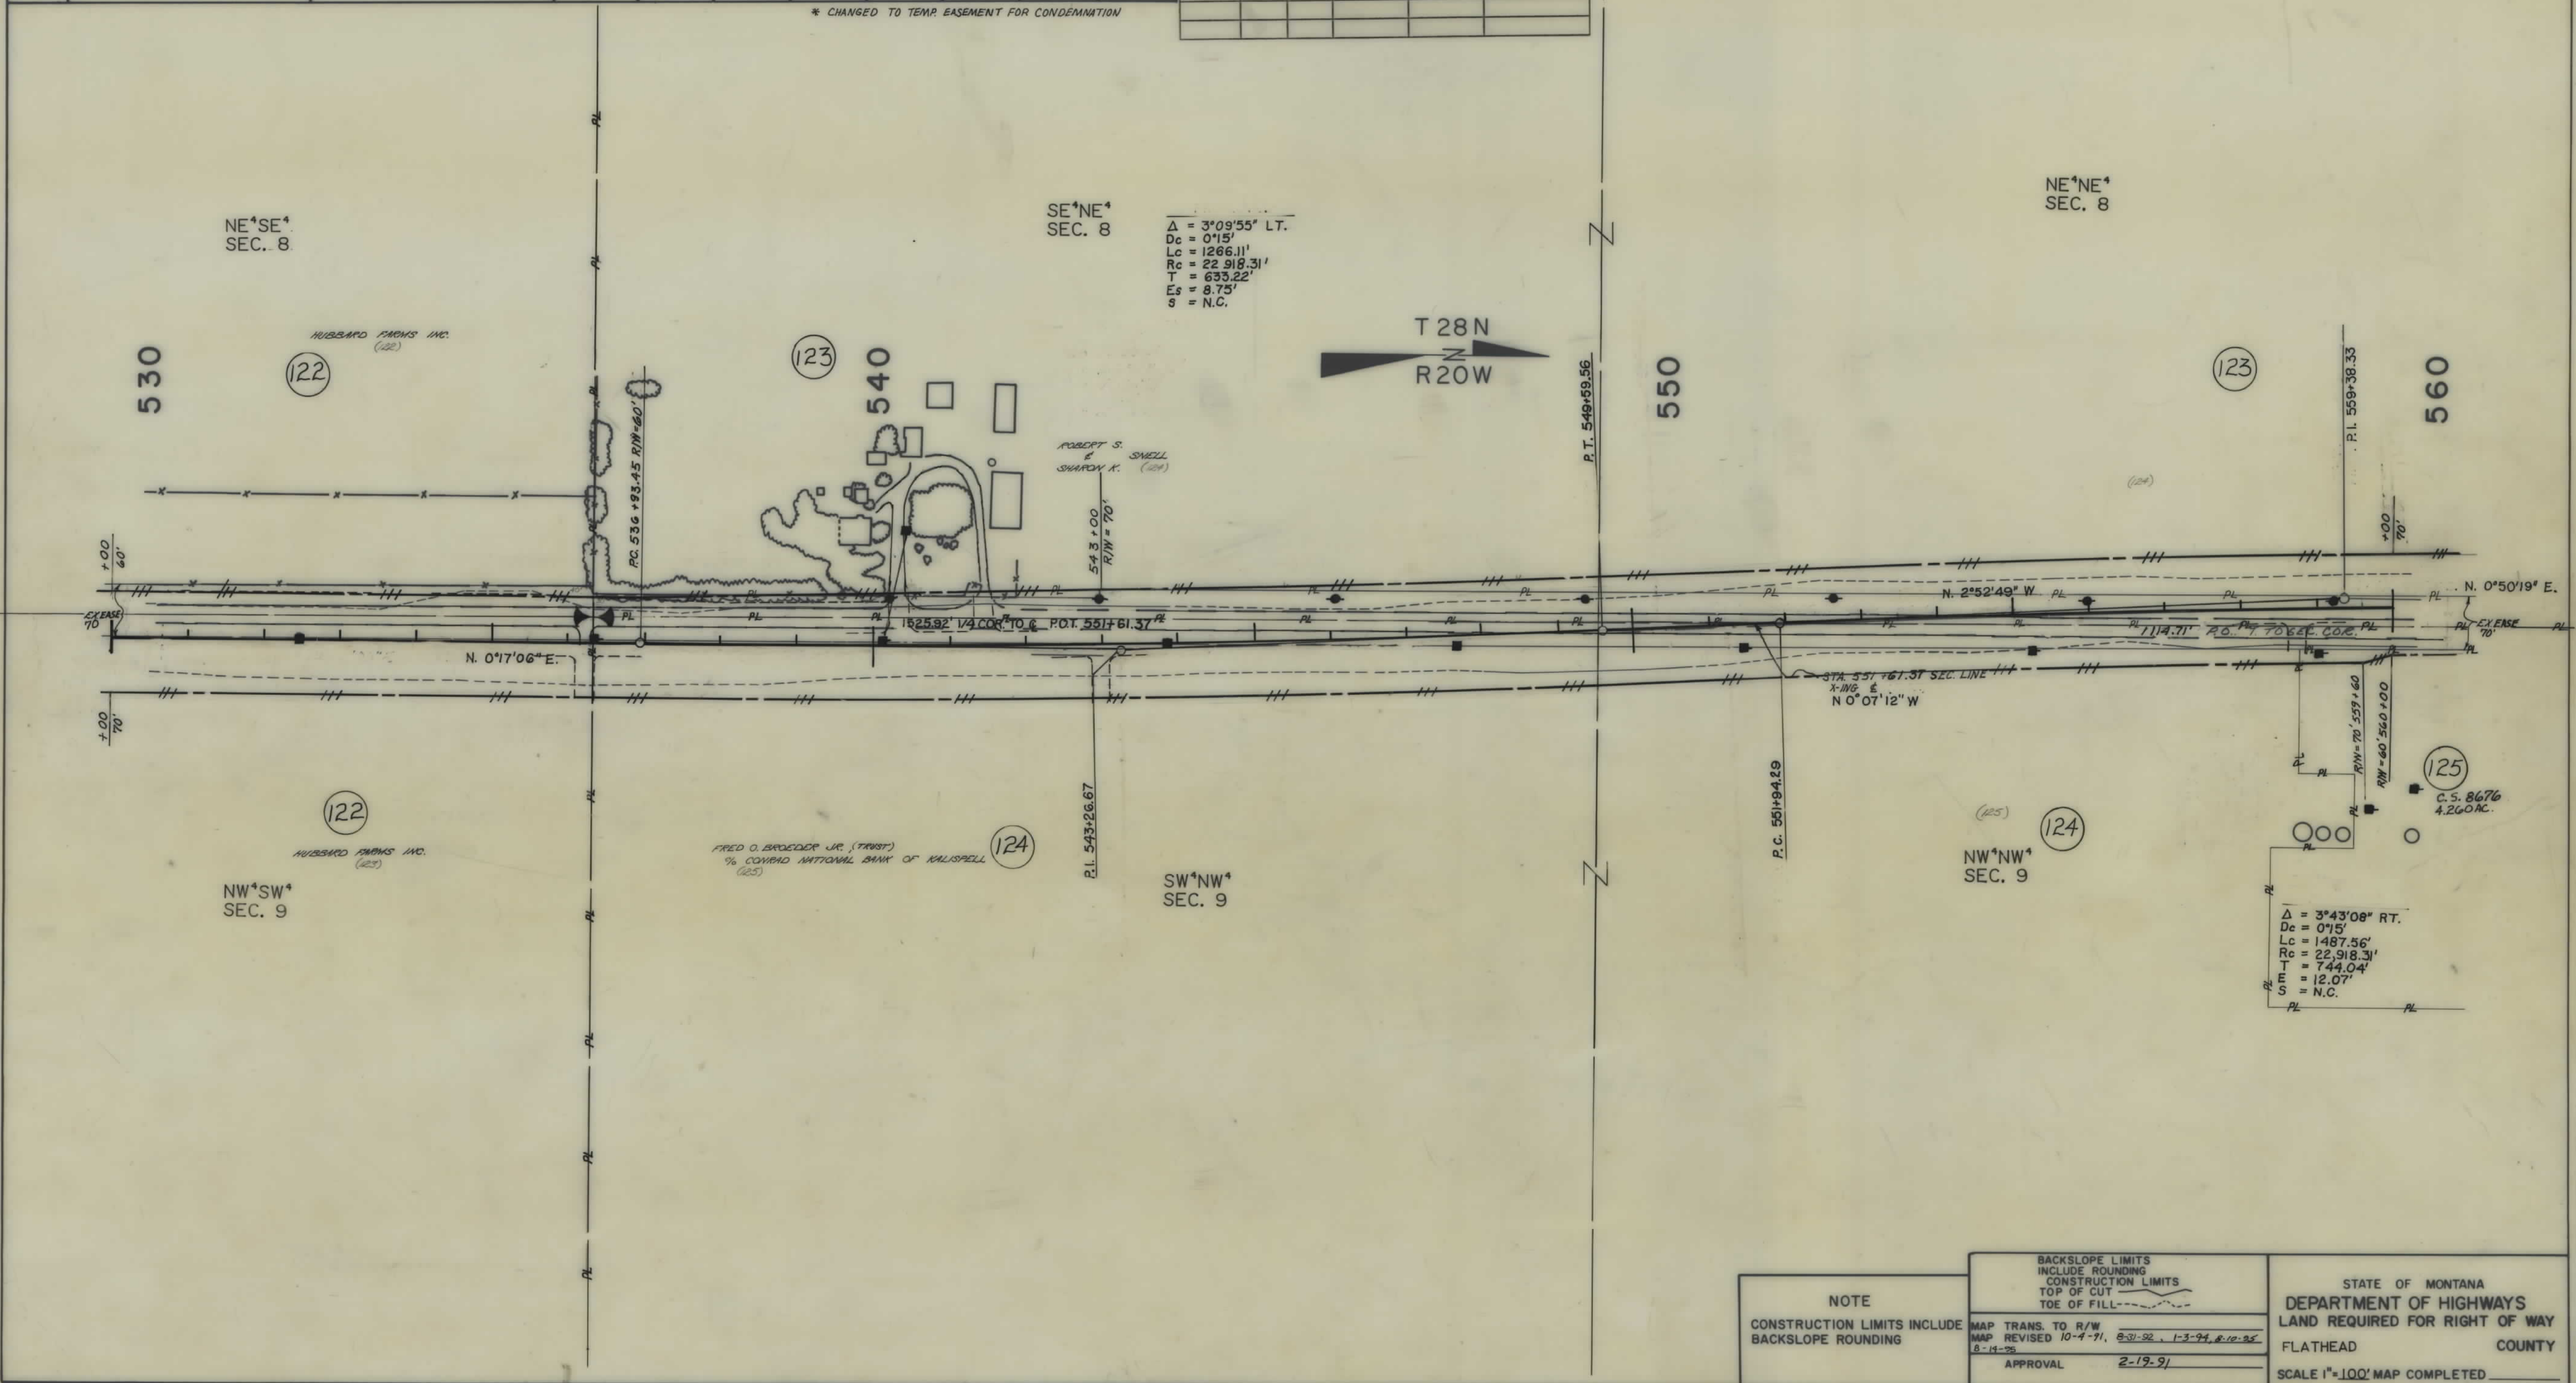

NOTE

CONSTRUCTION LIMITS INCLUDE BACKSLOPE ROUNDING

BACKSLOPE LIMITS INCLUDE ROUNDING CONSTRUCTION LIMITS TOP OF CUT TOE OF FILL

MAP TRANS. TO R/W 8-31-92, 1-3-94, 8-10-95

MAP REVISED 10-4-91, 8-31-92, 1-3-94, 8-10-95

APPROVAL 2-19-91

STATE OF MONTANA

DEPARTMENT OF HIGHWAYS

LAND REQUIRED FOR RIGHT OF WAY

FLATHEAD COUNTY

SCALE 1"=100' MAP COMPLETED


OWNERSHIPS											PRIVATE ROAD APPROACHES					STATE		PROJECT NO.		SHEET TOTAL	
PARCEL	NAME	ADDRESS	TOTAL AREA	GROSS R/W AREA	P.T.W. AREA	AREA TO BE ACQUIRED	REMAINDER		CONST. PERM. AREA	CONST. EASE. AREA	PARCELS SERVED	NO. OF APP.	SIDE	MOVABLE APPROACHES (1) LIMITS FROM STA. TO STA.	JOINT-USE APPROACHES (2) FIXED LOCATION STATION	MONT.	F52-2(12)34	21	28		
123	ROBERT S. & SHARON K. SNELL			1.37 AC.	0	1.37 AC.										(1) MOVABLE ROAD APPROACHES MAY BE RELOCATED BETWEEN THE SPECIFIED STATIONS AFTER THE INITIAL CONSTRUCTION. BEFORE RECONSTRUCTION, A PERMIT MUST BE OBTAINED FROM THE MDOT OFFICE IN MISSOULA	CRESTON N & S				
124	FRED O. BROEDER JR. (TRUST) & CONRAD	NATIONAL BANK OF KALISPELL		SEE SHEET		NA 20															
125	HERMAN D. & BERNIDA CHEFF BYRD, ET AL		4.260 AC.	0.069 AC.	0	0.069 AC.		4.191 AC.			125	1	RT	558+75 561+95							
126	ARDEN & BETTY NOREM			1.45 AC.	0.61 AC.	0.84 AC.					128, 129	1	LT		575+20						
127	HARRY J. REIMER			SEE SHEET		NO. 22					129, 130	1	LT		588+80						
128	KATHLEEN ANNE NOREM			1.25 AC.	0.58 AC.	0.67 AC.					127		SEE SHEET	NO. 22		(2) JOINT-USE ROAD APPROACH RELOCATIONS "RESTRICTED". (SEE LIMITED ACCESS RESOLUTION, SHEET NO. 1A.)					
129	FRED O. BROEDER JR. (TRUST) & CONRAD	NATION BANK OF KALISPELL		2.27 AC.	1.23 AC.	1.04 AC.					130		"	"	NO. 23						
130	A HAROLD SMALL			SEE SHEET		NO. 23					126	1	LT.	563+56 568+92							
											128	1	LT.	569+00 574+00							
* TO BE ACQUIRED BY EASEMENT																					

(1) MOVABLE ROAD APPROACHES MAY BE RELOCATED BETWEEN THE SPECIFIED STATIONS AFTER THE INITIAL CONSTRUCTION. BEFORE RECONSTRUCTION, A PERMIT MUST BE OBTAINED FROM THE MDOT OFFICE IN MISSOULA

(2) JOINT-USE ROAD APPROACH RELOCATIONS "RESTRICTED". (SEE LIMITED ACCESS RESOLUTION, SHEET NO. 1A.)

STATE	PROJECT NO.	SHEET TOTAL	
MONT.	F52-2(12)34	21	28

CRESTON N & S

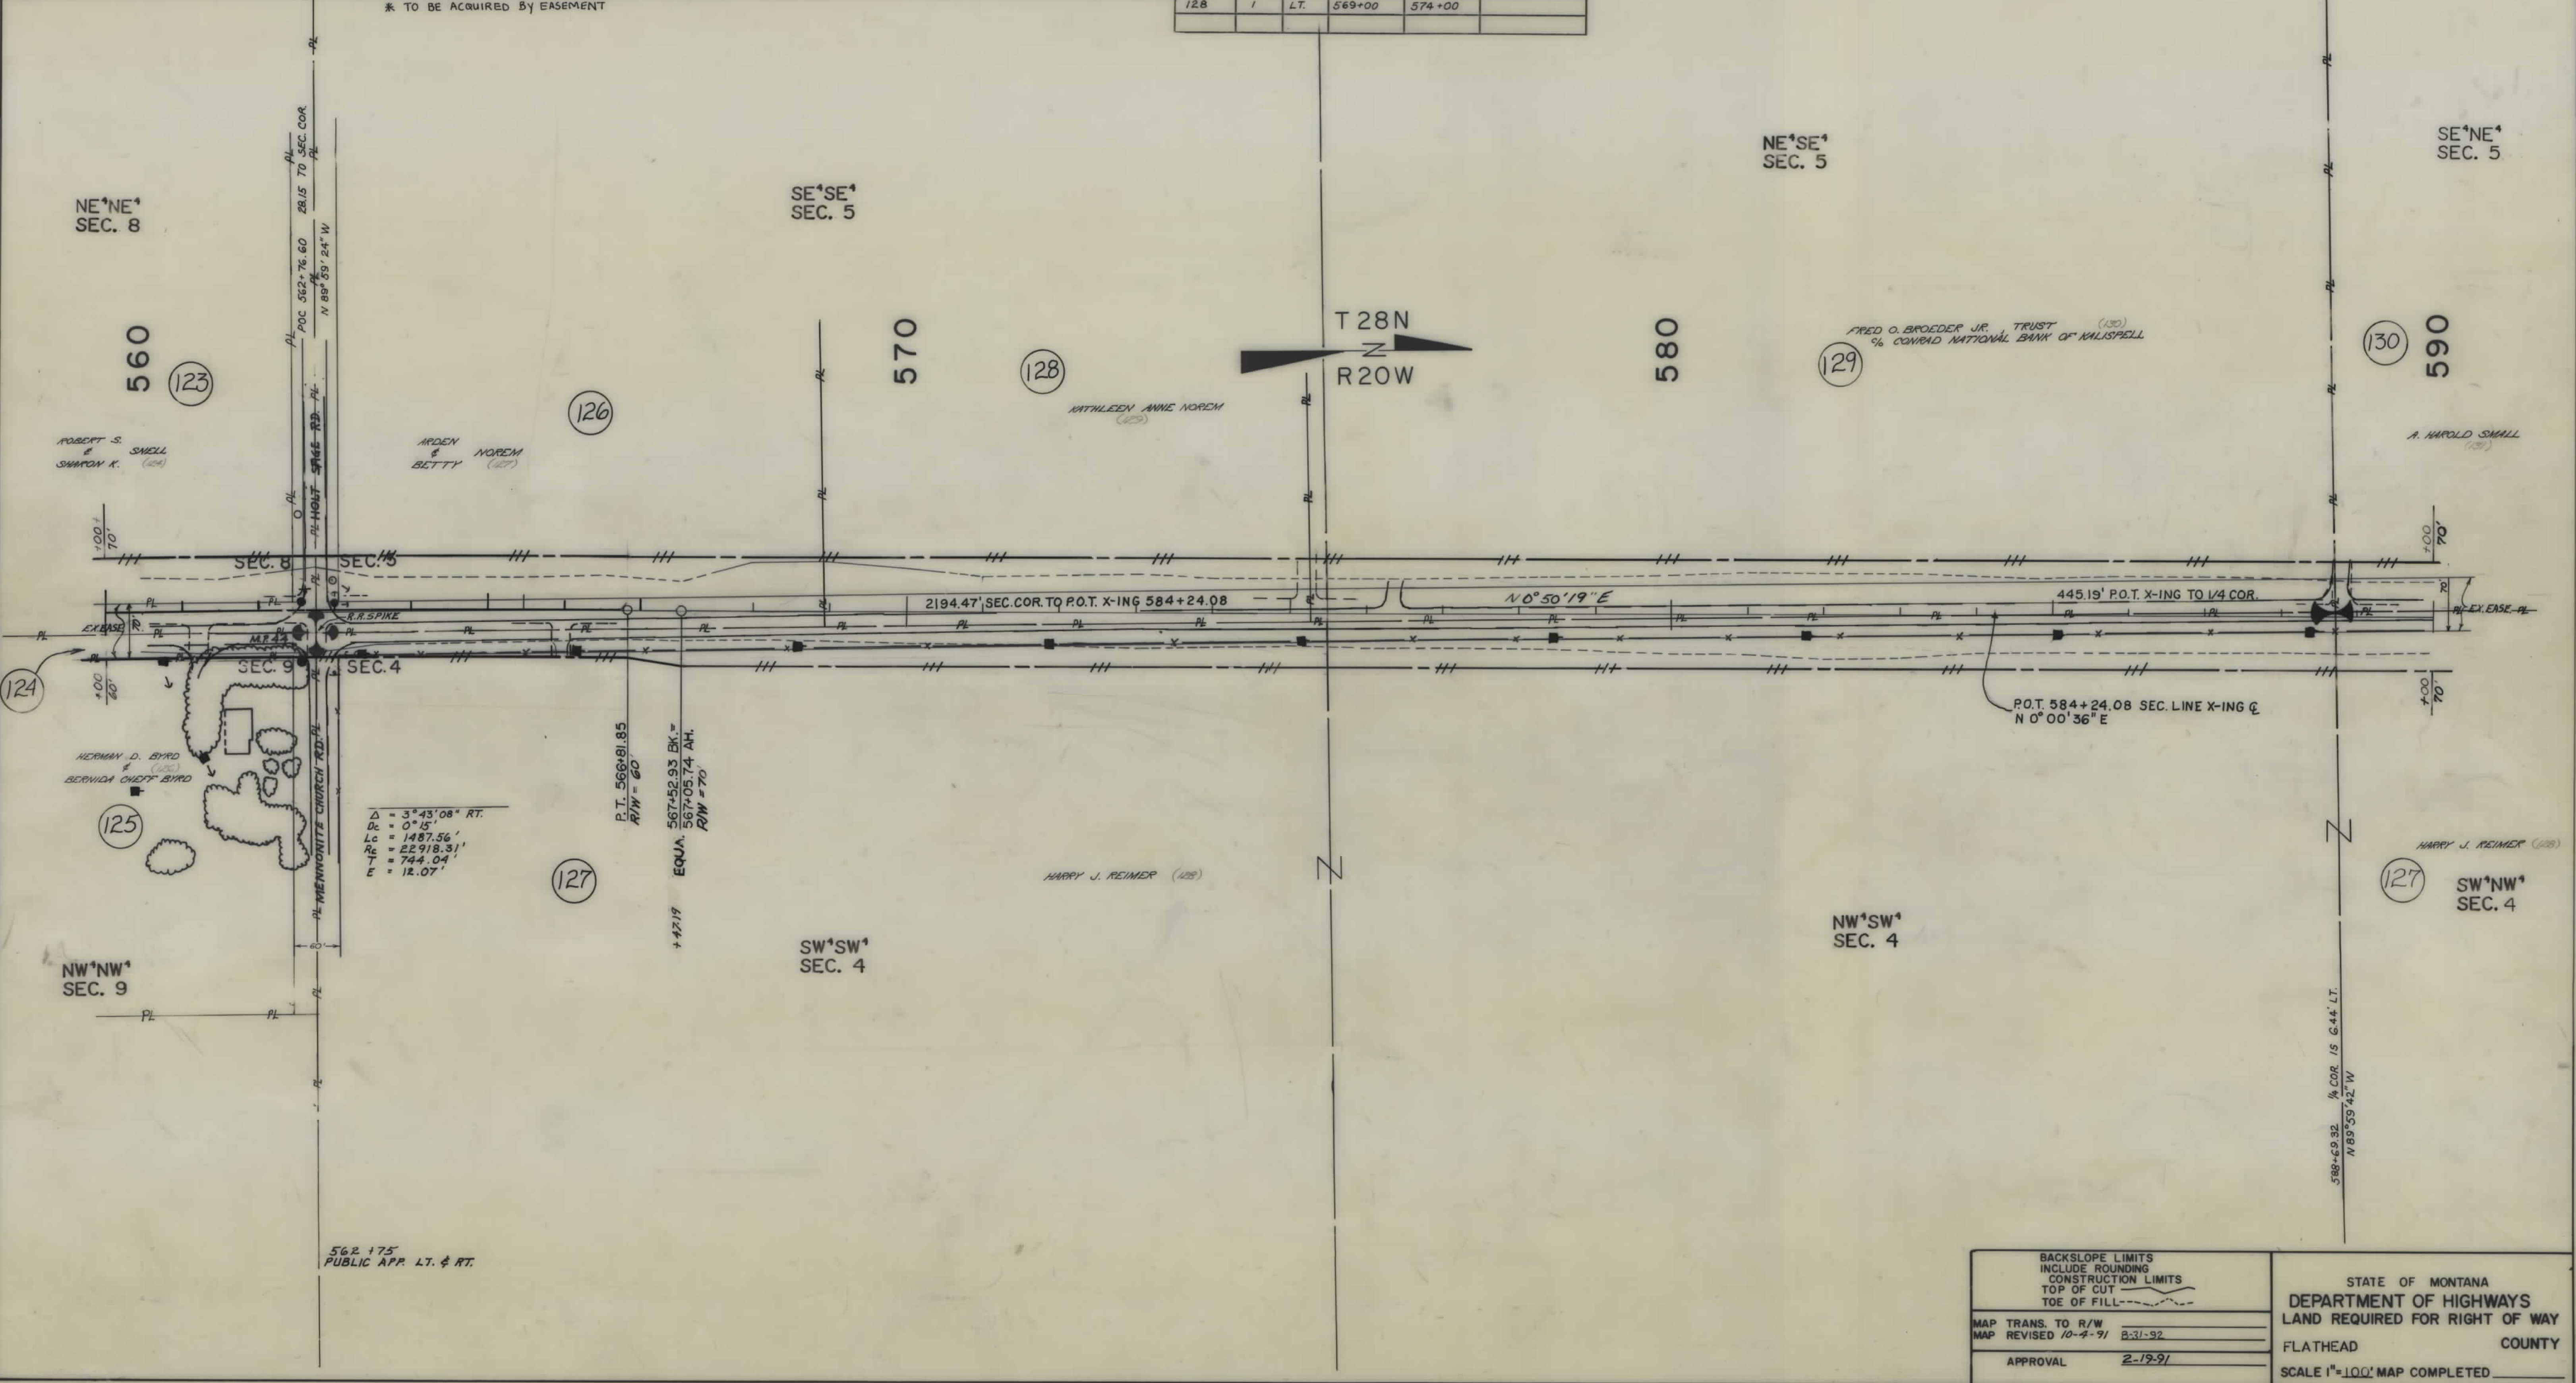


OWNERSHIPS									
PARCEL	NAME	ADDRESS	TOTAL AREA	GROSS R/W AREA	P.T.W. AREA	AREA TO BE ACQUIRED	REMAINDER		CONST. PERM. CONST. EASE
							LEFT	RIGHT	AREA AREA
130	A. HAROLD SMALL			12.98 AC.	3.66 AC.	9.32 AC.			
131	HENRY & MARY A. BYRNE			1.62 AC.	0	1.62 AC.			
132	RIENHARD & PATRICIA MUELLER			0.58 AC.	0	0.58 AC.			
133	MARGARET ENGBERG			0.04 AC.	0	0.04 AC.			
134	WOODY'S COUNTRY STORE, INC., A MT CORPORATION			1.85 AC.	0	1.85 AC.			
135	EVANS FARMS			0.15 AC.	0	0.15 AC.			
136	BARBARA JEAN FOPP			1.81 AC.	0.85 AC.	0.96 AC.			
137	KARI PETERSEN KLIEN, ETAL			SEE	SHEET	NO. 24			
138	JAMES A. & SHARON J. SUTHERLAND			"	"	"			
134.1	CHARLES A. WEIS		2.055 AC.	0.08 AC.	0	0.08 AC.		1.975 AC.	


PRIVATE ROAD APPROACHES					
PARCELS SERVED	NO. OF APP.	SIDE	MOVABLE APPROACHES (1)		JOINT-USE APPROACHES (2)
			LIMITS		FIXED LOCATION
			FROM STA.	TO STA.	
130	3	LT	589+30	636+75	
138	1	LT	645+70	650+65	
137	1	RT	637+60	650+80	
135	1	RT	635+00	637+00	
131	1	RT	622+00	623+00	
134	1	RT	627+00	631+50	
136	1	LT	637+00	645+50	

- (1) MOVABLE ROAD APPROACHES MAY BE RELOCATED BETWEEN THE SPECIFIED STATIONS AFTER THE INITIAL CONSTRUCTION. BEFORE RECONSTRUCTION, A PERMIT MUST BE OBTAINED FROM THE MDOT OFFICE IN MISSOULA
- (2) JOINT-USE ROAD APPROACH RELOCATIONS "RESTRICTED". (SEE LIMITED ACCESS RESOLUTION, SHEET NO. 1A.)

STATE	PROJECT NO.	SHEET TOTAL	
MONT.	F52-2112134	NO.	SHEETS
	CRESTON N & S	23	28

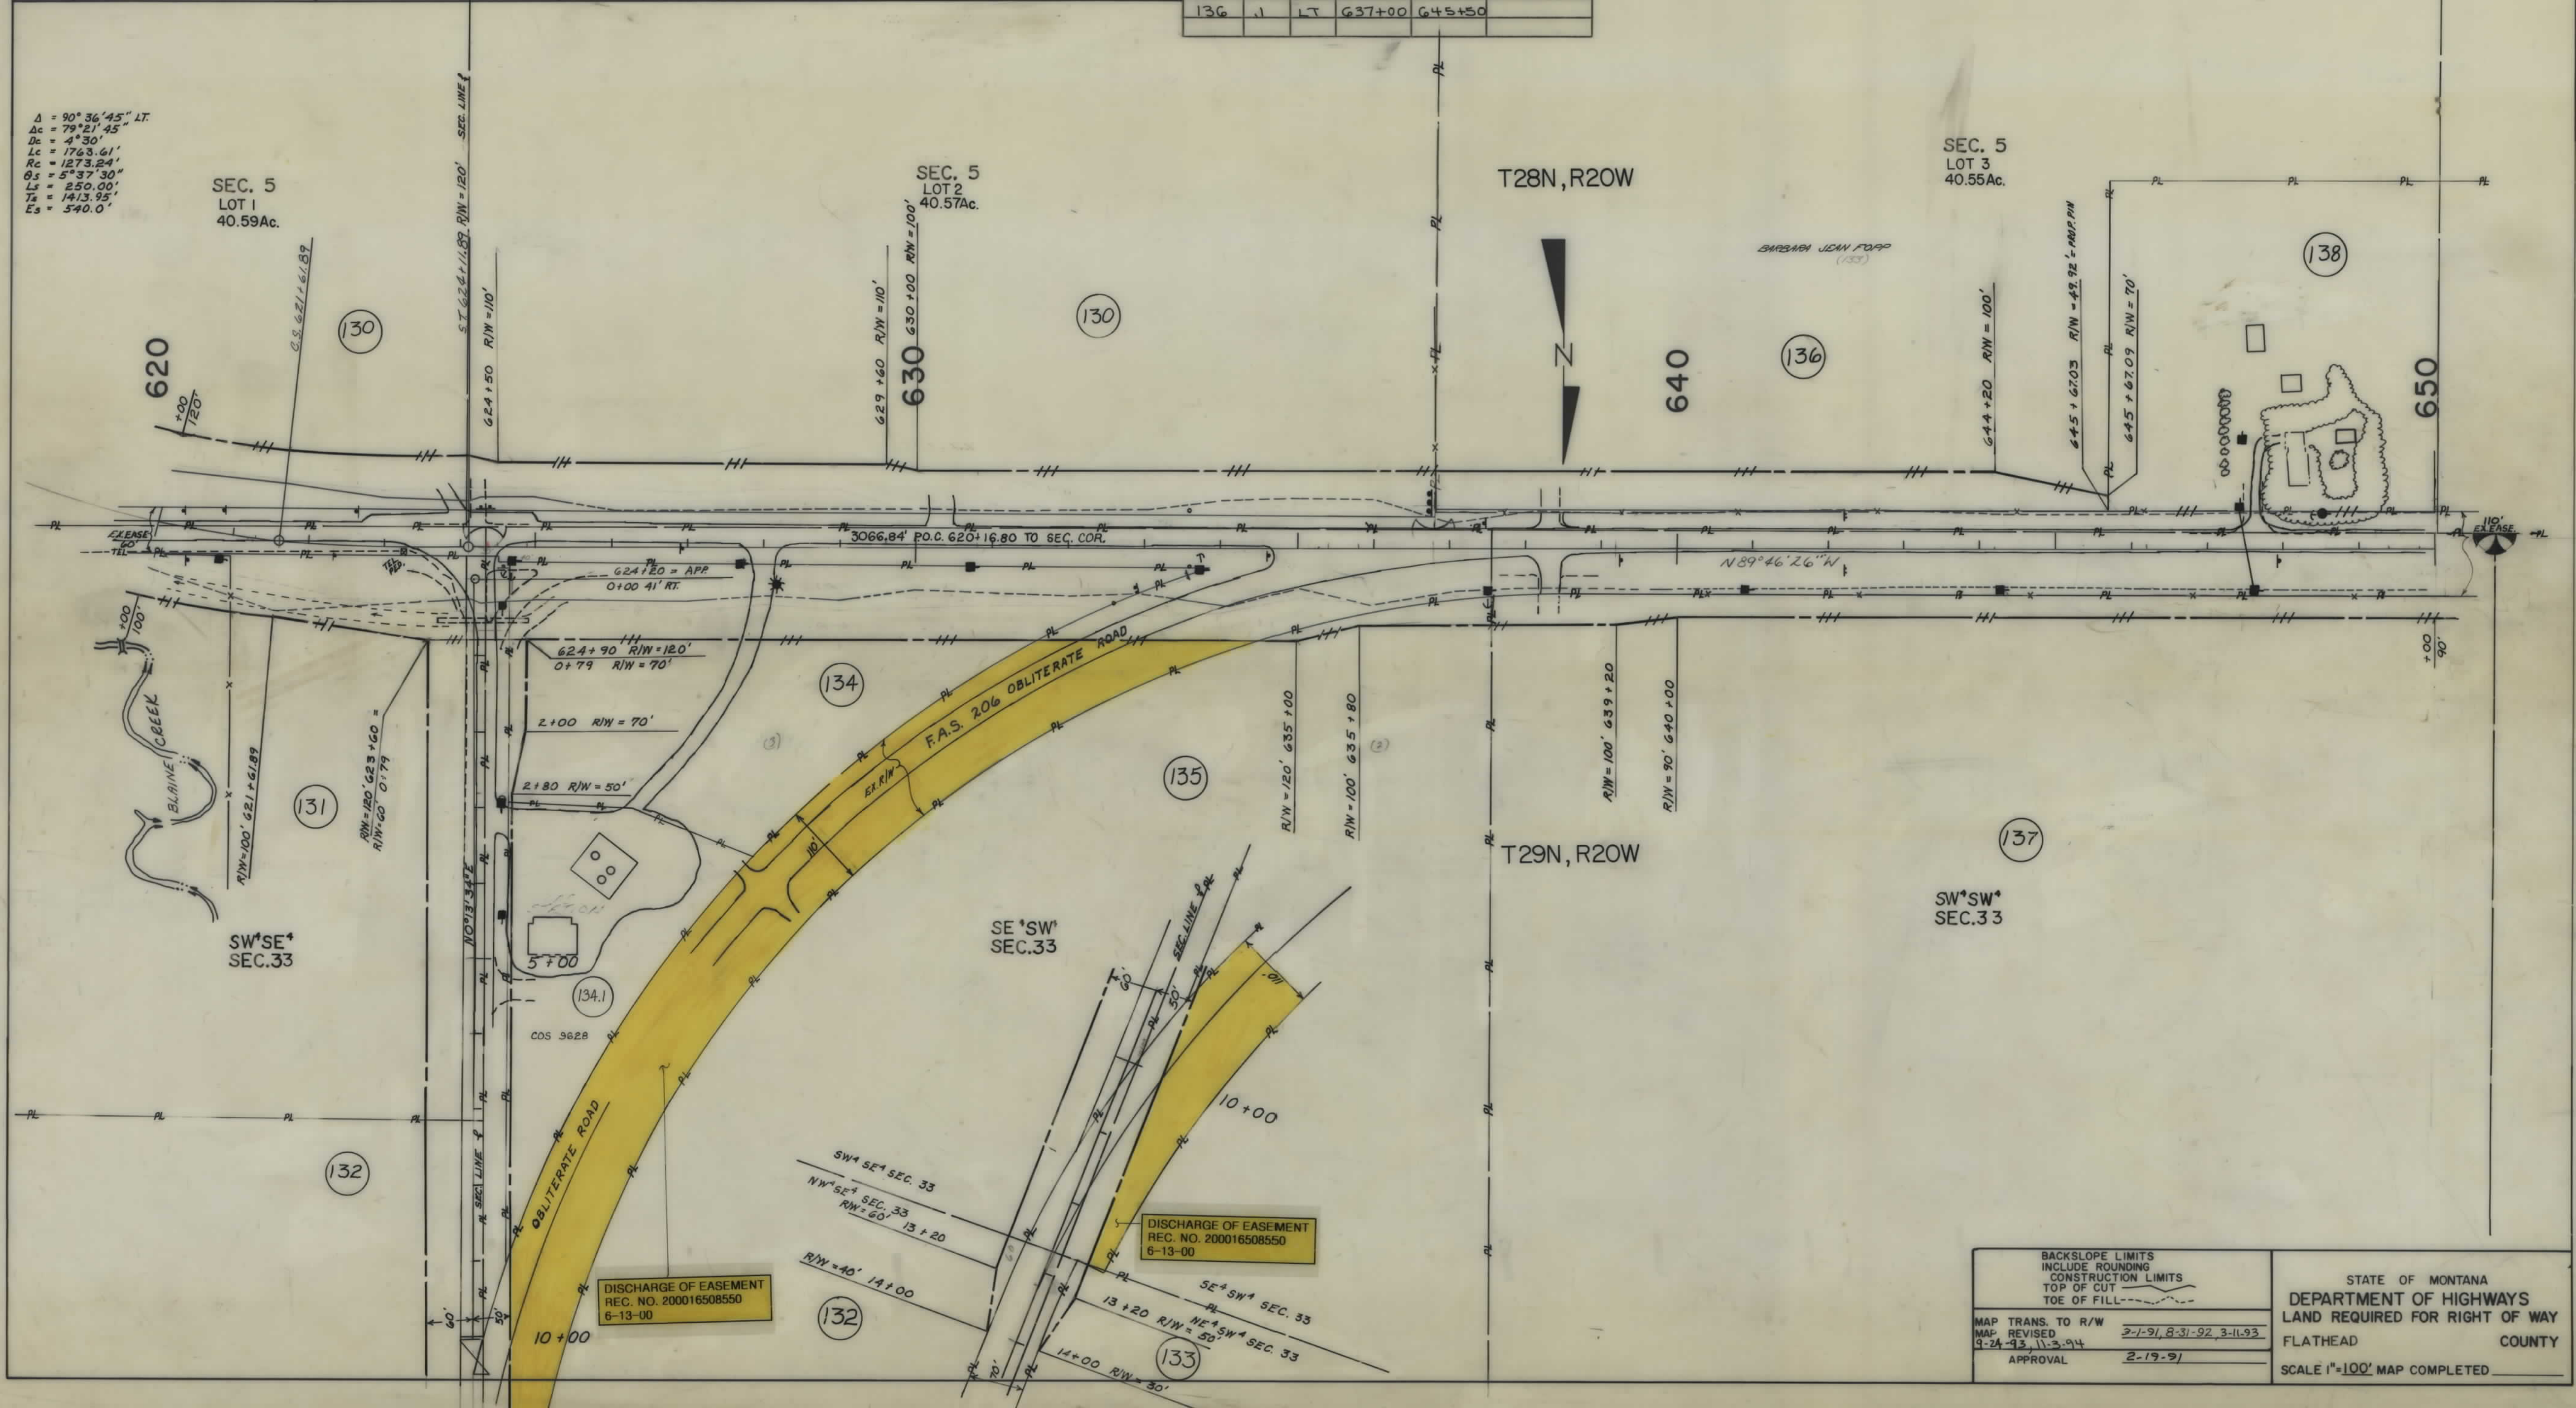

BACKSLOPE LIMITS INCLUDE ROUNDING CONSTRUCTION LIMITS TOP OF CUT TOE OF FILL		STATE OF MONTANA DEPARTMENT OF HIGHWAYS LAND REQUIRED FOR RIGHT OF WAY FLATHEAD COUNTY	
MAP TRANS. TO R/W 9-24-93, 11-3-94	2-1-91, 8-31-92, 3-11-93	SCALE 1"=100' MAP COMPLETED	
APPROVAL	2-19-91		

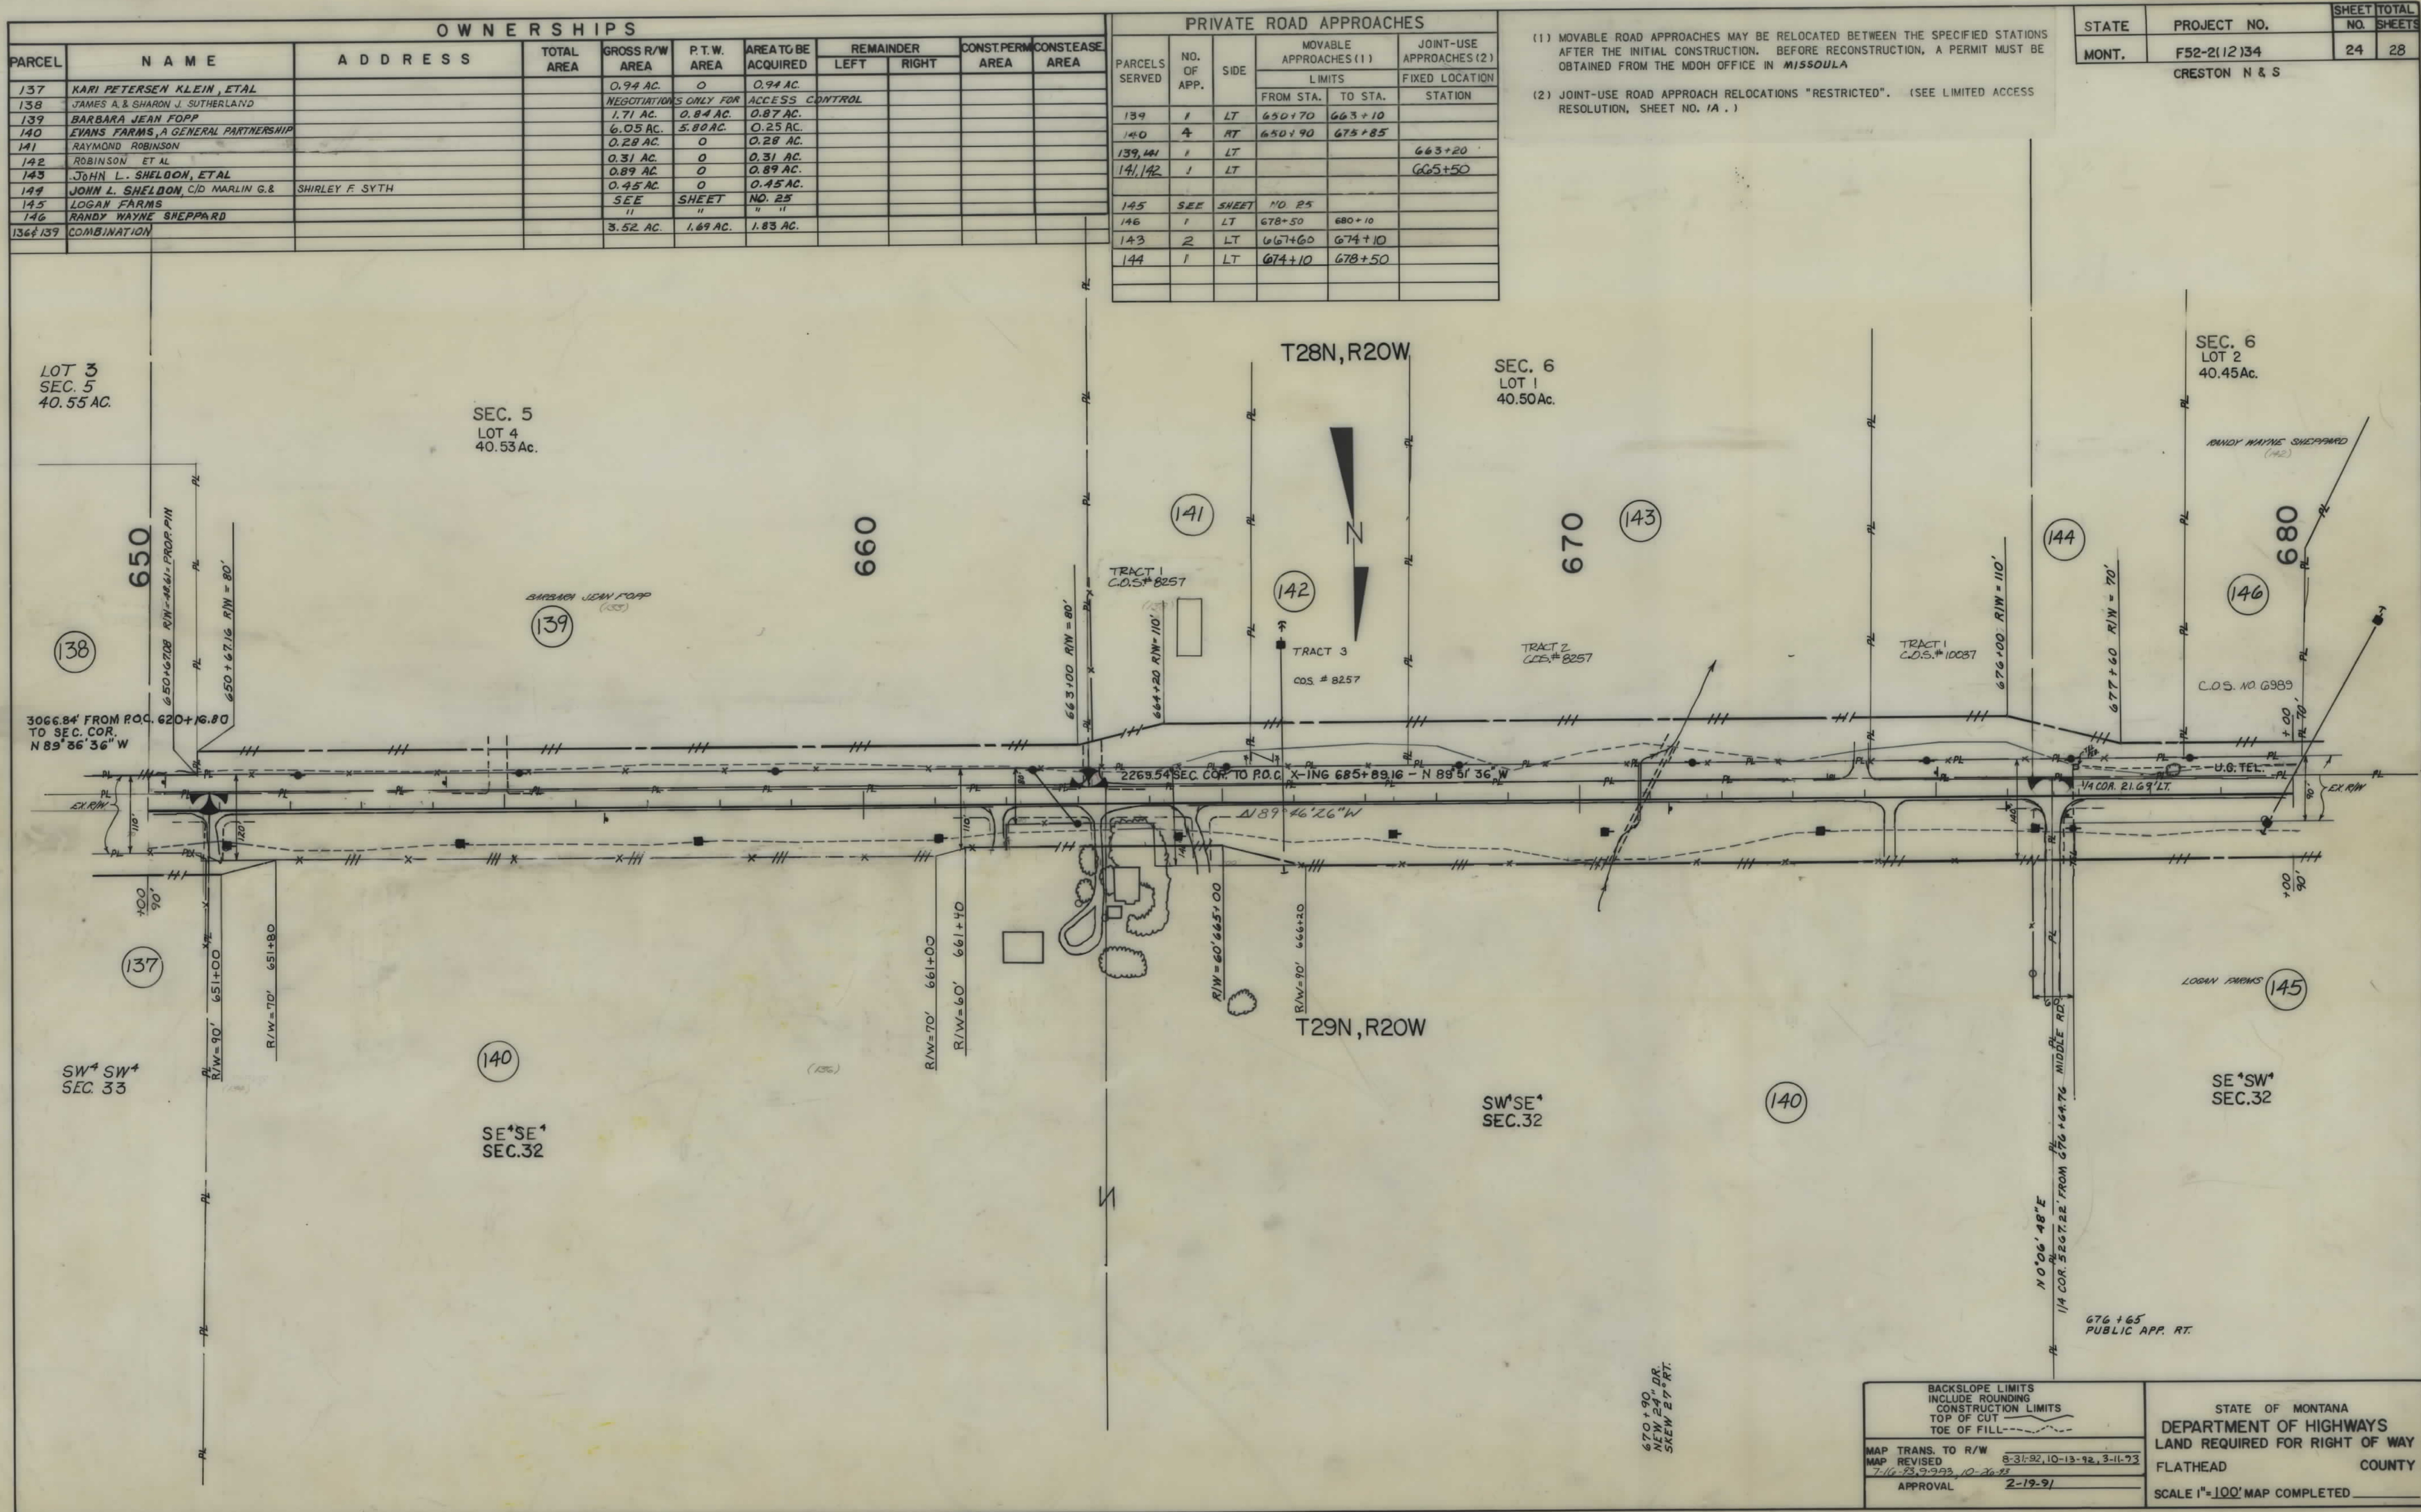

OWNERSHIPS									
PARCEL	N A M E	A D D R E S S	TOTAL AREA	GROSS R/W AREA	P.T.W. AREA	AREA TO BE ACQUIRED	REMAINDER		CONST. PERM. AREA
137	KARI PETERSEN KLEIN, ETAL			0.94 AC.	0	0.94 AC.			
138	JAMES A. & SHARON J. SUTHERLAND			NEGOTIATIONS ONLY FOR ACCESS CONTROL					
139	BARBARA JEAN FOPP			1.71 AC.	0.84 AC.	0.87 AC.			
140	EVANS FARMS, A GENERAL PARTNERSHIP			6.05 AC.	5.80 AC.	0.25 AC.			
141	RAYMOND ROBINSON			0.28 AC.	0	0.28 AC.			
142	ROBINSON ET AL			0.31 AC.	0	0.31 AC.			
143	JOHN L. SHELTON, ETAL			0.89 AC.	0	0.89 AC.			
144	JOHN L. SHELTON, C/D MARLIN G. & SHIRLEY F. SYTH			0.45 AC.	0	0.45 AC.			
145	LOGAN FARMS			SEE SHEET NO. 25					
146	RANDY WAYNE SHEPPARD			"	"	"			
136 & 139	COMBINATION			3.52 AC.	1.69 AC.	1.83 AC.			

PRIVATE ROAD APPROACHES				
PARCELS SERVED	NO. OF APP.	SIDE	MOVABLE APPROACHES (1)	
			FROM STA.	TO STA.
139	1	LT	650+70	663+10
140	4	RT	650+90	673+85
139, 141	1	LT		663+20
141, 142	1	LT		665+50
145	SEE SHEET NO. 25			
146	1	LT	678+50	680+10
143	2	LT	667+60	674+10
144	1	LT	674+10	678+50

(1) MOVABLE ROAD APPROACHES MAY BE RELOCATED BETWEEN THE SPECIFIED STATIONS AFTER THE INITIAL CONSTRUCTION. BEFORE RECONSTRUCTION, A PERMIT MUST BE OBTAINED FROM THE MDOT OFFICE IN MISSOULA

(2) JOINT-USE ROAD APPROACH RELOCATIONS "RESTRICTED". (SEE LIMITED ACCESS RESOLUTION, SHEET NO. 1A.)

STATE	PROJECT NO.	SHEET TOTAL	
MONT.	F52-2(12)34	24	28
	CRESTON N & S		

BACKSLOPE LIMITS INCLUDE ROUNDING CONSTRUCTION LIMITS TOP OF CUT TOE OF FILL

MAP TRANS. TO R/W 8-31-82, 10-13-92, 3-11-93
MAP REVISED 7-11-93, 9-23-93, 10-26-93
APPROVAL 2-19-91

STATE OF MONTANA
DEPARTMENT OF HIGHWAYS
LAND REQUIRED FOR RIGHT OF WAY
FLATHEAD COUNTY
SCALE 1"=100' MAP COMPLETED


OWNERSHIPS										PRIVATE ROAD APPROACHES				STATE	PROJECT NO.	SHEET TOTAL
PARCEL	NAME	ADDRESS	TOTAL AREA	GROSS R/W AREA	P.T.W. AREA	AREA TO BE ACQUIRED	REMAINDER		CONST. PERM. AREA	CONST. EASE. AREA	PARCELS SERVED	NO. OF APP.	SIDE	MOVABLE APPROACHES (1) LIMITS	JOINT-USE APPROACHES (2) FIXED LOCATION	NO. SHEETS
145	LOGAN FARMS			3.62 AC.	1.49 AC.	2.13 AC.								FROM STA. TO STA.	STATION	25
146	RANDY WAYNE SHEPPARD			*0.08 AC.	0	*0.08 AC.										28
147	LARRY A. & KATHLEEN C. GARRISON			0.26 AC.	0	0.26 AC.					147	1	LT.	680+10	686+00	
148	LEORA M. SHELTON			0.43 AC.	0	0.43 AC.					148	1	LT.	686+05	689+70	
149	PATRICIA A. LAMBRECHT			0.07 AC.	0	0.07 AC.					149	1	LT.	689+78	690+35	
150	DANIEL PAUL & CINDY ANN LUCAS			1.42 AC.	0	1.42 AC.					151		SEE SHEET	NO 26		
151	VERNON G. & PHYLLIS M. KNOLL			SEE SHEET	SEE SHEET	NO. 26										

* TO BE ACQUIRED AS EASEMENT

(1) MOVABLE ROAD APPROACHES MAY BE RELOCATED BETWEEN THE SPECIFIED STATIONS AFTER THE INITIAL CONSTRUCTION. BEFORE RECONSTRUCTION, A PERMIT MUST BE OBTAINED FROM THE MDOT OFFICE IN MISSOULA.

(2) JOINT-USE ROAD APPROACH RELOCATION "RESTRICTED". (SEE LIMITED ACCESS RESOLUTION, SHEET NO. 1A.)

STATE MONT.
PROJECT NO. F52-21(12)34
CRESTON N & S

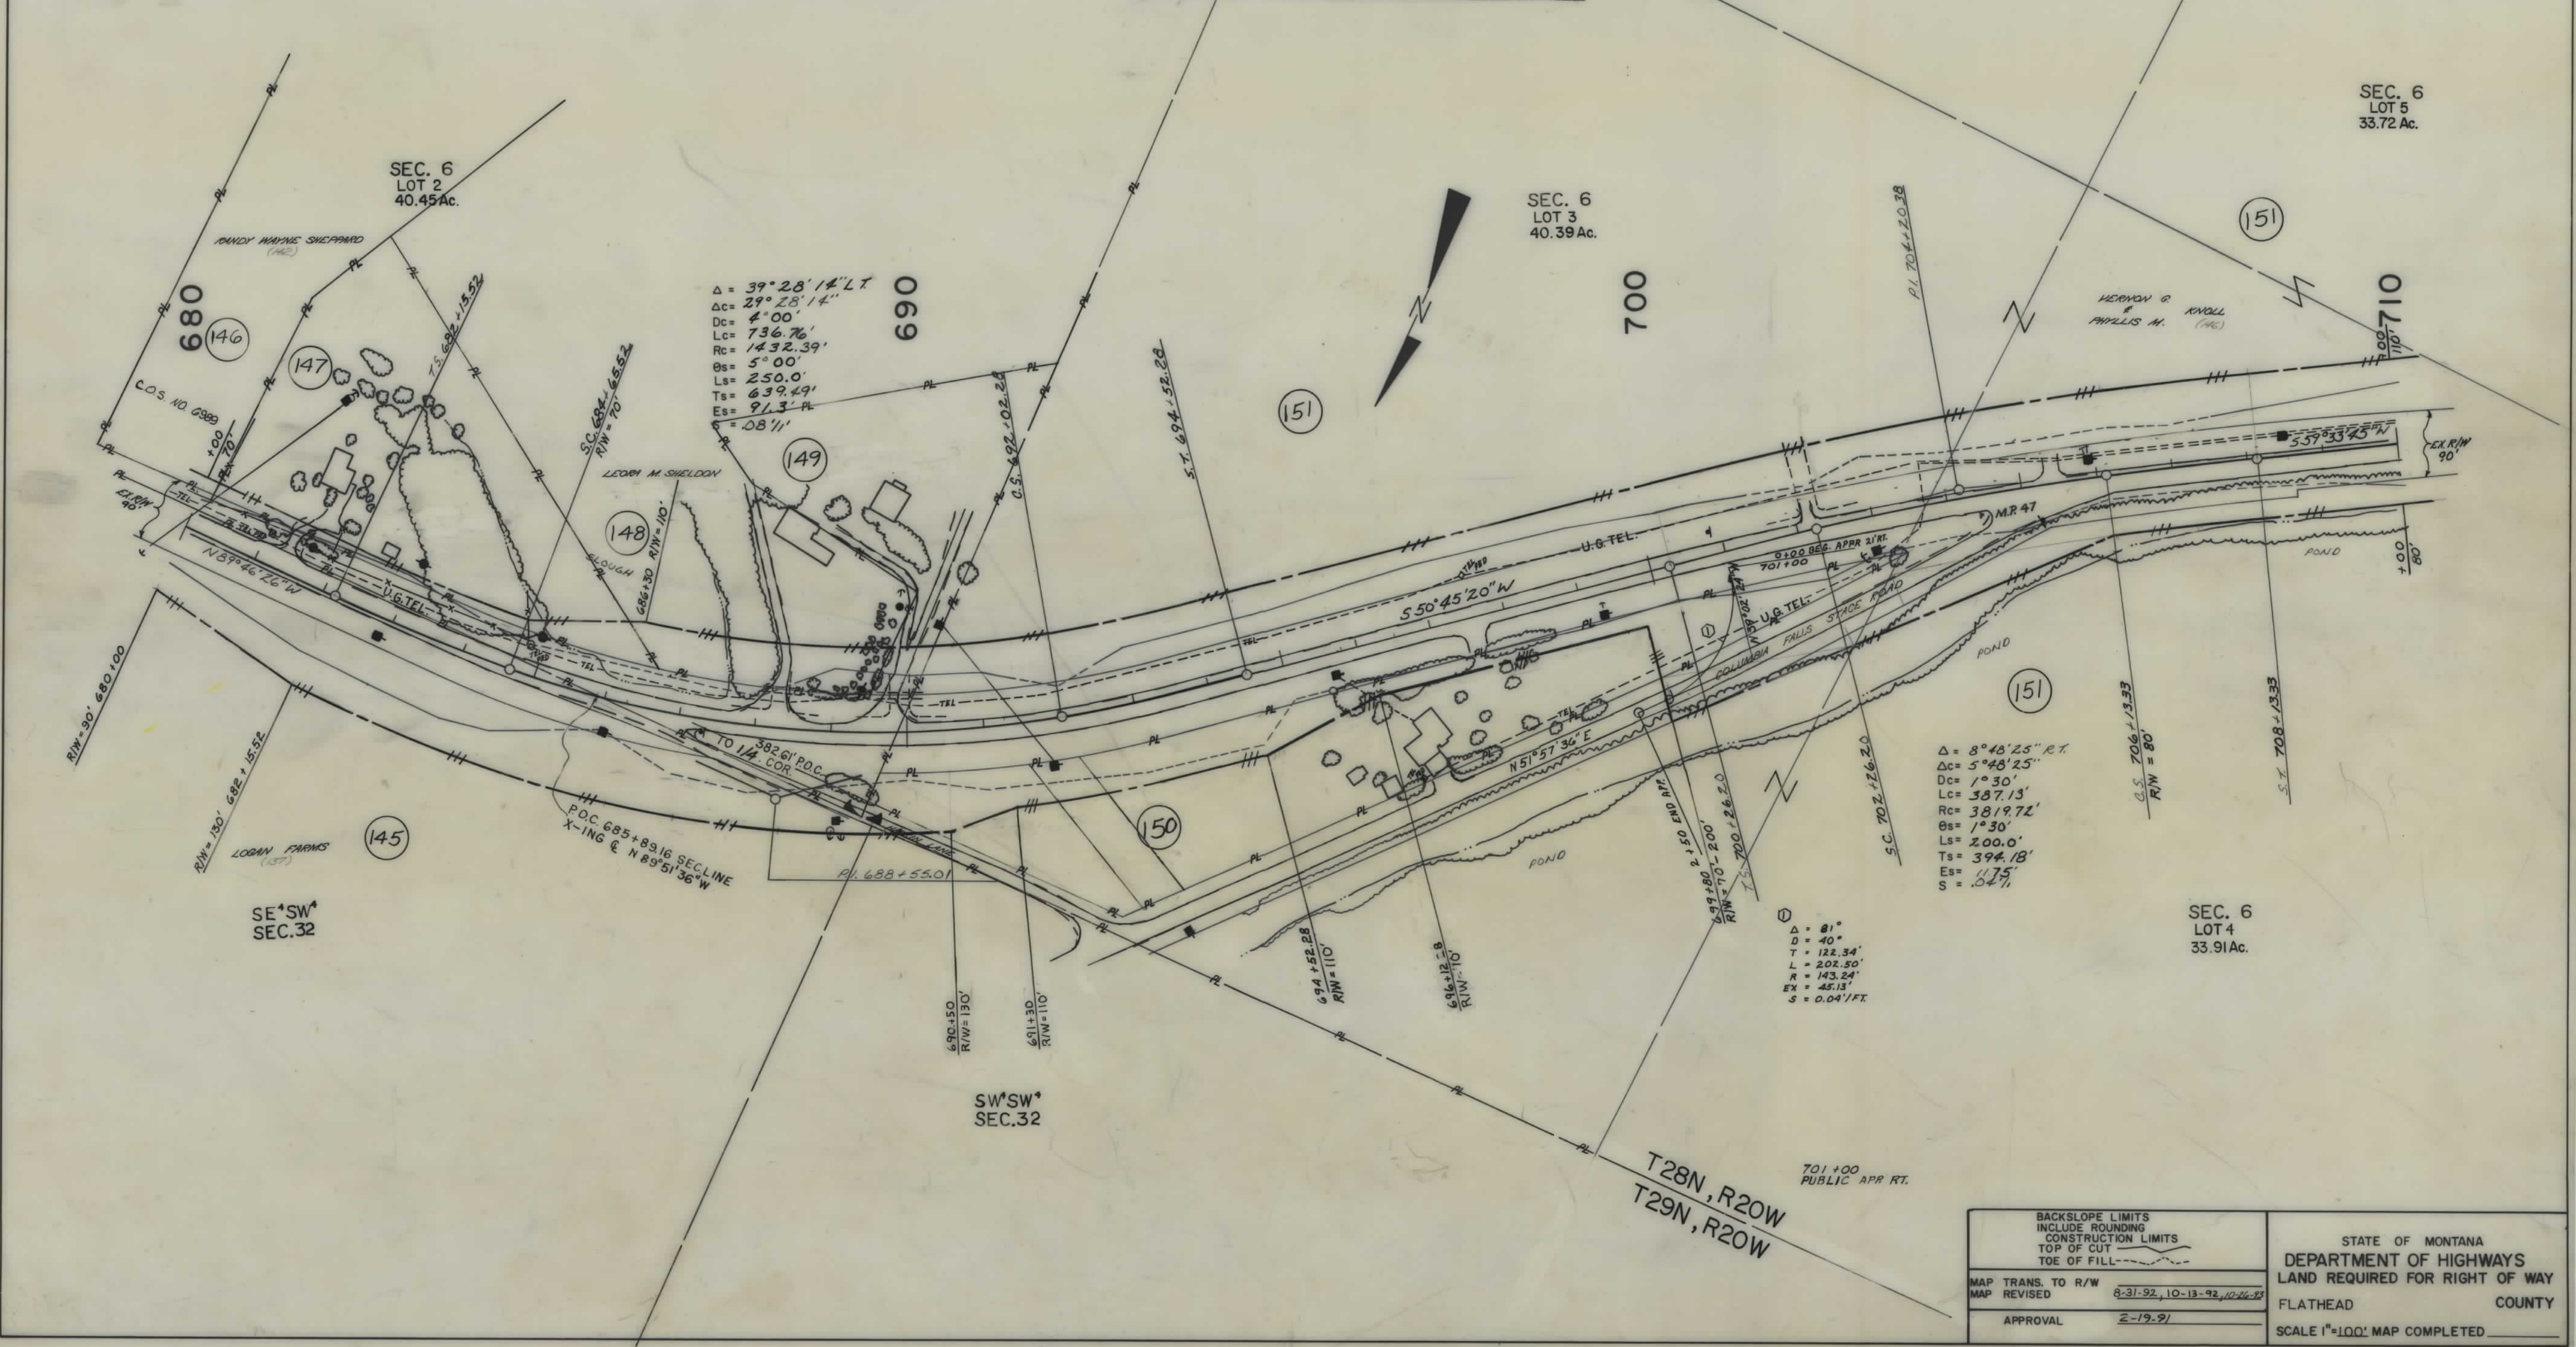


OWNERSHIPS									
PARCEL	NAME	ADDRESS	TOTAL AREA	GROSS R/W AREA	P.T.W. AREA	AREA TO BE ACQUIRED	REMAINDER	CONST. PERM. AREA	EASE AREA
164	MEL E. & MILLY N. JUKICH C/D EPHRAIM H. MAY		2.64 AC.	0.34 AC.	0	0.34 AC.	2.30 AC.		
165	JERRY D. & LORRAINE A. OLSEN		43.866 SF	68.69 SF	0	68.69 SF	36.997 SF		
166	WANDA MOORE BEARS							0.04 AC.	
167	JOHN L. & MARY C. KLOECKL							0.14 AC.	
168	MEL E. JUKICH-ETAL C/D GARY F. GOERS			0.21 AC.	0.01 AC.	0.20 AC.		0.09 AC.	
169	MAURICE MICHAEL & MARY ANN MANNING			0.91 AC.	0.04 AC.	0.87 AC.			
170	COLIN JOHNSON, THE ROCKY MOUNTAIN BAPTIST CHURCH & CLINT THELINE			0.58 AC.	0.02 AC.	0.56 AC.			
171	RAYMOND REILLY KACHEL AS TRUSTEE RAYMOND ROBERT KACHEL TRUST			0.94 AC.	0	0.94 AC.			
172	DELETED								
173	WILLIAM L. & IRENE M. ENGLE			0.74 AC.	0	0.74 AC.			
174	DELETED								

PRIVATE ROAD APPROACHES					
PARCELS SERVED	NO. OF APP.	SIDE	MOVABLE APPROACHES (1) LIMITS	JOINT-USE APPROACHES (2) FIXED LOCATION	
			FROM STA.	TO STA.	STATION
166	1	LT	770+64	771+45	
167	2	LT	771+50	774+11	
168	1	RT	770+90	774+11	
169	1	LT	775+62	781+30	
170	1	RT	775+62	781+30	
171	1	LT	781+41	787+78	
172	1	RT	781+39	787+75	
165	1	LT	768+80	770+60	

(1) MOVABLE ROAD APPROACHES MAY BE RELOCATED BETWEEN THE SPECIFIED STATIONS AFTER THE INITIAL CONSTRUCTION. BEFORE RECONSTRUCTION, A PERMIT MUST BE OBTAINED FROM THE MDH OFFICE IN MISSOULA.

(2) JOINT-USE ROAD APPROACH RELOCATIONS "RESTRICTED". (SEE LIMITED ACCESS RESOLUTION, SHEET NO. 1A.)

STATE	PROJECT NO.	SHEET TOTAL
MONT.	F52-2(12)34	28 28
	CRESTON N & S	

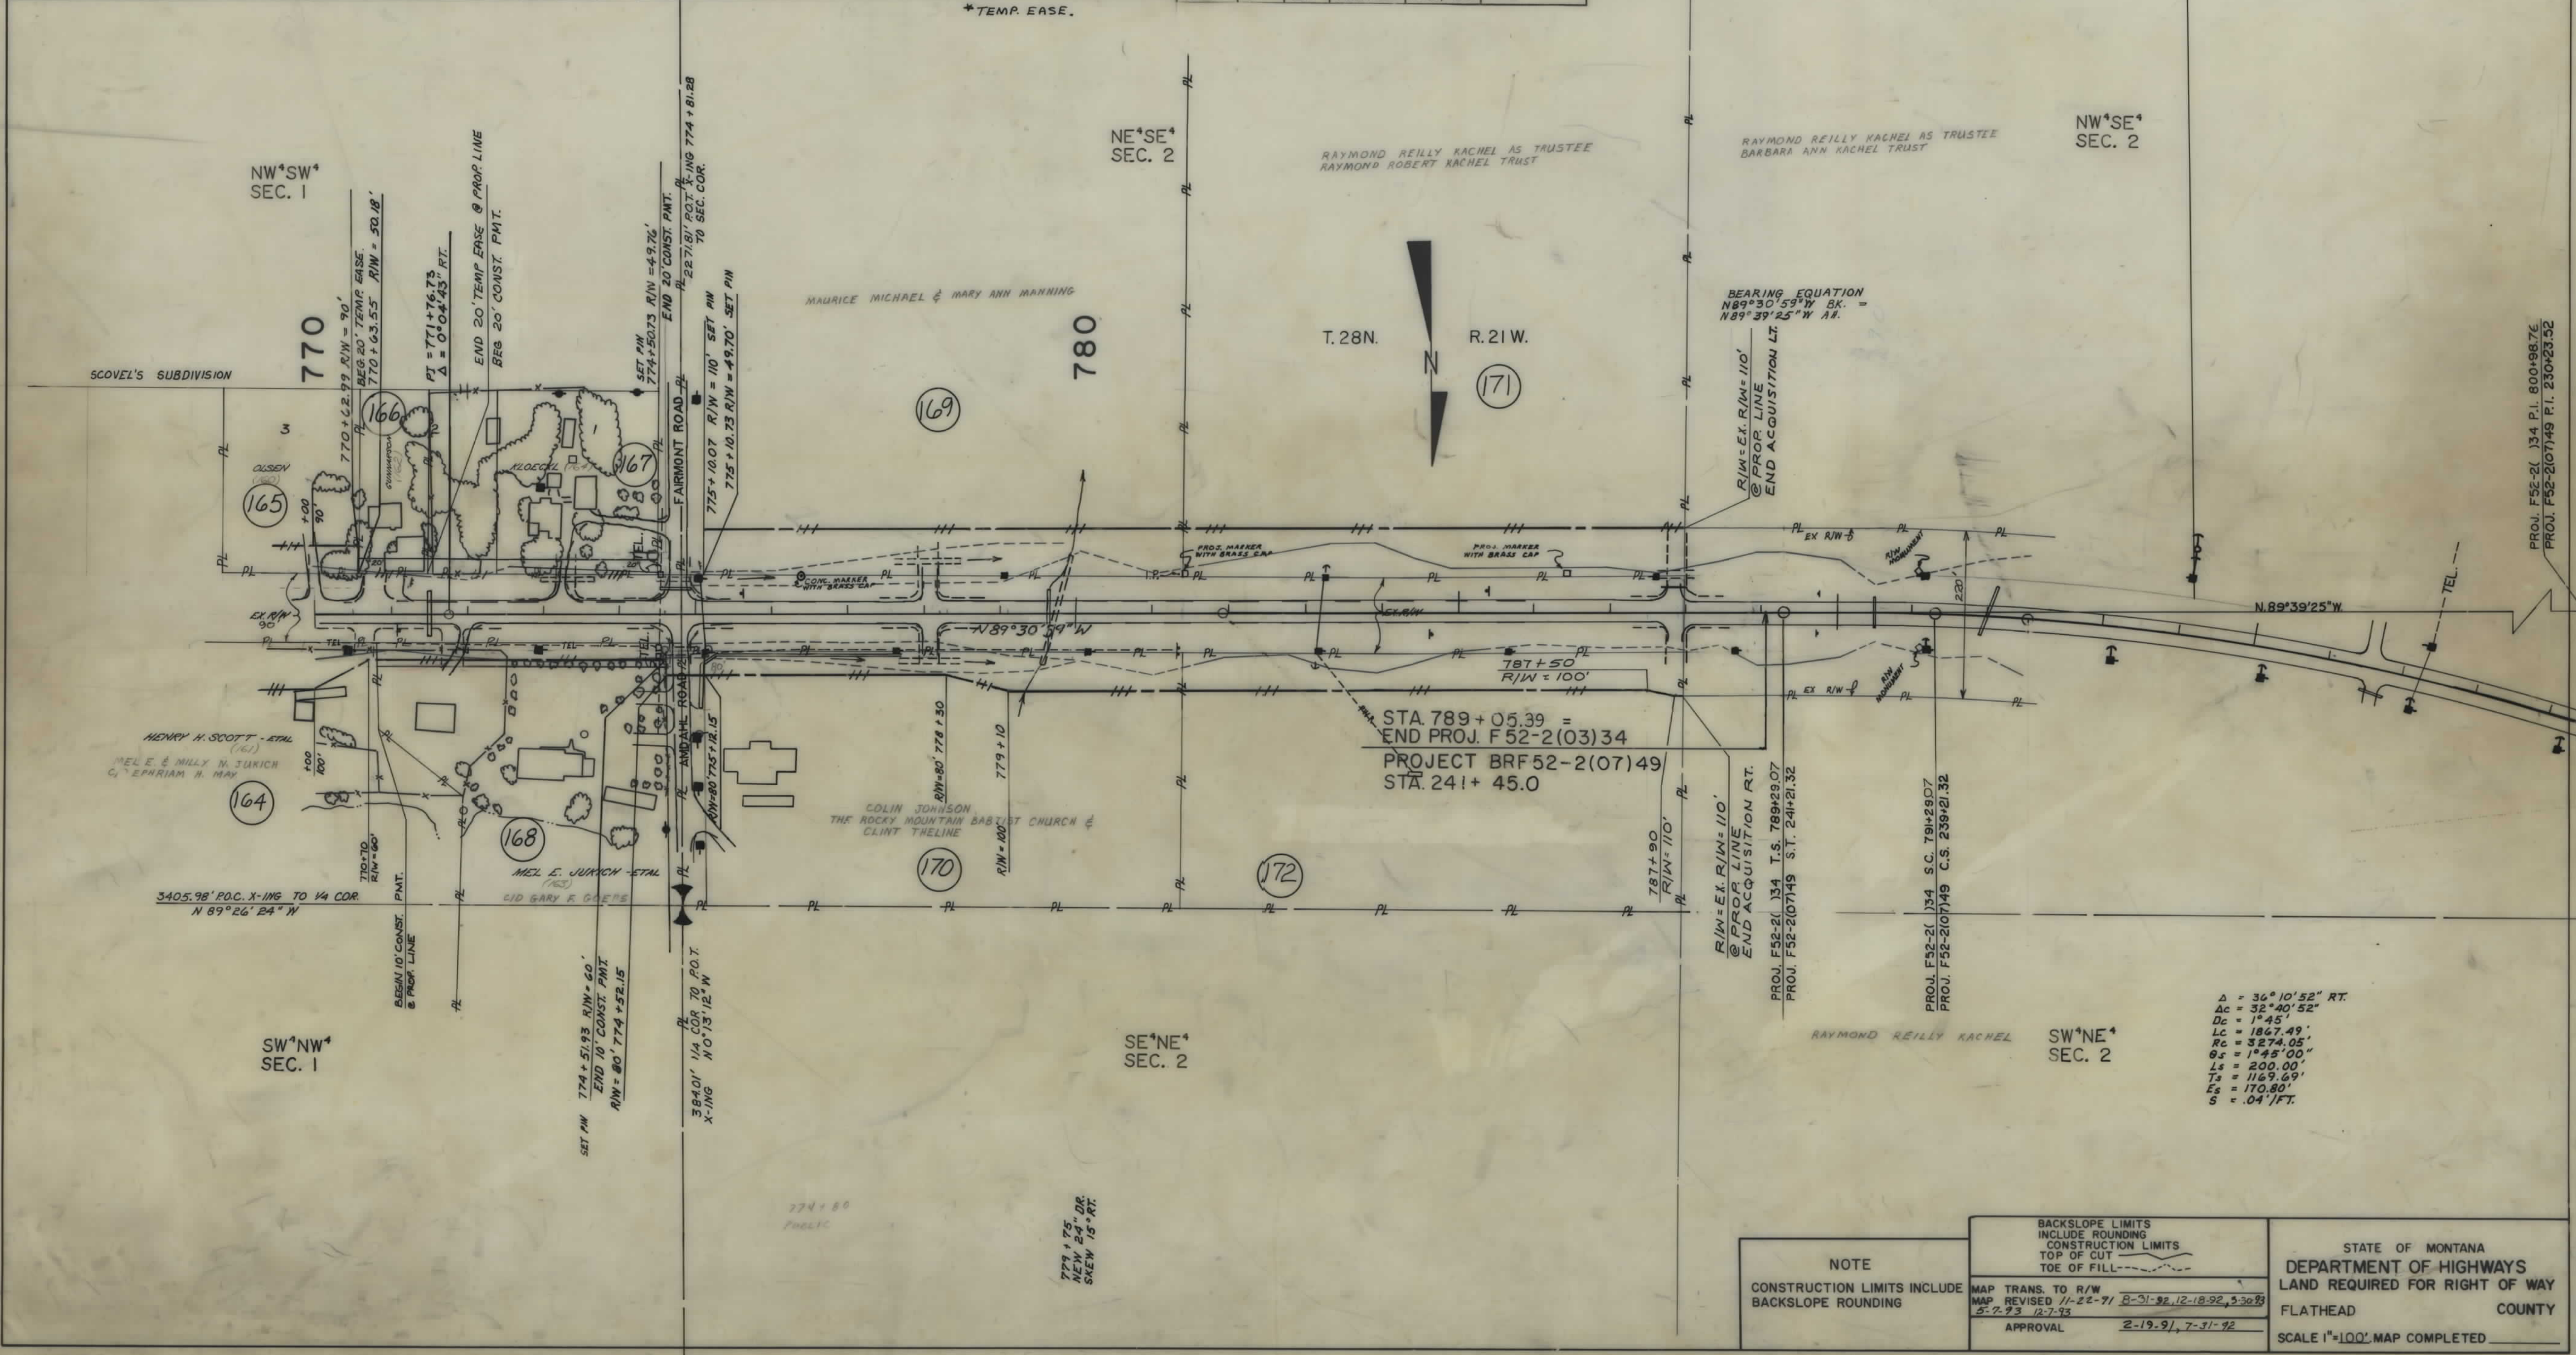

NOTE

CONSTRUCTION LIMITS INCLUDE BACKSLOPE ROUNDING

BACKSLOPE LIMITS INCLUDE ROUNDING CONSTRUCTION LIMITS TOP OF CUT TOE OF FILL

MAP TRANS. TO R/W 11-22-71 8-21-82, 12-18-82, 3-30-83

MAP REVISED 11-22-71 5-7-73 12-7-73

APPROVAL 2-19-91, 7-31-92

STATE OF MONTANA

DEPARTMENT OF HIGHWAYS

LAND REQUIRED FOR RIGHT OF WAY

FLATHEAD COUNTY

SCALE 1"=100' MAP COMPLETED