

PLANS
NOT
TO
SCALE

FED. ROAD DIST. NO.	STATE	FED. AID PROJECT NUMBERS		STATE NO.	SHEET NO.	TOTAL SHEETS
		CONST. NO.	R/W NO.			
8	MONT.		S-59(3)	3059-03	1	4

As built only

ALDER - RUBY DAM


STATE OF MONTANA
STATE HIGHWAY COMMISSION

RIGHT OF WAY PLAN OF
FEDERAL AID PROJECT NO. S-59(3) R W
S-59() CONST.

ALDER - RUBY DAM
LENGTH 2.576 MILES



INDEX		
PARCEL NO.	OWNERSHIPS	SHEET NO.
1,5,6,13,20,25	ROBERT, SAMUEL & WILLIAM MALONEY	2, 3, 4.
2	HAROLD & CLARICE GRIFFIN	2
3	GUY WARREN & SAM MALONEY	2
4,6,11,12,15,17	HAROLD JAMES & KENNETH WIER	2, 3, 4
7,8,9,10,13,14	U. S. A.	2, 3
19	STATE WATER CONSERVATION BOARD	4
21,22,	WILLIAM & ETHEL POWERS	4

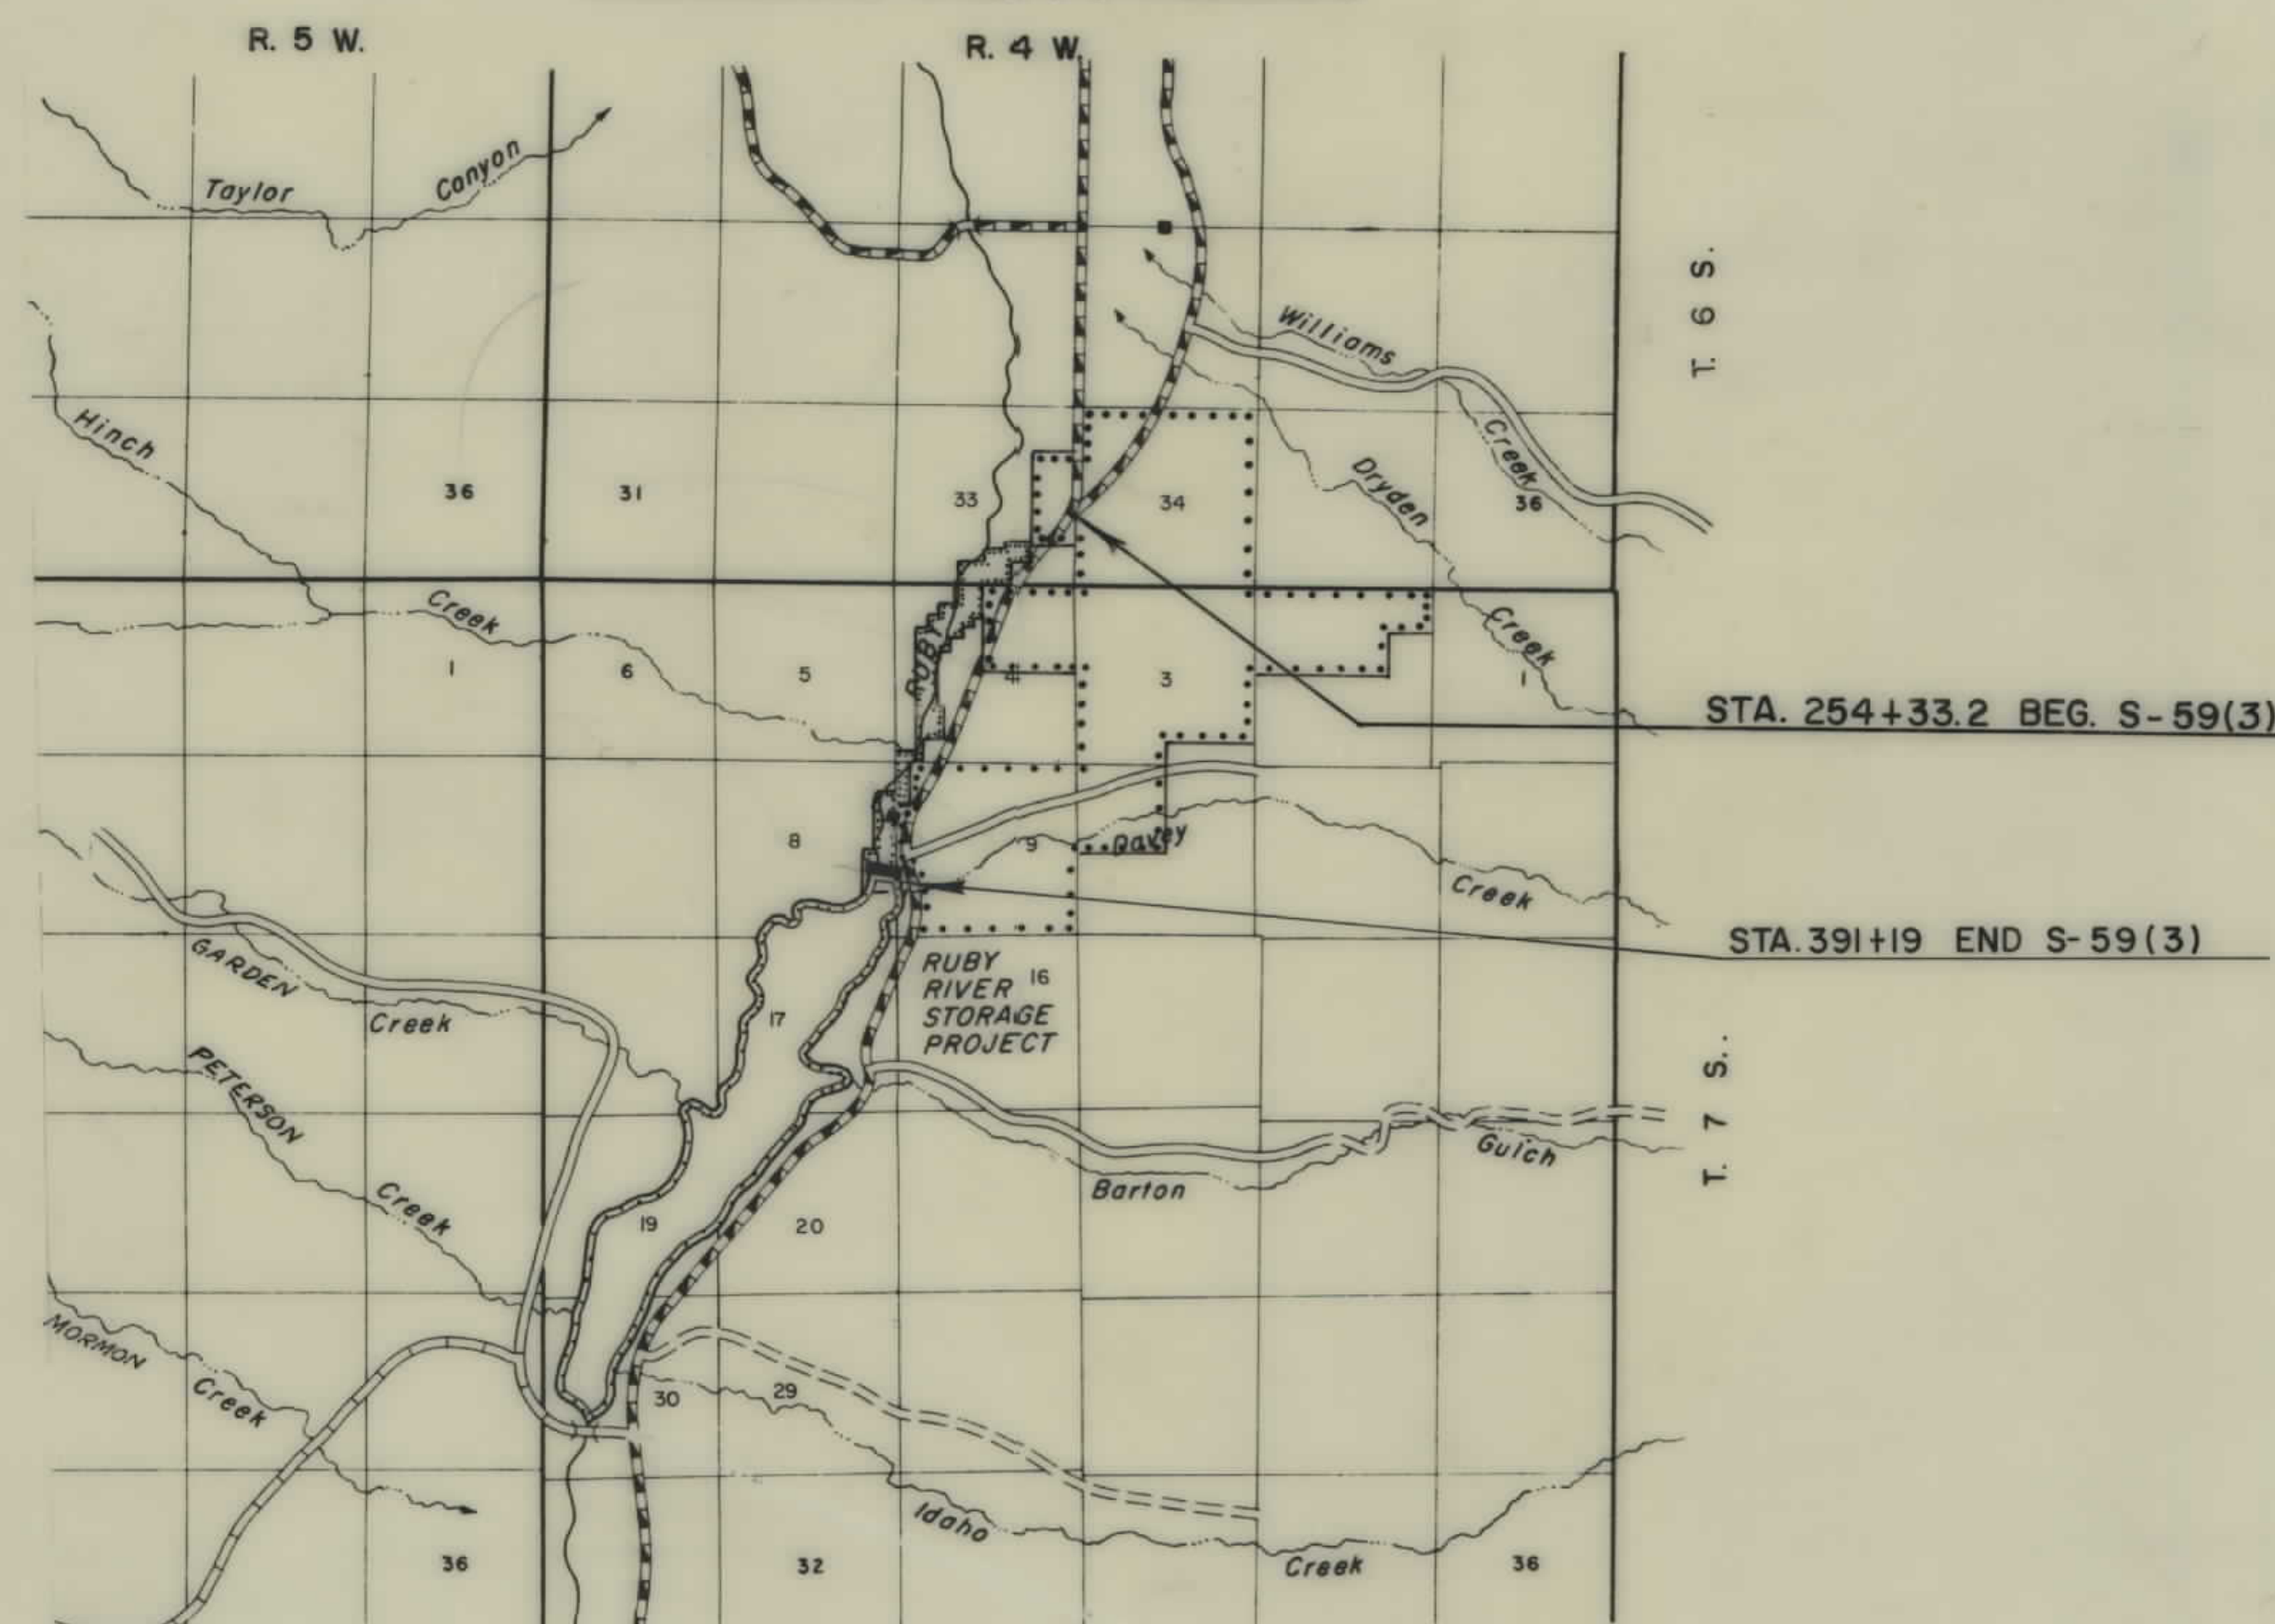


CONVENTIONAL SIGNS

STATE AND NATIONAL LINE	— — — — —
COUNTY LINE	— — — — —
CITY, VILLAGE OR BOROUGH LINE	— — — — —
TOWNSHIP LINE	— — — — —
SECTION LINE	— — — — —
RESERVATION LINE	— — — — —
FENCE LINE	— — — — —
GUARD RAIL	— — — — —
OWNERSHIP BOUNDARY	— — — — —
RIGHT OF WAY LINE	— — — — —
RIGHT OF WAY LINE FENCED	— — — — —
TRAVELED WAY	— — — — —
RAILROADS	— — — — —
RETAINING WALLS	— — — — —
BASE OR SURVEY LINE	— — — — —
LEVEE	— — — — —
CULVERTS IN PLACE (PLAN)	— — — — —
NEW CULVERTS (PLAN)	— — — — —
NEW CULVERTS (PROFILE)	— — — — —
TROLLEY POLE	— — — — —
POWER POLE	— — — — —
TELEPHONE OR TELEGRAPH POLE	— — — — —
MARSH	— — — — —
DITCH	— — — — —
RIPRAP	— — — — —
BRIDGE	— — — — —
SECTION CORNER	FOUND UNFOUND
1/4 SECTION CORNER	FOUND UNFOUND
1/16 CORNER	FOUND UNFOUND
CENTER OF SECTION	— — — — —
CONTROL OF ACCESS WITH FENCE	— — — — —
CONTROL OF ACCESS WITHOUT FENCE	— — — — —
PARCEL NUMBER	— — — — —
CATTLE GUARD	— — — — —
GATE IN FENCE	— — — — —
CONSTRUCTION LIMITS	CUT FILL

MAP TRANS. TO R/W
MAP REVISED
STATE APPROVAL 12/9/65, 9-15-70,

OWNERSHIPS								
PARCEL	NAME	ADDRESS	TOTAL AREA	GROSS R/W AREA	P.T.W. AREA	AREA TO BE ACQUIRED	REMAINDER	
							LEFT	RIGHT
1	ROBERT J., SAMUEL W., & WILLIAM MALONEY	ALDER, MONT.		3.53 AC.		3.53 AC.		
2	HAROLD H. & CLARICE D. GRIFFIN	ALDER, MONT.	40.41 AC.	2.57 AC.		2.57 AC.	37.84 AC.	
3	GUY WARREN & SAM MULONEY	" "	8.12 AC.	1.94 AC.		1.94 AC.	0.03 AC.	6.15 AC.
4	HAROLD L. JAMES & KENNETH L. WIER	1619 CARL ST., ST. PAUL, MINN.		1.03 AC.		1.03 AC.		
5	ROBERT J., SAMUEL W., & WM. MALONEY	ALDER, MONT.		3.05 AC.		3.05 AC.		
6	HAROLD L. JAMES & KENNETH L. WIER	1619 CARL ST., ST. PAUL, MINN.		6.00 AC.		6.00 AC.		
7	U. S. A.			0.10 AC.		0.10 AC.		

FED. ROAD DIST. NO.	STATE	FED. AID PROJECT NUMBERS		STATE NO.	SHEET NO.	TOTAL SHEETS
		CONST. NO.	R/W NO.			
8	MONT.		S-59(3)	3059-03	2	4

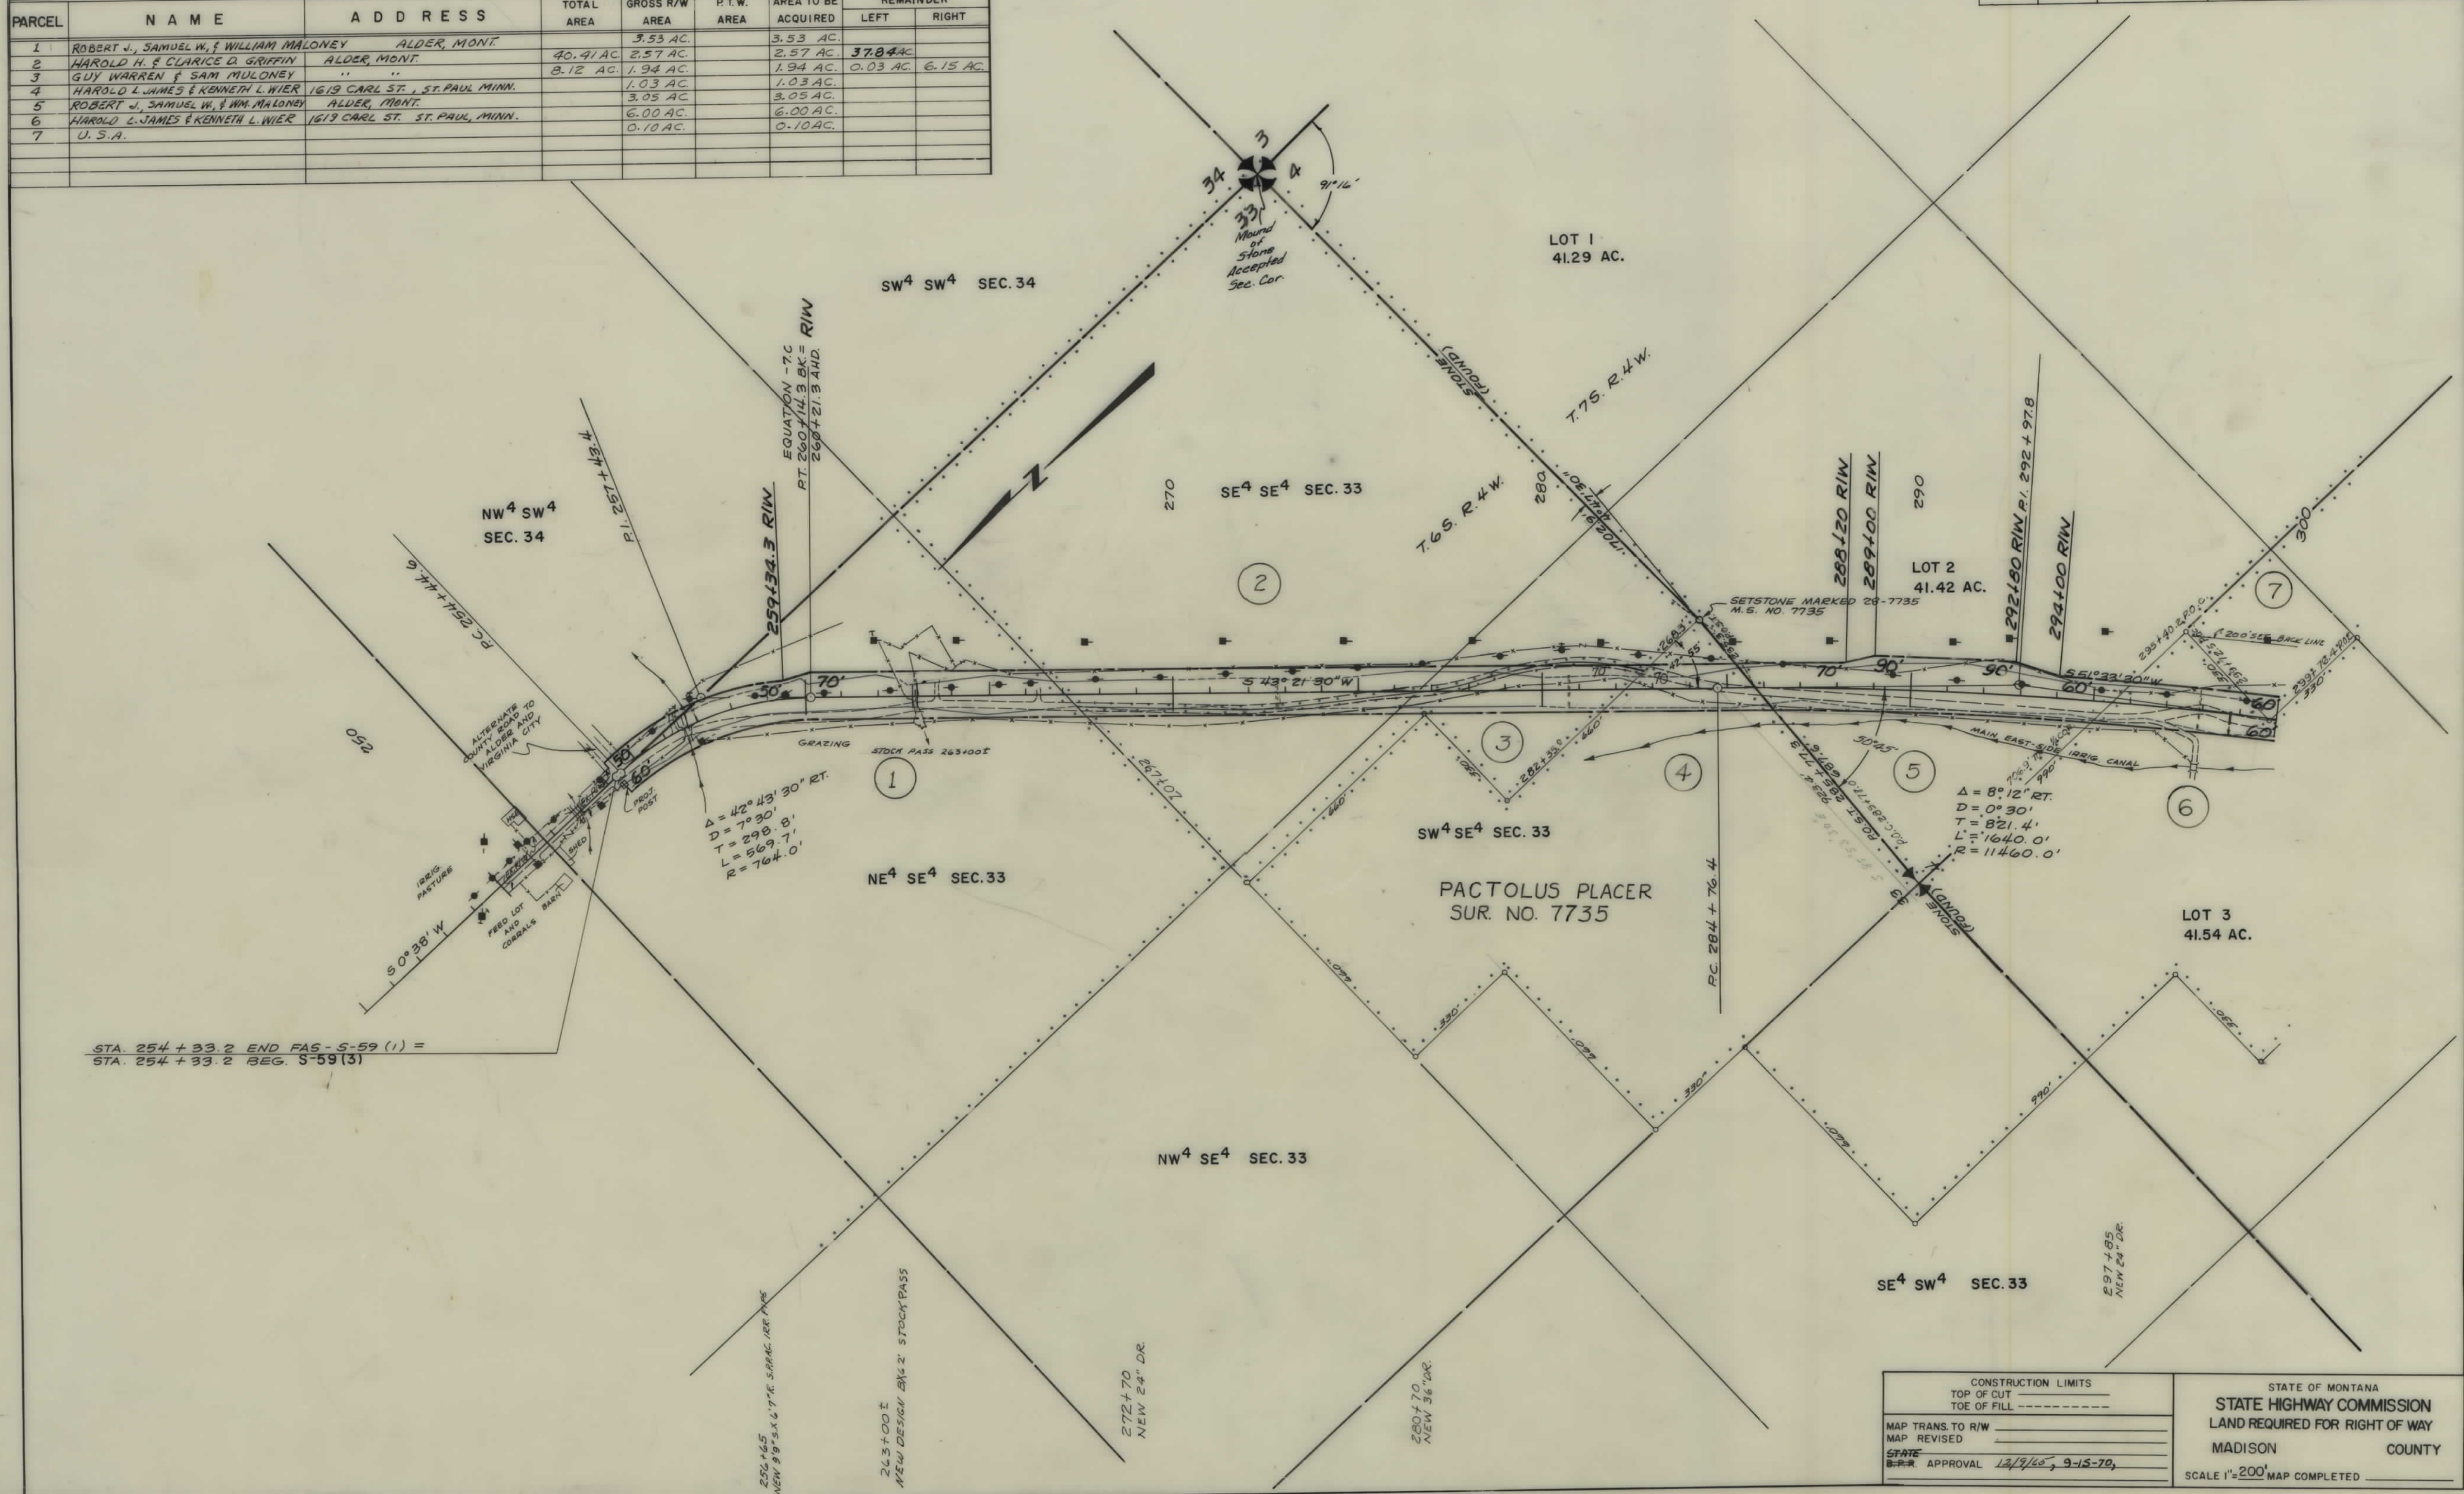

CONSTRUCTION LIMITS		STATE OF MONTANA	
TOP OF CUT		STATE HIGHWAY COMMISSION	
TOE OF FILL		LAND REQUIRED FOR RIGHT OF WAY	
MAP TRANS. TO R/W		MADISON COUNTY	
MAP REVISED		SCALE 1"=200' MAP COMPLETED	
STATE			
APPROVAL 12/19/65, 9-15-70,			

