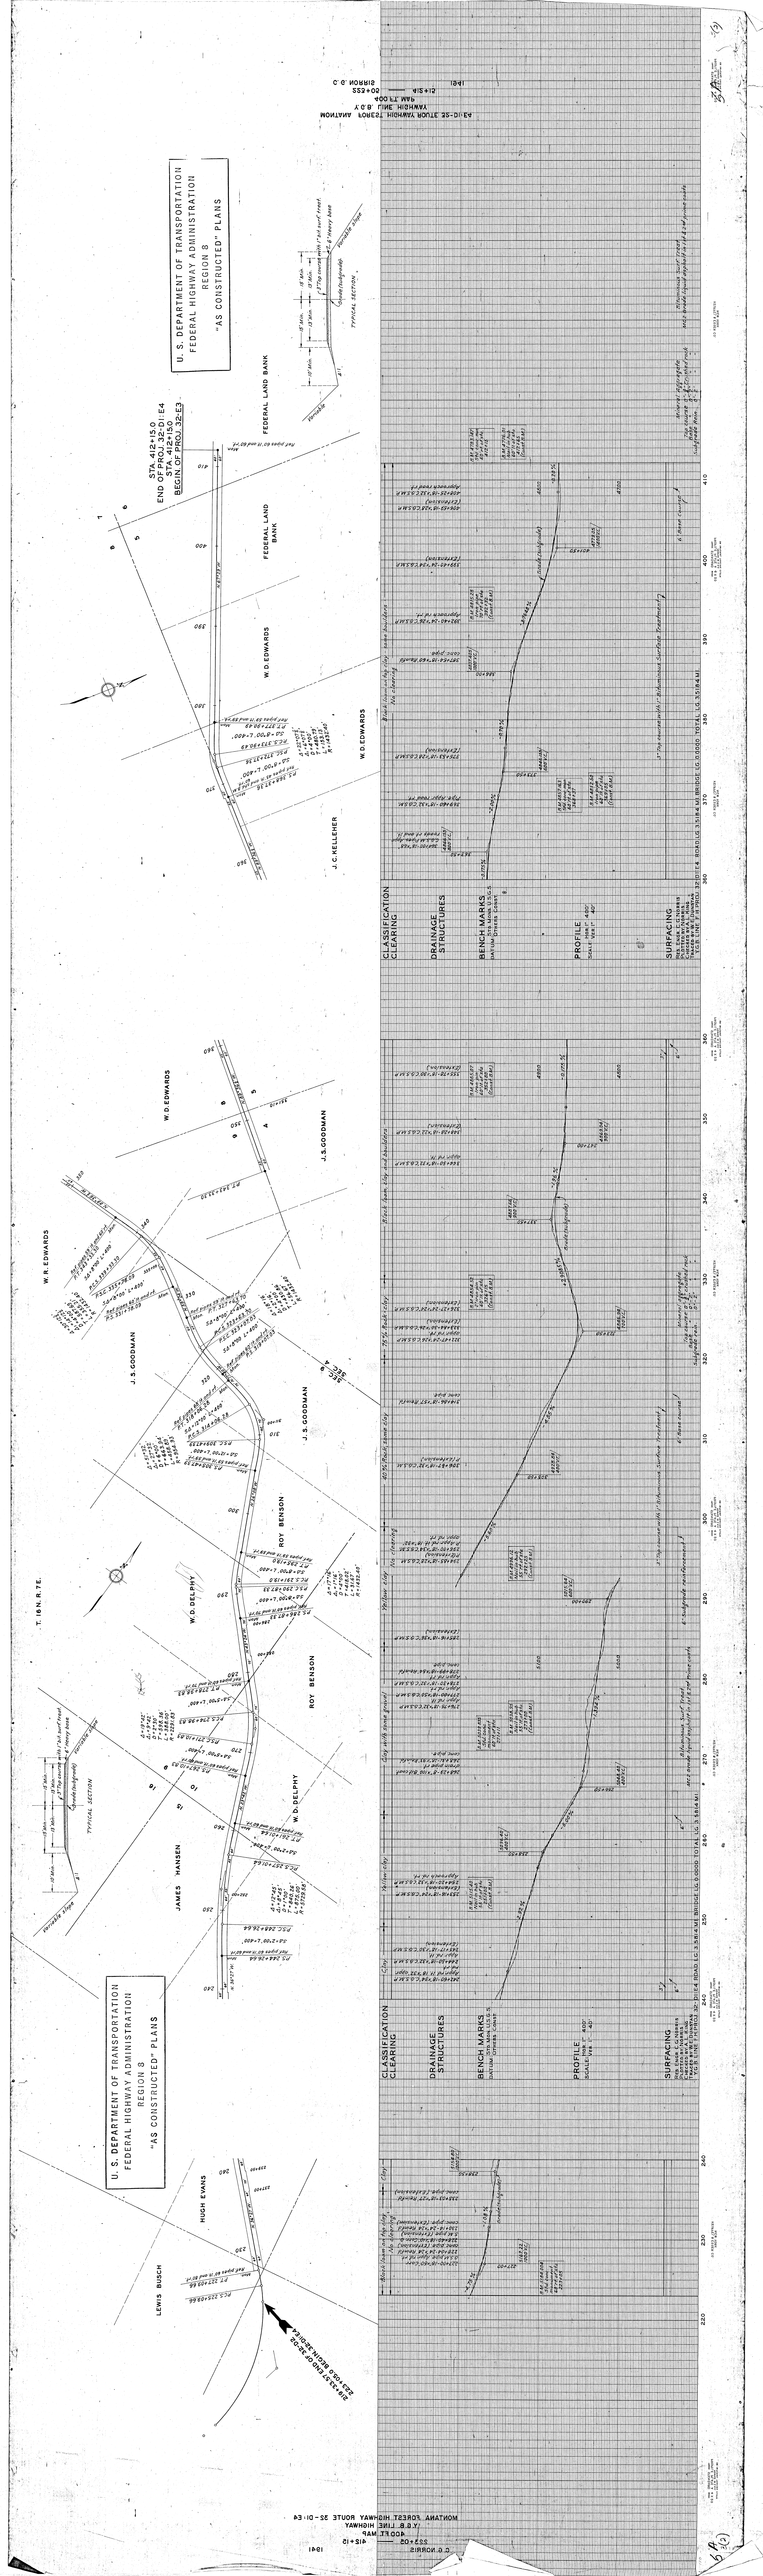
U. S. DEPARTMENT OF TRANSPORTATION
FEDERAL HIGHWAY ADMINISTRATION
REGION 8
"AS CONSTRUCTED" PLANS
U. S. DEPARTMENT OF TRANSPORTATION
FEDERAL HIGHWAY ADMINISTRATION
REGION 8
"AS CONSTRUCTED" PLANS
STA. 412+15.0
END OF PROJ. 32-D(1)E4
BEGIN OF PROJ. 32-E3
T. 16 N. R. 7 E.
W. R. EDWARDS
W. D. EDWARDS
J. S. GOODMAN
ROY BENSON
W. D. DELPHY
JAMES HANSEN
HUGH EVANS
LEWIS BUSCH
J. C. KELLAHER
FEDERAL LAND BANK
TYPICAL SECTION
CLASSIFICATION
CLEARING
DRAINAGE STRUCTURES
BENCH MARKS
PROFILE
SURFACING
C. C. JORRIS
1941